


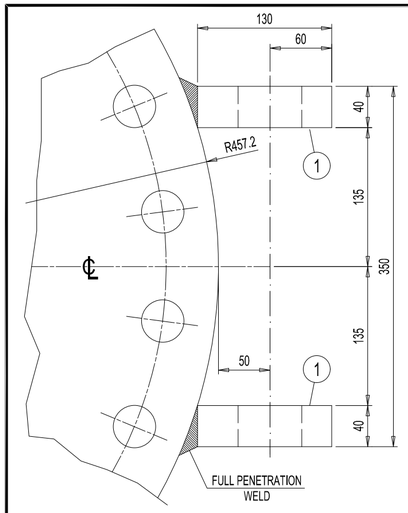


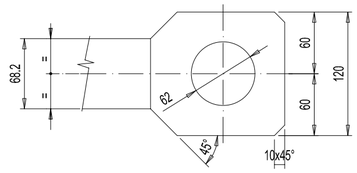

SUPPORT PLATES DETAIL

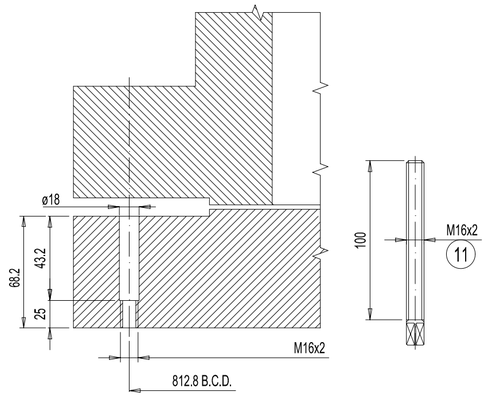


JACK SCREWS DETAIL

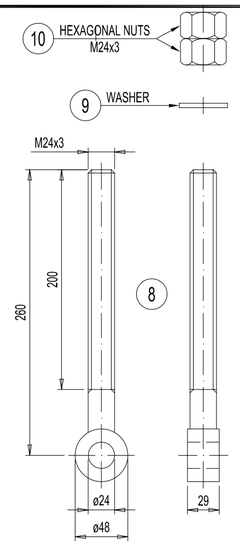


DETAIL "A"


13	ROD	1		SA 36	ø15-438 Lg.	–
12	WASHER	2		BRASS	90 O.D.-62 I.D.-3 Thk.	–
11	JACK SCREW H.H.	6		SA 307 Gr.B	M16x2-100 Lg.	Note 6b
10	HEXAGONAL NUT	4		SA 194 Gr.2H	M24x3	–
9	WASHER	2		SA 36 or equivalent	40 O.D.-25 I.D.-4 Thk.	–
8	EYE BOLT (SEE DETAIL)	2		SA 193 Gr.B7+ SA 194 Gr.2H	M24x3-260 Lg.	–
7	SPLIT PIN	2		S.S. 304	4 Dia.-45 Lg.	–
6	BOLT WITH NUT	2		SA 193 Gr.B7+ SA 194 Gr.2H	M22x2.5-100 Lg.	Note 6b
5	PLATE	4		SA 516 Gr.70	68x100x16 Thk.	3.1 Cert
4	RING	2		SA 516 Gr.70	90 O.D.-62 I.D.-25 Thk.	–
3	PLATE	2		SA 516 Gr.70	80x90x30 Thk.	–
2	ROD	2		SA 36 or equivalent	ø60-1236 Lg.	–
1	PLATE	4		SA 516 Gr.70	130x120x40 Thk.	3.1 Cert
MK	DESCRIPTION	Q.TY	Standard	MATERIAL	DIMENSIONS	Mat. test report
MC.	DESCRIZIONE	Q.TÀ	Standard	MATERIALE	DIMENSIONI	

23096-01-EGA1	General Arrangement
Manufacturer Dwg. No.	Description
Reference documents/belong to drawing	

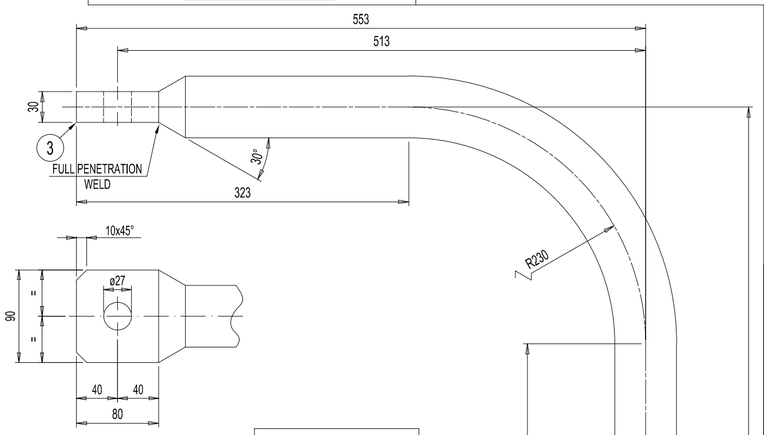



DAVIT DETAIL

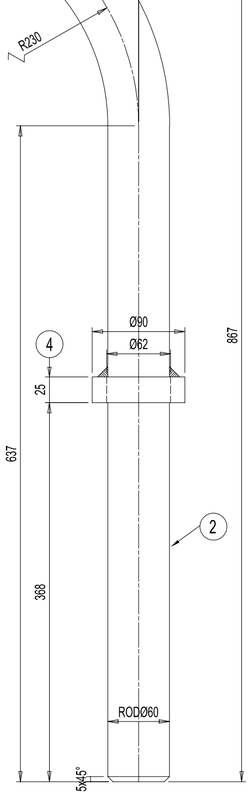

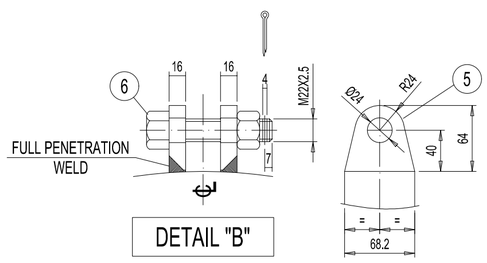

DETAIL "B"

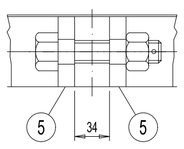

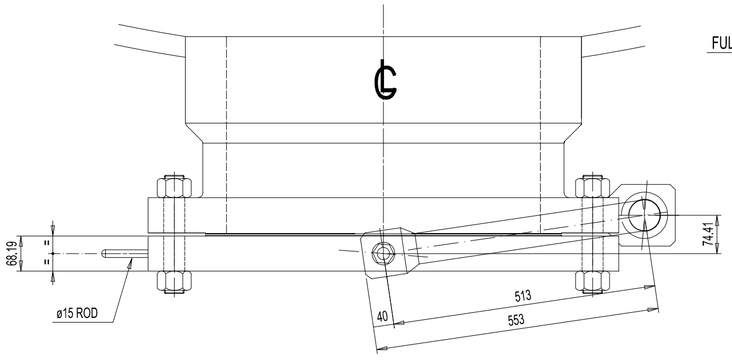

ROSETTI MARINO

no comment

1	NO COMMENTS - APPROVED - WORK MAY PROCEED
2	MINOR COMMENTS - REVISE AND RESUBMIT - WORK MAY PROCEED
3	MAJOR COMMENTS – REJECTED – DO NOT PROCEED
4	APPROVAL NOT REQUIRED

NOTE: Approval doesn't relieve the supplier from mandatory compliance with contractual documents and specifications. Comments made do not imply acceptance of any cost or delivery impact.

Sign	Date
	20-12-2023

B&R

CLIENT : Rosetti Marino

PURCHASE ORDER N

B&R CAD FILE No: 23096-01-EGA1.dwg | MFR'S S.N.

REV.	DATE	DRN	CHKD	APPD	DESCRIPTION
0	23/11/2023				ISSUE FOR INFORMATION (IFI)

CROSSWIND

ROSETTI MARINO

DETAIL DRAWING
MANHOLE DAVIT
H2 STORAGE VESSEL ITEM : V-25001A/F

CONTRACT NO. CW-I-WP4-2023-05 / H2 STORAGE				SCALE	1:10
DRAWN	D.ADELINI	CHECKED	M.TONIOLO	APPROVED	D.PASSERINI	DATE	23/11/23
A2	DRAWING NO. 1723001756-MAC-DD-00023			SHEET	1	REV.	0

File Name : 1723001756-MAC-DD-00023.DWG