

DRAWING NO. 1724000049-AR-DA-00015


REV. 04

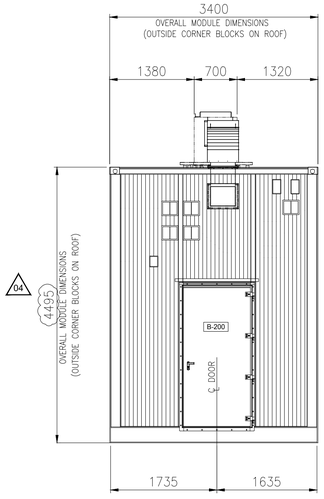


EAST VIEW

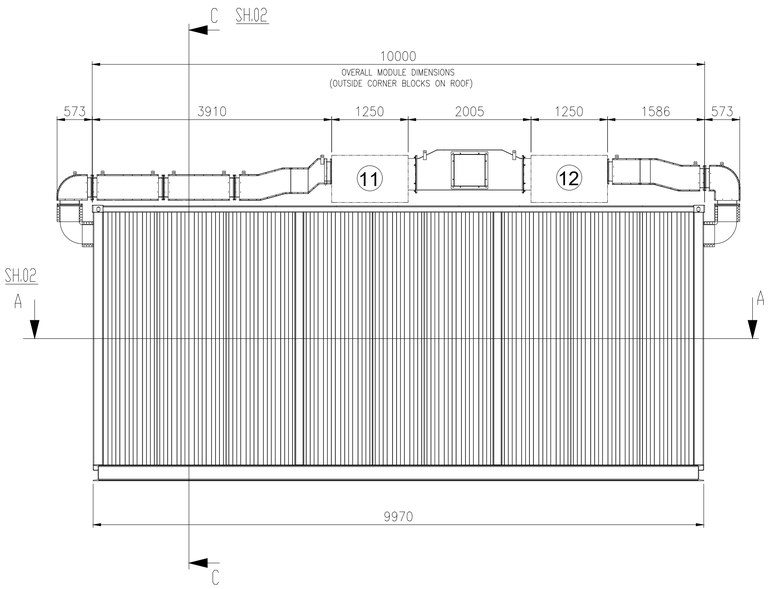

SOUTH VIEW

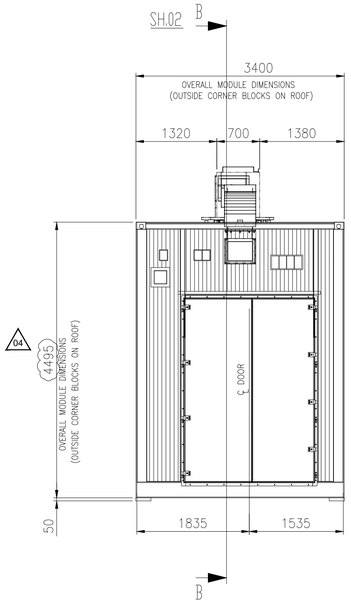

WEST VIEW

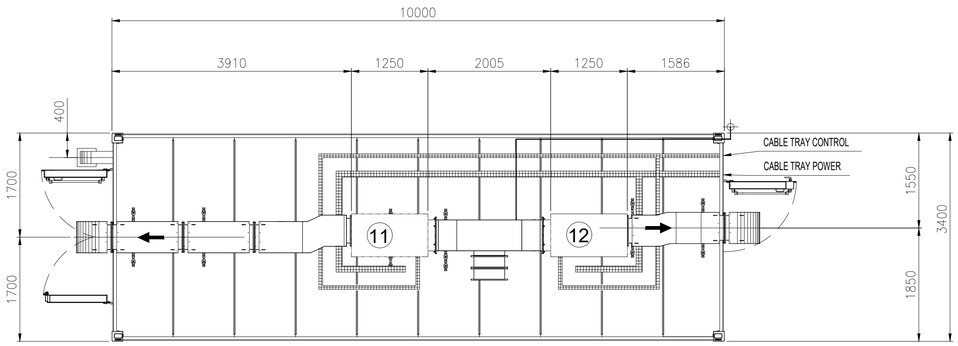



TOP VIEW


EQUIPMENT LIST						
REF.	TAG No.	DESCRIPTION	LENGTH (mm)	WIDTH (mm)	HEIGHT (mm)	WEIGHT (Kg)
1	SG-200N1	400V SWITCHGEAR	7850	700	2331	4900
2	DP-200N1	DISTRIBUTION BOARD FOR LIGHTING AND SMALL POWER B.O.P.	1146	520	2250	600
3	-	SERVICE TROLLEY FOR 400V SWITCHGEAR	1034	490	2030	90
4	CN-200N1	ICCP PANEL	700	580	1830	250
5	B200-HSB-001	DISTRIBUTION & HVAC PANEL - LV ROOM	1200	600	1900	400
6	-	TOOL BOX	495	335	200	20
7	-	TABLE	1000	500	750	50
8	SG-200D2	ACB PANEL FOR SOLAR PACKAGE	1096	844	2294	1000
9	-	PORTABLE EXTINGUISHER (CO2) 5 Kg.	150	150	750	20
10	-	PORTABLE EXTINGUISHER (CO2) 5 Kg.	150	150	750	20
11	HHU-77003	AIR HANDLING UNIT A	1250	850	900	140
12	HHU-77004	AIR HANDLING UNIT B	1250	850	900	140
13	HSS-77-004	SPACE HEATER 1	184	145	1100	5
14	HSS-77-005	SPACE HEATER 2	184	145	1100	5
15	HSS-77-006	SPACE HEATER 3	184	145	1100	5

04

"B-200" LV (400V) SWITCHGEAR ROOM

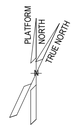

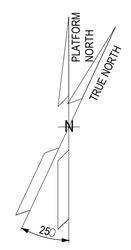

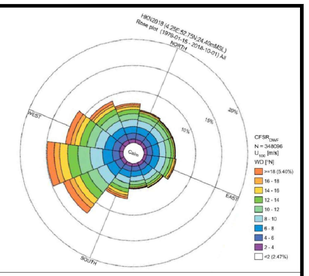

NOTE

1) ALL DIMENSIONS ARE IM MM.
2) THE POSITION OF THE LAMPS INDICATED IS TO BE CONSIDERED THE THEORETICAL ONE, THE FINAL ONE WILL BE CONFIRMED IN THE AS-BUILT ISSUE.

REFERENCE


DOCUMENT TITLE	DOCUMENT NUMBER
"B-200" HVAC SYSTEM G.A. & DETAILS	1724000049-HV-DA-00065
"B-200" DETAILED DRAWING	1724000049-AR-DD-00019
PAINTING PROCEDURE	1724000049-MAT-PRO-00005
"B-200" FOUNDATION	1724000049-ST-DD-00011
"B-200" STRUCTURAL CALCULATION	1724000049-ST-CA-00007

LEGEND

- INTERNAL LIGHT
- E INTERNAL EMERGENCY LIGHT
- SOCKET OUTLET, INDOOR
- LIGHT SWITCH
- ESCAPE CORRIDOR – WIDTH 800mm.
- MAINTENANCE AREA – VENDOR REQUIREMENT
- INSULATION PANEL

HOLDS

KEY PLAN

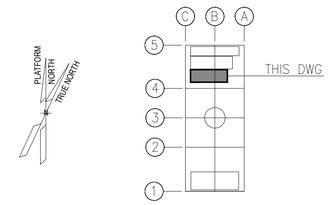

ALEXSISTEMI spa

REV.	DATE	DRN	CHKD	APPD	DESCRIPTION
04	22/10/24	M.G.	SKV	C.A.	ACCEPTED FOR CONSTRUCTION (AFC)
03	23/07/24	M.G.	SKV	C.A.	ACCEPTED FOR CONSTRUCTION (AFC)
02	28/06/24	M.G.	SKV	C.A.	ACCEPTED FOR CONSTRUCTION (AFC)
01	14/05/24	M.G.	SKV	C.A.	ISSUE FOR REVIEW (IFR)
00	08/02/24	A.G.	SKV	C.A.	ISSUE FOR CLIENT REVIEW (ICR)


CROSSWIND | ROSETTI MARINO

TITLE :
BASE LOAD POWER HUB (BLPH)
B-200 GENERAL ARRANGEMENT DRAWINGS


CONTRACT NO./TITLE CONTRACT_NO. 1724000049			SCALE 1:50
DRAWN M.G.	CHECKED SKV	APPROVED C.A.	DATE 22/10/24
A1	DRAWING NO. 1724000049-AR-DA-00015	SHEET 001	REV. 04

File Name : 1724000049-AR-DA-00015-REV.04


DRAWING NO. 1724000049-AR-DA-00015 REV. 04

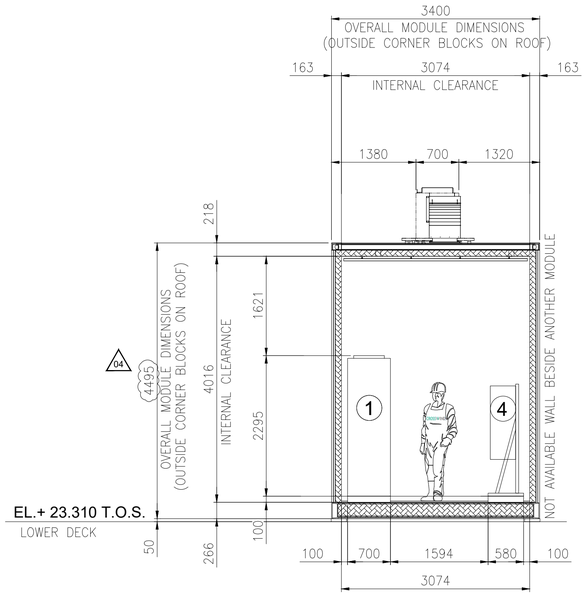


SECTION C-C

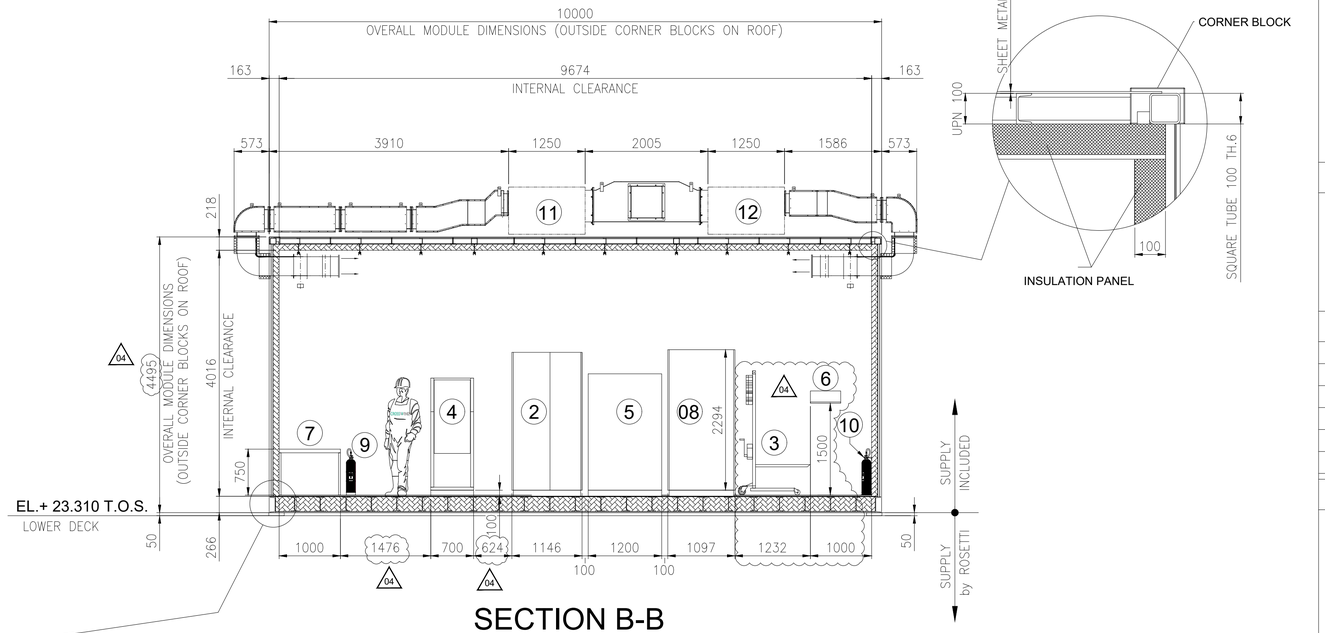

SECTION B-B

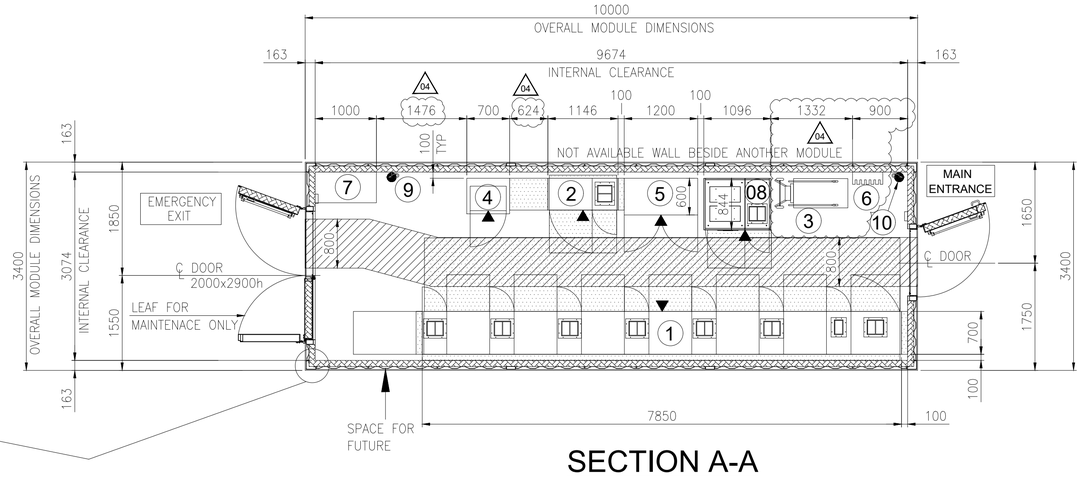


SECTION A-A

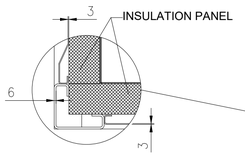



EQUIPMENT LIST

REF.	TAG No.	DESCRIPTION	LENGTH (mm)	WIDTH (mm)	HEIGHT (mm)	WEIGHT (Kg)	
1	SG-200N1	400V SWITCHGEAR	7850	700	2331	4900	
2	DP-200N1	DISTRIBUTION BOARD FOR LIGHTING AND SMALL POWER B.O.P.	1146	520	2250	600	
3	-	SERVICE TROLLEY FOR 400V SWITCHGEAR	1034	490	2030	90	04
4	CN-200N1	ICCP PANEL	700	580	1830	250	
5	B200-HSB-001	DISTRIBUTION & HVAC PANEL - LV ROOM	1200	600	1900	400	
6	-	TOOL BOX	495	335	200	20	
7	-	TABLE	1000	500	750	50	
8	SG-200D2	ACB PANEL FOR SOLAR PACKAGE	1096	844	2294	1000	
9	-	PORTABLE EXTINGUISHER (CO2) 5 Kg.	150	150	750	20	
10	-	PORTABLE EXTINGUISHER (CO2) 5 Kg.	150	150	750	20	
11	HHU-77003	AIR HANDLING UNIT A	1250	850	900	140	
12	HHU-77004	AIR HANDLING UNIT B	1250	850	900	140	
13	HSS-77-004	SPACE HEATER 1	184	145	1100	5	
14	HSS-77-005	SPACE HEATER 2	184	145	1100	5	
15	HSS-77-006	SPACE HEATER 3	184	145	1100	5	

EQUIPMENT LAYOUT
"B-200" LV (400V) SWITCHGEAR ROOM
BOTTOM PLAN

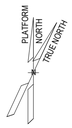

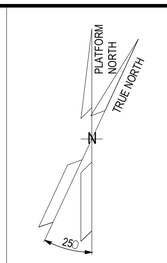

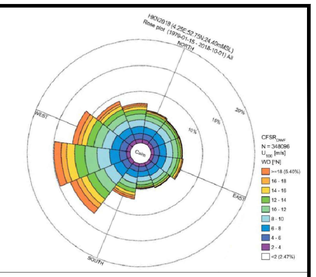

NOTE

1) ALL DIMENSIONS ARE IM MM.
2) THE POSITION OF THE LAMPS INDICATED IS TO BE CONSIDERED THE THEORETICAL ONE, THE FINAL ONE WILL BE CONFIRMED IN THE AS-BUILT ISSUE.

REFERENCE


DOCUMENT TITLE	DOCUMENT NUMBER
"B-200" HVAC SYSTEM G.A. & DETAILS	1724000049-HV-DA-00065
"B-200" DETAILED DRAWING	1724000049-AR-DD-00019
PAINTING PROCEDURE	1724000049-MAT-PRO-00005
"B-200" FOUNDATION	1724000049-ST-DD-00011
"B-200" STRUCTURAL CALCULATION	1724000049-ST-CA-00007

LEGEND

- INTERNAL LIGHT
- E INTERNAL EMERGENCY LIGHT
- SOCKET OUTLET, INDOOR
- LIGHT SWITCH
- ESCAPE CORRIDOR – WIDTH 800mm.
- MAINTENANCE AREA – VENDOR REQUIREMENT
- INSULATION PANEL

HOLDS

KEY PLAN

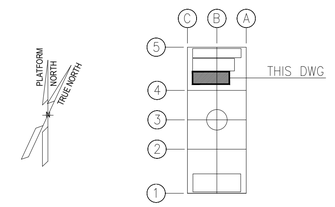

ALEXSISTEMI spa

REV.	DATE	DRN	CHKD	APPD	DESCRIPTION
04	22/10/24	M.G.	SKV	C.A.	ACCEPTED FOR CONSTRUCTION (AFC)
03	23/07/24	M.G.	SKV	C.A.	ACCEPTED FOR CONSTRUCTION (AFC)
02	28/06/24	M.G.	SKV	C.A.	ACCEPTED FOR CONSTRUCTION (AFC)
01	14/05/24	M.G.	SKV	C.A.	ISSUE FOR REVIEW (IFR)
00	08/02/24	A.G.	SKV	C.A.	ISSUE FOR CLIENT REVIEW (ICR)

CROSSWIND | ROSETTI MARINO


TITLE : BASE LOAD POWER HUB (BLPH)
B-200 GENERAL ARRANGEMENT DRAWINGS

CONTRACT NO./TITLE CONTRACT_NO. 1724000049			SCALE 1:50
DRAWN M.G.	CHECKED SKV	APPROVED C.A.	DATE 22/10/24
A1	DRAWING NO. 1724000049-AR-DA-00015	SHEET 002	REV. 04


File Name : 1724000049-AR-DA-00015-REV.04

DRAWING NO. 1724000049-AR-DA-00015


REV. 04

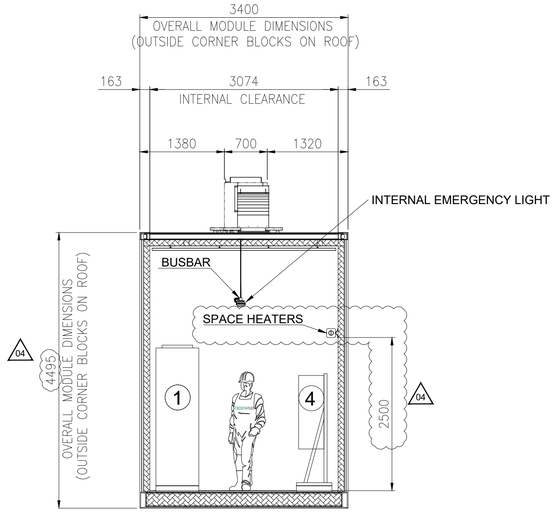


SECTION E-E

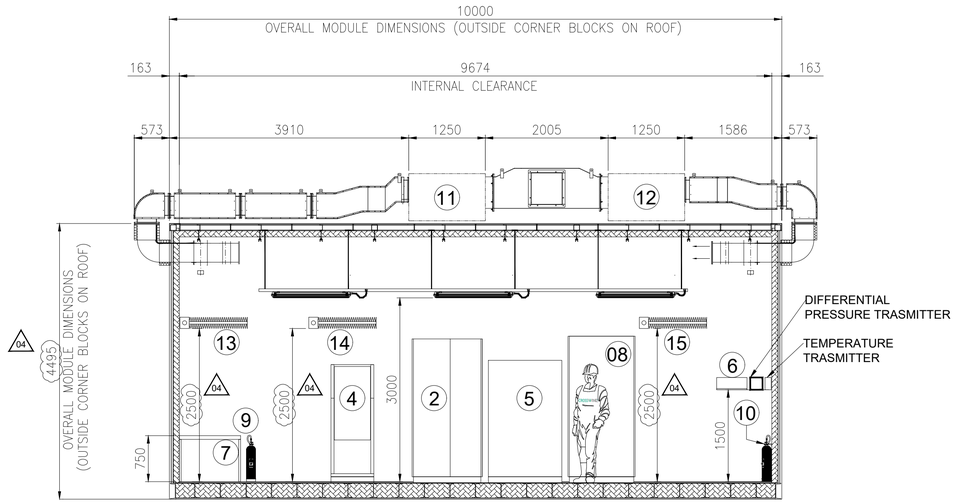

SECTION D-D

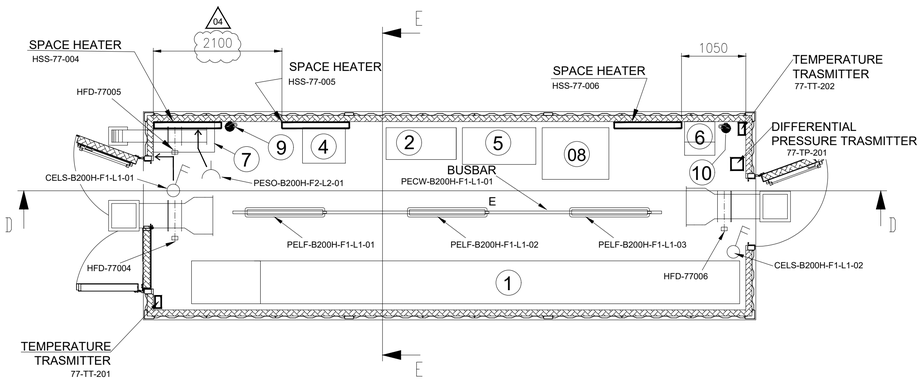


"B-200" LV (400V) SWITCHGEAR ROOM PLAN

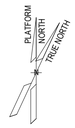

EQUIPMENT LIST

REF.	TAG No.	DESCRIPTION	LENGTH (mm)	WIDTH (mm)	HEIGHT (mm)	WEIGHT (Kg)
1	SG-200N1	400V SWITCHGEAR	7850	700	2331	4900
2	DP-200N1	DISTRIBUTION BOARD FOR LIGHTING AND SMALL POWER B.O.P.	1146	520	2250	600
3	-	SERVICE TROLLEY FOR 400V SWITCHGEAR	1034	490	2030	90
4	CN-200N1	ICCP PANEL	700	580	1830	250
5	B200-HSB-001	DISTRIBUTION & HVAC PANEL - LV ROOM	1200	600	1900	400
6	-	TOOL BOX	495	335	200	20
7	-	TABLE	1000	500	750	50
8	SG-200D2	ACB PANEL FOR SOLAR PACKAGE	1096	844	2294	1000
9	-	PORTABLE EXTINGUISHER (CO2) 5 Kg.	150	150	750	20
10	-	PORTABLE EXTINGUISHER (CO2) 5 Kg.	150	150	750	20
11	HHU-77003	AIR HANDLING UNIT A	1250	850	900	140
12	HHU-77004	AIR HANDLING UNIT B	1250	850	900	140
13	HSS-77-004	SPACE HEATER 1	184	145	1100	5
14	HSS-77-005	SPACE HEATER 2	184	145	1100	5
15	HSS-77-006	SPACE HEATER 3	184	145	1100	5

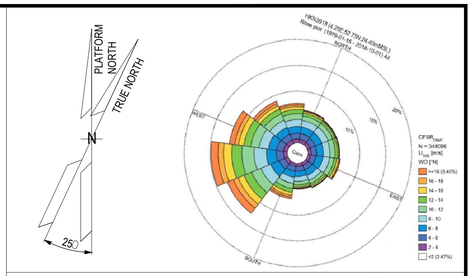

NOTE

1) ALL DIMENSIONS ARE IM MM.
2) THE POSITION OF THE LAMPS INDICATED IS TO BE CONSIDERED THE THEORETICAL ONE, THE FINAL ONE WILL BE CONFIRMED IN THE AS-BUILT ISSUE.

REFERENCE

DOCUMENT TITLE	DOCUMENT NUMBER
"B-200" HVAC SYSTEM G.A. & DETAILS	1724000049-HV-DA-00065
"B-200" DETAILED DRAWING	1724000049-AR-DD-00019
PAINTING PROCEDURE	1724000049-MAT-PRO-00005
"B-200" FOUNDATION	1724000049-ST-DD-00011
"B-200" STRUCTURAL CALCULATION	1724000049-ST-CA-00007

LEGEND

INTERNAL LIGHT

E INTERNAL EMERGENCY LIGHT

SOCKET OUTLET, INDOOR

LIGHT SWITCH


ESCAPE CORRIDOR – WIDTH 800mm.

MAINTENANCE AREA – VENDOR REQUIREMENT

INSULATION PANEL

HOLDS

KEY PLAN

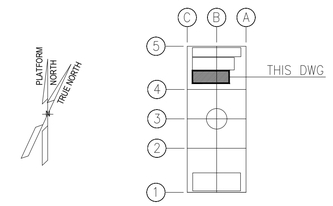

ALEXSISTEMI spa

REV.	DATE	DRN	CHKD	APPD	DESCRIPTION
04	22/10/24	M.G.	SKV	C.A.	ACCEPTED FOR CONSTRUCTION (AFC)
03	23/07/24	M.G.	SKV	C.A.	ACCEPTED FOR CONSTRUCTION (AFC)
02	28/06/24	M.G.	SKV	C.A.	ACCEPTED FOR CONSTRUCTION (AFC)
01	14/05/24	M.G.	SKV	C.A.	ISSUE FOR REVIEW (IFR)
00	08/02/24	A.G.	SKV	C.A.	ISSUE FOR CLIENT REVIEW (ICR)

CROSSWIND

ROSETTI MARINO

TITLE :
BASE LOAD POWER HUB (BLPH)
B-200 GENERAL ARRANGEMENT DRAWINGS

CONTRACT NO./TITLE CONTRACT_NO. 1724000049			SCALE 1:50
DRAWN M.G.	CHECKED SKV	APPROVED C.A.	DATE 22/10/24
A1	DRAWING NO. 1724000049-AR-DA-00015	SHEET 003	REV. 04

File Name : 1724000049-AR-DA-00015-REV.04