

DRAWING NO. 1724000049-AR-DA-00016


REV. 04

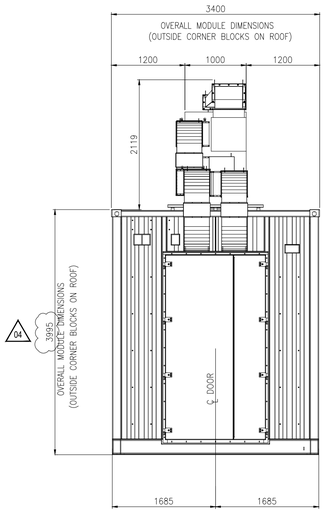

WEST VIEW

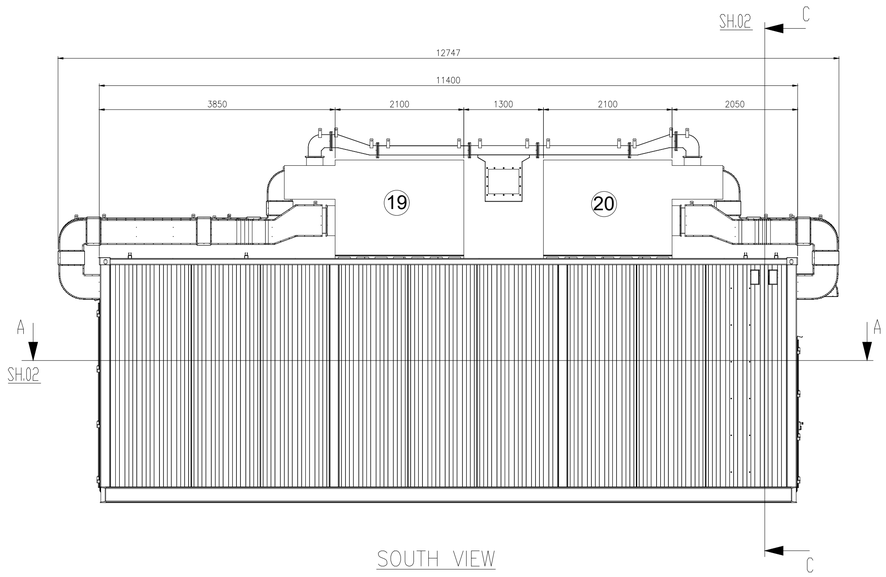


SOUTH VIEW

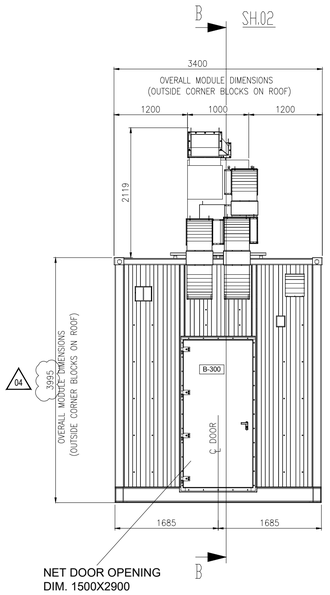

NET DOOR OPENING
DIM. 1500X2900

EAST VIEW

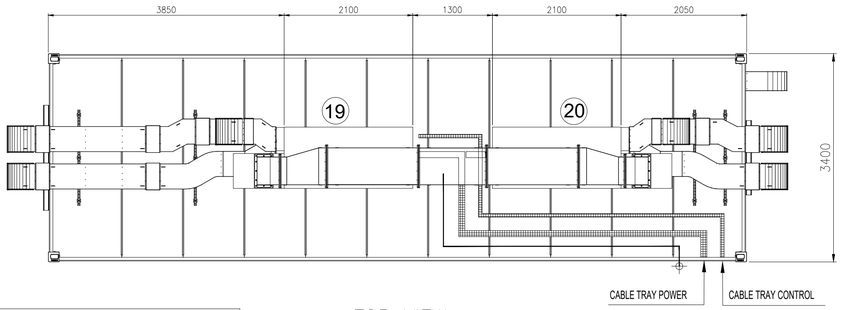



TOP VIEW


EQUIPMENT LIST

REF.	TAG No.	DESCRIPTION	LENGTH (mm)	WIDTH (mm)	HEIGHT (mm)	WEIGHT (Kg)
1	UP-200F3	AC UPS 35kVA	2400	860	1915	2258
2	UP-200F4	AC UPS 15kVA	2400	860	1915	2258
3	BA-200F3A	BATTERY RACK GEL VRLA 7y AC UPS 35kVA	1050	725	1272	914
4	BA-200F3B	BATTERY RACK GEL VRLA 7y AC UPS 35kVA	1050	725	1272	914
5	BA-200F4A	BATTERY RACK GEL VRLA 7y AC UPS 15kVA	1890	725	1761	3429
6	BA-200F4B	BATTERY RACK GEL VRLA 7y AC UPS 15kVA	1890	725	1761	3429
7	CB-200F3A	ISOLATOR BOX AC UPS 35kVA	600	300	800	100
8	CB-200F3B	ISOLATOR BOX AC UPS 35kVA	600	300	800	100
9	CB-200F4A	ISOLATOR BOX AC UPS 15kVA	600	300	800	100
10	CB-200F4B	ISOLATOR BOX AC UPS 15kVA	600	300	800	100
11	NC-200F2	NAVAID PANEL	1000	800	2600	535
12	BA-200F2	BATTERY BOX NAVAID	958	993	1210	1552
13	CB-200F2	ISOLATOR BOX NAVAID	500	400	765	70
14	B300-HSB-001	DISTRIBUTION & HVAC PANEL - AC/UPS ROOM	1600	600	2300	500
15	-	EYE WASH STATION	228	80	290	5
16	-	PORTABLE EXTINGUISHER (CO2) 5 Kg.	150	150	750	20
17	-	PORTABLE EXTINGUISHER (CO2) 5 Kg.	150	150	750	20
18	BC-200F2	BATTERY CHARGER NAVAID	607	607	2157	500
19	HHU-77005	AIR HANDLING UNIT A	2100	1000	2158	850
20	HHU-77006	AIR HANDLING UNIT B	2100	1000	2158	850
21	HSS-77-007	SPACE HEATER 1	184	145	1100	5
22	HSS-77-008	SPACE HEATER 2	184	145	1100	5
23	HSS-77-009	SPACE HEATER 3	184	145	1100	5

"B-300" AC UPS FITTED WITH UPS SYSTEM EQUIPMENT ROOM

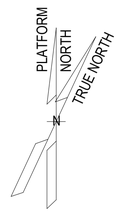

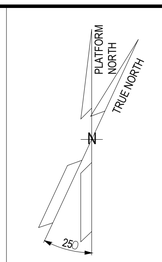

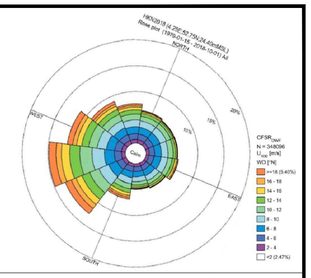

NOTE

1) ALL DIMENSIONS ARE IM MM.
2) THE POSITION OF THE LAMPS INDICATED IS TO BE CONSIDERED THE THEORETICAL ONE, THE FINAL ONE WILL BE CONFIRMED IN THE AS-BUILT ISSUE.

REFERENCE


DOCUMENT TITLE	DOCUMENT NUMBER
"B-300" HVAC SYSTEM G.A. & DETAILS	1724000049-HV-DA-00066
"B-300" DETAILED DRAWING	1724000049-AR-DD-00020
PAINTING PROCEDURE	1724000049-MAT-PRO-00006
"B-300" FOUNDATION	1724000049-ST-DD-00012
"B-300" STRUCTURAL CALCULATION	1724000049-ST-CA-00008

LEGEND

- INTERNAL LIGHT
- E INTERNAL EMERGENCY LIGHT
- SOCKET OUTLET, INDOOR
- LIGHT SWITCH
- ESCAPE CORRIDOR – WIDTH 800mm.
- MAINTENANCE AREA – VENDOR REQUIREMENT
- INSULATION PANEL

HOLDS

KEY PLAN

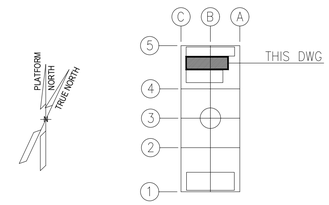

ALEXSISTEMI spa

REV.	DATE	DRN	CHKD	APPD	DESCRIPTION
04	22/10/24	M.G.	SKV	C.A.	ACCEPTED FOR CONSTRUCTION (AFC)
03	23/07/24	M.G.	SKV	C.A.	ACCEPTED FOR CONSTRUCTION (AFC)
02	03/07/24	M.G.	SKV	C.A.	ACCEPTED FOR CONSTRUCTION (AFC)
01	16/05/24	M.G.	SKV	C.A.	ISSUE FOR REVIEW (IFR)
00	08/02/24	A.G.	SKV	C.A.	ISSUE FOR CLIENT REVIEW (ICR)

CROSSWIND | ROSETTI MARINO


TITLE : BASE LOAD POWER HUB (BLPH)
B-300 GENERAL ARRANGEMENT DRAWINGS

CONTRACT NO./TITLE CONTRACT_NO. 1724000049			SCALE 1:50
DRAWN M.G.	CHECKED SKV	APPROVED C.A.	DATE 22/10/24
A1	DRAWING NO. 1724000049-AR-DA-00016	SHEET 001	REV. 04


File Name : 1724000049-AR-DA-00016-REV.04

DRAWING NO. 1724000049-AR-DA-00016


REV. 04

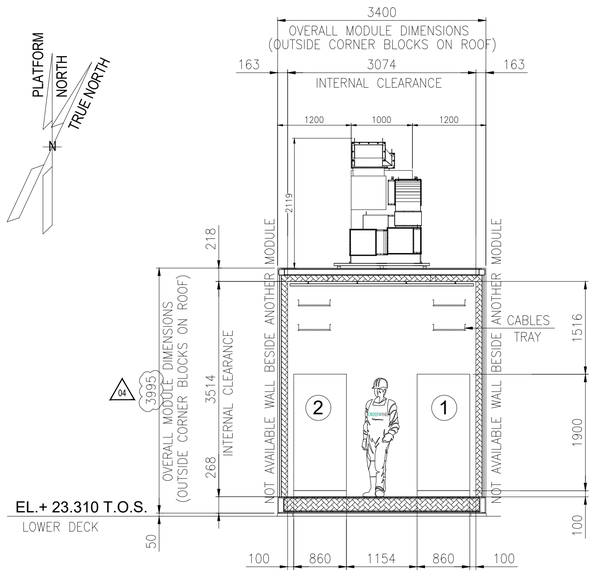

SECTION C-C

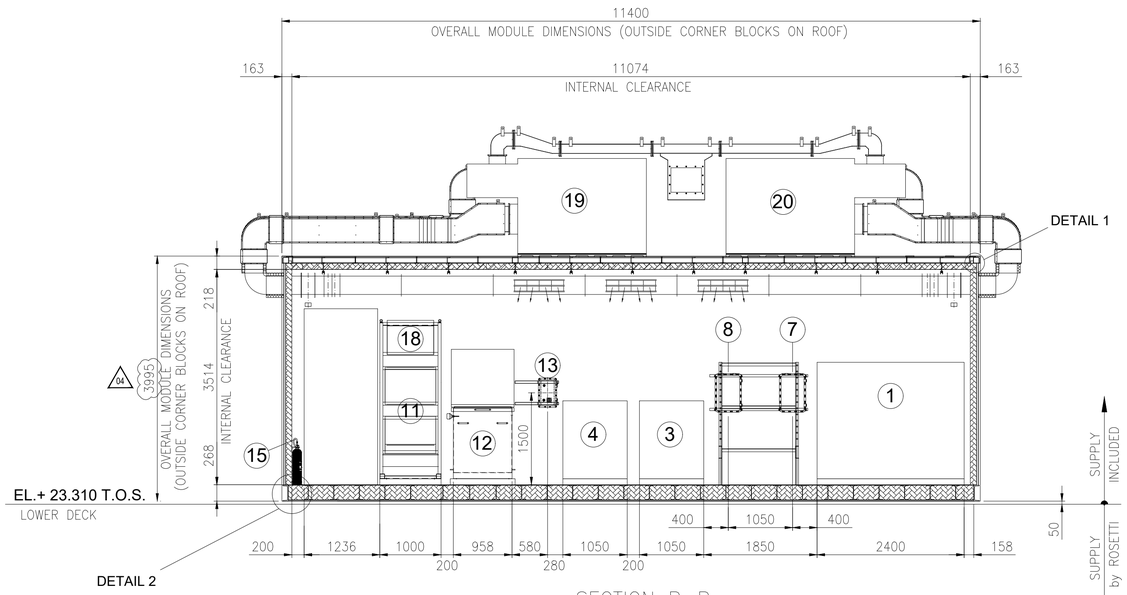

SECTION B-B

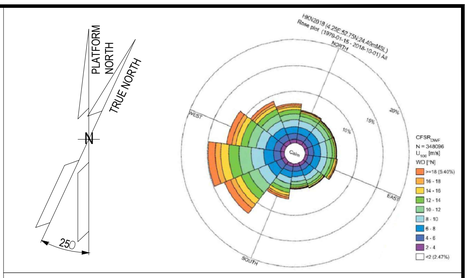

NOTE

1) ALL DIMENSIONS ARE IM MM.
2) THE POSITION OF THE LAMPS INDICATED IS TO BE CONSIDERED THE THEORETICAL ONE, THE FINAL ONE WILL BE CONFIRMED IN THE AS-BUILT ISSUE.

REFERENCE


DOCUMENT TITLE	DOCUMENT NUMBER
"B-300" HVAC SYSTEM G.A. & DETAILS	1724000049-HV-DA-00066
"B-300" DETAILED DRAWING	1724000049-AR-DD-00020
PAINTING PROCEDURE	1724000049-MAT-PRO-00006
"B-300" FOUNDATION	1724000049-ST-DD-00012
"B-300" STRUCTURAL CALCULATION	1724000049-ST-CA-00008

LEGEND


- INTERNAL LIGHT
- E INTERNAL EMERGENCY LIGHT
- SOCKET OUTLET, INDOOR
- LIGHT SWITCH
- ESCAPE CORRIDOR - WIDTH 800mm.
- MAINTENANCE AREA - VENDOR REQUIREMENT
- INSULATION PANEL

HOLDS


KEY PLAN

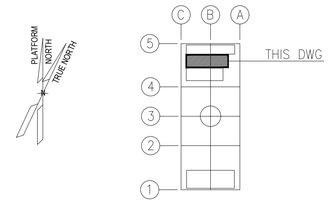

DETAIL 1

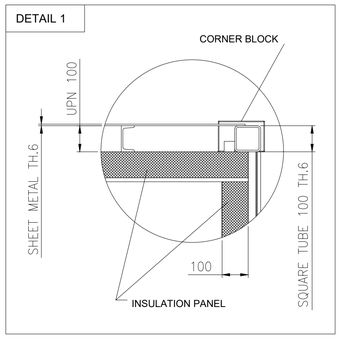


DETAIL 2

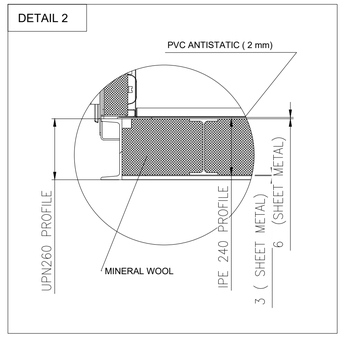

EQUIPMENT LIST

REF.	TAG No.	DESCRIPTION	LENGTH (mm)	WIDTH (mm)	HEIGHT (mm)	WEIGHT (Kg)
1	UP-200F3	AC UPS 35kVA	2400	860	1915	2258
2	UP-200F4	AC UPS 15kVA	2400	860	1915	2258
3	BA-200F3A	BATTERY RACK GEL VRLA 7y AC UPS 35kVA	1050	725	1272	914
4	BA-200F3B	BATTERY RACK GEL VRLA 7y AC UPS 35kVA	1050	725	1272	914
5	BA-200F4A	BATTERY RACK GEL VRLA 7y AC UPS 15kVA	1890	725	1761	3429
6	BA-200F4B	BATTERY RACK GEL VRLA 7y AC UPS 15kVA	1890	725	1761	3429
7	CB-200F3A	ISOLATOR BOX AC UPS 35kVA	600	300	800	100
8	CB-200F3B	ISOLATOR BOX AC UPS 35kVA	600	300	800	100
9	CB-200F4A	ISOLATOR BOX AC UPS 15kVA	600	300	800	100
10	CB-200F4B	ISOLATOR BOX AC UPS 15kVA	600	300	800	100
11	NC-200F2	NAVAID PANEL	1000	800	2600	535
12	BA-200F2	BATTERY BOX NAVAID	958	993	1210	1552
13	CB-200F2	ISOLATOR BOX NAVAID	500	400	765	70
14	B300-HSB-001	DISTRIBUTION & HVAC PANEL - AC/UPS ROOM	1600	600	2300	500
15	-	EYE WASH STATION	228	80	290	5
16	-	PORTABLE EXTINGUISHER (CO2) 5 Kg.	150	150	750	20
17	-	PORTABLE EXTINGUISHER (CO2) 5 Kg.	150	150	750	20
18	BC-200F2	BATTERY CHARGER NAVAID	607	607	2157	500
19	HHU-77005	AIR HANDLING UNIT A	2100	1000	2158	850
20	HHU-77006	AIR HANDLING UNIT B	2100	1000	2158	850
21	HSS-77-007	SPACE HEATER 1	184	145	1100	5
22	HSS-77-008	SPACE HEATER 2	184	145	1100	5
23	HSS-77-009	SPACE HEATER 3	184	145	1100	5

SECTION A-A

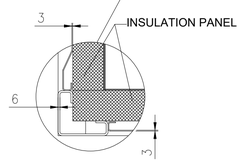

EQUIPMENT LAYOUT
"B-300" AC UPS FITTED WITH UPS SYSTEM EQUIPMENT ROOM
BOTTOM PLAN

ALEXSISTEMI spa

REV.	DATE	DRN	CHKD	APPD	DESCRIPTION
04	22/10/24	M.G.	SKV	C.A.	ACCEPTED FOR CONSTRUCTION (AFC)
03	23/07/24	M.G.	SKV	C.A.	ACCEPTED FOR CONSTRUCTION (AFC)
02	03/07/24	M.G.	SKV	C.A.	ACCEPTED FOR CONSTRUCTION (AFC)
01	16/05/24	M.G.	SKV	C.A.	ISSUE FOR REVIEW (IFR)
00	08/02/24	A.G.	SKV	C.A.	ISSUE FOR CLIENT REVIEW (ICR)

CROSSWIND

ROSETTI MARINO


TITLE : BASE LOAD POWER HUB (BLPH)
B-300 GENERAL ARRANGEMENT DRAWINGS


CONTRACT NO./TITLE CONTRACT_NO. 1724000049			SCALE 1:50
DRAWN M.G.	CHECKED SKV	APPROVED C.A.	DATE 22/10/24
A1	DRAWING NO. 1724000049-AR-DA-00016	SHEET 002	REV. 04

File Name : 1724000049-AR-DA-00016-REV.04


DRAWING NO. 1724000049-AR-DA-00016

REV. 04

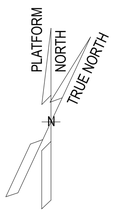

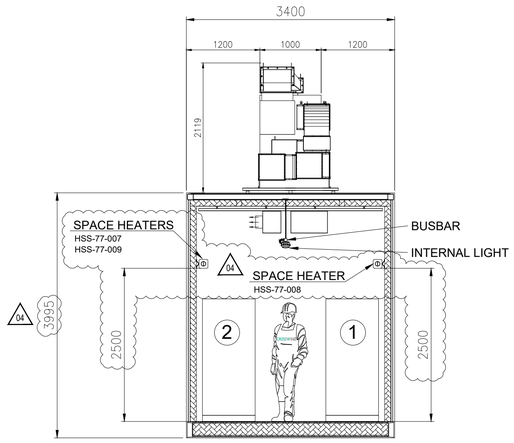


SECTION E-E

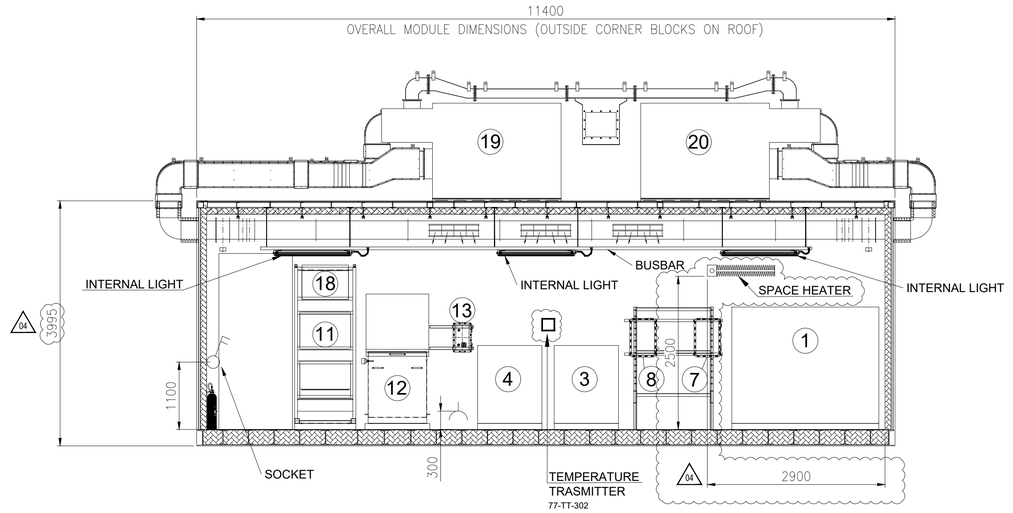



SECTION D-D

EQUIPMENT LIST						
REF.	TAG No.	DESCRIPTION	LENGTH (mm)	WIDTH (mm)	HEIGHT (mm)	WEIGHT (Kg)
1	UP-200F3	AC UPS 35kVA	2400	860	1915	2258
2	UP-200F4	AC UPS 15kVA	2400	860	1915	2258
3	BA-200F3A	BATTERY RACK GEL VRLA 7y AC UPS 35kVA	1050	725	1272	914
4	BA-200F3B	BATTERY RACK GEL VRLA 7y AC UPS 35kVA	1050	725	1272	914
5	BA-200F4A	BATTERY RACK GEL VRLA 7y AC UPS 15kVA	1890	725	1761	3429
6	BA-200F4B	BATTERY RACK GEL VRLA 7y AC UPS 15kVA	1890	725	1761	3429
7	CB-200F3A	ISOLATOR BOX AC UPS 35kVA	600	300	800	100
8	CB-200F3B	ISOLATOR BOX AC UPS 35kVA	600	300	800	100
9	CB-200F4A	ISOLATOR BOX AC UPS 15kVA	600	300	800	100
10	CB-200F4B	ISOLATOR BOX AC UPS 15kVA	600	300	800	100
11	NC-200F2	NAVAID PANEL	1000	800	2600	535
12	BA-200F2	BATTERY BOX NAVAID	958	993	1210	1552
13	CB-200F2	ISOLATOR BOX NAVAID	500	400	765	70
14	B300-HSB-001	DISTRIBUTION & HVAC PANEL - AC/UPS ROOM	1600	600	2300	500
15	-	EYE WASH STATION	228	80	290	5
16	-	PORTABLE EXTINGUISHER (CO2) 5 Kg.	150	150	750	20
17	-	PORTABLE EXTINGUISHER (CO2) 5 Kg.	150	150	750	20
18	BC-200F2	BATTERY CHARGER NAVAID	607	607	2157	500
19	HHU-77005	AIR HANDLING UNIT A	2100	1000	2158	850
20	HHU-77006	AIR HANDLING UNIT B	2100	1000	2158	850
21	HSS-77-007	SPACE HEATER 1	184	145	1100	5
22	HSS-77-008	SPACE HEATER 2	184	145	1100	5
23	HSS-77-009	SPACE HEATER 3	184	145	1100	5

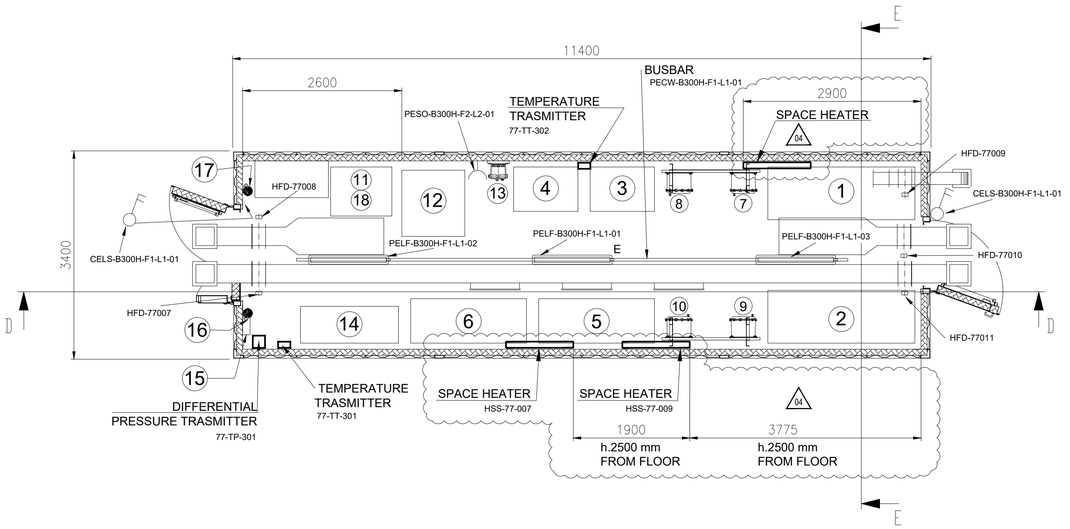

"B-300" AC UPS FITTED WITH UPS SYSTEM EQUIPMENT ROOM
PLAN

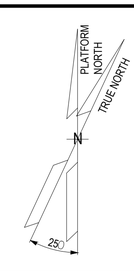

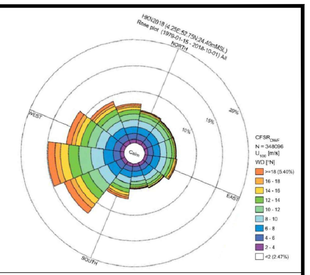

NOTE

1) ALL DIMENSIONS ARE IM MM.
2) THE POSITION OF THE LAMPS INDICATED IS TO BE CONSIDERED THE THEORETICAL ONE, THE FINAL ONE WILL BE CONFIRMED IN THE AS-BUILT ISSUE.

REFERENCE


DOCUMENT TITLE	DOCUMENT NUMBER
"B-300" HVAC SYSTEM G.A. & DETAILS	1724000049-HV-DA-00066
"B-300" DETAILED DRAWING	1724000049-AR-DD-00020
PAINTING PROCEDURE	1724000049-MAT-PRO-00006
"B-300" FOUNDATION	1724000049-ST-DD-00012
"B-300" STRUCTURAL CALCULATION	1724000049-ST-CA-00008

LEGEND

- INTERNAL LIGHT
- E INTERNAL EMERGENCY LIGHT
- SOCKET OUTLET, INDOOR
- LIGHT SWITCH
- ESCAPE CORRIDOR - WIDTH 800mm.
- MAINTENANCE AREA - VENDOR REQUIREMENT
- INSULATION PANEL

HOLDS

KEY PLAN

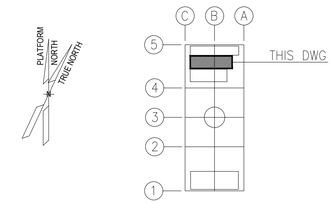

ALEXSISTEMI spa

REV.	DATE	DRN	CHKD	APPD	DESCRIPTION
04	22/10/24	M.G.	SKV	C.A.	ACCEPTED FOR CONSTRUCTION (AFC)
03	23/07/24	M.G.	SKV	C.A.	ACCEPTED FOR CONSTRUCTION (AFC)
02	03/07/24	M.G.	SKV	C.A.	ACCEPTED FOR CONSTRUCTION (AFC)
01	16/05/24	M.G.	SKV	C.A.	ISSUE FOR REVIEW (IFR)
00	08/02/24	A.G.	SKV	C.A.	ISSUE FOR CLIENT REVIEW (ICR)

CROSSWIND | ROSETTI MARINO

TITLE : BASE LOAD POWER HUB (BLPH)
B-300 GENERAL ARRANGEMENT DRAWINGS

CONTRACT NO./TITLE CONTRACT_NO. 1724000049			SCALE 1:50
DRAWN M.G.	CHECKED SKV	APPROVED C.A.	DATE 22/10/24
A1	DRAWING NO. 1724000049-AR-DA-00016	SHEET 003	REV. 04

File Name : 1724000049-AR-DA-00016-REV.04