

DRAWING NO. 1724000049-AR-DA-00017


REV. 04

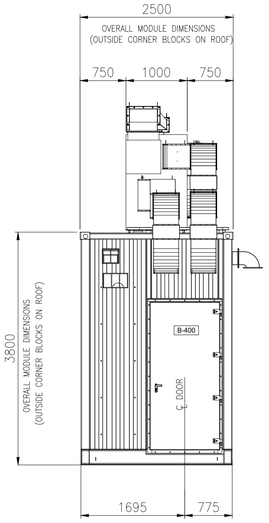


EAST VIEW

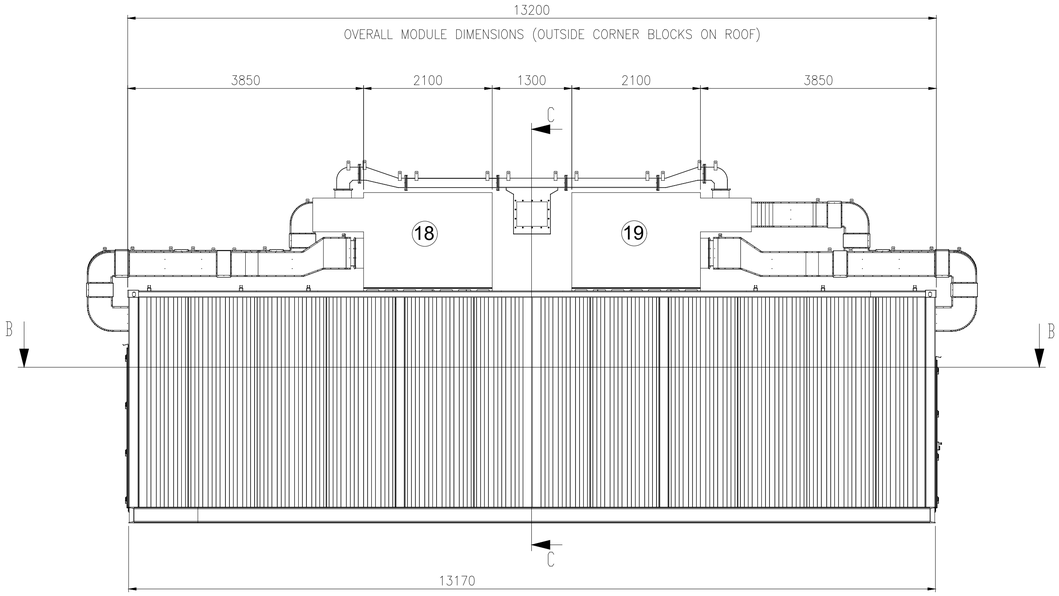

SOUTH VIEW

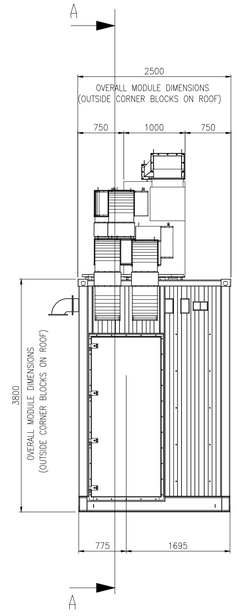

WEST VIEW

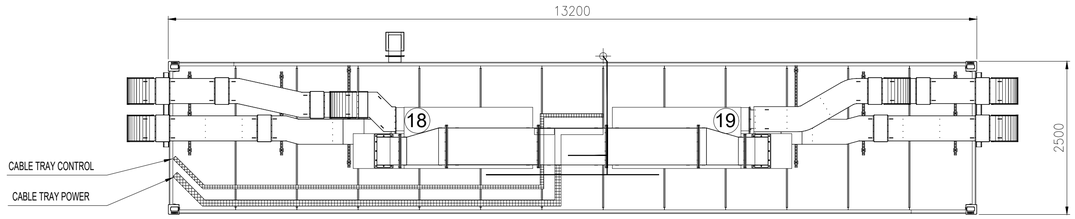



TOP VIEW


EQUIPMENT LIST

REF.	TAG No.	DESCRIPTION	LENGTH (mm)	WIDTH (mm)	HEIGHT (mm)	WEIGHT (Kg)	NOTE
1	B400-SRV-001	SERVER CABINET	1000	800	2100	250	SINGLE CABINET
2	B400-NET-001	NETWORK CABINET	800	800	2100	250	SINGLE CABINET
3	B400-EMCS-001	EMCS SYSTEM CABINET	800	800	2100	250	SINGLE CABINET
4	B400-PCS-001	PCS SYSTEM CABINET	800	800	2100	250	DOUBLE CABINET
5	B400-PCS-002	PCS MARSHALLING CABINET	800	800	2100	250	
6	B400-FGS-001	FGS SYSTEM CABINET	800	800	2100	250	TRIPLE CABINET
7	B400-FGS-002	FGS MARSHALLING CABINET 1	800	800	2100	250	
8	B400-FGS-003	FGS MARSHALLING CABINET 2	800	800	2100	250	
9	B400-SIS-001	SIS SYSTEM/MARSHALLING CABINET	800	800	2100	250	SINGLE CABINET
10	-	SPARE					
11	B400-HSB-001	DISTRIBUTION & HVAC PANEL - I&T ROOM	1600	600	2300	1150	
12	-	TABLE	850	500	750	50	
13	-	PORTABLE EXTINGUISHER (CO_2) 5 Kg.	150	150	750	20	
14	-	PORTABLE EXTINGUISHER (CO_2) 5 Kg.	150	150	750	20	
15	-	FIRST AID KIT	280	115	200	10	
16	-	RESUSCITATION UNIT	430	210	480	10	
17	-	CABINET INCLUDED N.10 ESCAPE MASK	448	213	422	15	
18	HHU-77007	AIR HANDLING UNIT A	2100	1000	2158	850	
19	HHU-77008	AIR HANDLING UNIT B	2100	1000	2158	850	
20	HSS-77-010	SPACE HEATER 1	184	145	1100	5	
21	HSS-77-011	SPACE HEATER 2	184	145	1100	5	
22	HSS-77-012	SPACE HEATER 3	184	145	1100	5	

"B-400" I&T EQUIPMENT ROOM

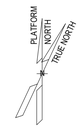

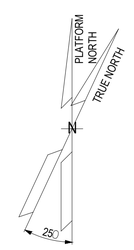

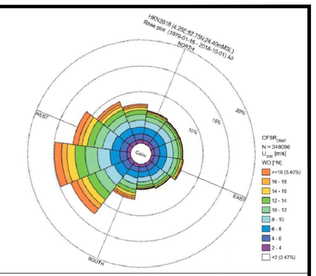

NOTE

1) ALL DIMENSIONS ARE IM MM.
2) THE POSITION OF THE LAMPS INDICATED IS TO BE CONSIDERED THE THEORETICAL ONE, THE FINAL ONE WILL BE CONFIRMED IN THE AS-BUILT ISSUE.

REFERENCE

DOCUMENT TITLE	DOCUMENT NUMBER
"B-400" HVAC SYSTEM G.A. & DETAILS	1724000049-HV-DA-00067
"B-400" DETAILED DRAWING	1724000049-AR-DD-00021
PAINTING PROCEDURE	1724000049-MAT-PRO-00007
"B-400" FOUNDATION	1724000049-ST-DD-00013
"B-400" STRUCTURAL CALCULATION	1724000049-ST-CA-00009

LEGEND

INTERNAL LIGHT

E INTERNAL EMERGENCY LIGHT

SOCKET OUTLET, INDOOR

LIGHT SWITCH


ESCAPE CORRIDOR – WIDTH 800mm.

MAINTENANCE AREA – VENDOR REQUIREMENT

INSULATION PANEL

HOLDS

KEY PLAN

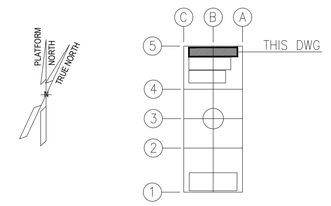

ALEXSISTEMI spa

REV.	DATE	DRN	CHKD	APPD	DESCRIPTION
04	22/10/24	M.G.	SKV	C.A.	ACCEPTED FOR CONSTRUCTION (AFC)
03	23/07/24	M.G.	SKV	C.A.	ACCEPTED FOR CONSTRUCTION (AFC)
02	04/07/24	M.G.	SKV	C.A.	ACCEPTED FOR CONSTRUCTION (AFC)
01	16/05/24	M.G.	SKV	C.A.	ISSUE FOR REVIEW (IFR)
00	08/02/24	A.G.	SKV	C.A.	ISSUE FOR CLIENT REVIEW (ICR)


CROSSWIND | ROSETTI MARINO

TITLE : BASE LOAD POWER HUB (BLPH)
B-400 GENERAL ARRANGEMENT DRAWINGS


CONTRACT NO./TITLE CONTRACT_NO. 1724000049			SCALE 1:50
DRAWN M.G.	CHECKED SKV	APPROVED C.A.	DATE 22/10/24
A1	DRAWING NO. 1724000049-AR-DA-00017	SHEET 001	REV. 04

File Name : 1724000049-AR-DA-00017-REV.04


DRAWING NO. 1724000049-AR-DA-00017 REV. 04

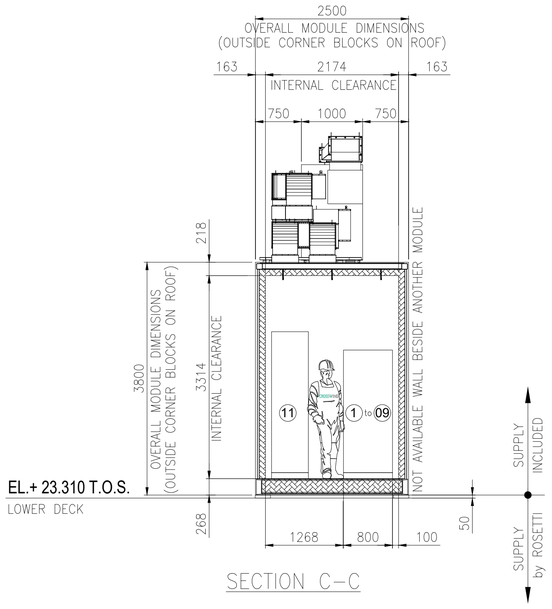



SECTION C-C

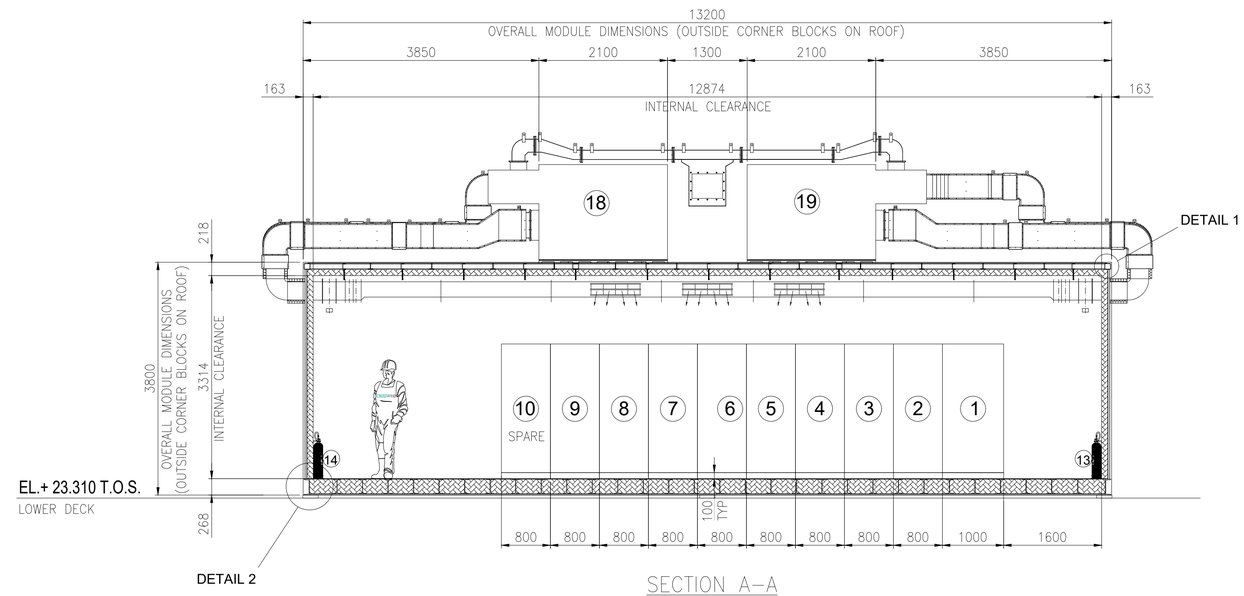


SECTION A-A

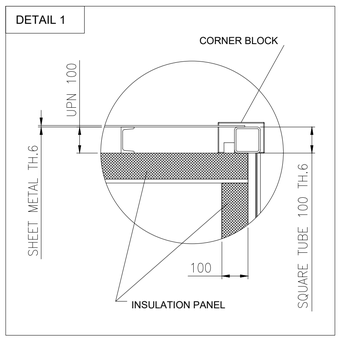

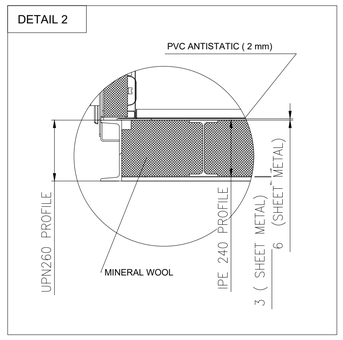

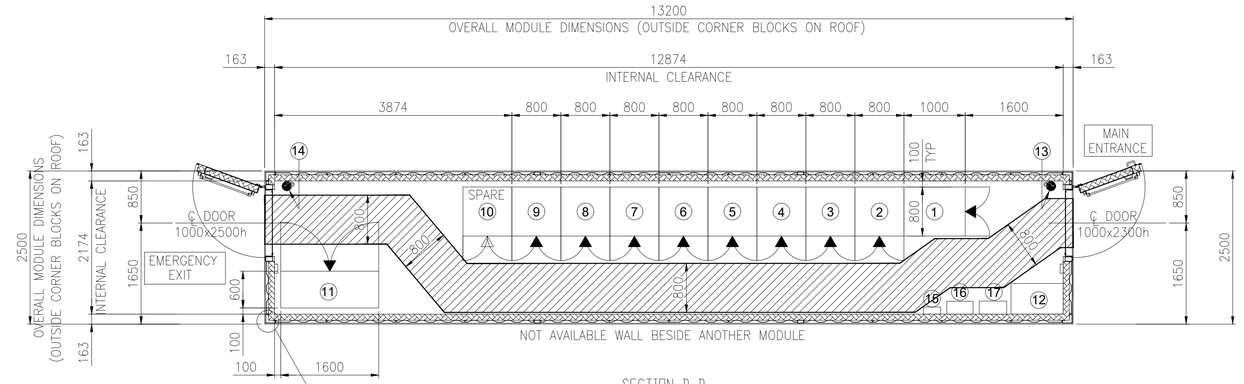


SECTION B-B

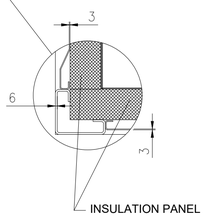

EQUIPMENT LAYOUT
"B-400" I&T EQUIPMENT ROOM
BOTTOM PLAN

EQUIPMENT LIST

REF.	TAG No.	DESCRIPTION	LENGTH (mm)	WIDTH (mm)	HEIGHT (mm)	WEIGHT (Kg)	NOTE
1	B400-SRV-001	SERVER CABINET	1000	800	2100	250	SINGLE CABINET
2	B400-NET-001	NETWORK CABINET	800	800	2100	250	SINGLE CABINET
3	B400-EMCS-001	EMCS SYSTEM CABINET	800	800	2100	250	SINGLE CABINET
4	B400-PCS-001	PCS SYSTEM CABINET	800	800	2100	250	DOUBLE CABINET
5	B400-PCS-002	PCS MARSHALLING CABINET	800	800	2100	250	
6	B400-FGS-001	FGS SYSTEM CABINET	800	800	2100	250	TRIPLE CABINET
7	B400-FGS-002	FGS MARSHALLING CABINET 1	800	800	2100	250	
8	B400-FGS-003	FGS MARSHALLING CABINET 2	800	800	2100	250	
9	B400-SIS-001	SIS SYSTEM/MARSHALLING CABINET	800	800	2100	250	SINGLE CABINET
10	-	SPARE					
11	B400-HSB-001	DISTRIBUTION & HVAC PANEL - I&T ROOM	1600	600	2300	1150	
12	-	TABLE	850	500	750	50	
13	-	PORTABLE EXTINGUISHER (CO2) 5 Kg.	150	150	750	20	
14	-	PORTABLE EXTINGUISHER (CO2) 5 Kg.	150	150	750	20	
15	-	FIRST AID KIT	280	115	200	10	
16	-	RESUSCITATION UNIT	430	210	480	10	
17	-	CABINET INCLUDED N.10 ESCAPE MASK	448	213	422	15	
18	HHU-77007	AIR HANDLING UNIT A	2100	1000	2158	850	
19	HHU-77008	AIR HANDLING UNIT B	2100	1000	2158	850	
20	HSS-77-010	SPACE HEATER 1	184	145	1100	5	
21	HSS-77-011	SPACE HEATER 2	184	145	1100	5	
22	HSS-77-012	SPACE HEATER 3	184	145	1100	5	

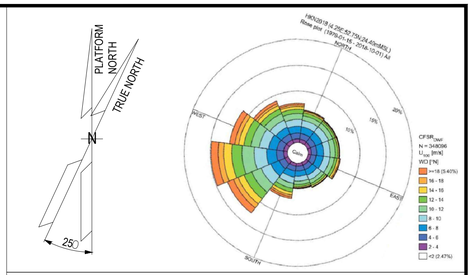

NOTE

1) ALL DIMENSIONS ARE IM MM.
2) THE POSITION OF THE LAMPS INDICATED IS TO BE CONSIDERED THE THEORETICAL ONE, THE FINAL ONE WILL BE CONFIRMED IN THE AS-BUILT ISSUE.

REFERENCE


DOCUMENT TITLE	DOCUMENT NUMBER
"B-400" HVAC SYSTEM G.A. & DETAILS	1724000049-HV-DA-00067
"B-400" DETAILED DRAWING	1724000049-AR-DD-00021
PAINTING PROCEDURE	1724000049-MAT-PRO-00007
"B-400" FOUNDATION	1724000049-ST-DD-00013
"B-400" STRUCTURAL CALCULATION	1724000049-ST-CA-00009

LEGEND

- INTERNAL LIGHT
- E INTERNAL EMERGENCY LIGHT
- SOCKET OUTLET, INDOOR
- LIGHT SWITCH
- ESCAPE CORRIDOR - WIDTH 800mm.
- MAINTENANCE AREA - VENDOR REQUIREMENT
- INSULATION PANEL

HOLDS

KEY PLAN

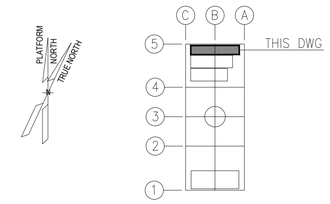

ALEXSISTEMI spa

REV.	DATE	DRN	CHKD	APPD	DESCRIPTION
04	22/10/24	M.G.	SKV	C.A.	ACCEPTED FOR CONSTRUCTION (AFC)
03	23/07/24	M.G.	SKV	C.A.	ACCEPTED FOR CONSTRUCTION (AFC)
02	04/07/24	M.G.	SKV	C.A.	ACCEPTED FOR CONSTRUCTION (AFC)
01	16/05/24	M.G.	SKV	C.A.	ISSUE FOR REVIEW (IFR)
00	08/02/24	A.G.	SKV	C.A.	ISSUE FOR CLIENT REVIEW (ICR)

CROSSWIND

ROSETTI MARINO


TITLE :
BASE LOAD POWER HUB (BLPH)
B-400 GENERAL ARRANGEMENT DRAWINGS

CONTRACT NO./TITLE CONTRACT_NO. 1724000049			SCALE 1:50
DRAWN M.G.	CHECKED SKV	APPROVED C.A.	DATE 22/10/24
A1	DRAWING NO. 1724000049-AR-DA-00017	SHEET 002	REV. 04


File Name : 1724000049-AR-DA-00017-REV.04

DRAWING NO. 1724000049-AR-DA-00017


REV. 04

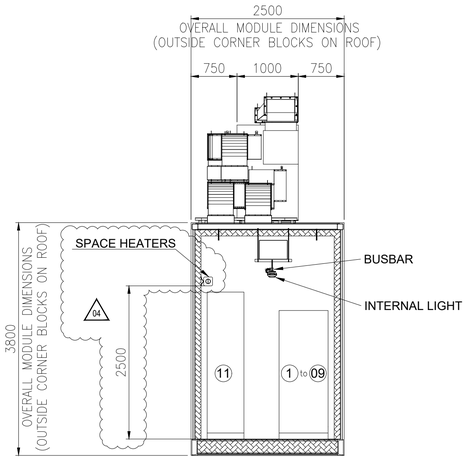

SECTION E-E

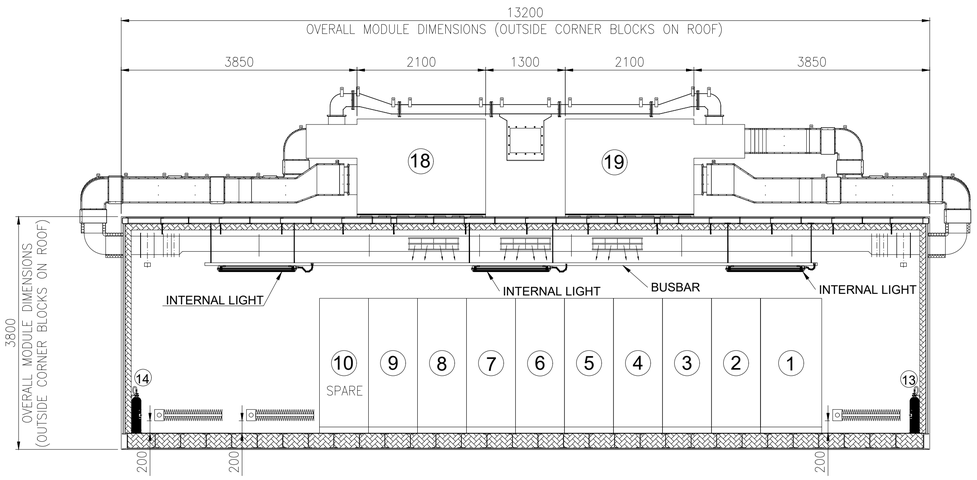


SECTION D-D

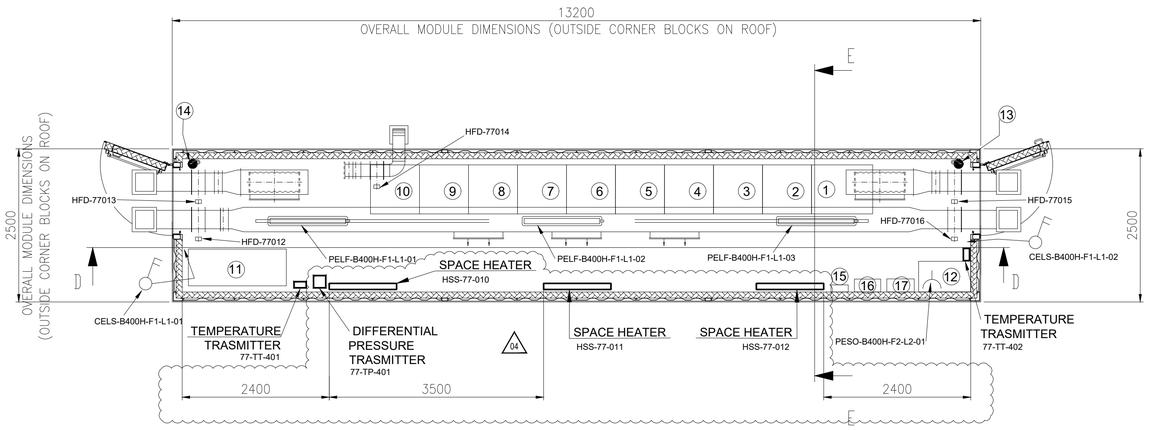

"B-400" I&T EQUIPMENT ROOM PLAN

EQUIPMENT LIST

REF.	TAG No.	DESCRIPTION	LENGTH (mm)	WIDTH (mm)	HEIGHT (mm)	WEIGHT (Kg)	NOTE
1	B400-SRV-001	SERVER CABINET	1000	800	2100	250	SINGLE CABINET
2	B400-NET-001	NETWORK CABINET	800	800	2100	250	SINGLE CABINET
3	B400-EMCS-001	EMCS SYSTEM CABINET	800	800	2100	250	SINGLE CABINET
4	B400-PCS-001	PCS SYSTEM CABINET	800	800	2100	250	DOUBLE CABINET
5	B400-PCS-002	PCS MARSHALLING CABINET	800	800	2100	250	
6	B400-FGS-001	FGS SYSTEM CABINET	800	800	2100	250	TRIPLE CABINET
7	B400-FGS-002	FGS MARSHALLING CABINET 1	800	800	2100	250	
8	B400-FGS-003	FGS MARSHALLING CABINET 2	800	800	2100	250	
9	B400-SIS-001	SIS SYSTEM/MARSHALLING CABINET	800	800	2100	250	SINGLE CABINET
10	-	SPARE					
11	B400-HSB-001	DISTRIBUTION & HVAC PANEL - I&T ROOM	1600	600	2300	1150	
12	-	TABLE	850	500	750	50	
13	-	PORTABLE EXTINGUISHER (CO2) 5 Kg.	150	150	750	20	
14	-	PORTABLE EXTINGUISHER (CO2) 5 Kg.	150	150	750	20	
15	-	FIRST AID KIT	280	115	200	10	
16	-	RESUSCITATION UNIT	430	210	480	10	
17	-	CABINET INCLUDED N.10 ESCAPE MASK	448	213	422	15	
18	HHU-77007	AIR HANDLING UNIT A	2100	1000	2158	850	
19	HHU-77008	AIR HANDLING UNIT B	2100	1000	2158	850	
20	HSS-77-010	SPACE HEATER 1	184	145	1100	5	
21	HSS-77-011	SPACE HEATER 2	184	145	1100	5	
22	HSS-77-012	SPACE HEATER 3	184	145	1100	5	

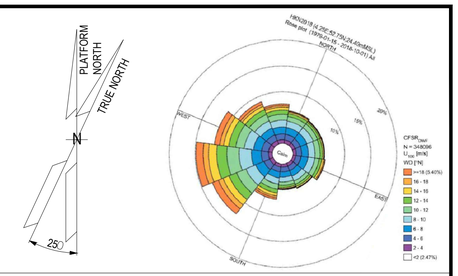

NOTE

1) ALL DIMENSIONS ARE IM MM.
2) THE POSITION OF THE LAMPS INDICATED IS TO BE CONSIDERED THE THEORETICAL ONE, THE FINAL ONE WILL BE CONFIRMED IN THE AS-BUILT ISSUE.

REFERENCE


DOCUMENT TITLE	DOCUMENT NUMBER
"B-400" HVAC SYSTEM G.A. & DETAILS	1724000049-HV-DA-00067
"B-400" DETAILED DRAWING	1724000049-AR-DD-00021
PAINTING PROCEDURE	1724000049-MAT-PRO-00007
"B-400" FOUNDATION	1724000049-ST-DD-00013
"B-400" STRUCTURAL CALCULATION	1724000049-ST-CA-00009

LEGEND

- INTERNAL LIGHT
- E — INTERNAL EMERGENCY LIGHT
- SOCKET OUTLET, INDOOR
- LIGHT SWITCH
- _____ ESCAPE CORRIDOR - WIDTH 800mm.
- _____ MAINTENANCE AREA - VENDOR REQUIREMENT
- _____ INSULATION PANEL

HOLDS

KEY PLAN

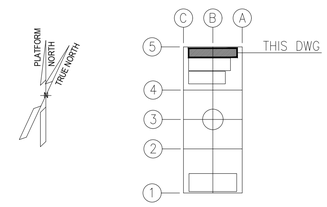

ALEXSISTEMI spa

REV.	DATE	DRN	CHKD	APPD	DESCRIPTION
04	22/10/24	M.G.	SKV	C.A.	ACCEPTED FOR CONSTRUCTION (AFC)
03	23/07/24	M.G.	SKV	C.A.	ACCEPTED FOR CONSTRUCTION (AFC)
02	04/07/24	M.G.	SKV	C.A.	ACCEPTED FOR CONSTRUCTION (AFC)
01	16/05/24	M.G.	SKV	C.A.	ISSUE FOR REVIEW (IFR)
00	08/02/24	A.G.	SKV	C.A.	ISSUE FOR CLIENT REVIEW (ICR)

CROSSWIND | ROSETTI MARINO

TITLE : BASE LOAD POWER HUB (BLPH)
B-400 GENERAL ARRANGEMENT DRAWINGS

CONTRACT NO./TITLE CONTRACT_NO. 1724000049			SCALE 1:50
DRAWN M.G.	CHECKED SKV	APPROVED C.A.	DATE 22/10/24
A1	DRAWING NO. 1724000049-AR-DA-00017	SHEET 003	REV. 04

File Name : 1724000049-AR-DA-00017-REV.04