
DRAWING NO. 1724000049-AR-DD-00062

REV. 01


ALLOWED

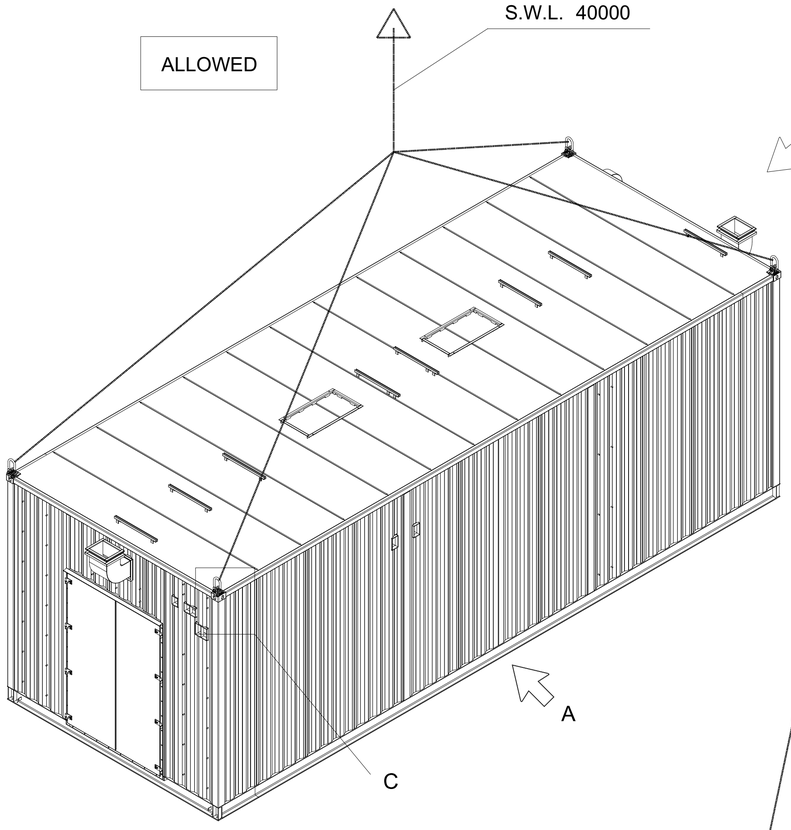

B-100

01

ALL INDICATIONS ON THIS DOCUMENT ARE THEORETICAL, ALL DEFINITIONS OF LOADS, LENGTHS AND SECTION OF SLINGS, TYPE OF SCHACKLES WILL BE DEFINED FOLLOWING THE PHYSICAL WEIGHING OF THE MANUFACTURED MODULE COMPLETE WITH ALL EQUIPMENT AND ACCESSORIES INCLUDING THE CORRECT DEFINITION OF THE CENTER OF GRAVITY.

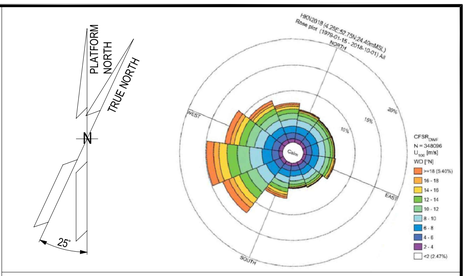

NOTE

1) ALL DIMENSIONS ARE IM MM.
2) BLPH WEIGHT: 40000 kg
3) USE ROPES/CHAINS FITTED WITH HOOKS WITH THE SAFETY WORKING LOAD OF 40000 kg
4) HOOKS, SHACKLE, SPREADER, ROPES/CHAINS ARE NOT IN THE ALEX-SISTEMI SCOPE OF SUPPLY

REFERENCE

DOCUMENT TITLE	DOCUMENT NUMBER
"B-100" GENERAL ARRANGEMENT DWGS	1724000049-AR-DA-00014
"B-100" STRUCTURAL CALCULATION	1724000049-ST-CA-00006

LEGEND

C.O.G. _____ CENTER OF GRAVITY


DETAIL D

DETAIL E


FLEX LINK DIMENSIONS

ISO LIFT LUG ASS'Y (S20901AA)

DETAIL C

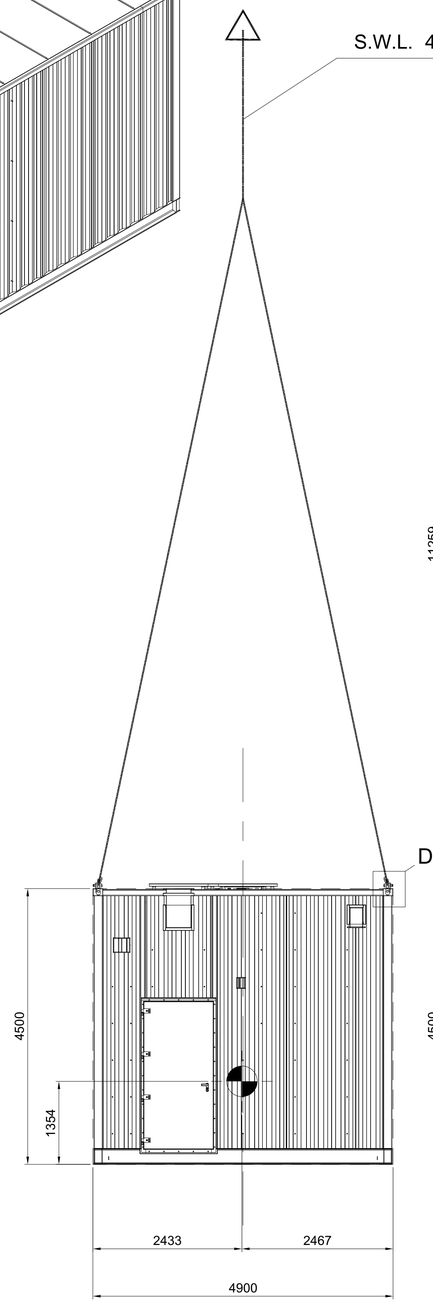

VIEW FROM "B"

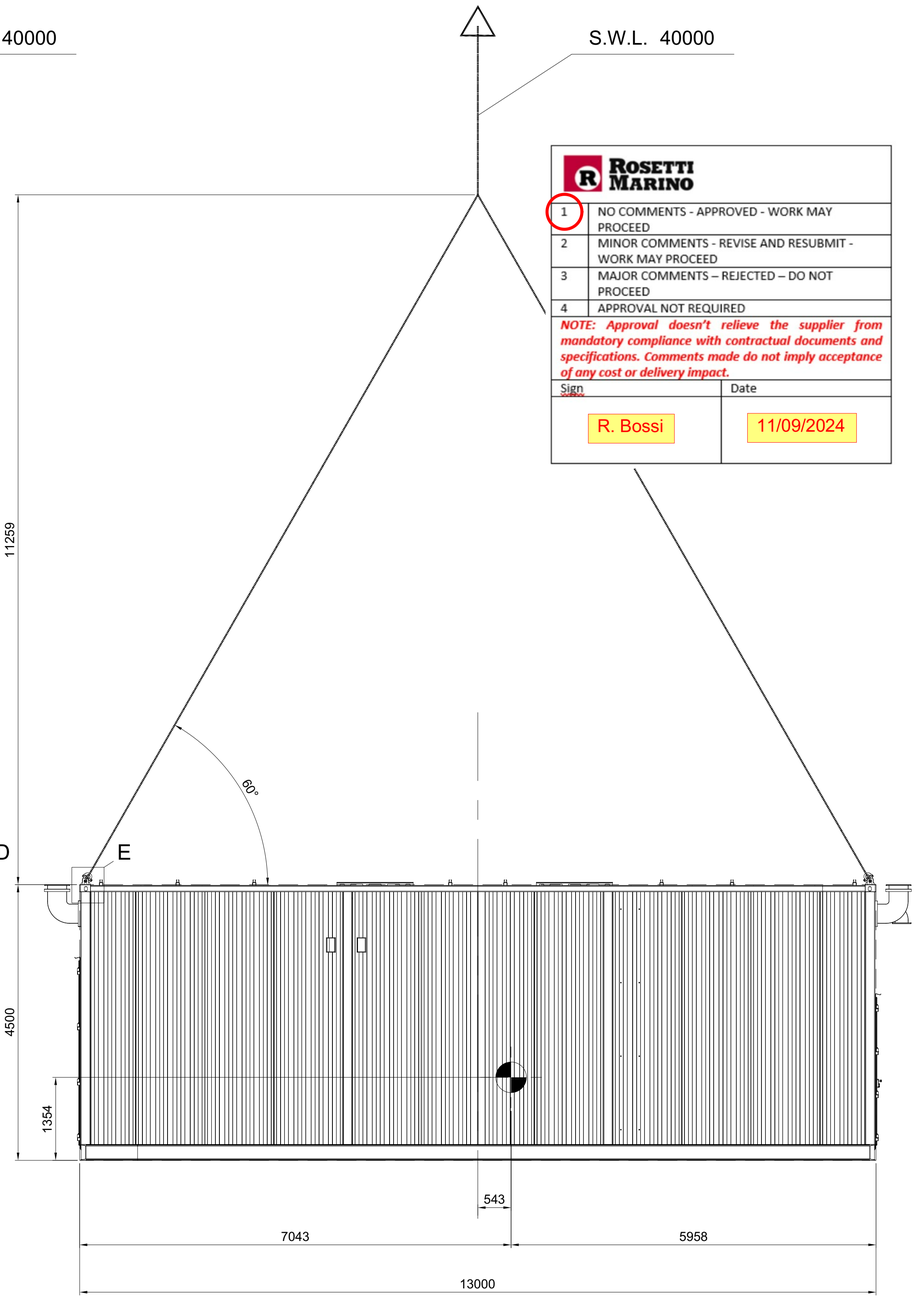

VIEW FROM "A"


ROSETTI MARINO	
1	NO COMMENTS - APPROVED - WORK MAY PROCEED
2	MINOR COMMENTS - REVISE AND RESUBMIT - WORK MAY PROCEED
3	MAJOR COMMENTS – REJECTED – DO NOT PROCEED
4	APPROVAL NOT REQUIRED

NOTE: Approval doesn't relieve the supplier from mandatory compliance with contractual documents and specifications. Comments made do not imply acceptance of any cost or delivery impact.

Sign	Date
R. Bossi	11/09/2024

HOLDS

KEY PLAN

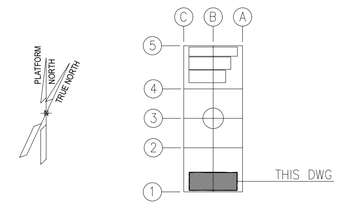

ALEXSISTEMI spa

REV.	DATE	DRN	CHKD	APPD	DESCRIPTION
01	02/08/24	F.P.	SKV	C.A.	ISSUE FOR INFORMATION (IFI)
00	04/07/24	F.P.	SKV	C.A.	ISSUE FOR INFORMATION (IFI)

CROSSWIND | ROSETTI MARINO

TITLE :

BASE LOAD POWER HUB (BLPH)
LIFTING DRAWINGS
E&I SHELTERS


CONTRACT NO./TITLE CONTRACT_NO. 1724000049			SCALE 1:50
DRAWN F.P.	CHECKED SKV	APPROVED C.A.	DATE 02/08/24
A1	DRAWING NO. 1724000049-AR-DD-00062	SHEET 001	REV. 01

File Name : 1724000049-AR-DD-00062-REV.01

DRAWING NO. 1724000049-AR-DD-00062

REV. 01

ALLOWED

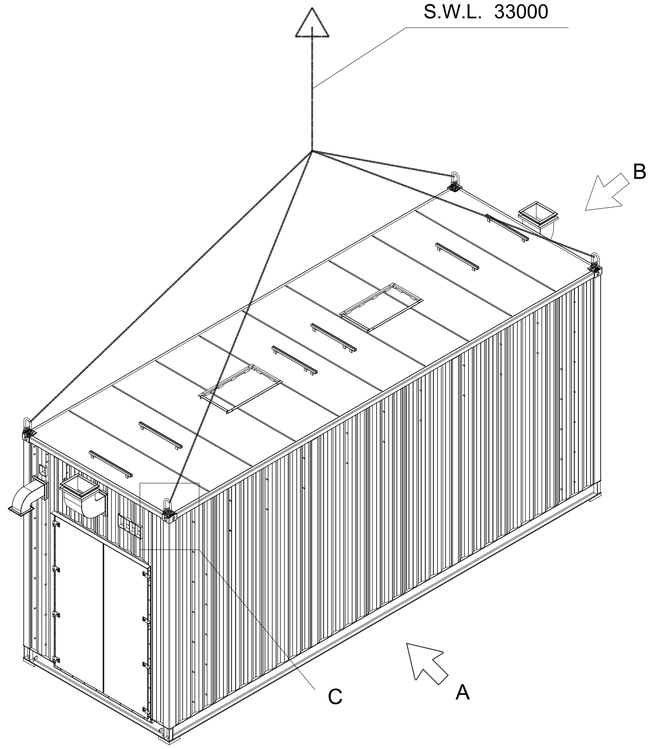

B-200

01

ALL INDICATIONS ON THIS DOCUMENT ARE THEORETICAL, ALL DEFINITIONS OF LOADS, LENGTHS AND SECTION OF SLINGS, TYPE OF SCHACKLES WILL BE DEFINED FOLLOWING THE PHYSICAL WEIGHING OF THE MANUFACTURED MODULE COMPLETE WITH ALL EQUIPMENT AND ACCESSORIES INCLUDING THE CORRECT DEFINITION OF THE CENTER OF GRAVITY.




DETAIL D


DETAIL E

FLEX LINK DIMENSIONS


ISO LIFT LUG ASS'Y (S20901AA)

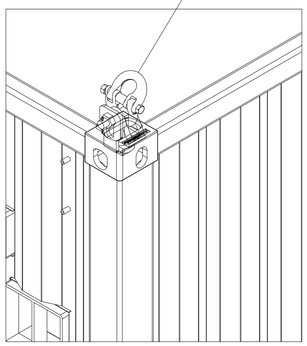


DETAIL C

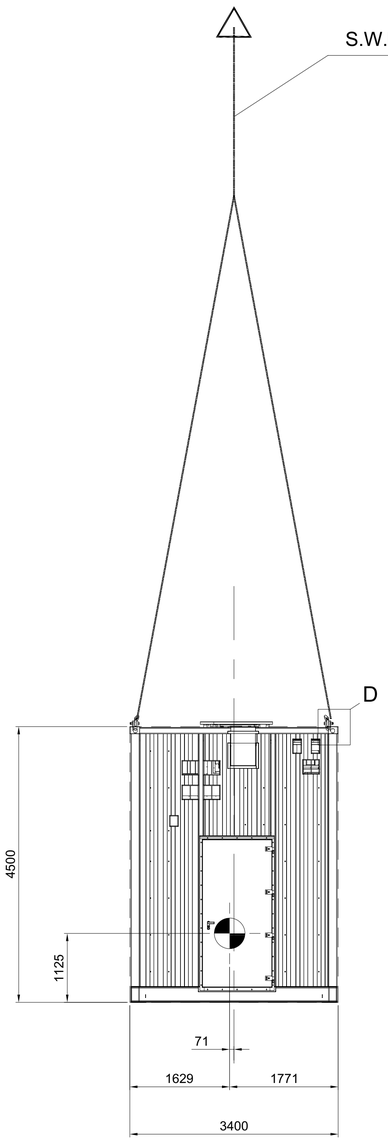

VIEW FROM "B"

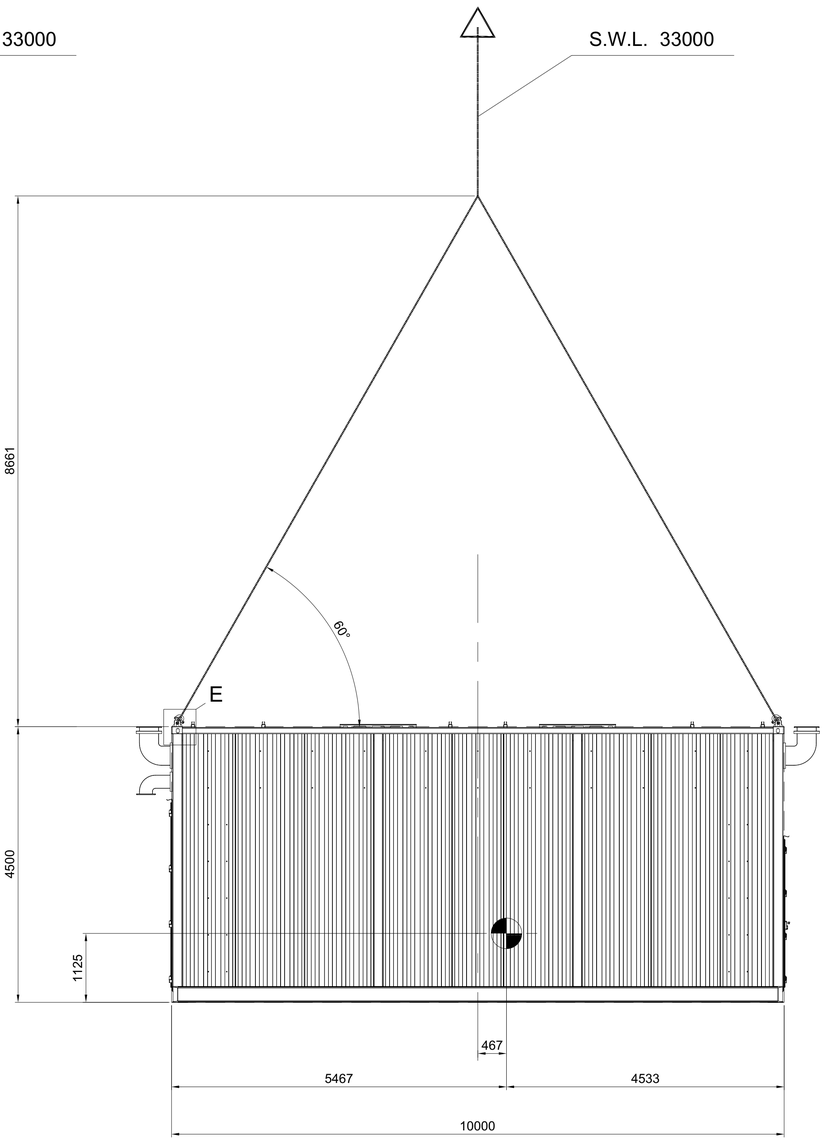

VIEW FROM "A"

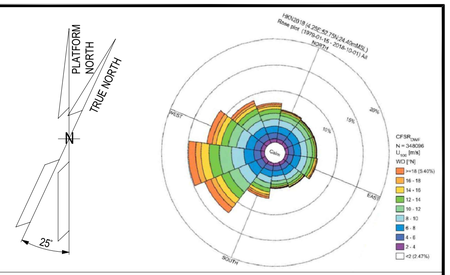

NOTE

1) ALL DIMENSIONS ARE IM MM.
2) BLPH WEIGHT: 33000 kg
3) USE ROPES/CHAINS FITTED WITH HOOKS WITH THE SAFETY WORKING LOAD OF 33000 kg
4) HOOKS, SHACKLE, SPREADER, ROPES/CHAINS ARE NOT IN THE ALEX-SISTEMI SCOPE OF SUPPLY

REFERENCE


DOCUMENT TITLE	DOCUMENT NUMBER
"B-200" GENERAL ARRANGEMENT DWGS	1724000049-AR-DA-00015
"B-200" STRUCTURAL CALCULATION	1724000049-ST-CA-00007

LEGEND

C.O.G. _____ CENTER OF GRAVITY

HOLDS

KEY PLAN

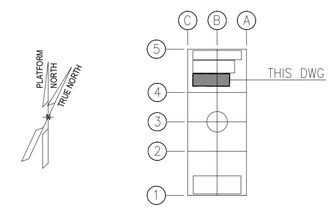

ALEXSISTEMI spa

REV.	DATE	DRN	CHKD	APPD	DESCRIPTION
01	02/08/24	F.P.	SKV	C.A.	ISSUE FOR INFORMATION (IFI)
00	04/07/24	F.P.	SKV	C.A.	ISSUE FOR INFORMATION (IFI)

CROSSWIND

ROSETTI MARINO

TITLE :

BASE LOAD POWER HUB (BLPH)
LIFTING DRAWINGS
E&I SHELTERS


CONTRACT NO./TITLE CONTRACT_NO. 1724000049			SCALE 1:50
DRAWN F.P.	CHECKED SKV	APPROVED C.A.	DATE 02/08/24
A1	DRAWING NO. 1724000049-AR-DD-00062	SHEET 002	REV. 01

File Name : 1724000049-AR-DD-00062-REV.01

DRAWING NO. 1724000049-AR-DD-00062

REV. 01


ALLOWED

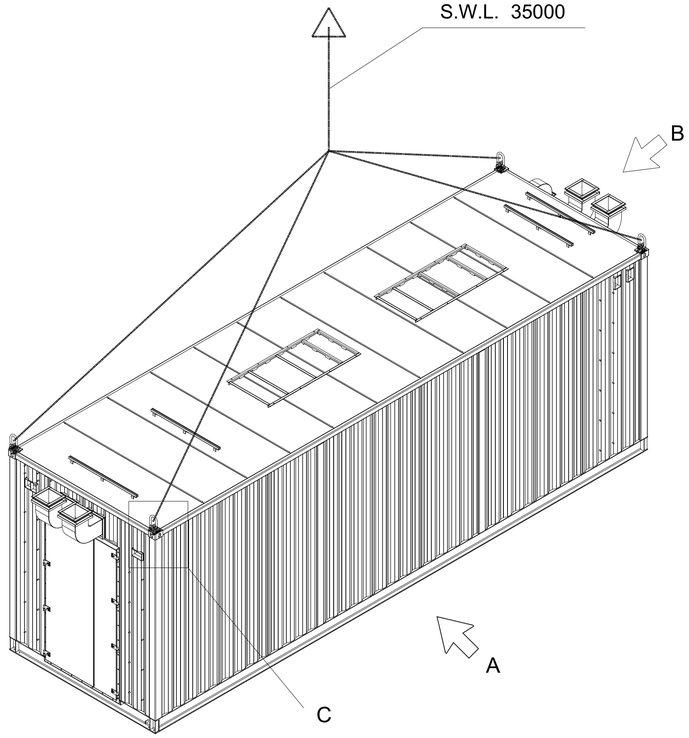

B-300

01

ALL INDICATIONS ON THIS DOCUMENT ARE THEORETICAL, ALL DEFINITIONS OF LOADS, LENGTHS AND SECTION OF SLINGS, TYPE OF SCHACKLES WILL BE DEFINED FOLLOWING THE PHYSICAL WEIGHING OF THE MANUFACTURED MODULE COMPLETE WITH ALL EQUIPMENT AND ACCESSORIES INCLUDING THE CORRECT DEFINITION OF THE CENTER OF GRAVITY.

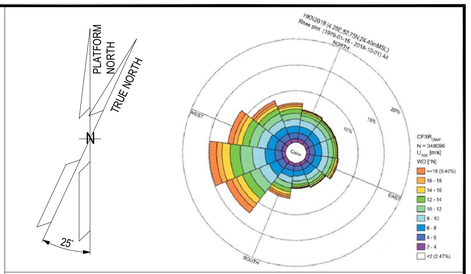

NOTE

1) ALL DIMENSIONS ARE IM MM.
2) BLPH WEIGHT: 35000 kg
3) USE ROPES/CHAINS FITTED WITH HOOKS WITH THE SAFETY WORKING LOAD OF 35000 kg
4) HOOKS, SHACKLE, SPREADER, ROPES/CHAINS ARE NOT IN THE ALEX-SISTEMI SCOPE OF SUPPLY


REFERENCE

DOCUMENT TITLE	DOCUMENT NUMBER
"B-300" GENERAL ARRANGEMENT DWGS	1724000049-AR-DA-00016
"B-300" STRUCTURAL CALCULATION	1724000049-ST-CA-00008

LEGEND

C.O.G. _____ CENTER OF GRAVITY

VIEW FROM "B"

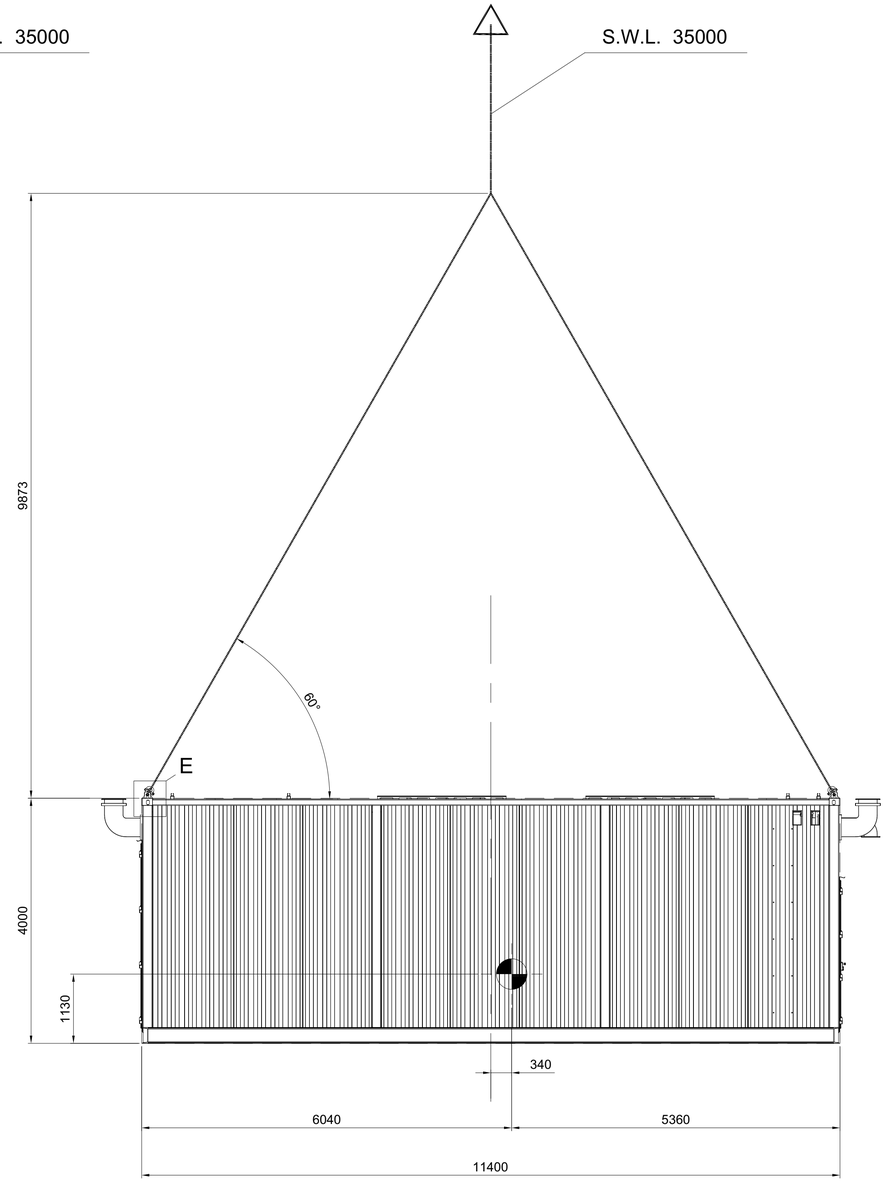

VIEW FROM "A"

DETAIL D

DETAIL E


FLEX LINK DIMENSIONS

ISO LIFT LUG ASS'Y (S20901AA)

DETAIL C

HOLDS

KEY PLAN

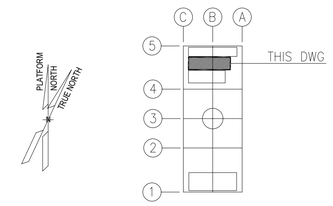

ALEXSISTEMI spa

REV.	DATE	DRN	CHKD	APPD	DESCRIPTION
01	02/08/24	F.P.	SKV	C.A.	ISSUE FOR INFORMATION (IFI)
00	04/07/24	F.P.	SKV	C.A.	ISSUE FOR INFORMATION (IFI)

CROSSWIND

ROSETTI MARINO

TITLE :

BASE LOAD POWER HUB (BLPH)
LIFTING DRAWINGS
E&I SHELTERS

CONTRACT NO./TITLE CONTRACT_NO. 1724000049			SCALE 1:50
DRAWN F.P.	CHECKED SKV	APPROVED C.A.	DATE 02/08/24
A1	DRAWING NO. 1724000049-AR-DD-00062	SHEET 003	REV. 01


File Name : 1724000049-AR-DD-00062-REV.01


DRAWING NO. 1724000049-AR-DD-00062

REV. 01


ALLOWED

B-400

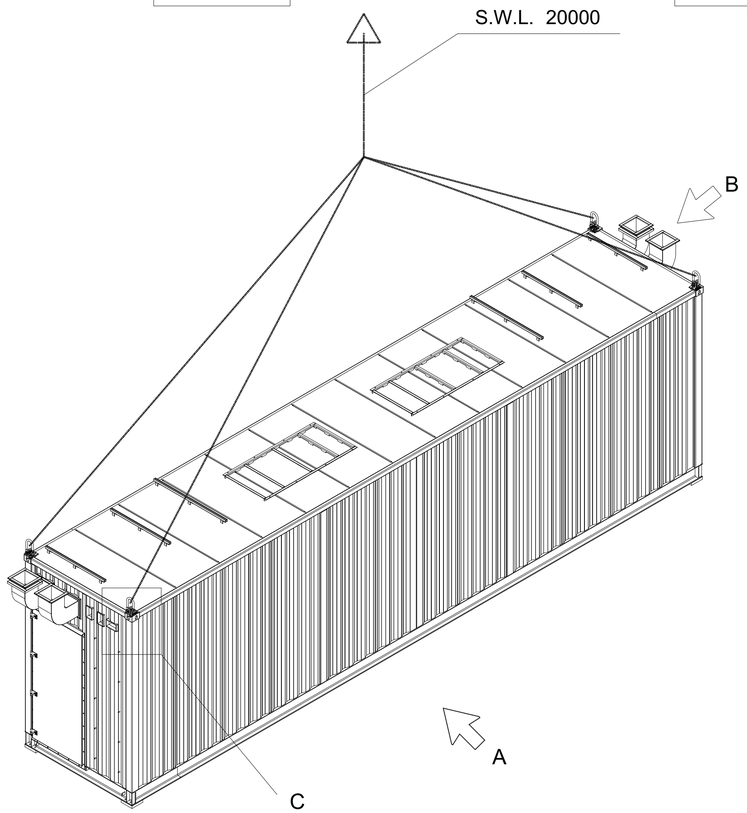


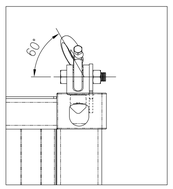

DETAIL D

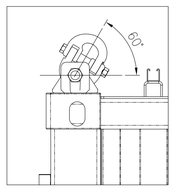


DETAIL E

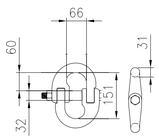

FLEX LINK DIMENSIONS


ISO LIFT LUG ASS'Y (S20901AA)

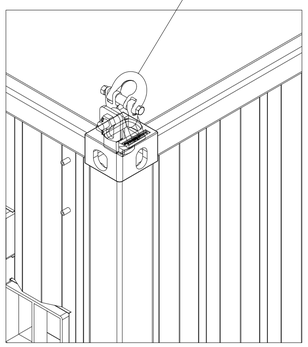


DETAIL C

01


ALL INDICATIONS ON THIS DOCUMENT ARE THEORETICAL, ALL DEFINITIONS OF LOADS, LENGTHS AND SECTION OF SLINGS, TYPE OF SCHACKLES WILL BE DEFINED FOLLOWING THE PHYSICAL WEIGHING OF THE MANUFACTURED MODULE COMPLETE WITH ALL EQUIPMENT AND ACCESSORIES INCLUDING THE CORRECT DEFINITION OF THE CENTER OF GRAVITY.

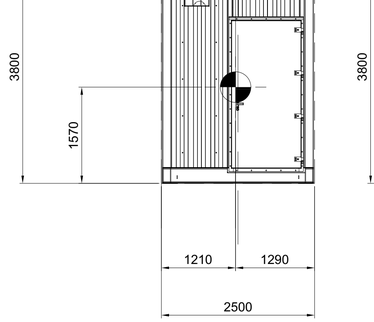

VIEW FROM "B"

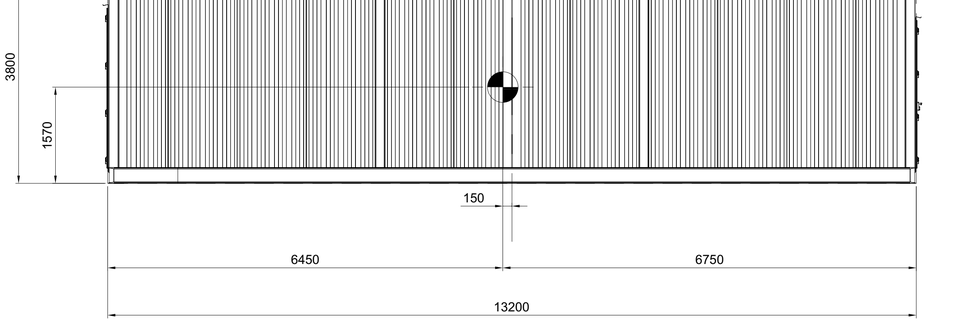

VIEW FROM "A"

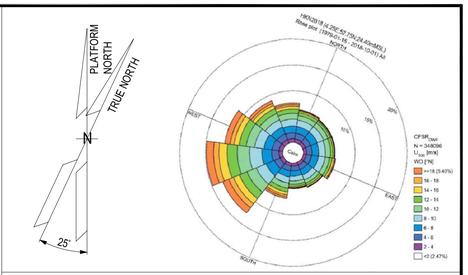

NOTE

1) ALL DIMENSIONS ARE IM MM.
2) BLPH WEIGHT: 20000 kg
3) USE ROPES/CHAINS FITTED WITH HOOKS WITH THE SAFETY WORKING LOAD OF 20000 kg
4) HOOKS, SHACKLE, SPREADER, ROPES/CHAINS ARE NOT IN THE ALEX-SISTEMI SCOPE OF SUPPLY

REFERENCE


DOCUMENT TITLE	DOCUMENT NUMBER
"B-400" GENERAL ARRANGEMENT DWGS	1724000049-AR-DA-00017
"B-400" STRUCTURAL CALCULATION	1724000049-ST-CA-00009

LEGEND

C.O.G. _____ CENTER OF GRAVITY

HOLDS

KEY PLAN

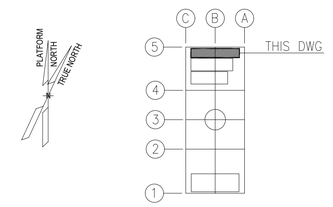

ALEXSISTEMI spa

REV.	DATE	DRN	CHKD	APPD	DESCRIPTION
01	02/08/24	F.P.	SKV	C.A.	ISSUE FOR INFORMATION (IFI)
00	04/07/24	F.P.	SKV	C.A.	ISSUE FOR INFORMATION (IFI)

CROSSWIND

ROSETTI MARINO

TITLE :

BASE LOAD POWER HUB (BLPH)
LIFTING DRAWINGS
E&I SHELTERS

CONTRACT NO./TITLE CONTRACT_NO. 1724000049			SCALE 1:50
DRAWN F.P.	CHECKED SKV	APPROVED C.A.	DATE 02/08/24
A1	DRAWING NO. 1724000049-AR-DD-00062	SHEET 004	REV. 01

File Name : 1724000049-AR-DD-00062-REV.01