Base Load Power Hub (BLPH)

DC UPS - BATTERY LAYOUT AND INTERCONNECTION DIAGRAM

umber: 1724000372-EL-DG-00010

Document Class: 2

ROSETTI MARINO

1	NO COMMENTS - APPROVED - WORK MAY PROCEED
2	MINOR COMMENTS - REVISE AND RESUBMIT - WORK MAY PROCEED
3	MAJOR COMMENTS – REJECTED – DO NOT PROCEED
4	APPROVAL NOT REQUIRED

NOTE: Approval doesn't relieve the supplier from mandatory compliance with contractual documents and specifications. Comments made do not imply acceptance of any cost or delivery impact.

Sign	Date
	27/02/2025

Rev.	Date	Description	Prepared	Reviewed	Approved
06	27/02/2025	As Built (ASB)	DA	DA	AD
05	17/12/2024	As Built (ASB)	DA	DA	AD
04	05/10/2024	Accepted for Construction (AFC)	DA	DA	AD
03	04/08/2024	Accepted for Construction (AFC)	DA	DA	AD
02	01/06/2024	Accepted for Construction (AFC)	DA	DA	AD
01	15/05/2024	Accepted for Construction (AFC)	DA	DA	AD
00	21/04/2024	Issue for Review (IFR)	DA	DA	AD

3W power | a company of AEG POWER SOLUTIONS

This document undergoes an issuance cycle within EDMS Fusionlive". Its distribution is electronically controlled. Once printed shall be considered as "NOT CONTROLLED" copy

Revision / Change Log

Rev.	Description
00	Issue for Review (IFR)
01	Accepted for Construction (AFC)
02	Accepted for Construction (AFC)
03	Accepted for Construction (AFC)
04	Accepted for Construction (AFC)
05	As Built (ASB)
06	As Built (ASB)

HOLDS LIST

No.	Description
1	
2	
3	
4	

This document undergoes an issuance cycle within EDMS Fusionlive". Its distribution is electronically controlled. Once printed shall be considered as "NOT CONTROLLED" copy

Table of contents

Description — Sheet

COVER 1

REVISION / CHANGE LOG 2

HOLDS LIST 2

TABLE OF CONTENTS 3

DC UPS - TAG: UP-200F1 4

DC UPS - TAG: UP-200F1 - BATTERY PROTECTION BOX 7

DC UPS - TAG: UP-200F1 - BLACK START PROCEDURE 10

This document undergoes an issuance cycle within EDMS Fusionlive". Its distribution is electronically controlled. Once printed shall be considered as "NOT CONTROLLED" copy


Base Load Power Hub (BLPH)

DC UPS - TAG: UP-200F1


BATTERY LAYOUT AND INTERCONNECTION DIAGRAM

This document undergoes an issuance cycle within EDMS Fusionlive". Its distribution is electronically controlled. Once printed shall be considered as "NOT CONTROLLED" copy

Battery Rack
BA-200F1

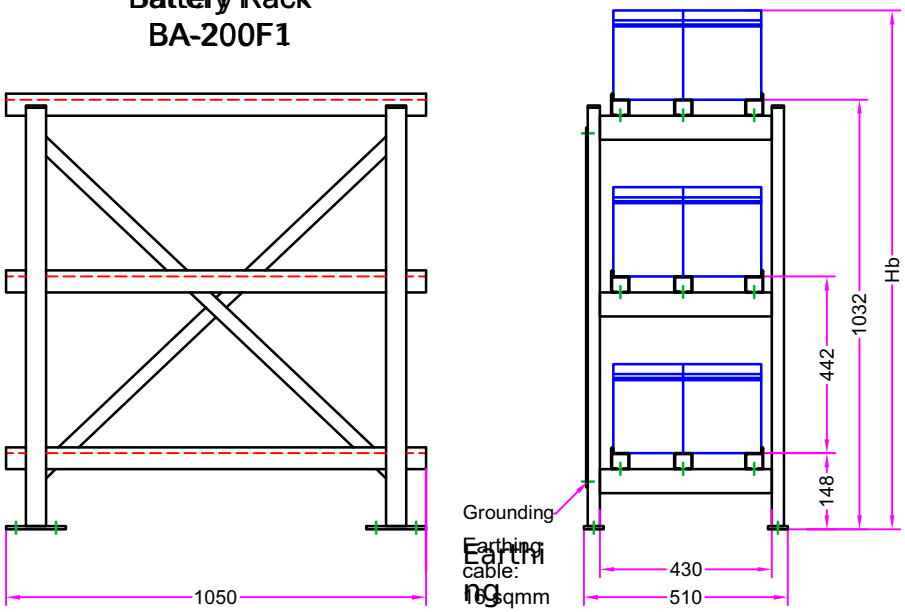

Foot-Print:

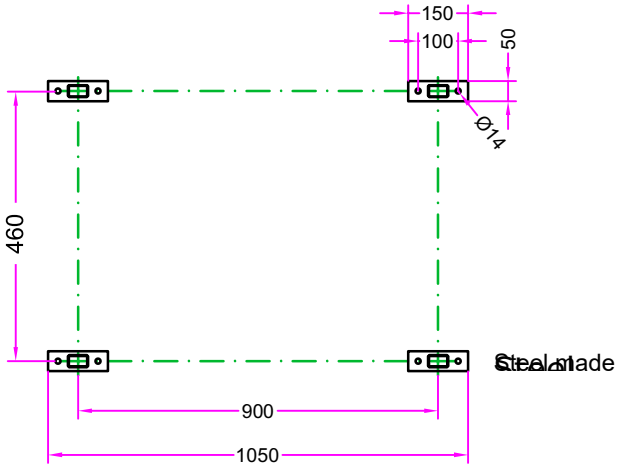

Steel made

Rack weight : 44,4 kg
Battery weight : 475,0 kg
Total weight : 519,4 kg

Material:	S235 JR EN 10025 (St-37-2)
Coating:	Plastic Coated
Tolerance:	DIN ISO 2768 "C"
Battery:	

Date	Name	Checked
16/24	Riedel	St.Selig

Scale: none

Execution: Rack, Standard

Drawing-/Article No: 3L2115


Rev: 00

Type: 3E-PGL 2-11 with FIX002


Production Details:

Welding execution according to


All rights are reserved with respect to this drawing. Without prior approval this drawing may neither be copied nor made accessible to third parties. Alterations serving technical improvement are reserved.

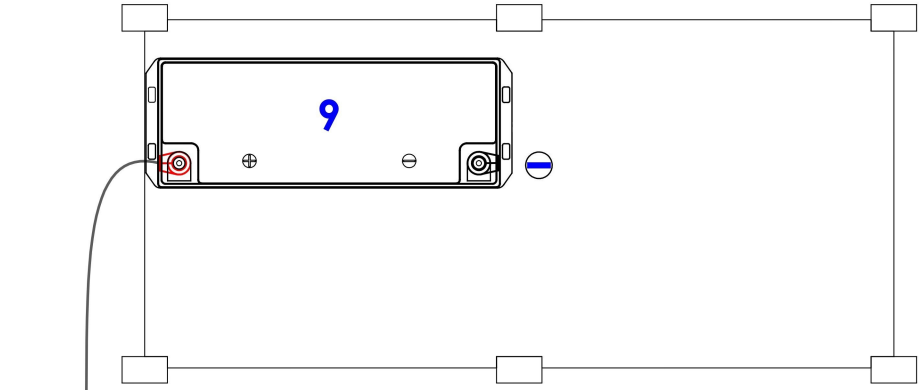

Tier 3

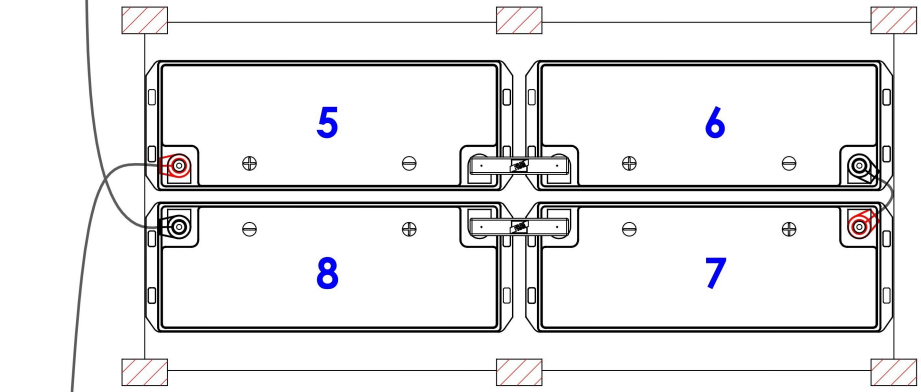


Tier 2

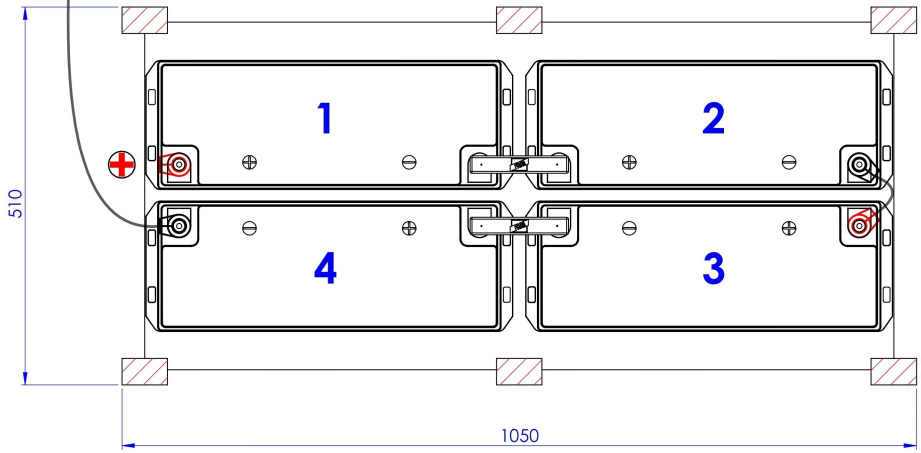

Tier 1

Battery block : FLG12-150

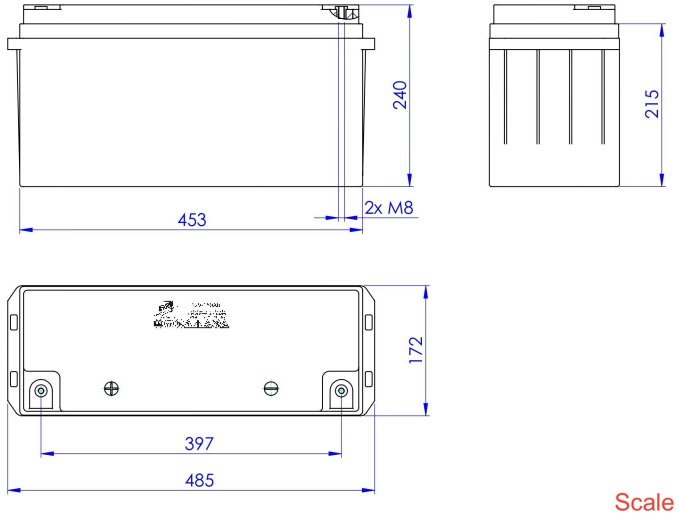

Scale 1:5

BILL OF MATERIALS	CODE	WEIGHT (kg)	Q.TY
CELL FLG 12-150	11000495	47,50	9
COPPER TIN STRIP FLL-FHP serie	41000222	0,04	4
CONNECTION AND AGM COVER CENTER DISTANCE 100	41000251	0,01	4
CELLS CONNECTION CABLE 50 mm	21000191	0,5	4 m
CABLE LUG F8 X 50	41005167	0,3	10
CABLE LUG COVER BLACK 50040	41000243	0,008	5
CABLE LUG COVER RED 50039	41000244	0,008	5

NOTE:

n.1 Battery block FLG 12-150
is supplied as spare part

TOLLERANZE GENERALI/GENERAL ALLOWANCES: NORMA UNI EN 22768-mk		TOTAL BATCH WEIGHT: 475.24 kg	PROGETTISTA/DESIGNER: P. VECCHIARELLI
NORMA UNI ISO 1302		TARE PLASTICS WEIGHT: 47.50 kg	DISEGNATO/DRAWN: P. VECCHIARELLI
NORMA UNI ISO 1101	10 FLG12-150		CONTROLLATO/CHECKED: F. PAGLIARINI
SCALA/SCALE: 1:5	FORMATO/SHEET SIZE: A2	CODICE BAT.TA/ASSY. BAT. CODE: 11000495	DATA/DATE: 10/04/2024
DESCRIZIONE/DESCRIPTION:			FILE - DISEGNO/FILE - DRAWING: layout
			FOGLIO/SHEET: 1

FAAM

1724000372-EL-DG-00010

DC UPS 10kW - 9 x FLG 12-150

Questo disegno è di proprietà della FIB e non può essere riprodotto o reso noto senza autorizzazione scritta.
This drawing is a proprietary and shall not be reproduced or released to otherwise autorized by FIB.

Base Load Power Hub (BLPH)

DC UPS - TAG: UP-200F1

BATTERY PROTECTION BOX

This document undergoes an issuance cycle within EDMS Fusionlive". Its distribution is electronically controlled. Once printed shall be considered as "NOT CONTROLLED" copy

MODEL C-225 REV.1

GENERAL NOTES:

-ENCLOSURE: EJBC-5
-MATERIAL: COPPER FREE ALUMINIUM ALLOY
-EXTERNAL PAINTING: RAL7035
-INTERNAL PAINTING: /
-ALL DIMENSION ARE IN mm
-WEIGHT: ≈55kg

BATTERY PROTECTION BOX

CB-200F1

SELECTOR SWITCHES DETAIL



TRUE TABLE

POSITION	CONTACT	
	1-2	3-4
OFF	O	O
ON	X	X

O	CONTACT OPEN
X	CONTACT CLOSED


TRUE TABLE

POSITION	CONTACT			
	1-2	3-4	5-6	7-8
NORMAL	X	O	X	O
OVERRIDE	O	X	O	X

O	CONTACT OPEN
X	CONTACT CLOSED


BOTTOM VIEW

1I: N°4 ØM20x1,5 ISO
2I: N°2 ØM25x1,5 ISO

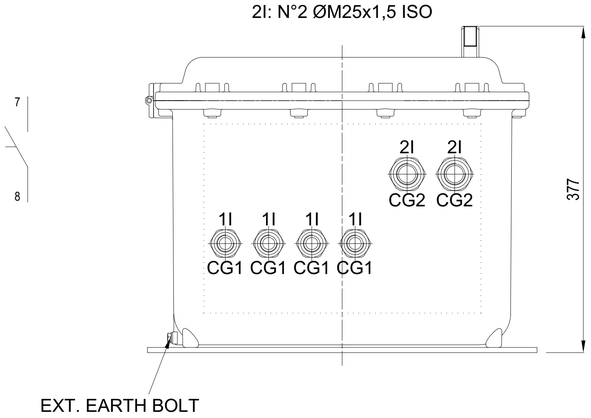


N°	Q.TY	CODE	DESCRIPTION
IF	1	BFE-5	ALUMINIUM INTERNAL FRAME
X1	2	UT35	PHOENIX TERMINALS SUITABLE FOR 35mm^2 CABLE
X2	2	UT35	PHOENIX TERMINALS SUITABLE FOR 35mm^2 CABLE
X3	11	UT4	PHOENIX TERMINALS SUITABLE FOR 4mm^2 CABLE
Q0	1	XT1B125TMD3	ABB XT1 MCCB, 3P, 125A, 18kA
	1	1SDA066399R1	220-240Vac/dc UNDERVOLTAGE RELEASE COIL
	2	1SDA066423R1	2NO AS PER TBE AUX CONTACTS FREE VOLTAGE
	1	M-0439/V1 + M-1044	PADLOCKABLE EXTERNAL HANDLE
F1,F2	2	UT4-HESI	PHOENIX FUSE HOLDER TERMINALS SUITABLE FOR 4mm^2 CABLE WITH 4A FUSE
	2	FUS5X20/4	
F3÷F8	6	UT4-HESI	PHOENIX FUSE HOLDER TERMINALS SUITABLE FOR 4mm^2 CABLE WITH 2,5A FUSE
	6	FUS5X20/2,5	
RLY	1	PHO2986575	PHOENIX SECURITY RELAY, 24Vcc, 3 EXCHANGE CONTACTS
R	1	RS1752429	47Ω RESISTOR, 95W, NOT ADJUSTABLE
D1÷D5	5	RS3959141	40A, 1000V, DIODES
S1	1	A2-10E/R	SELECTOR SWITCH, 2P, 16A, SCHEME I "OFF-ON"
	1	M-0553	EXTERNAL HANDLE
S2	1	WS2-10E/R	SELECTOR SWITCH, 4P, 16A, SCHEME 2Z "NORMAL-OVERRIDE"
	1	M-093/CF	KEY LOCK EXTERNAL HANDLE
CG1	4	NEV20IB	NICKEL PLATED BRASS CABLE GLANDS ØM20 FOR ARMORED CABLE Øint. 6,5-14mm Øext. 12,5-21mm, ARMOR THICKNESS 0,2-1,4mm
CG2	2	NAV25IB	NICKEL PLATED BRASS CABLE GLANDS ØM25 FOR NOT-ARMORED CABLE Ø11-20mm

INTERNAL VIEW

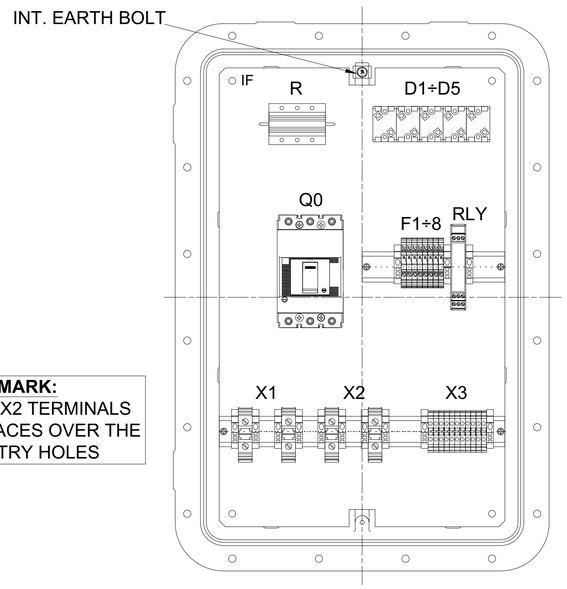


REMARK:
X1/X2 TERMINALS PLACES OVER THE ENTRY HOLES

EXTERNAL VIEW

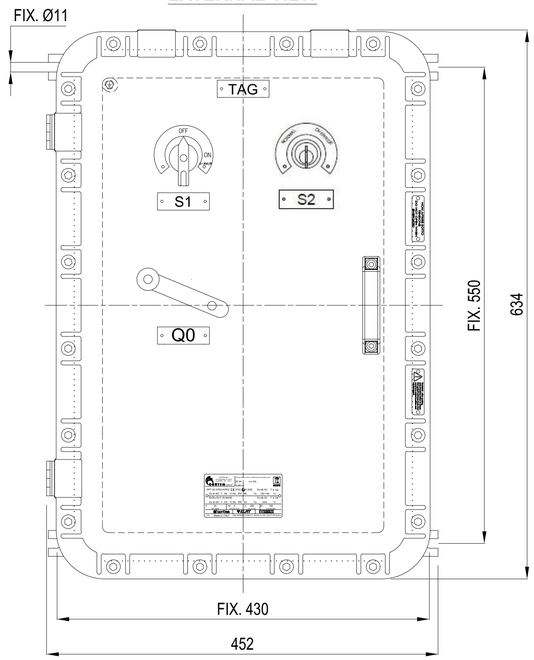

INT. LEFT SIDE VIEW

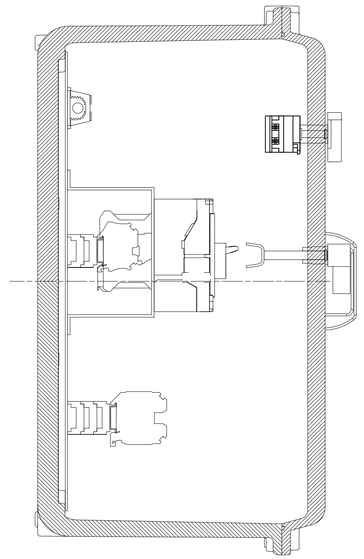

CERTIFICATE NAMEPLATE

CORTEM SpA
VIA AQUILEIA,10 34070
VILLESSE - GO ITALY
CORTEM GROUP
Enclosures for control, monitoring and signalling units:
20 24 s.n.24/...
EJBC-5
EPT 20 ATEX 4075X 0722 II 2GD Ex db IIC T 6 Gb
Ex tb IIIC T 85 °C Db IP6 66 Ta -20÷+40 °C
IECEx EUT 20.0024X Ex db IIC T X Gb
Ex tb IIIC T XX °C Db IP6 XX Ta XXX °C
V 240 max voltage | Hz 0 rated frequency | A 125 max current | W 160 max dissipated
U-606 Made in ITALY USE SCREWS QUALITY A2(A4)-70 UNI 7323 R 700 N/mm²

TAG NAMEPLATE

MATERIAL: TRAPHOLITE
DIMENSIONS: 60X20
BLACK TEXT ON WHITE BACKGROUND

N°	TAG N°
TAG	CB-200F1
S1	S1
S2	S2
Q0	Q0


THIS DRAWING IS PROPERTY OF CORTEM SPA
AND IT CANNOT BE REPRODUCED WITHOUT CORTEM'S AUTHORIZATION

REV.	DATE	PREP'D	CHK'D	APP'D	DESCRIPTION
1	24/05/2024	GRATTON	GIUSTI	GRATTON	MODIFIED AND REISSUED FOR APPROVAL
0	13/05/2024	BOGAR	GIUSTI	GRATTON	ISSUED FOR APPROVAL

DRAWING TITLE: DC UPS - TAG: UP-200F1
002 EJBC-5/C2401778/20.
ITEM 20
EXT/INT. LAYOUT

CORTEM JOB: COV2401778
DRAWING SCALE: /
DRAWING NUMBER: A3-C 27438
SHEET 3 NEXT 4 TOT. 4

Smart Professional R. 2012

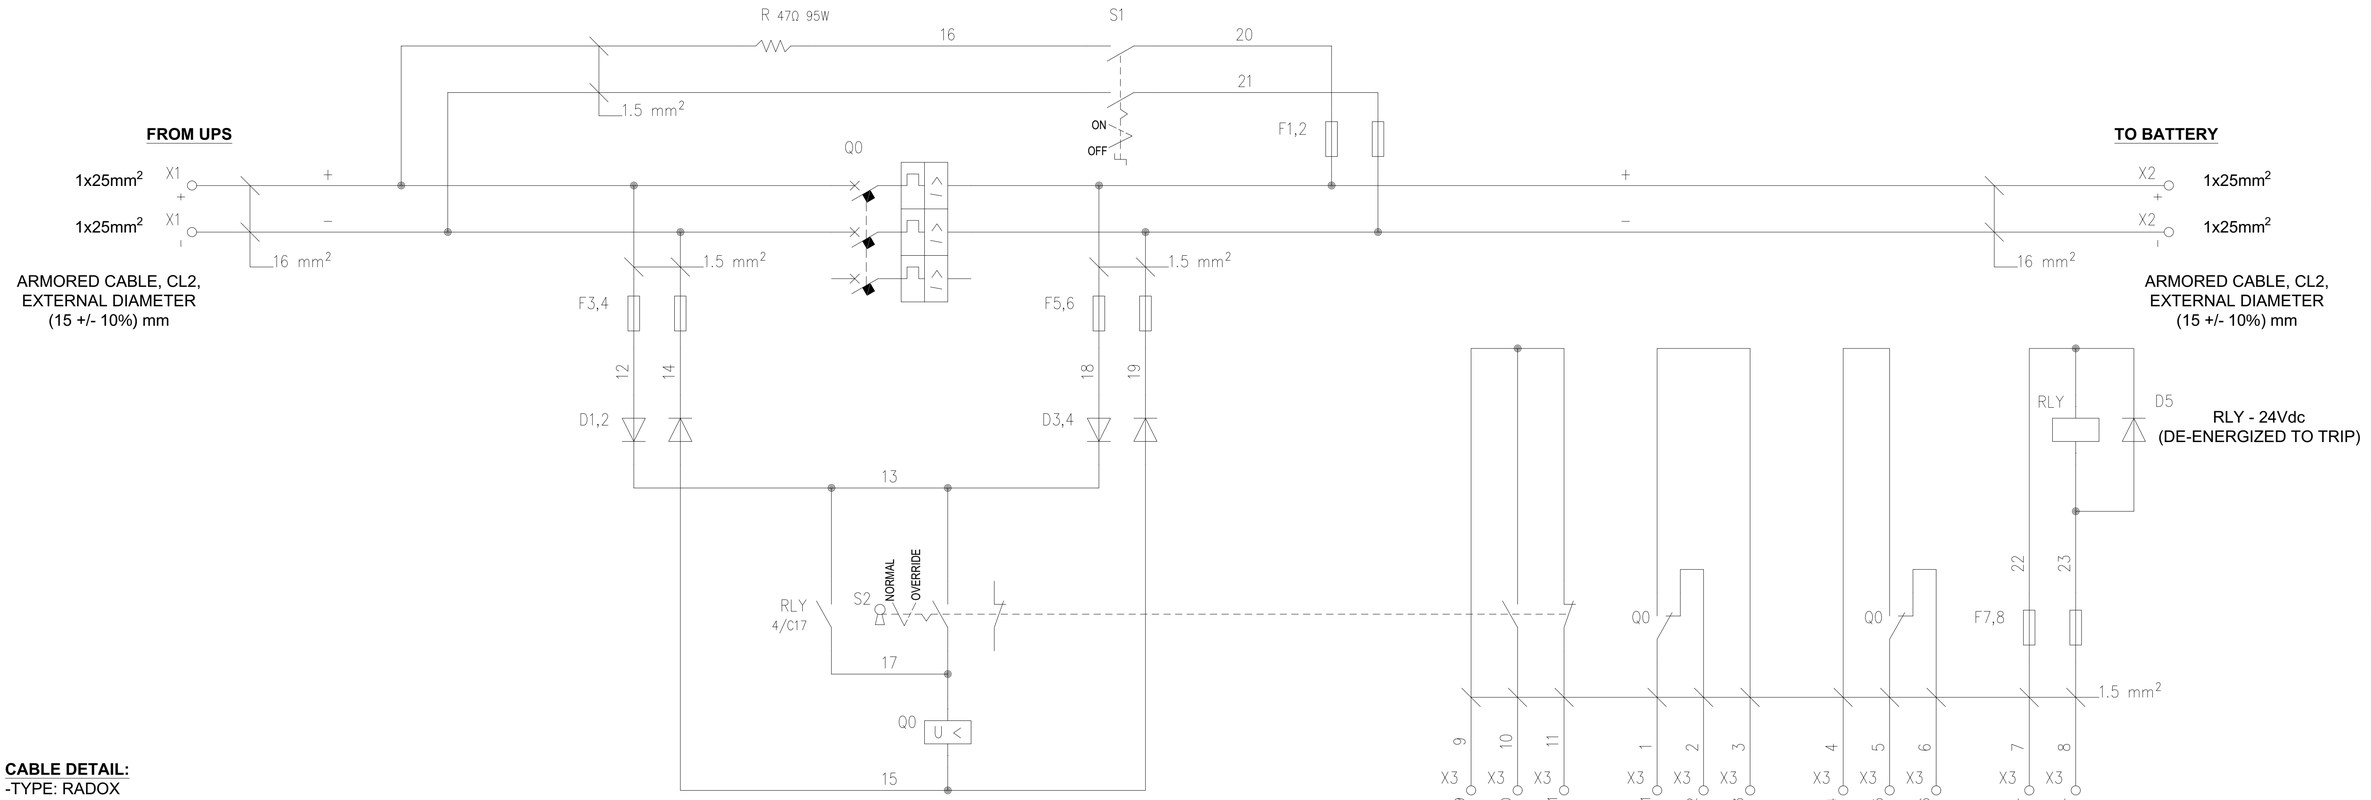

CABLE DETAIL:
-TYPE: RADOX
-COLORS: BLACK FOR (+) AND AUX
WHITE FOR (-)

CIRCUIT	DESCRIPTION			F3,4		Q0		F5,6		F1,2							F7,8						
	NUMBER																						
	PHASE	POWER	kW	+ -		+ -		+ -		+ -							+ -						
SWITCH	MANUFACTURER					ABB																	
	TYPE					XT3N200TMD3																	
	POLE N.	In	A			3	125																
	Idn A	CURVE																					
	Pdi kA	JUNCTION BOX N°				36kA																	
FUSE	TYPE			FUS5X20				FUS5X20		FUS5X20							FUS5X20						
	CURRENT		A	2,5				2,5		4							2,5						
CONTACTOR	TYPE																						
	In A	Pn	kW																				
THERMAL RELAY	TYPE																						
	CURRENT		A																				
TERMINALS CABLES	TERMINAL TYPE											UT				UT				UT			
	TERMINAL SECTION		mm²									4				4				4			
	TERMINAL NUMBER																						
	CABLE SECTION		mm²																				

REV.	DATE	PREP'D	CHK'D	APP'D	DESCRIPTION
1	24/05/2024	GRATTON	GIUSTI	GRATTON	MODIFIED AND REISSUED FOR APPROVAL
0	13/05/2024	BOGAR	GIUSTI	GRATTON	ISSUED FOR APPROVAL

DRAWING TITLE

DC UPS - TAG: UP-200F1

002 EJBC-5/C2401778/20.
ITEM 20
INTERNAL WIRING

CORTEM JOB: COV2401778
DRAWING SCALE: /
DRAWING NUMBER: A3-C 27438
SHEET 2 NEXT 3
TOT. 4

CORTEM GROUP
contem
FONDISONZO
ELFIT

THIS DRAWING IS PROPERTY OF CORTEM SPA
AND IT CANNOT BE REPRODUCED WITHOUT CORTEM'S
AUTHORIZATION

Smart Professional R. 2012

Base Load Power Hub (BLPH)

DC UPS - TAG: UP-200F1


BLACK START PROCEDURE

This document undergoes an issuance cycle within EDMS Fusionlive". Its distribution is electronically controlled. Once printed shall be considered as "NOT CONTROLLED" copy

AEG

POWER
SOLUTIONS

BLACK START PROCEDURE

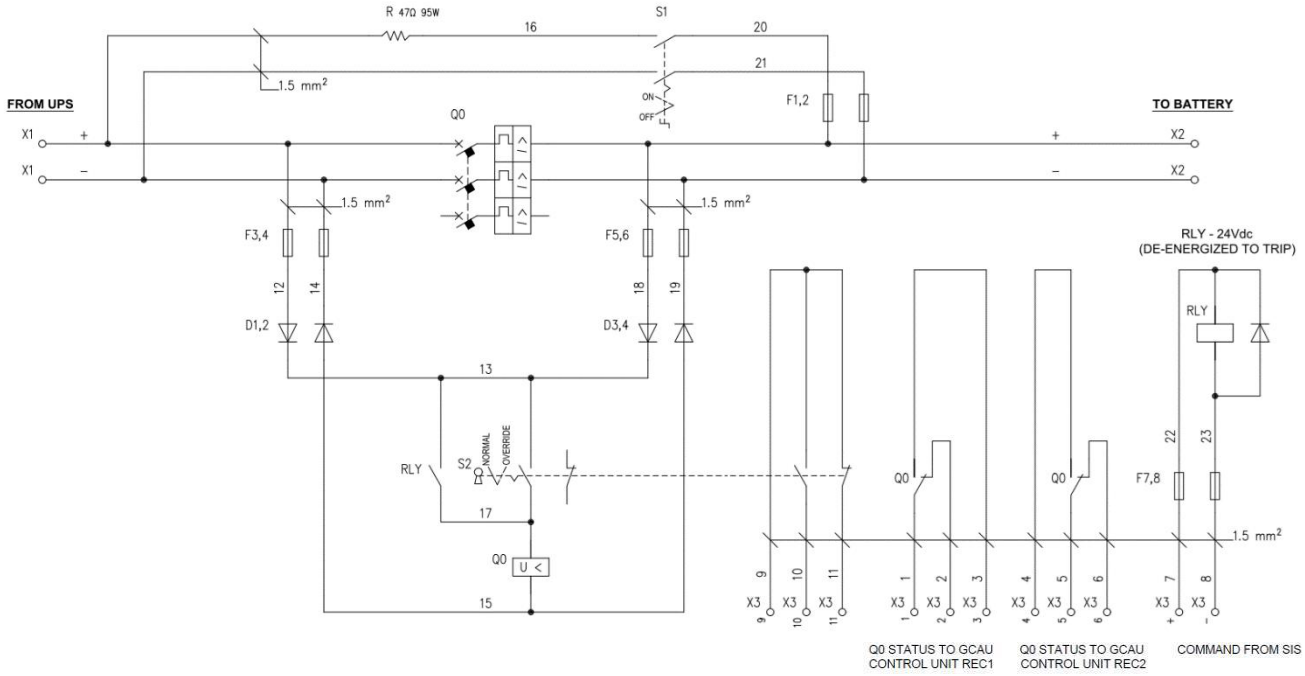

Black Start procedure

The target is to allow the energization of the loads from the battery, while the battery charger being still de-energized.

- The operator shall put the selector S2 on "override" position (contact closed)
- The operator shall close the selector S1 to pre-charge the charger output DC capacitors
- Once the charger DC capacitors are charged and the voltage across Q0 power contacts is close to 0V (and at least >80% of the system DC nominal voltage), the operator shall close the breaker Q0
- The operator shall open the selector S1
- The site safety and SCADA systems restart and the RLY relay is automatically energized when all safety conditions are fulfilled. The charger is energized through its AC supply and then it can restart
- The operator shall put the selector S2 on "normal" position (contact open)
- The system returns to normal working conditions