BASE LOAD POWER HUB (BLPH)

NAVIGATION AIDS SYSTEM

ELECTRICAL INTERCONNECTION DIAGRAMS

ROSETTI MARINO	
1	NO COMMENTS - APPROVED - WORK MAY PROCEED
2	MINOR COMMENTS - REVISE AND RESUBMIT - WORK MAY PROCEED
3	MAJOR COMMENTS – REJECTED – DO NOT PROCEED
4	APPROVAL NOT REQUIRED
NOTE: Approval doesn't relieve the supplier from mandatory compliance with contractual documents and specifications. Comments made do not imply acceptance of any cost or delivery impact.	
Sign	Date
	05/11/2024

05	28/10/24	A.B.	M.G.	R.M.	AS–BUILT (ASB)
04	16/10/24	A.B.	M.G.	R.M.	ACCEPTED FOR CONSTRUCTION (AFC)
03	26/09/24	A.B.	M.G.	R.M.	ACCEPTED FOR CONSTRUCTION (AFC)
02	19/07/24	A.B.	M.G.	R.M.	ISSUE FOR REVIEW (IFR)
01	03/07/24	A.B.	M.G.	R.M.	ISSUE FOR REVIEW (IFR)
00	31/05/24	A.B.	M.G.	R.M.	ISSUE FOR REVIEW (IFR)
REV.	DATE	DRN	CHKD	APPD	DESCRIPTION

SICE P.O. No : 1724000775 123A90A | SICE JOB No : JB–2416/C | SICE DOC. No : DW–864–4

sice

CROSSWIND | ROSETTI MARINO

TITLE : BASE LOAD POWER HUB (BLPH) ELECTRICAL INTERCONNECTION DIAGRAMS FRONT PAGE

CONTRACT NO./TITLE CW–I–WP4–2023–05/HOLLANDSE KUST NOORD WIND PARK | SCALE : NTS

A3	DRAWING NO.	SHEET	REV.
	1724000775–EL–DG–00007	001	05

F.to UNI A3: 420mmx297mm

File Name : 1724000775–EL–DG–00007 REV.5.DWG

REV. No.	SHEET No.	DESCRIPTION	REF. CODE
05	001	FRONT PAGE	
05	002	SUMMARY AND GENERAL NOTES	
05	003	NAVIGATION AIDS SYSTEM – ELECTRICAL INERCONNECTION DIAGRAMS	

GENERAL NOTES

(1) = EQUIPMENT TO BE PROVIDED BY OTHERS (NOT INCLUDED IN SICE SCOPE OF SUPPLY).

(2) = INTERCONNECTING CABLES TO BE PROVIDED BY OTHERS (NOT INCLUDED IN SICE SCOPE OF SUPPLY).

(3) = FOR A DETAILED LIST OF THE REMOTE SIGNALS, PLEASE REFER TO THE I/O LIST (DOC. No. 1724000775-EL-LIS-00011).

(4) = FEEDER TO BE CURVE D/K WITH RATED CURRENT 16A.

(5) = TEMPERATURE PROBE TO BE INSTALLED BY CUSTOMER IN THE BATTERY BOX.

SICE P.O. No : 1724000775 123A90A	SICE JOB No : JB-2416/C	SICE DOC. No : DW-864-4

sice

CROSSWIND

ROSETTI MARINO

REV.	DATE	DRN	CHKD	APPD	DESCRIPTION
05	28/10/24	A.B.	M.G.	R.M.	AS-BUILT (ASB)
04	16/10/24	A.B.	M.G.	R.M.	ACCEPTED FOR CONSTRUCTION (AFC)
03	26/09/24	A.B.	M.G.	R.M.	ACCEPTED FOR CONSTRUCTION (AFC)
02	19/07/24	A.B.	M.G.	R.M.	ISSUE FOR REVIEW (IFR)
01	03/07/24	A.B.	M.G.	R.M.	ISSUE FOR REVIEW (IFR)
00	31/05/24	A.B.	M.G.	R.M.	ISSUE FOR REVIEW (IFR)

TITLE : BASE LOAD POWER HUB (BLPH)
ELECTRICAL INTERCONNECTION DIAGRAMS
SUMMARY AND GENERAL NOTES

CONTRACT NO./TITLE CW-I-WP4-2023-05/HOLLANDSE KUST NOORD WIND PARK

SCALE : NTS

A3


DRAWING NO. 1724000775-EL-DG-00007

SHEET 002

REV. 05

F.to UNI A3: 420mmx297mm

File Name : 1724000775-EL-DG-00007 REV.5.DWG

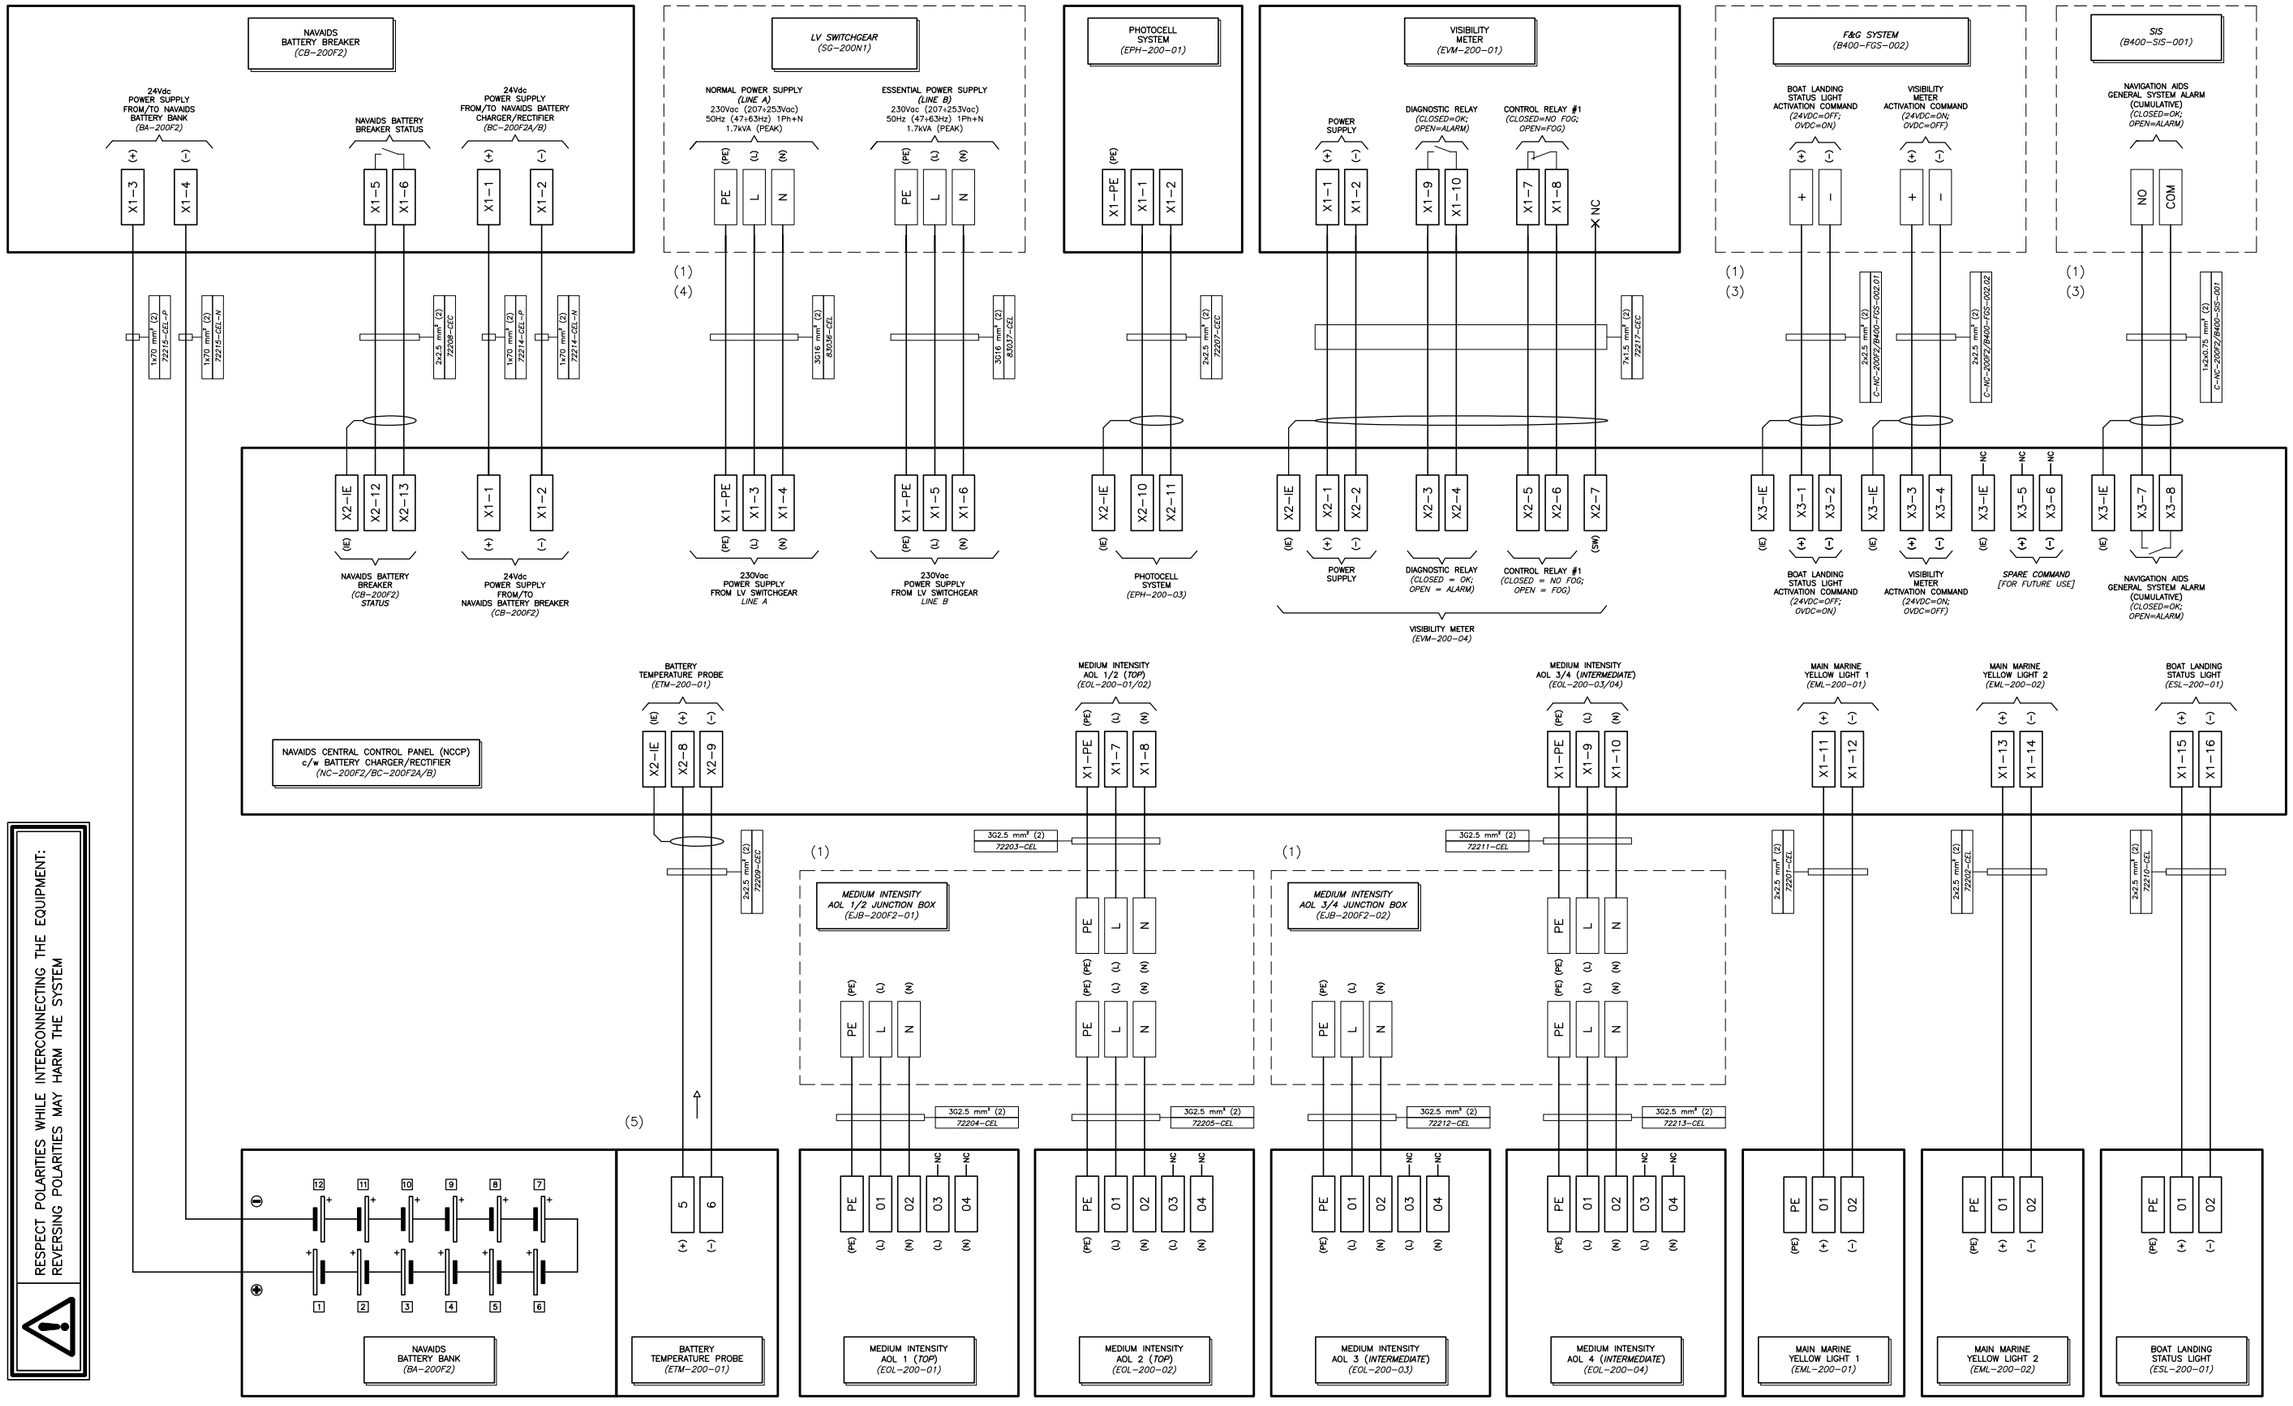

05	28/10/24	A.B.	M.G.	R.M.	AS-BUILT (ASB)
04	16/10/24	A.B.	M.G.	R.M.	ACCEPTED FOR CONSTRUCTION (AFC)
03	26/09/24	A.B.	M.G.	R.M.	ACCEPTED FOR CONSTRUCTION (AFC)
02	19/07/24	A.B.	M.G.	R.M.	ISSUE FOR REVIEW (IFR)
01	03/07/24	A.B.	M.G.	R.M.	ISSUE FOR REVIEW (IFR)
00	31/05/24	A.B.	M.G.	R.M.	ISSUE FOR REVIEW (IFR)
REV.	DATE	DRN	CHKD	APPD	DESCRIPTION

SICE P.O. No : 1724000775 123A90A | SICE JOB No : JB-2416/C | SICE DOC. No : DW-864-4

SICE ELETTRONICA sice

CROSSWIND | ROSETTI MARINO

TITLE : BASE LOAD POWER HUB (BLPH)
NAVIGATION AIDS SYSTEM
ELECTRICAL INTERCONNECTION DIAGRAMS

CONTRACT NO./TITLE CW-I-WP4-2023-05/HOLLANDSE KUST NOORD WIND PARK | SCALE : NTS

A3 | DRAWING NO. 1724000775-EL-DG-00007 | SHEET 003 | REV. 05

F.to UNI A3: 420mmx297mm

File Name : 1724000775-EL-DG-00007 REV.5.DWG