

DRAWING NO. 123A90-DDL-AR-DL-10011

REV. 02

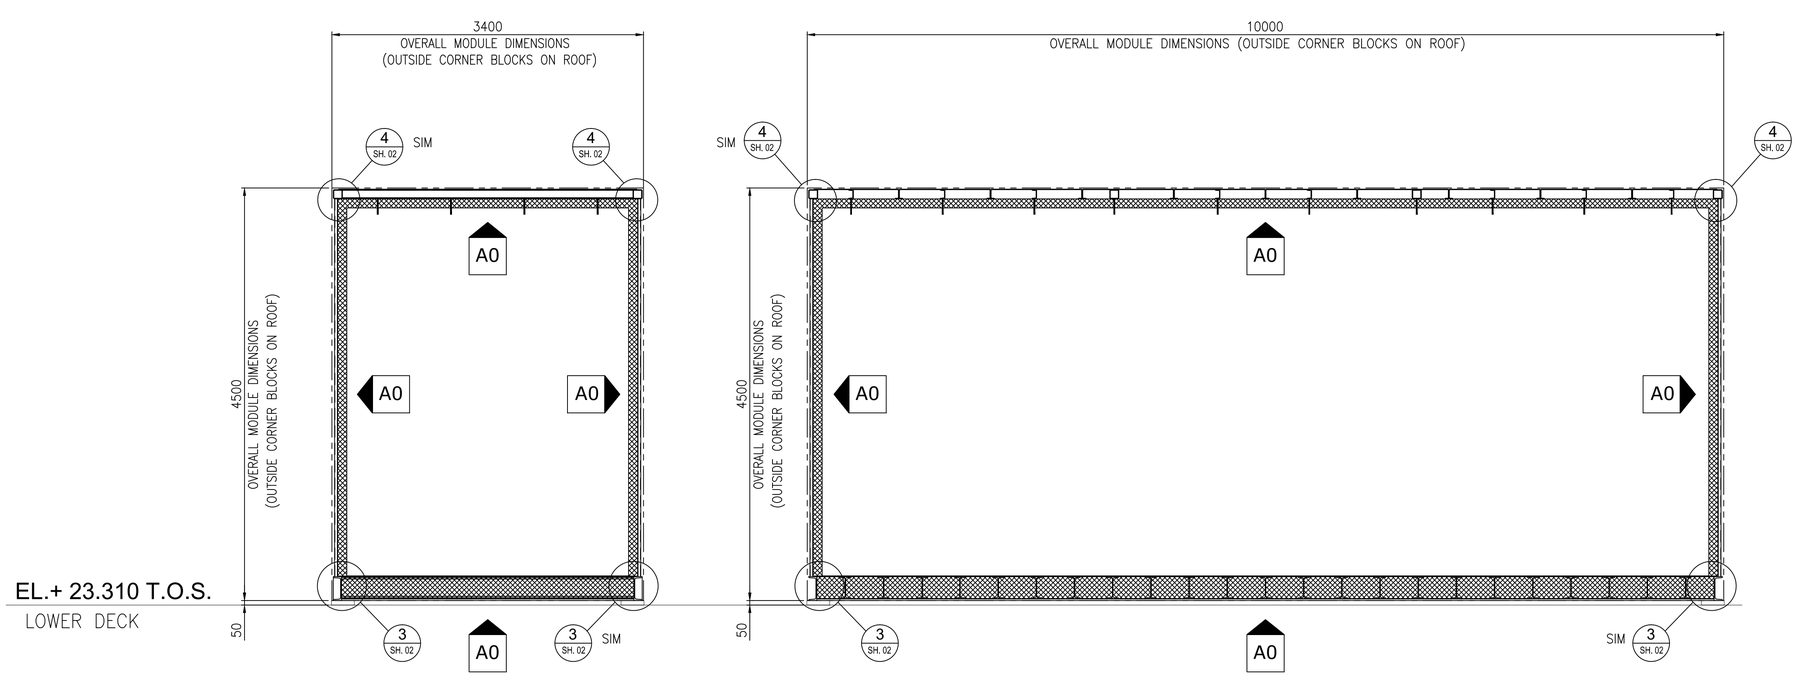

SECTION B -

SECTION A -

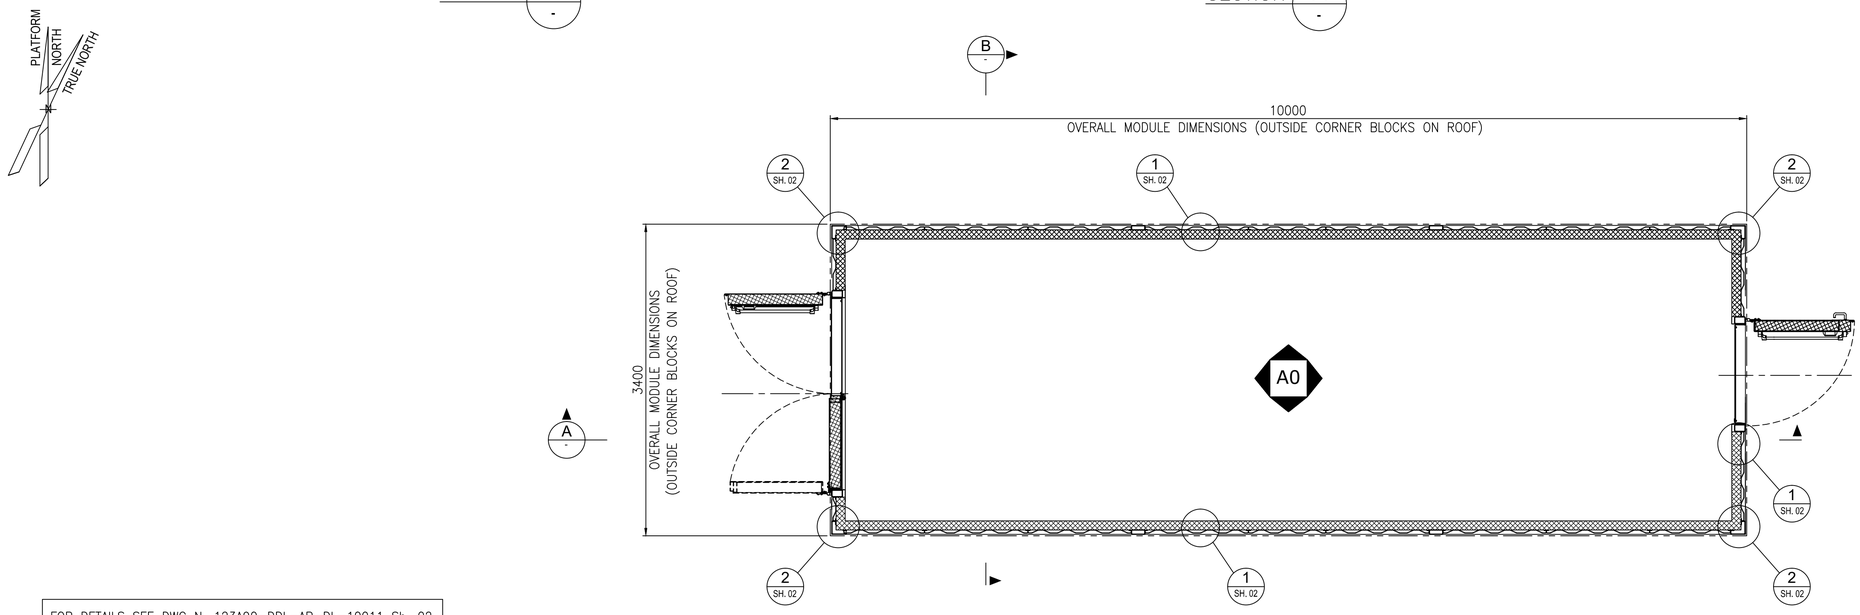

PLAN OF LV (400V) SWITCHGEAR ROOM B-200


FIRE SUBDIVISION and THERMAL & FIRE INSULATION

FOR DETAILS SEE DWG N. 123A90-DDL-AR-DL-10011 Sh. 02

FOR DETAILS SEE DWG N. 123A90-DDL-AR-DL-10011 Sh. 02

THERMAL INSULATION REQUIREMENTS

"U" VALUE = 0,45 [W/m2.K)] { ROOF, EXPOSED BULKHEAD, FLOOR EXPOSED BELOW, INTERNAL BULKHEAD

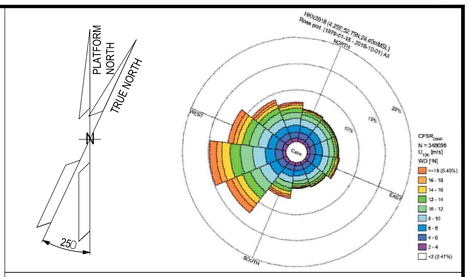

NOTES

1. U.N.O. ALL DIMENSIONS ARE IN MILLIMETERS.
2. FIRE RATING OF DOOR AND PENETRATION SHALL BE THE SAME AS WALL/DECK FIRE RATING.
3. FIRE PROOFING SHALL BE SUPPLIED WITH CERTIFICATE OF TYPICAL APPROVAL BY "IACS MEMBER".
4. FIRE PROOFING DETERMINED ACCORDING TO SOLAS CHAPTER II-2 REGULATION 9

LEGEND


U.N.O.	UNLESS NOTED OTHERWISE
T.O.S.	TOP OF STEEL
T.O.P.	TOP OF PLATE
T.O.F.	TOP OF FLOOR
℄	CENTER LINE
SIM	SIMILAR
T.B.D.	TO BE DEFINED
T.B.C.	TO BE COMFIRMED
A0 ▶	IMPACT DIRECTION OF POTENTIAL FIRE RESISTANCE CLASS

HOLDS

REFERENCE

DOCUMENT TITLE	DOCUMENT NUMBER
LV (400V) Switchroom – Supply Specification	123A90-DDL-AR-SP-10007
LV (400V) Switchroom – Architectural General Layout (plan, view, section & typical details)	123A90-DDL-AR-SP-10008
LV (400V) Switchroom – Doors Map and Schedule	123A90-DDL-AR-DL-10009
LV (400V) Switchroom – Flooring and Lining Layout	123A90-DDL-AR-DL-10010
B-200 General Arramgement Drawings (by Vendor)	1724000049-AR-DA-00015
B-200 Detail Drawings (by Vendor)	1724000049-AR-DD-00019

KEY PLAN

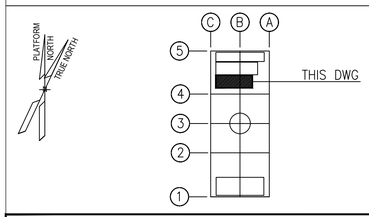

STILOG

REV.	DATE	DRN	CHKD	APPD	DESCRIPTION
02	18/09/25	SPS	M. GA	CGI	AS-BUILT (ASB)
01	12/03/24	R. BO	M. GA	D. LO	ACCEPTED FOR CONSTRUCTION (AFC)
00	17/10/23	R. BO	M. GA	D. LO	ISSUE FOR REVIEW (IFR)

CROSSWIND

ROSETTI MARINO

TITLE : BASE LOAD POWER HUB (BLPH)
LV (400V) SWITCHGEAR ROOM B-200 – ARCHITECTURAL
FIRE RATED REQ. – PLAN, SECTION & TYP. DET.


CONTRACT NO./TITLE CW-I-WP4-2023-05/HOLLANDSE KUST NOORD WIND PARK | SCALE 1:33

DRAWN SPS | CHECKED M. GATTI | APPROVED CGI | DATE 18/09/25


A1 | DRAWING NO. 123A90-DDL-AR-DL-10011 | SHEET 001 | REV. 02

File Name : 123A90-DDL-AR-DL-10011 REV.02

DRAWING NO. 123A90-DDL-AR-DL-10011 REV. 02

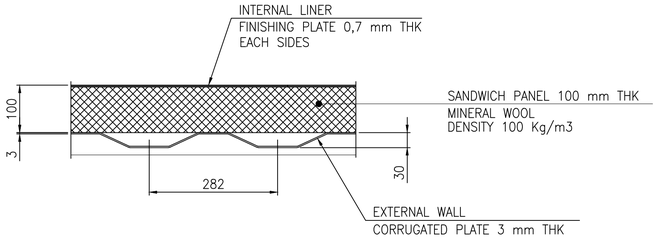


DETAIL 1 — WALL TYPICAL — SH. 01

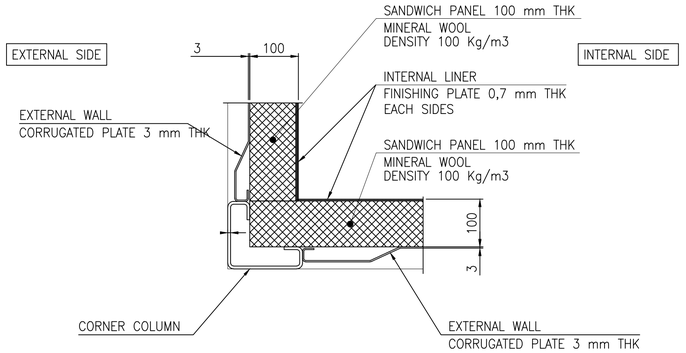


DETAIL 2 — AT PLAN CORNERS TYPICAL — SH. 01


FOR PLAN SEE DWG N. 123A90-DDL-AR-DL-10011 Sh. 01

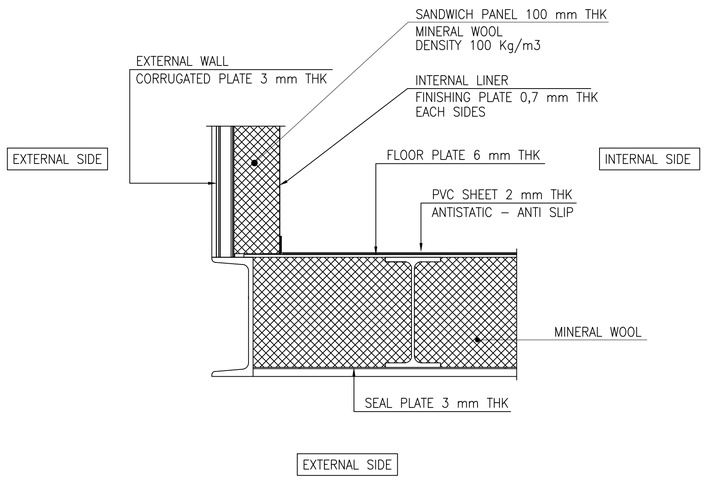

DETAIL 3 — AT BOTTOM CORNERS TYPICAL — SH. 01

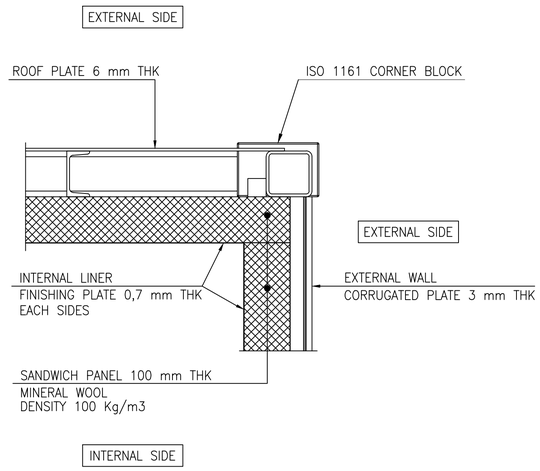

DETAIL 4 — AT TOP CORNERS TYPICAL — SH. 01

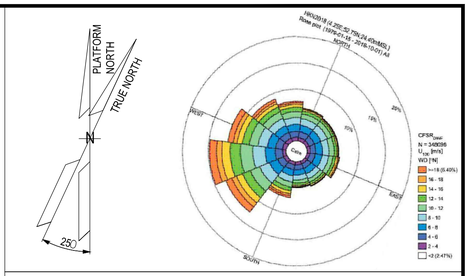

NOTES

1. U.N.O. ALL DIMENSIONS ARE IN MILLIMETERS.
2. FIRE RATING OF DOOR AND PENETRATION SHALL BE THE SAME AS WALL/DECK FIRE RATING.
3. FIRE PROOFING SHALL BE SUPPLIED WITH CERTIFICATE OF TYPICAL APPROVAL BY "IACS MEMBER".
4. FIRE PROOFING DETERMINED ACCORDING TO SOLAS CHAPTER II–2 REGULATION 9

LEGEND


U.N.O.	UNLESS NOTED OTHERWISE
T.O.S.	TOP OF STEEL
T.O.P.	TOP OF PLATE
T.O.F.	TOP OF FLOOR
℄	CENTER LINE
SIM	SIMILAR
T.B.D.	TO BE DEFINED
T.B.C.	TO BE COMFIRMED
A0	IMPACT DIRECTION OF POTENTIAL FIRE RESISTANCE CLASS

HOLDS

REFERENCE

DOCUMENT TITLE	DOCUMENT NUMBER
LV (400V) Switchroom – Supply Specification	123A90-DDL-AR-SP-10007
LV (400V) Switchroom – Architectural General Layout (plan, view, section & typical details)	123A90-DDL-AR-SP-10008
LV (400V) Switchroom – Doors Map and Schedule	123A90-DDL-AR-DL-10009
LV (400V) Switchroom – Flooring and Lining Layout	123A90-DDL-AR-DL-10010
B-200 General Arramgement Drawings (by Vendor)	1724000049-AR-DA-00015
B-200 Detail Drawings (by Vendor)	1724000049-AR-DD-00019

KEY PLAN

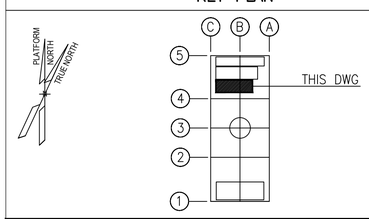

STILOG

REV.	DATE	DRN	CHKD	APPD	DESCRIPTION
02	18/09/25	SPS	M. GA	CGI	AS-BUILT (ASB)
01	12/03/24	R. BO	M. GA	D. LO	ACCEPTED FOR CONSTRUCTION (AFC)
00	17/10/23	R. BO	M. GA	D. LO	ISSUE FOR REVIEW (IFR)

CROSSWIND — ROSETTI MARINO

TITLE : BASE LOAD POWER HUB (BLPH)
LV (400V) SWITCHGEAR ROOM B-200 – ARCHITECTURAL
FIRE RATED REQ. – PLAN, SECTION & TYP. DET.

CONTRACT NO./TITLE CW-I-WP4-2023-05/HOLLANDSE KUST NOORD WIND PARK | SCALE 1:5

DRAWN SPS | CHECKED M. GATTI | APPROVED CGI | DATE 18/09/25

A1 | DRAWING NO. 123A90-DDL-AR-DL-10011 | SHEET 002 | REV. 02

File Name : 123A90-DDL-AR-DL-10011 REV.02