

DRAWING NO. 123A90-DDL-AR-DL-10018 REV. 02

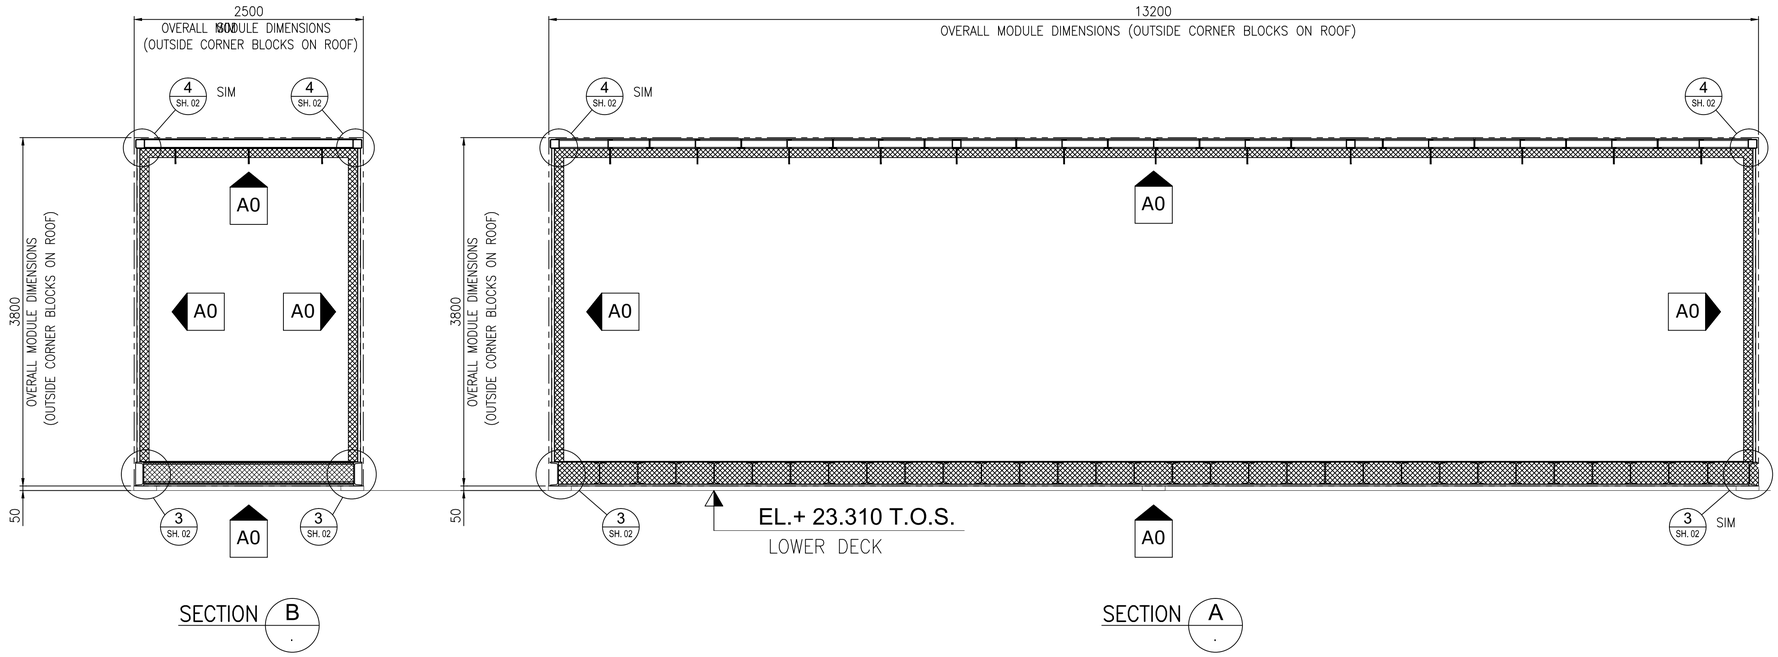

SECTION B

SECTION A

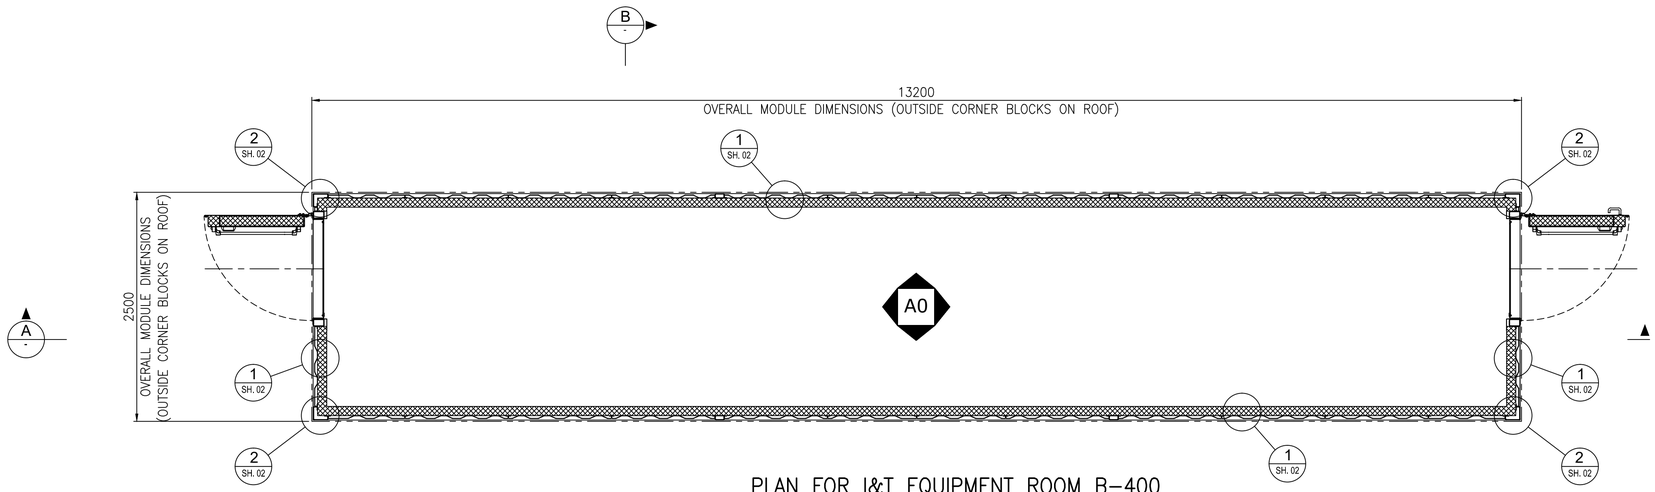


PLAN FOR I&T EQUIPMENT ROOM B-400
FIRE SUBDIVISION and THERMAL & FIRE INSULATION

FOR DETAILS SEE DWG N. 123A90-DDL-AR-DL-10018 Sh. 02

THERMAL INSULATION REQUIREMENTS

"U" VALUE = 0,45 [W/m2.K)] { ROOF; EXPOSED BULKHEAD; FLOOR EXPOSED BELOW; INTERNAL BULKHEAD

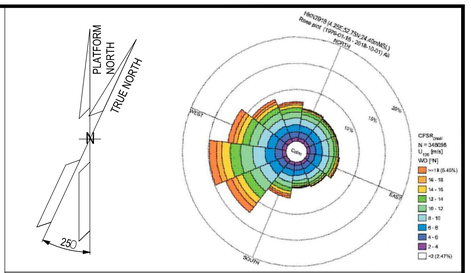

NOTES

1. U.N.O. ALL DIMENSIONS ARE IN MILLIMETERS.
2. FIRE RATING OF DOOR AND PENETRATION SHALL BE THE SAME AS WALL/DECK FIRE RATING.
3. FIRE PROOFING SHALL BE SUPPLIED WITH CERTIFICATE OF TYPICAL APPROVAL BY "IACS MEMBER".
4. FIRE PROOFING DETERMINED ACCORDING TO SOLAS CHAPTER II-2 REGULATION 9

LEGEND


U.N.O.	UNLESS NOTED OTHERWISE
T.O.S.	TOP OF STEEL
T.O.P.	TOP OF PLATE
T.O.F.	TOP OF FLOOR
℄	CENTER LINE
SIM	SIMILAR
T.B.D.	TO BE DEFINED
T.B.C.	TO BE COMFIRMED
A0	IMPACT DIRECTION OF POTENTIAL FIRE RESISTANCE CLASS

HOLDS

REFERENCE

DOCUMENT TITLE	DOCUMENT NUMBER
I&T Equipment Room – Supply Specification	123A90-DDL-AR-SP-10014
I&T Equipment Room – Architectural General Layout (plan, view, section & typical details)	123A90-DDL-AR-SP-10015
I&T Equipment Room – Doors Map and Schedule	123A90-DDL-AR-DL-10016
I&T Equipment Room – Flooring and Lining Layout	123A90-DDL-AR-DL-10017
B-400 General Arramgement Dwg's (by Vendor)	1724000049-AR-DA-00017
B-400 Detail Dwg's (by Vendor)	1724000049-AR-DD-00021

KEY PLAN

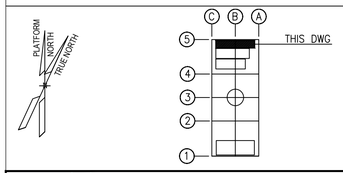

STILOG

REV.	DATE	DRN	CHKD	APPD	DESCRIPTION
02	18/09/25	SPS	M. GA	CGI	AS-BUILT (ASB)
01	23/02/24	R. BO	M. GA	D. LO	ACCEPTED FOR CONSTRUCTION (AFC)
00	30/10/23	R. BO	M. GA	D. LO	ISSUE FOR REVIEW (IFR)

CROSSWIND

ROSETTI MARINO

TITLE :
BASE LOAD POWER HUB (BLPH)
I&T EQUIPMENT ROOM B-400 – ARCHITECTURAL
FIRE RATED REQ. – PLAN, SECTION & TYP. DET.


CONTRACT NO./TITLE	CW-I-WP4-2023-05/HOLLANDSE KUST NOORD WIND PARK	SCALE	1:33
DRAWN SPS	CHECKED M. GATTI	APPROVED CGI	DATE 18/09/25

A1	DRAWING NO.	SHEET	REV.
	123A90-DDL-AR-DL-10018	001	02


File Name : 123A90-DDL-AR-DL-10018 REV.02

DRAWING NO. 123A90-DDL-AR-DL-10018

REV. 02

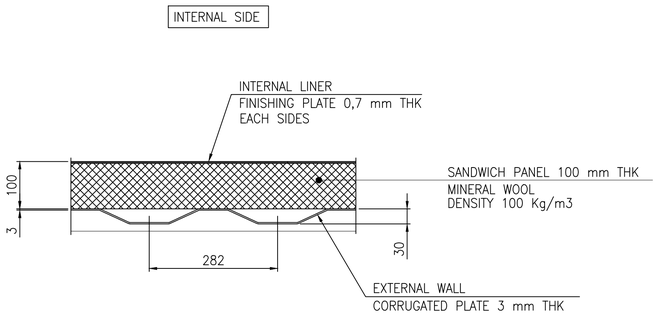


DETAIL 1 SH. 01
WALL TYPICAL

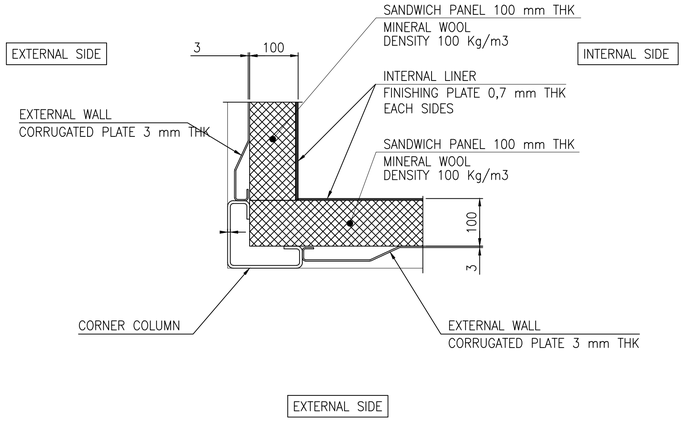


DETAIL 2 SH. 01
AT PLAN CORNERS TYPICAL


FOR PLAN SEE DWG N. 123A90-DDL-AR-DL-10018 Sh. 01

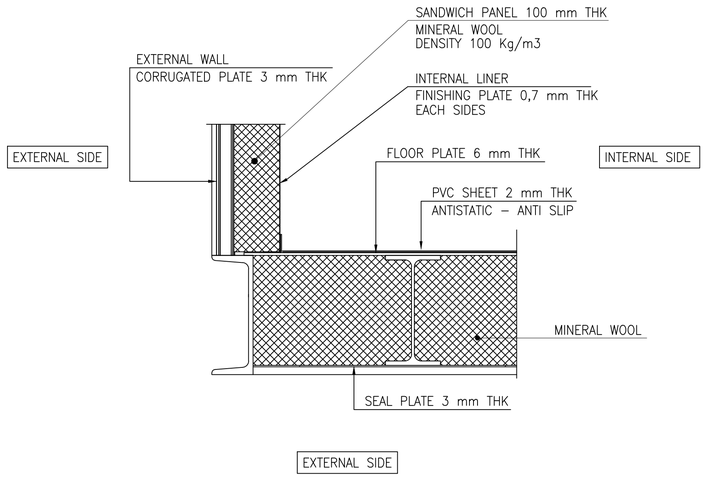

DETAIL 3 SH. 01
AT BOTTOM CORNERS TYPICAL

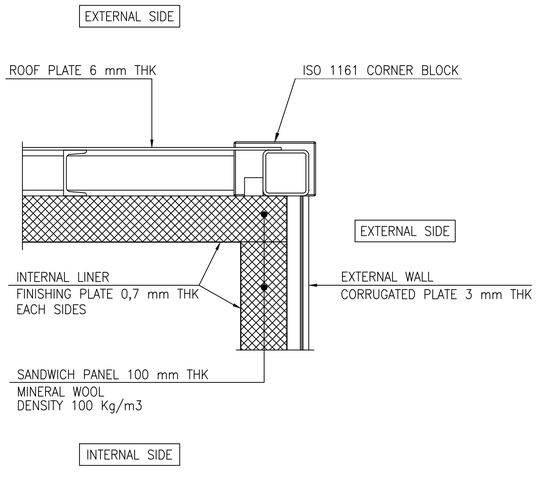

DETAIL 4 SH. 01
AT TOP CORNERS TYPICAL

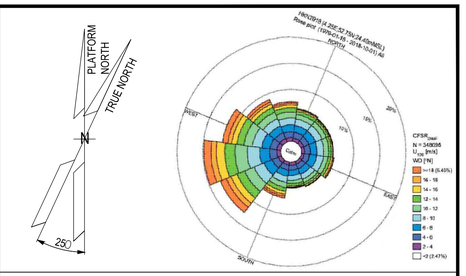

NOTES

1. U.N.O. ALL DIMENSIONS ARE IN MILLIMETERS.
2. FIRE RATING OF DOOR AND PENETRATION SHALL BE THE SAME AS WALL/DECK FIRE RATING.
3. FIRE PROOFING SHALL BE SUPPLIED WITH CERTIFICATE OF TYPICAL APPROVAL BY "IACS MEMBER".
4. FIRE PROOFING DETERMINED ACCORDING TO SOLAS CHAPTER II–2 REGULATION 9

LEGEND


U.N.O.	UNLESS NOTED OTHERWISE
T.O.S.	TOP OF STEEL
T.O.P.	TOP OF PLATE
T.O.F.	TOP OF FLOOR
℄	CENTER LINE
SIM	SIMILAR
T.B.D.	TO BE DEFINED
T.B.C.	TO BE COMFIRMED
A0	IMPACT DIRECTION OF POTENTIAL FIRE RESISTANCE CLASS

HOLDS

REFERENCE

DOCUMENT TITLE	DOCUMENT NUMBER
I&T Equipment Room – Supply Specification	123A90-DDL-AR-SP-10014
I&T Equipment Room – Architectural General Layout (plan, view, section & typical details)	123A90-DDL-AR-SP-10015
I&T Equipment Room – Doors Map and Schedule	123A90-DDL-AR-DL-10016
I&T Equipment Room – Flooring and Lining Layout	123A90-DDL-AR-DL-10017
B-400 General Arramgement Dwg's (by Vendor)	1724000049-AR-DA-00017
B-400 Detail Dwg's (by Vendor)	1724000049-AR-DD-00021

KEY PLAN

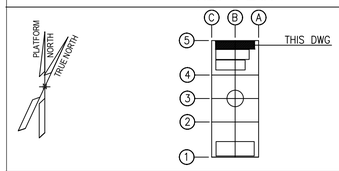

STILOG

REV.	DATE	DRN	CHKD	APPD	DESCRIPTION
02	18/09/25	SPS	M. GA	CGI	AS-BUILT (ASB)
01	23/02/24	R. BO	M. GA	D. LO	ACCEPTED FOR CONSTRUCTION (AFC)
00	30/10/23	R. BO	M. GA	D. LO	ISSUE FOR REVIEW (IFR)

CROSSWIND

ROSETTI MARINO

TITLE :
BASE LOAD POWER HUB (BLPH)
I&T EQUIPMENT ROOM B-400 – ARCHITECTURAL
FIRE RATED REQ. – PLAN, SECTION & TYP. DET.

CONTRACT NO./TITLE CW-I-WP4-2023-05/HOLLANDSE KUST NOORD WIND PARK | SCALE 1:5

DRAWN SPS | CHECKED M. GATTI | APPROVED CGI | DATE 18/09/25

A1 | DRAWING NO. 123A90-DDL-AR-DL-10018 | SHEET 002 | REV. 02

File Name : 123A90-DDL-AR-DL-10018 REV.02