


DRAWING NO. 123A90-DDL-EL-DL-20100

REV. 02

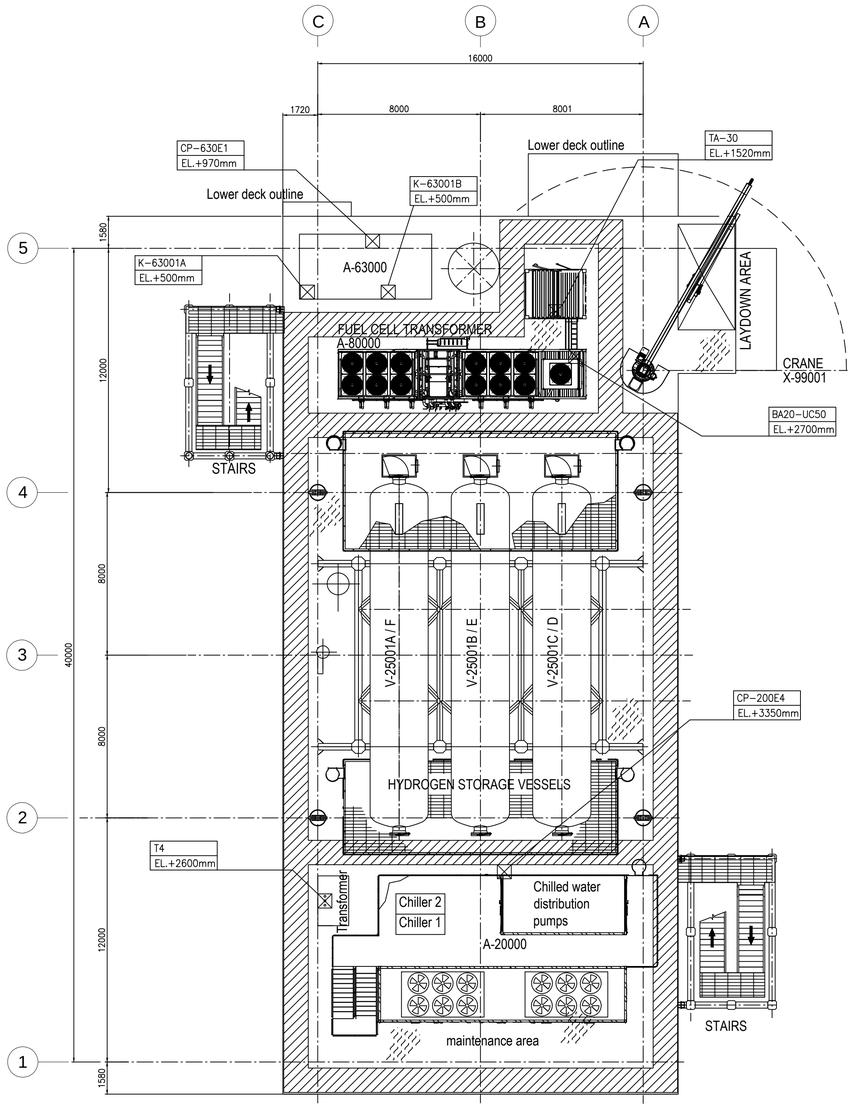

PLAN ON TOP DECK
EL+30.310 T.O.S.

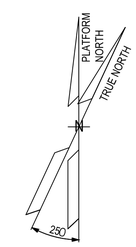

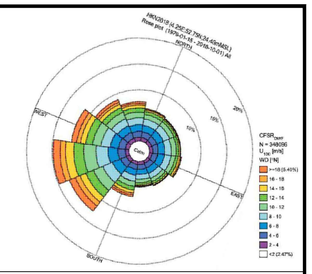

NOTES

1. ALL DIMENSIONS IN MM UNLESS NOTED OTHERWISE.
2. ALL ELEVATIONS IN METERS. UNLESS NOTED OTHERWISE.
3. ELEVATIONS REFER TO T.O.S. UNLESS NOTED OTHERWISE.
4. AFTER INTERFACE PANEL/BATTERY LIMIT CABLES WILL BE ROUTED INSIDE VENDOR CABLETRAYS

LEGEND

☒	INTERFACE PANEL/BATTERY LIMIT
JB-200E2 EL.+500mm	TAG ITEM REFERED ELEVATION TO T.O.S. (TOP OF STEEL)

HOLDS

REFERENCE DOCUMENTS

123A90-DDL-PP-DL-70070	PLOT PLAN - LOWER & UPPER DECK
123A90-DDL-EL-DL-20140	ELECTRICAL HEAT TRACING JUNCTION BOX LAYOUT
123A90-DDL-EL-DL-20118	LIGHTING & SOCKET LAYOUT - TOP DECK

INSERT SUBCONTRACTOR / VENDOR LOGO HERE

REV.	DATE	DRN	CHKD	APPD	DESCRIPTION
02	15/09/25	PS	FMA/AMA	CGI	ASBUILT (ASB)
01	22/07/24	SPS	FMA/AMA	FPA/DLO	ACCEPTED FOR CONSTRUCTION (AFC)
00	29/05/24	SPS	FMA/AMA	FPA/DLO	ISSUE FOR REVIEW (IFR)

CROSSWIND

ROSETTI MARINO

TITLE :
BASE LOAD POWER HUB (BLPH)
ELECTRICAL EQUIPMENT LAYOUT
TOP DECK

CONTRACT NO./TITLE CW-I-WP4-2023-05/HOLLANDSE KUST NOORD WIND PARK			SCALE 1:150
DRAWN SPS	CHECKED FMA/AMA	APPROVED FPA/DLO	DATE 22/07/24
A1	DRAWING NO. 123A90-DDL-EL-DL-20100	SHEET 001	REV. 02

File Name : 123A90-DDL-EL-DL-20100-Electrical Equipment Layout - Top Deck