

DRAWING NO. 123A90-DDL-EL-DL-20101

REV. 02

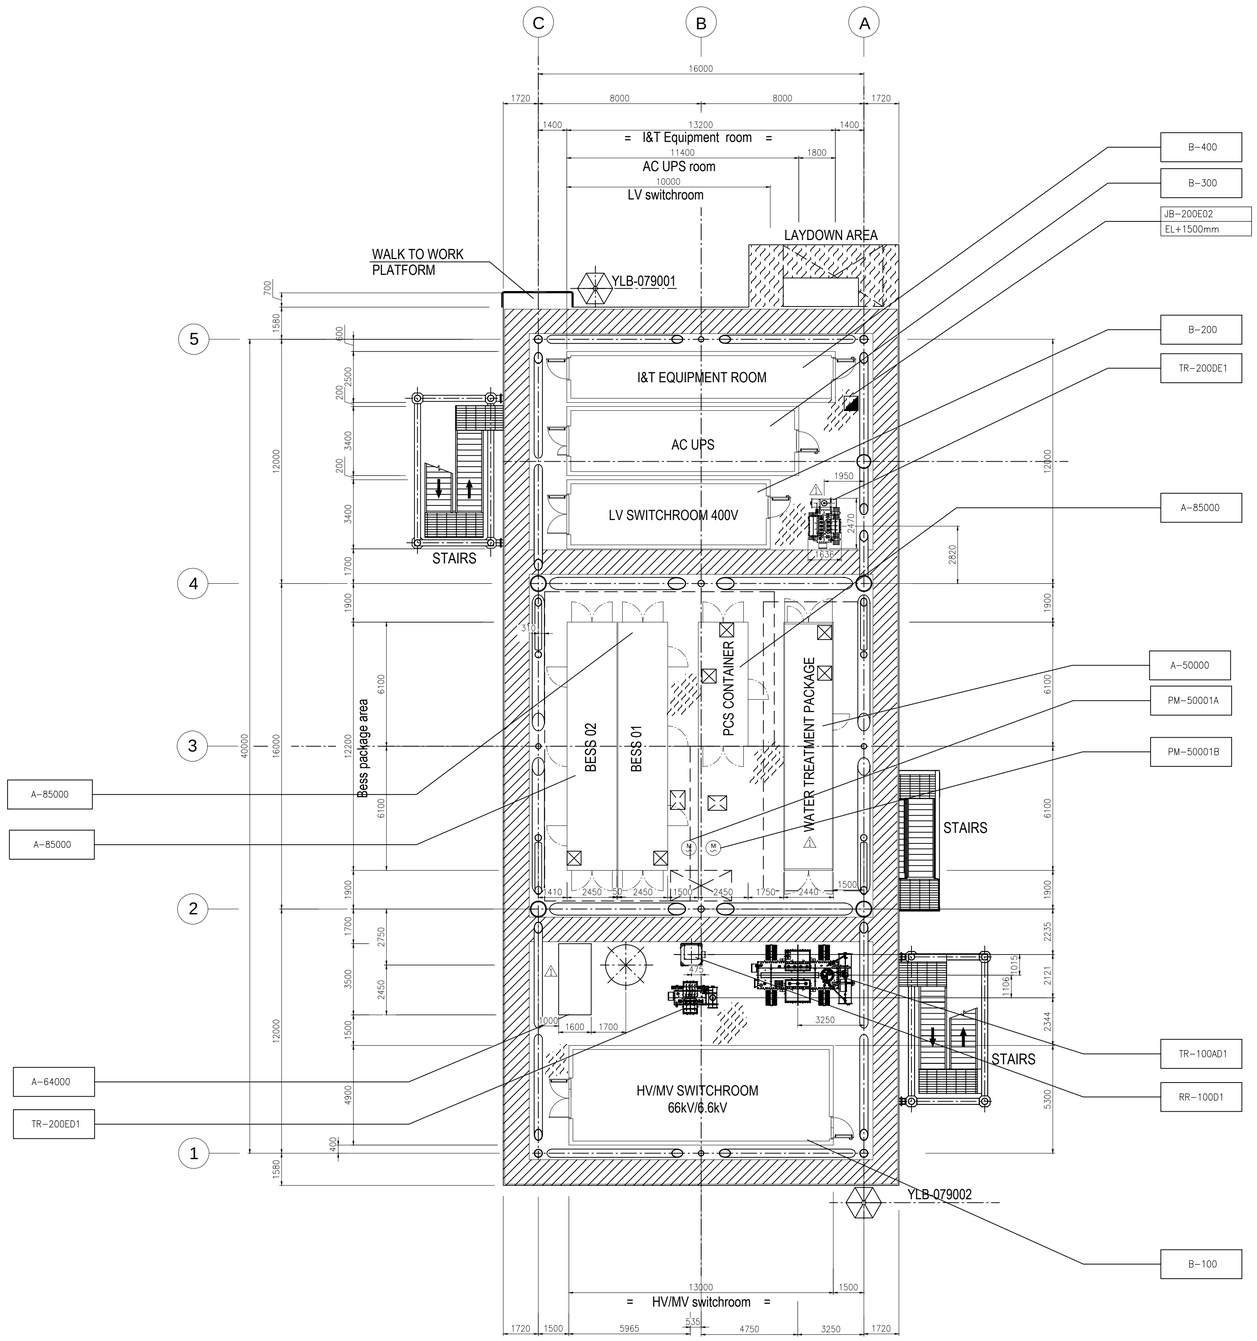

PLAN ON LOWER DECK
EL+23.310 T.O.S.

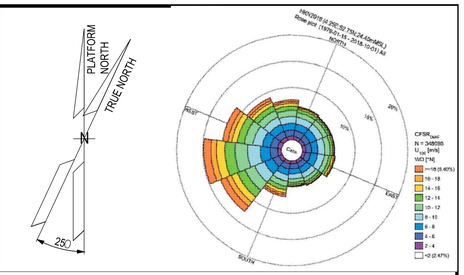

NOTES

1. ALL DIMENSIONS IN MM UNLESS NOTED OTHERWISE.
2. ALL ELEVATIONS IN METERS. UNLESS NOTED OTHERWISE.
3. ELEVATIONS REFER TO T.O.S.
4. FOR ELECTRICAL EQUIPMENT LAYOUT OF CONTAINERS B-100, B-200, B-300, B-400 REFER TO THE RESPECTIVE LAYOUTS.

LEGEND

(M)	ELECTRIC MOTOR – LOW VOLTAGE
⊠	INTERFACE PANEL
◪	JUNCTION BOX
JB-200E2 / EL+500mm	TAG ITEM / REFERED ELEVATION TO T.O.S. (TOP OF STEEL)

HOLDS

REFERENCE DOCUMENTS

123A90-DDL-PP-DL-70070	PLOT PLAN - LOWER & UPPER DECK
123A90-DDL-EL-DL-20106	ELECTRICAL EQUIPMENT LAYOUT UPSs & BATTERIES SWITCHROOM
123A90-DDL-IN-DL-40012	ITER EQUIPMENT LAYOUT
123A90-DDL-EL-DL-20104	ELECTRICAL EQUIPMENT LAYOUT HV & MV SWITCHROOM
123A90-DDL-EL-DL-20105	LV SWITCHGEAR ROOM EQUIPMENT LAYOUT

INSERT SUBCONTRACTOR / VENDOR LOGO HERE

REV.	DATE	DRN	CHKD	APPD	DESCRIPTION
02	15/09/25	PS	FMA/AMA	CGI	ASBUILT (ASB)
01	06/05/24	SAM	FMA/AMA	FPA/DLO	ACCEPTED FOR CONSTRUCTION (AFC)
00	04/03/24	SAM	FMA/AMA	FPA/DLO	ISSUE FOR REVIEW (IFR)

CROSSWIND | ROSETTI MARINO

TITLE :
BASE LOAD POWER HUB (BLPH)
ELECTRICAL EQUIPMENT LAYOUT
LOWER DECK

CONTRACT NO./TITLE CW-I-WP4-2023-05/HOLLANDSE KUST NOORD WIND PARK			SCALE 1:150
DRAWN SAM	CHECKED FMA/AMA	APPROVED FPA/DLO	DATE 04/03/24
A1	DRAWING NO. 123A90-DDL-EL-DL-20101		SHEET 001 / REV. 02

File Name : 123A90-DDL-EL-DL-20101-Electrical Equipment Layout – Lower Deck