

DRAWING NO. 123A90-DDL-EL-DL-20102


REV. 02

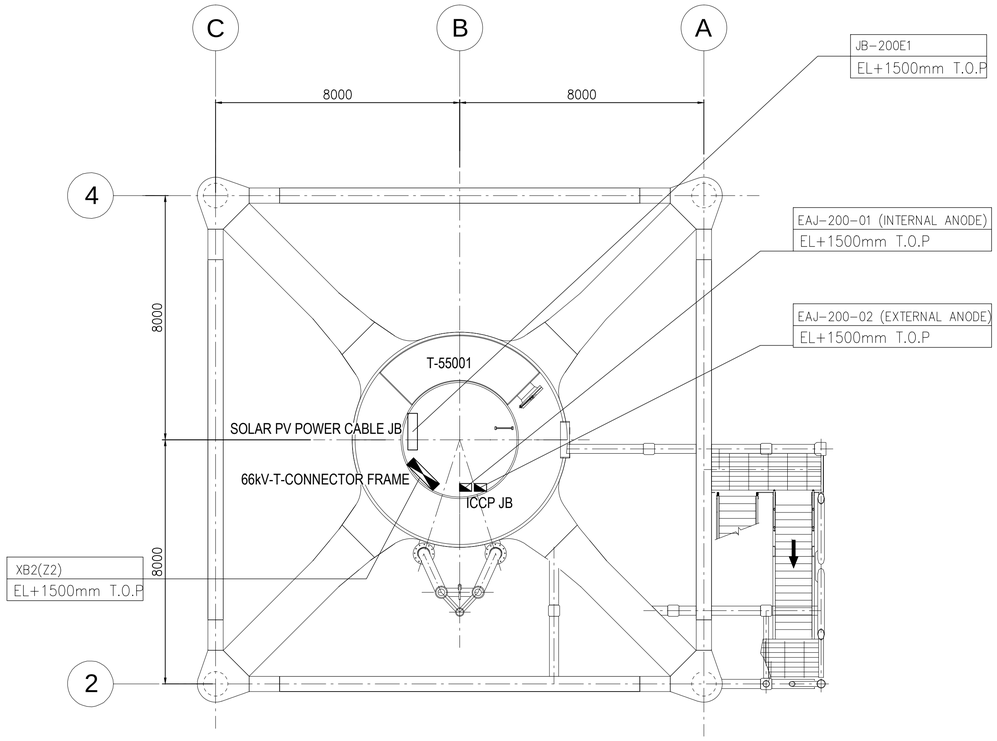


PLAN ON TRANSITION PIECE
EL+21.710 T.O.S.

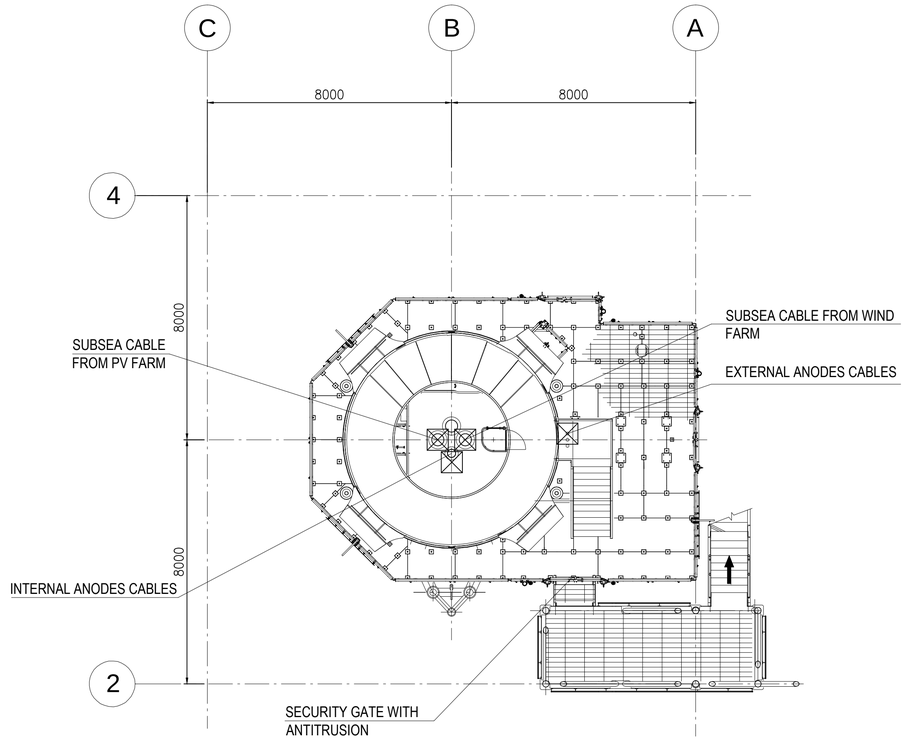

PLAN ON EXISTING PLATFORM AT
EL+16.860 T.O.S.

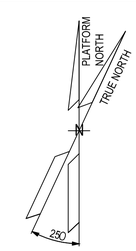

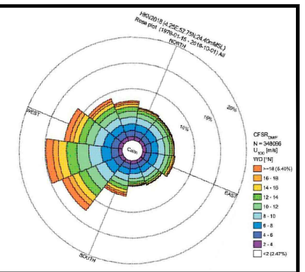

NOTES

1. ALL DIMENSIONS IN MM UNLESS NOTED OTHERWISE.
2. ALL ELEVATIONS IN METERS. UNLESS NOTED OTHERWISE.
3. ELEVATIONS REFER TO T.O.S. UNLESS NOTED OTHERWISE.
4. ELEVATIONS REFER TO THE HORIZONTAL AXIS OF THE OBJECT.

LEGEND

JB-200E1 EL+1500mm T.O.P	TAG ITEM REFERED ELEVATION TO T.O.P. (TOP OF PLATFORM)
	SOLAR PV POWER CABLE JB
	66kV T-CONNECTOR FRAME
	ICCP JUNCTION BOX
	EXISTING CABLE ENTRY

REFERENCE DOCUMENTS

123A90-DDL-PP-DL-70071	PLOT PLAN - BELOW LOWER DECK
123A90-DDL-EL-DL-20140	ELECTRICAL HEAT TRACING JUNCTION BOX LAYOUT
123A90-DDL-EL-DL-20120	LIGHTING & SOCKET LAYOUT - BELOW LOWER DECK
123A90-DDL-EL-DS-20048	TDS - IAC CABLE INTERFACE JB + SOLAR PV JB
123A90-DDL-EL-DS-20054	T-CONNECTORS & HV TERMINATIONS
DRW-15547-001-SAE-001	ICCP DRAWINGS & SPECIFICATIONS

REV.	DATE	DRN	CHKD	APPD	DESCRIPTION
02	15/09/25	PS	FMA/AMA	CGI	ASBUILT (ASB)
01	23/07/24	SPS	FMA/AMA	FPA/DLO	ACCEPTED FOR CONSTRUCTION (AFC)
00	24/05/24	SPS	FMA/AMA	FPA/DLO	ISSUE FOR REVIEW (IFR)

CROSSWIND

ROSETTI MARINO

TITLE :
BASE LOAD POWER HUB (BLPH)
ELECTRICAL EQUIPMENT LAYOUT
BELOW LOWER DECK

CONTRACT NO./TITLE CW-I-WP4-2023-05/HOLLANDSE KUST NOORD WIND PARK			SCALE 1:100
DRAWN SPS	CHECKED FMA/AMA	APPROVED FPA/DLO	DATE 23/07/24
A1	DRAWING NO. 123A90-DDL-EL-DL-20102	SHEET 001	REV. 02

File Name : 123A90-DDL-EL-DL-20102-Electrical Equipment Layout - Stair Towers