

DRAWING NO. 123A90-DDL-EL-DL-20105


REV. 03

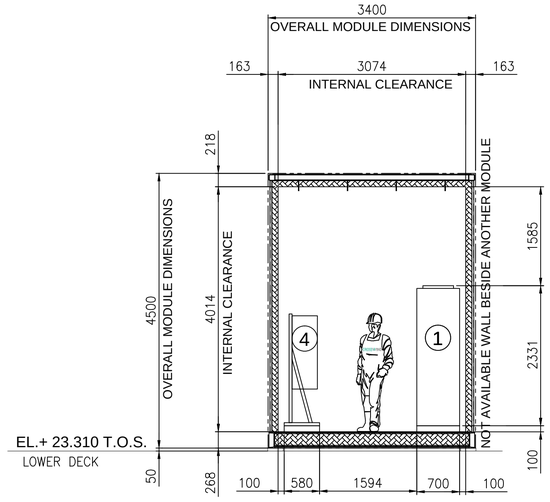

SECTION B -

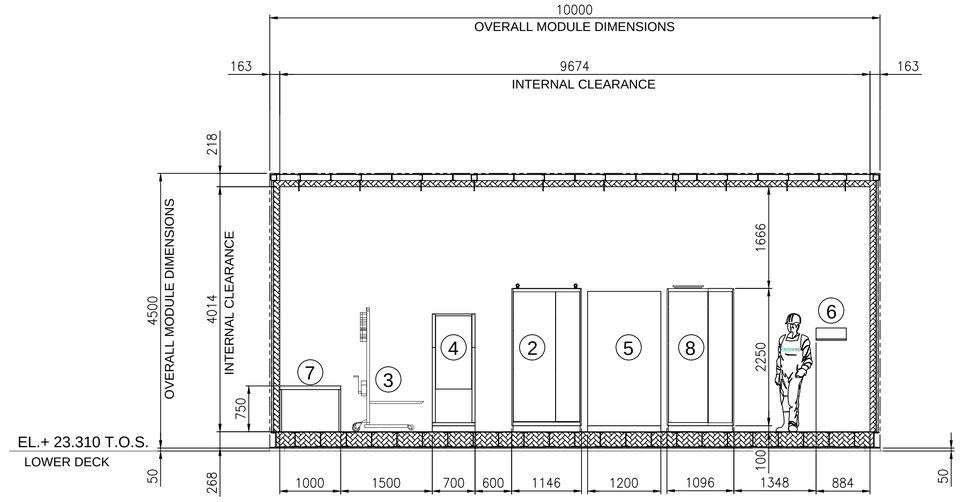

SECTION A -

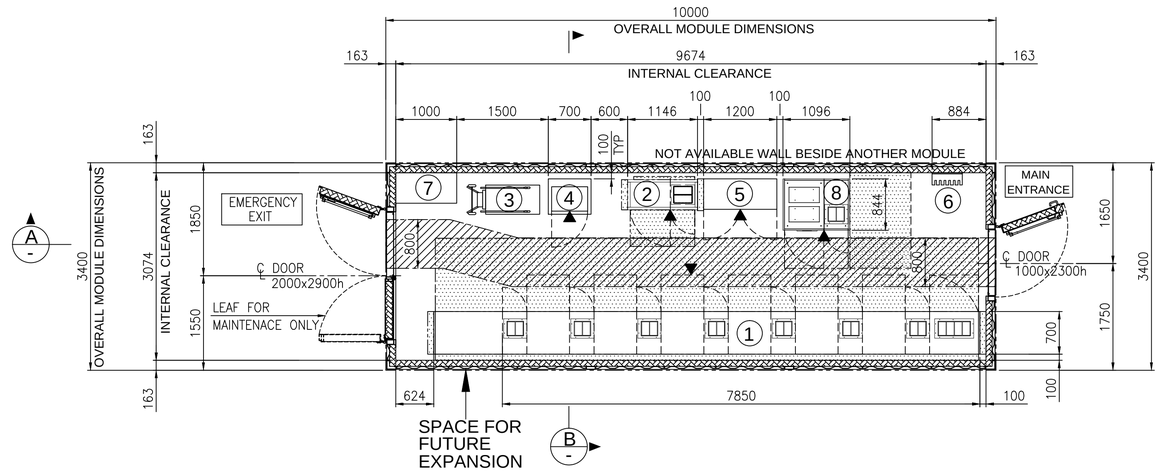


EQUIPMENT LAYOUT
"B-200" LV (400V) SWITCHGEAR ROOM
BOTTOM PLAN

1

EQUIPMENT LIST

REF.	TAG No.	DESCRIPTION	LENGTH (mm)	WIDTH (mm)	HEIGHT (mm)	NOTE
1	SG-200N1	400V SWITCHGEAR	7850	700	2331	
2	DP-200N1	DISTRIBUTION BOARD FOR LIGHTING AND SMALL POWER B.O.P.	1146	520	2250	
3	-	SERVICE TROLLEY FOR 400V SWITCHGEAR	1034	490	2030	
4	CN-200N1	ICCP PANEL	700	580	1830	
5	B200-HSB-001	DISTRIBUTION & HVAC PANEL - LV ROOM	1200	600	1900	
6	-	TOOL BOX	495	200	200	
7	-	TABLE	1000	500	750	
8	SG-200D2	ACB PANEL FOR SOLAR PACKAGE	1096	844	2294	

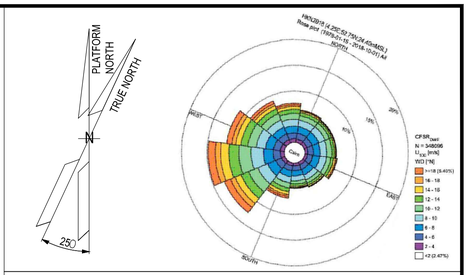

NOTES

1. U.N.O. ALL DIMENSIONS ARE IN MILLIMETERS.
2. DELETED.
3. DOCUMENT VALID ONLY FOR ELECTRICAL COMPONENT, FOR OTHER SCOPE LOCATION AND INFORMATION, PLEASE REFER TO VENDORS AND PROJECT DOCUMENTS.
4. FOR OTHER ITEMS, CORRECT LOCATION AND INFORMATION, PLEASE REFER TO VENDORS AND DEDICATED PROJECT DOCUMENTATION.
5. HEIGHT OF ALL PANELS IN THE EQUIPMENT LIST TABLE IS WITHOUT THE BASE FRAME (100mm)


LEGEND

U.N.O. _____ UNLESS NOTED OTHERWISE
T.O.S. _____ TOP OF STEEL
_____ ESCAPE CORRIDOR - WIDTH 800mm.
_____ MAINTENANCE AREA - VENDOR REQUIREMENT
_____ SWITCHGEAR ROOM ENCLOUSURE
_____ FRONT OF EQUIPMENT

REFERENCES

DOCUMENT TITLE	DOCUMENT NUMBER
SG-200N1 GENERAL ARRANGEMENT DRAWING	1723002197-EL-DA-00007
SG-200D2 GENERAL ARRANGEMENT DRAWING	1723002197-EL-DA-00008
DP-200N1 GENERAL ARRANGEMENT DRAWING	1723002197-EL-DA-00009
AC UPS – GENERAL ARRANGEMENT AND DIMENSIONAL DRAWINGS	1724000372-EL-DA-00004
AC UPS – BATTERY LAYOUT INTERCONNECTING DIAGRAM	1724000372-EL-DG-00011
B-200 -GENERAL ARRANGEMENT DRAWINGS - E&I SHELTER	1724000049-AR-DA-00015
ICCC PANEL GENERAL ARRANGEMENT DRAWING	144671-CORR-TF-FAB-DWG-0003

KEY PLAN

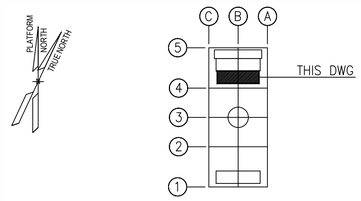

REV.	DATE	DRN	CHKD	APPD	DESCRIPTION
03	15/09/2025	PS	LMA/AMA	CGI	ASBUILT (ASB)
02	27/05/2024	FMO	LMA/AMA	LMA/MDO	ACCEPTED FOR CONSTRUCTION (AFC)
01	26/03/2024	GPA	LMA/AMA	LMA/MDO	ISSUE FOR REVIEW (IFR)
00	08/11/2023	DSF	CB/AMA	DYFO/MDO	ISSUE FOR REVIEW (IFR)

CROSSWIND

ROSETTI MARINO

TITLE :
BASE LOAD POWER HUB (BLPH)
ELECTRICAL EQUIPMENT LAYOUT
LV SWITCHROOM

CONTRACT NO./TITLE CW-I-WP4-2023-05/HOLLANDSE KUST NOORD WIND PARK | SCALE 1:50

DRAWN FMO | CHECKED LMA/AMA | APPROVED LMA/MDO | DATE 27/05/2024

A1 | DRAWING NO. 123A90-DDL-EL-DL-20105 | SHEET 001 | REV. 03

File Name : 123A90-DDL-EL-DL-20105_REV03.dwg