

DRAWING NO. 123A90-DDL-EL-DL-20106

REV. 02

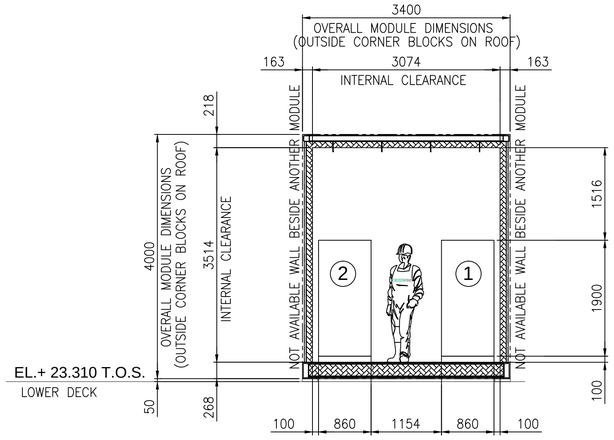


SECTION B -

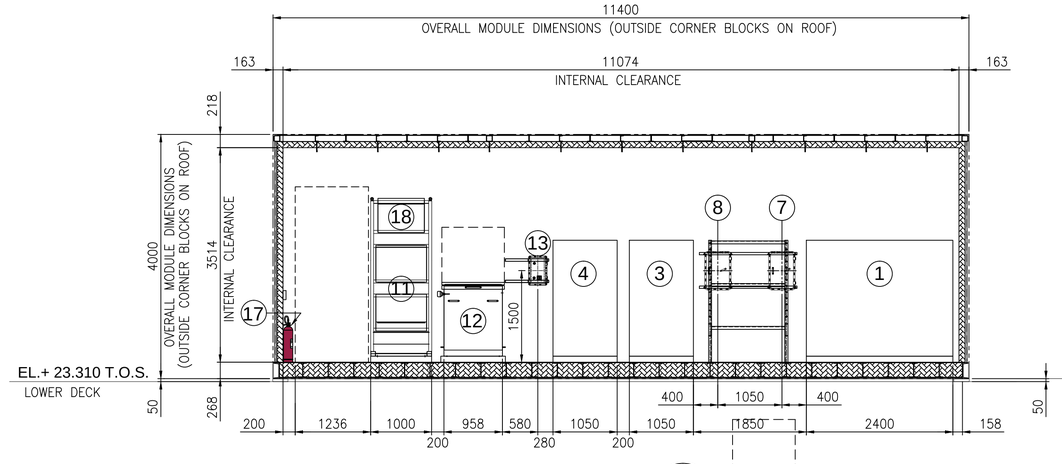

SECTION A -

B -

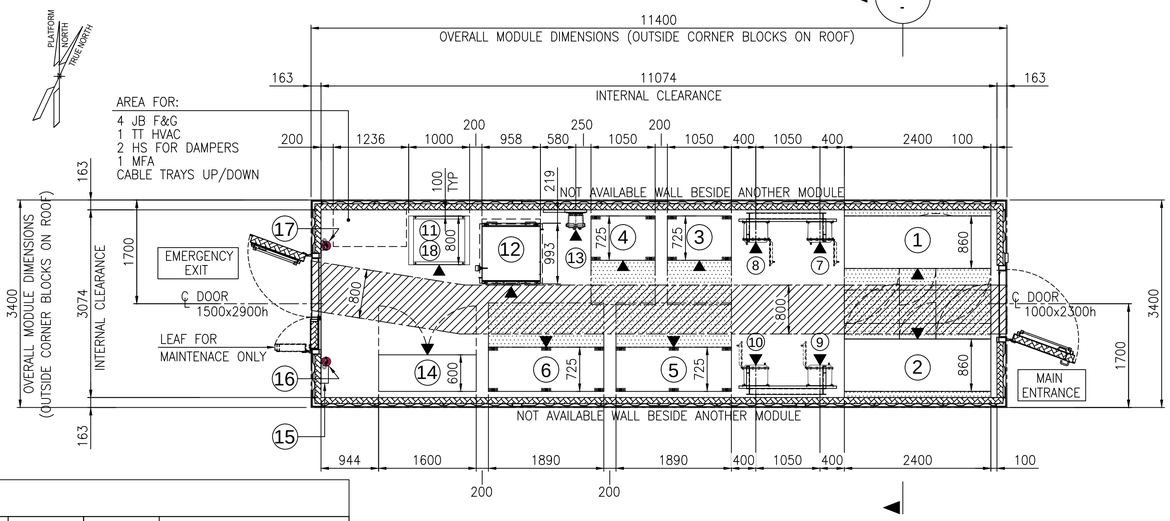


A -

EQUIPMENT LAYOUT
"B-300" UPSs & BATTERIES SWITCHROOM
BOTTOM PLAN

EQUIPMENT LIST

REF.	TAG No.	DESCRIPTION	LENGTH (mm)	WIDTH (mm)	HEIGHT (mm)	WEIGHT (Kg)	NOTES
1	UP-200F3	AC UPS 35kVA	2400	860	1915	2258	
2	UP-200F4	AC UPS 15kVA	2400	860	1915	2258	
3	BA-200F3A	BATTERY RACK GEL VRLA 7y AC UPS 35kVA	1050	725	1272	914	
4	BA-200F3B	BATTERY RACK GEL VRLA 7y AC UPS 35kVA	1050	725	1272	914	
5	BA-200F4A	BATTERY RACK GEL VRLA 7y AC UPS 15kVA	1890	725	1761	3429	
6	BA-200F4B	BATTERY RACK GEL VRLA 7y AC UPS 15kVA	1890	725	1761	3429	
7	CB-200F3A	ISOLATOR BOX AC UPS 35kVA	450	341	632	100	
8	CB-200F3B	ISOLATOR BOX AC UPS 35kVA	450	341	632	100	
9	CB-200F4A	ISOLATOR BOX AC UPS 15kVA	450	341	632	100	
10	CB-200F4B	ISOLATOR BOX AC UPS 15kVA	450	341	632	100	
11	NC-200F2	NAVAID PANEL	1000	800	2600	535	
12	BA-200F2	BATTERY BOX NAVAID	958	993	1210	1552	
13	CB-200F2	ISOLATOR BOX NAVAID	500	400	765	70	
14	B3000-HSB-001	DISTRIBUTION & HVAC PANEL - AC/UPS ROOM	1600	600	2300	1150	
15	-	EYE WASH STATION	228	80	290	5	
16	-	PORTABLE EXTINGUISHER (CO2) 5 Kg.	150	150	750	20	
17	-	PORTABLE EXTINGUISHER (CO2) 5 Kg.	150	150	750	20	
18	BC-200F2	BATTERY CHARGER NAVAID	-	-	-	-	INCLUDED IN THE RACK OF NC-200F2

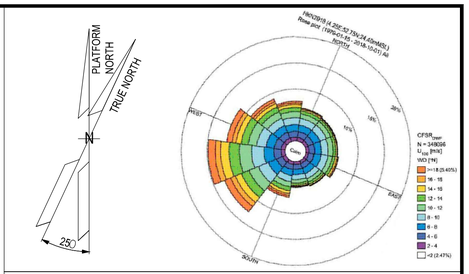

NOTES

1. U.N.O. ALL DIMENSIONS ARE IN MILLIMETERS.
2. EQUIPMENT DIMENSION ARE DEFINED ACCORDING TO THE LATEST DRAWING AND INFORMATION FROM THE VENDOR
3. DOCUMENT VALID ONLY FOR ELECTRICAL COMPONENT, FOR OTHER SCOPE LOCATION AND INFORMATION, PLEASE REFER TO VENDORS AND PROJECT DOCUMENTS.
   - "B-300" – GENERAL ARRANGEMENT DRAWING DOC. N. 1724000049-AR-DA-00016
   - "B-300" – DETAILED DRAWINGS DOC. N. 1724000049-AR-DD-00020

LEGEND


U.N.O. _____ UNLESS NOTED OTHERWISE
T.O.S. _____ TOP OF STEEL
_____ ESCAPE CORRIDOR – WIDTH 800mm.
_____ MAINTENANCE AREA – VENDOR REQUIREMENT
_____ SWITCHGEAR ROOM ENCLOSURE
_____ FRONT OF EQUIPMENT

HOLDS

REFERENCE

DOCUMENT TITLE	DOCUMENT NUMBER
"B-300" GENERAL ARRANGEMENT DRAWING	1724000049-AR-DA-00016
"B-300" DETAILED DRAWINGS	1724000049-AR-DD-00020
"B-300" ARCHITECTURAL GENERAL LAYOUT PLAN, WIEW, SECTIONS & TYP. DETAILS	123A90-DDL-AR-DL-10022
PLOT PLAN – LOWER & UPPER DECK	123A90-DDL-PP-DL-70070

KEY PLAN

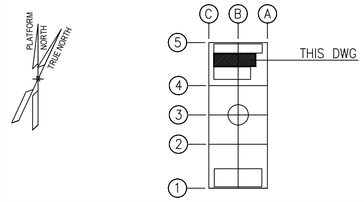

REV.	DATE	DRN	CHKD	APPD	DESCRIPTION
02	15/09/25	PS	FMA/AMA	CGI	ASBUILT (ASB)
01	23/07/24	SAM	FMA/AMA	FPA/DLO	ACCEPTED FOR CONSTRUCTION (AFC)
00	28/03/24	SAM	FMA/AMA	FPA/DLO	ISSUE FOR REVIEW (IFR)

CROSSWIND | ROSETTI MARINO

TITLE :
BASE LOAD POWER HUB (BLPH)
ELECTRICAL EQUIPMENT LAYOUT
UPSs & BATTERIES SWITCHROOM

CONTRACT NO./TITLE CW-I-WP4-2023-05/HOLLANDSE KUST NOORD WIND PARK			SCALE 1:50
DRAWN SAM	CHECKED FMA/AMA	APPROVED FPA/DLO	DATE 23/07/24
A1	DRAWING NO. 123A90-DDL-EL-DL-20106	SHEET 001	REV. 02

File Name : 123A90-DDL-EL-DL-20106 Rev02.dwg