


DRAWING NO. 123A90-DDL-EL-DL-20114

REV. 02

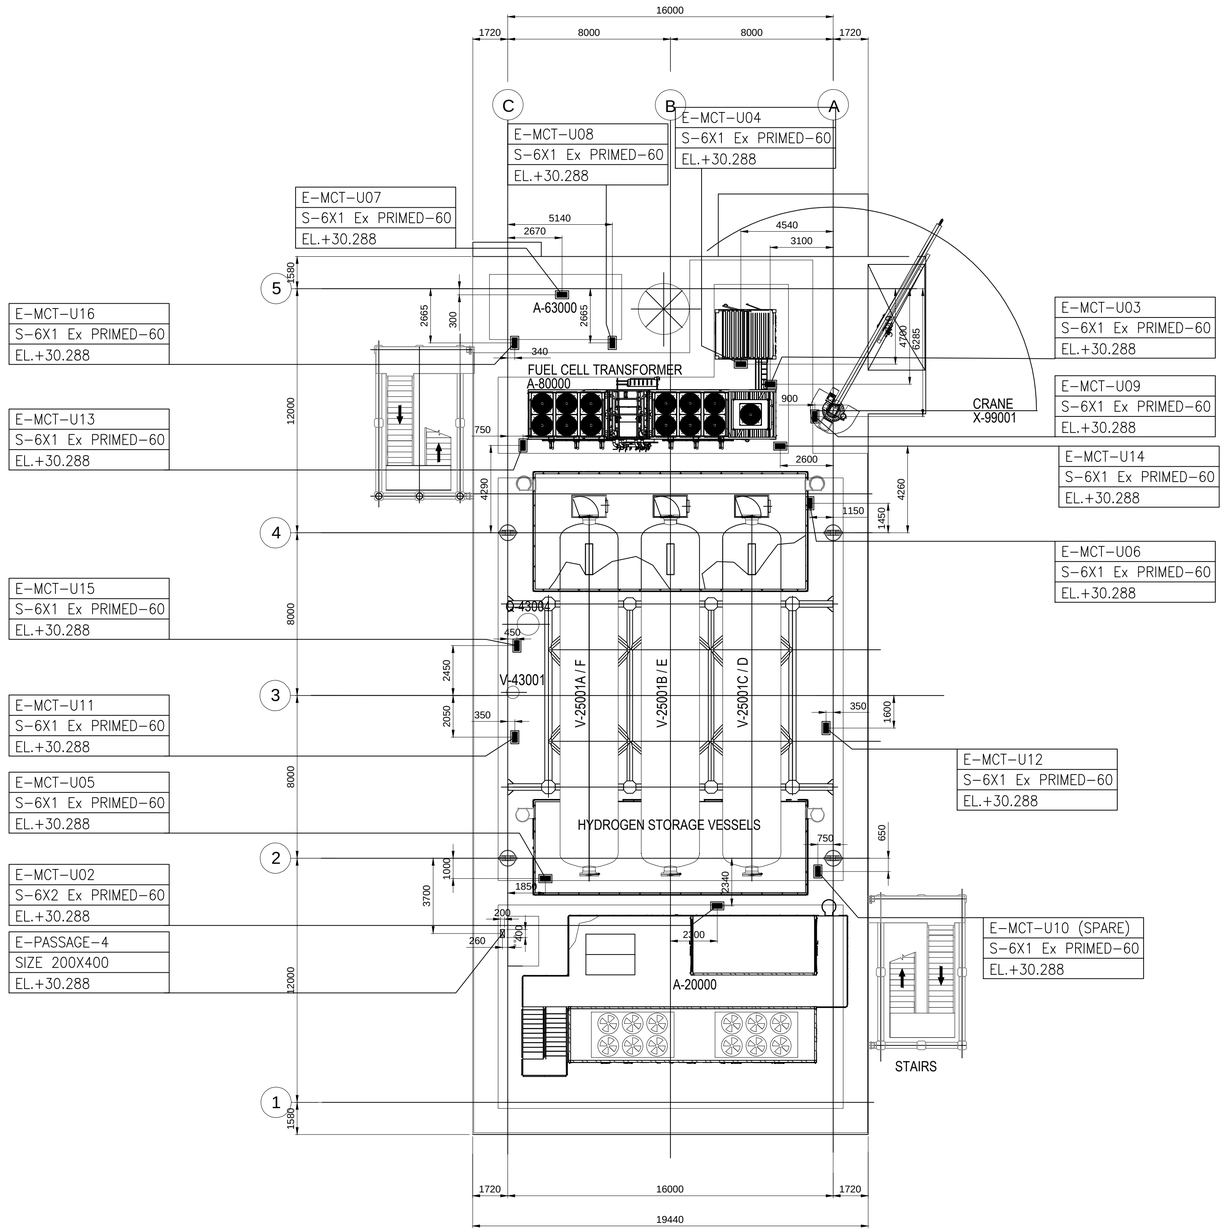

PLAN ON UPPER DECK
EL+30.310 T.O.S.

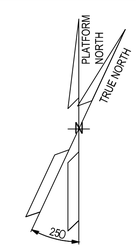

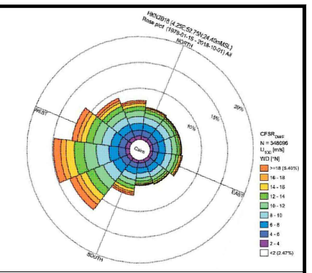

NOTES

GENERAL NOTES:

1. ALL DIMENSIONS IN mm U.N.O
2. ALL ELEVATIONS IN METERS.
3. ALL ELEVATIONS RELATE TO LOWEST ASTRONOMICAL TIDE (LAT) = 0.000.


NOTES:

1. THIS DOCUMENT IS VALID FOR TAGGING, SIZE AND LOCATION OF THE MCT.
2. ALL MCTs IN UPPER DECK ARE ATEX TYPE.

HOLDS

LEGEND

LEGEND MCT FRAME

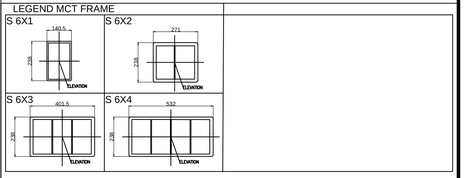


MULTI CABLE TRANSIT FOR ATEX AREA

PASSAGE

TAG	TAGGING
SIZE-MATERIAL-DEPTH	TYPICAL
EL.	ELEVATION

KEY PLAN

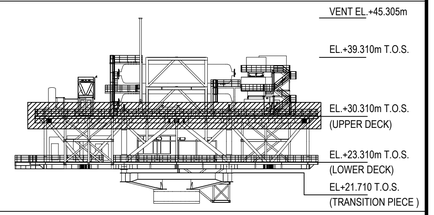

REFERENCE DOCUMENTS

123A90-DDL-PP-DL-70070	PLOT PLAN - LOWER & UPPER DECK
123A90-DDL-EL-DL-20100	ELECTRICAL EQUIPMENT LAYOUT - TOP DECK
123A90-DDL-EL-DD-20095	MCT COMPOSITION
123A90-DDL-EL-DL-20115	ELECTRICAL MCT LAYOUT-LOWER DECK
123A90-DDL-EL-DL-20116	ELECTRICAL MCT LAYOUT- BELOW LOWER DECK

REV.	DATE	DRN	CHKD	APPD	DESCRIPTION
02	15/09/25	PS	FMA/AMA	CGI	ASBUILT (ASB)
01	31/07/24	SPS	FMA/AMA	FPA/DLO	ACCEPTED FOR CONSTRUCTION (AFC)
00	23/04/24	SPS	FMA/AMA	FPA/DLO	ISSUE FOR REVIEW (IFR)

CROSSWIND

ROSETTI MARINO

TITLE :
BASE LOAD POWER HUB (BLPH)
ELECTRICAL MCT LAYOUT
TOP DECK

CONTRACT NO./TITLE CW-I-WP4-2023-05/HOLLANDSE KUST NOORD WIND PARK			SCALE 1:150
DRAWN SPS	CHECKED FMA/AMA	APPROVED FPA/DLO	DATE 15/07/24
A1	DRAWING NO. 123A90-DDL-EL-DL-20114		SHEET 001 / REV. 02

File Name : 123A90-DDL-EL-DL-20114