


DRAWING NO. 123A90-DDL-EL-DL-20119

REV. 02

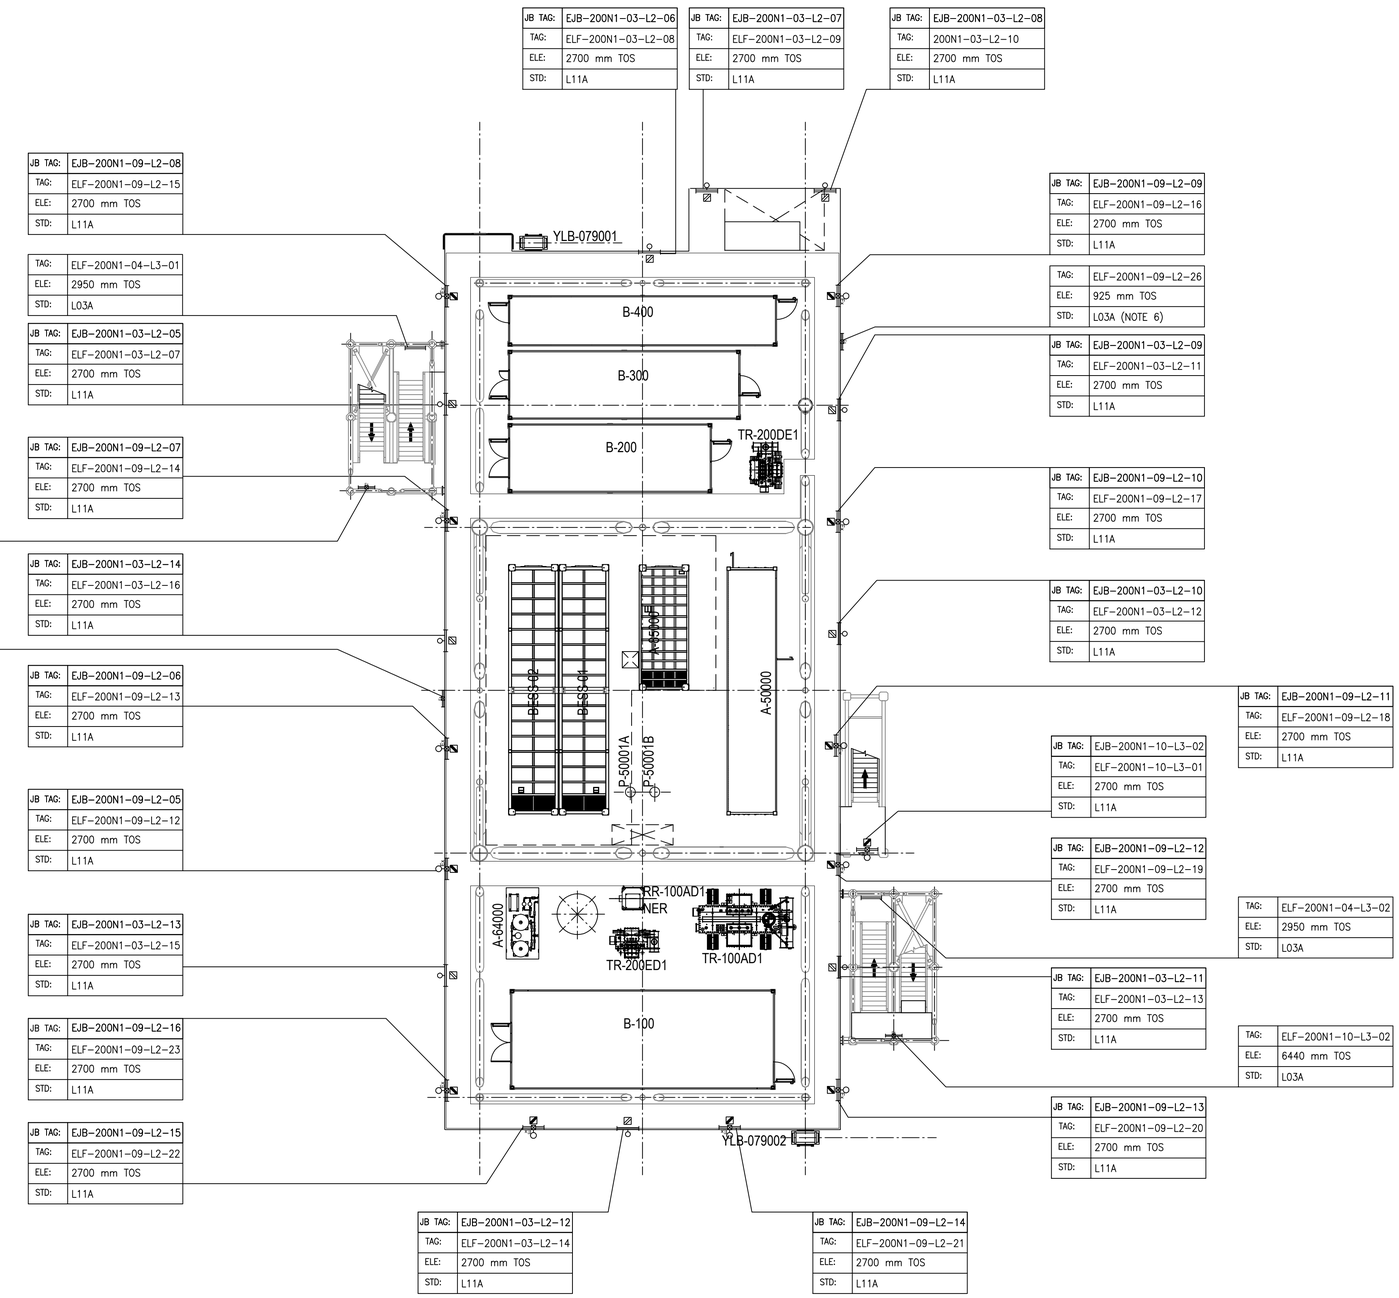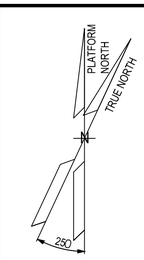


PLAN ON LOWER DECK
EL+23.310 T.O.S

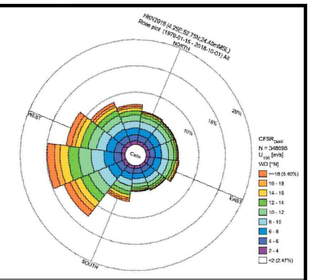


## NOTES

1. ALL DIMENSIONS AND ELEVATIONS ARE GIVEN IN MM UNLESS OTHERWISE NOTED.
2. ELEVATIONS REFER TO T.O.S.
3. ELEVATION OF THE LAMPS ARE REFFERED TO THE BOTTOM OF THE LAMP.
4. FOR THE ELEVATION OF JB, REFER TO THE TYPICAL INSTALLATION.
5. SHEET 1 OF 2 SHOWS ONLY POLE MOUNTED TYPE LIGHTING FIXTURES, SHEET 2 OF 2 SHOWS ONLY SUSPENDED TYPE LIGHTING FIXTURES.
6. FOR ELF-200N1-09-L2-26 AND ELF-200N1-09-L2-27 CONSTRUCTION DETAILS REFER TO DOC. 123A90-DDL-ST-DD-90076

## LEGEND

- EMERGENCY LIGHTING JB
- 60W LED EMERGENCY LUMINARIES
- 60W LED EMERGENCY LUMINARIES FIXTURE POLE MOUNTED
- NORMAL LIGHTING JB
- 45W LED NORMAL LUMINARIES
- 45W LED NORMAL LUMINARIES FIXTURE POLE MOUNTED
- WELDING SOCKET WITH INTEGRATED JB
- SMALL POWER SOCKET WITH INTEGRATED JB

| | |
|---|---|
| JB TAG: | JB-TAG |
| TAG: | TAG |
| ELE: | ELEVATION |
| STD: | STANDARD |

## REFERENCE DOCUMENTS

| | |
|---|---|
| 123A90-DDL-PP-DL-70070 | PLOT PLAN - LOWER & UPPER DECK |
| 123A90-DDL-EL-DL-20101 | ELECTRICAL EQUIPMENT LAYOUT - LOWER DECK |
| 123A90-DDL-EL-DD-20091 | ELECTRICAL TYPICAL INSTALLATION DETAILS - LIGHTING SYSTEM |
| 123A90-DDL-EL-DD-20092 | ELECTRICAL TYPICAL INSTALLATION DETAILS - POWER SYSTEM & CABLE INSTALLATION |
| 123A90-DDL-EL-RE-20153 | LIGHTING CALCULATION STUDY REPORT |
| 123A90-DDL-ST-DD-90076 | INDICATION PANELS ASSEMBLY AND DETAILS |

| REV. | DATE | DRN | CHKD | APPD | DESCRIPTION |
|---|---|---|---|---|---|
| 02 | 15/09/25 | PS | FMA/AMA | CGI | ASBUILT (ASB) |
| 01 | 06/08/24 | ASR | FMA/AMA | FPA/DLO | ACCEPTED FOR CONSTRUCTION (AFC) |
| 00 | 29/05/24 | ASR | FMA/AMA | FPA/DLO | ISSUE FOR REVIEW (IFR) |

CROSSWIND

ROSETTI MARINO


TITLE : BASE LOAD POWER HUB (BLPH)
LIGHTING & SOCKET LAYOUT – LOWER DECK

| | | | |
|---|---|---|---|
| CONTRACT NO./TITLE CW-I-WP4-2023-05/HOLLANDSE KUST NOORD WIND PARK | | | SCALE 1:150 |
| DRAWN ASR | CHECKED FMA/AMA | APPROVED FPA/DLO | DATE 06/08/24 |
| A1 | DRAWING NO. 123A90-DDL-EL-DL-20119 | | SHEET 1of2 / REV. 02 |


File Name : 123A90-DDL-EL-DL-20119


DRAWING NO. 123A90-DDL-EL-DL-20119

REV. 02

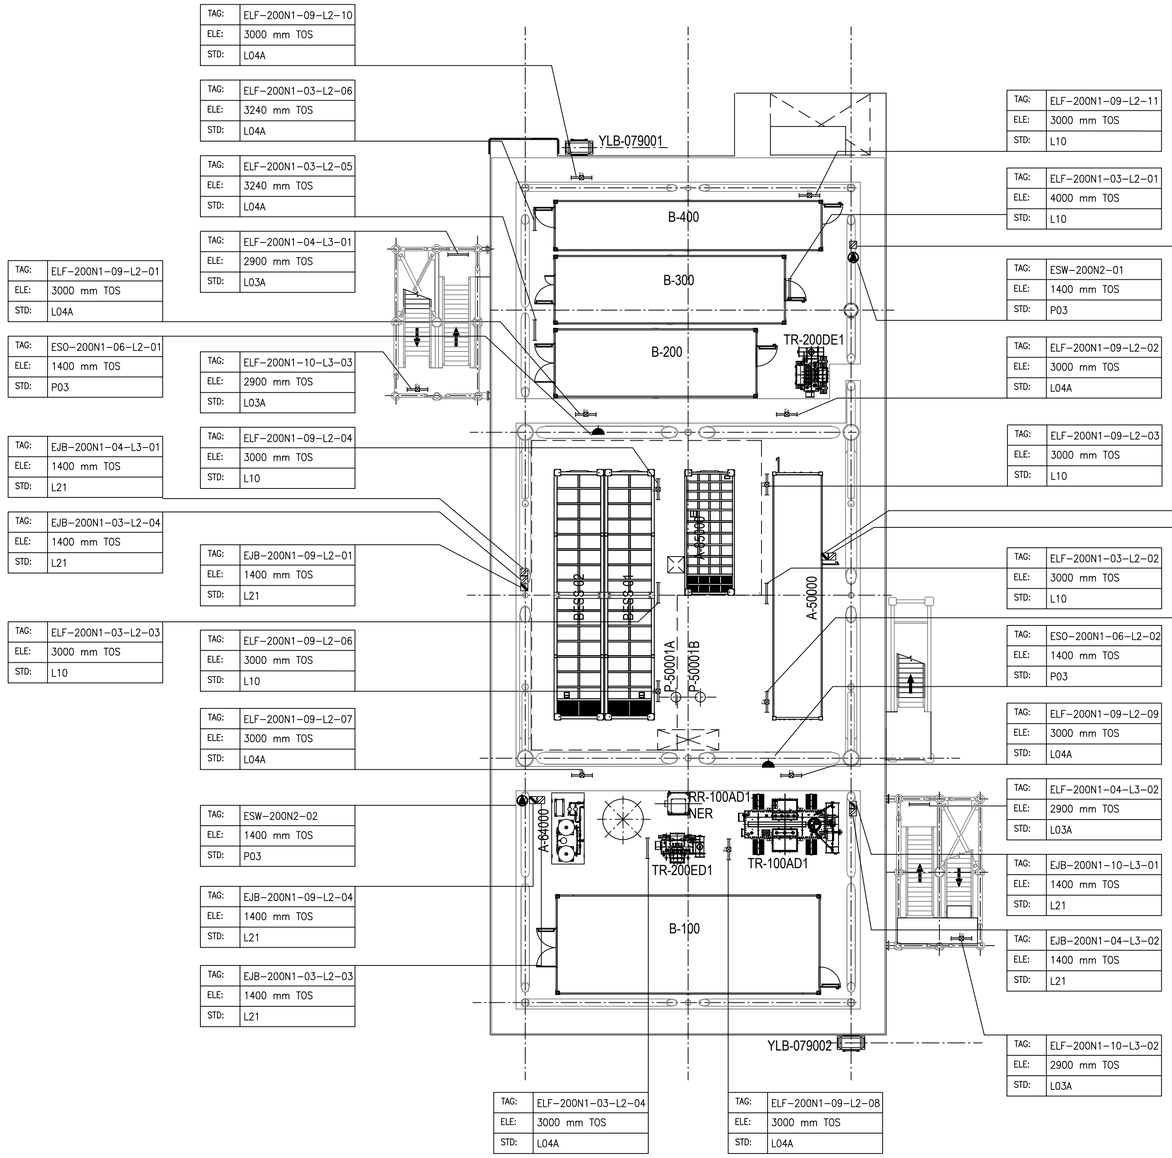


PLAN ON LOWER DECK
EL+23.310 T.O.S

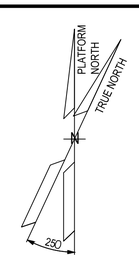

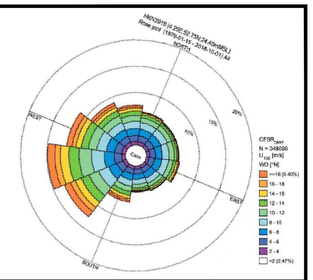
## NOTES

1. ALL DIMENSIONS AND ELEVATIONS ARE GIVEN IN mm UNLESS OTHERWISE NOTED.
2. ELEVATIONS REFER TO T.O.S.
3. ELEVATION OF THE LAMPS ARE REFFERED TO THE BOTTOM OF THE LAMP.
4. FOR THE ELEVATION OF JB, REFER TO THE TYPICAL INSTALLATION.
5. SHEET 1 OF 2 SHOWS ONLY POLE MOUNTED TYPE LIGHTING FIXTURES, SHEET 2 OF 2 SHOWS ONLY SUSPENDED TYPE LIGHTING FIXTURES.

## LEGEND

- EMERGENCY LIGHTING JB
- 60W LED EMERGENCY LUMINARIES
- 60W LED EMERGENCY LUMINARIES FIXTURE POLE MOUNTED
- NORMAL LIGHTING JB
- 45W LED NORMAL LUMINARIES
- 45W LED NORMAL LUMINARIES FIXTURE POLE MOUNTED
- WELDING SOCKET WITH INTEGRATED JB
- SMALL POWER SOCKET WITH INTEGRATED JB

| | |
|---|---|
| JB TAG: | JB–TAG |
| TAG: | TAG |
| ELE: | ELEVATION |
| STD: | STANDARD |

## REFERENCE DOCUMENTS

| | |
|---|---|
| 123A90-DDL-PP-DL-70070 | PLOT PLAN - LOWER & UPPER DECK |
| 123A90-DDL-EL-DL-20101 | ELECTRICAL EQUIPMENT LAYOUT - LOWER DECK |
| 123A90-DDL-EL-DD-20091 | ELECTRICAL TYPICAL INSTALLATION DETAILS - LIGHTING SYSTEM |
| 123A90-DDL-EL-DD-20092 | ELECTRICAL TYPICAL INSTALLATION DETAILS - POWER SYSTEM & CABLE INSTALLATION |
| 123A90-DDL-EL-RE-20153 | LIGHTING CALCULATION STUDY REPORT |

| REV. | DATE | DRN | CHKD | APPD | DESCRIPTION |
|---|---|---|---|---|---|
| 02 | 15/09/25 | PS | FMA/AMA | CGI | ASBUILT (ASB) |
| 01 | 06/08/24 | ASR | FMA/AMA | FPA/DLO | ACCEPTED FOR CONSTRUCTION (AFC) |
| 00 | 29/05/24 | ASR | FMA/AMA | FPA/DLO | ISSUE FOR REVIEW (IFR) |

CROSSWIND

ROSETTI MARINO

TITLE : BASE LOAD POWER HUB (BLPH)
LIGHTING & SOCKET LAYOUT – LOWER DECK

| | | | |
|---|---|---|---|
| CONTRACT NO./TITLE CW-I-WP4-2023-05/HOLLANDSE KUST NOORD WIND PARK | | | SCALE 1:150 |
| DRAWN ASR | CHECKED FMA/AMA | APPROVED FPA/DLO | DATE 06/08/24 |
| A1 | DRAWING NO. 123A90–DDL–EL–DL–20119 | SHEET 2of2 | REV. 02 |

File Name : 123A90-DDL-EL-DL-20119