
DRAWING NO. 123A90-DDL-EL-DL-20123

REV. 02

TAG:	PELF-B200H-F1-L1-01
ELE:	3000 mm TOS
STD:	L04C

TAG:	CELS-B200H-F1-L1-01
ELE:	1300 mm TOS
STD:	L46A

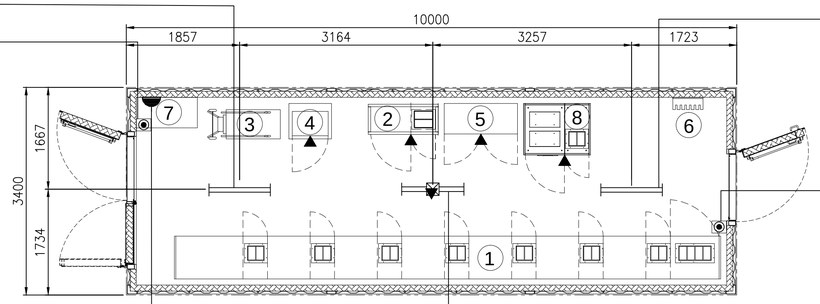

TAG:	PELF-B200H-F1-L1-03
ELE:	3000 mm TOS
STD:	L04C

TAG:	CELS-B200H-F1-L1-02
ELE:	1300 mm TOS
STD:	L46A

TAG:	PESO-B200H-F2-L2-01
ELE:	1300 mm TOS
STD:	L48


TAG:	PELF-B200H-F1-L1-02
ELE:	3000 mm TOS
STD:	L04C

LIGHTING AND SOCKET LAYOUT "B-200" LV (400V) SWITCHGEAR ROOM PLAN

1

EQUIPMENT LIST

REF.	TAG No.	DESCRIPTION	LENGTH (mm)	WIDTH (mm)	HEIGHT (mm)	NOTE
1	SG-200N1	400V SWITCHGEAR	7850	700	2331	
2	DP-200N1	DISTRIBUTION BOARD FOR LIGHTING AND SMALL POWER B.O.P.	1146	520	2250	
3	-	SERVICE TROLLEY FOR 400V SWITCHGEAR	1034	490	2030	
4	CN-200N1	ICCP PANEL	700	580	1830	
5	B200-HSB-001	DISTRIBUTION & HVAC PANEL - LV ROOM	1200	600	1900	
6	-	TOOL BOX	495	200	200	
7	-	TABLE	1000	500	750	
8	SG-200D2	ACB PANEL FOR SOLAR PACKAGE	1096	844	2294	

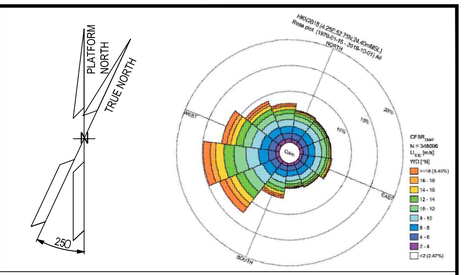

NOTES

1. ALL DIMENSIONS AND ELEVATIONS ARE GIVEN IN mm UNLESS OTHERWISE NOTED.
2. ELEVATIONS REFER TO T.O.S.
3. ELEVATION OF LAMPS AND PUSHBUTTON ARE REFERRED TO THE BOTTOM OF THE LAMP
4. CABLE FOR LIGHTING PUSHBUTTON LOCATED OUTSIDE THE CONTAINER WILL ENTER THROUGH MCT

LEGEND

- LED NORMAL LUMINARIES
- LED EMERGENCY LUMINARIES
- LIGHTING PUSHBUTTON
- CONVENIENCE POWER SOCKET OUTLET 16 A


TAG: — TAG
ELE: — ELEVATION
STD: — STANDARD

HOLDS

REFERENCE

DOCUMENT NUMBER	DOCUMENT TITLE
123A90-DDL-EL-DL-20104	ELECTRICAL EQUIPMENT LAYOUT – HV SWITCHROOM
123A90-DDL-EL-DL-20091	ELECTRICAL TYPICAL INSTALLATION DETAILS – LIGHTING SYSTEM
1724000049-AR-DA-00015	B-200 GENERAL ARRANGEMENT DRAWINGS
1724000049-EL-LIS-00044	B-200 ELECTRICAL COMPONENTS LIST AND DS – E&I SHELTERS

KEY PLAN

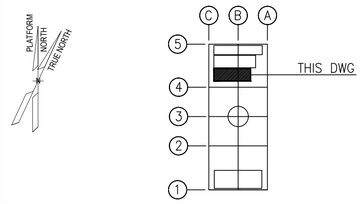

REV.	DATE	DRN	CHKD	APPD	DESCRIPTION
02	15/09/2025	SPS	FMA/AMA	CGI	AS-BUILT (ASB)
01	24/07/2024	ASR	FMA/AMA	FPA/DLO	ACCEPTED FOR CONSTRUCTION (AFC)
00	06/05/2024	ASR	FMA/AMA	FPA/DLO	ISSUE FOR REVIEW (IFR)

CROSSWIND

ROSETTI MARINO

TITLE :
BASE LOAD POWER HUB (BLPH)
LIGHTING & SOCKET LAYOUT
LV SWITCHROOM

CONTRACT NO./TITLE CW-1-WP4-2023-05/HOLLANDSE KUST NOORD WIND PARK			SCALE 1:50
DRAWN SPS	CHECKED FMA/AMA	APPROVED CGI	DATE 15/09/2025
A1	DRAWING NO. 123A90-DDL-EL-DL-20123	SHEET 001	REV. 02

File Name : 123A90-DDL-EL-DL-20123