
DRAWING NO. 123A90-DDL-EL-DL-20124

REV. 02

TAG:	PESO-B300H-F2-L2-01
ELE:	1300 mm TOS
STD:	L48

TAG:	PELF-B300H-F1-L1-02
ELE:	3000 mm TOS
STD:	L04C

TAG:	CELS-B300H-F1-L1-01
ELE:	1300 mm TOS
STD:	L46A

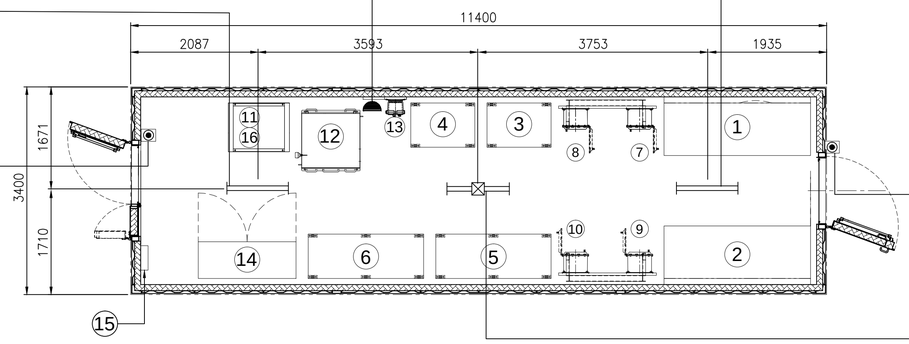

TAG:	PELF-B300H-F1-L1-03
ELE:	3000 mm TOS
STD:	L04C


TAG:	CELS-B300H-F1-L1-02
ELE:	1300 mm TOS
STD:	L46B

TAG:	PELF-B300H-F1-L1-01
ELE:	3000 mm TOS
STD:	L04C

LIGHTING AND SOCKET LAYOUT
"B-300" UPSs & BATTERIES SWITCHROOM
PLAN

EQUIPMENT LIST

REF.	TAG No.	DESCRIPTION	LENGTH (mm)	WIDTH (mm)	HEIGHT (mm)	WEIGHT (Kg)	NOTES
1	UP-200F3	AC UPS 35kVA	2400	860	1915	2258	
2	UP-200F4	AC UPS 15kVA	2400	860	1915	2258	
3	BA-200F3A	BATTERY RACK GEL VRLA 7y AC UPS 35kVA	1050	725	1272	914	
4	BA-200F3B	BATTERY RACK GEL VRLA 7y AC UPS 35kVA	1050	725	1272	914	
5	BA-200F4A	BATTERY RACK GEL VRLA 7y AC UPS 15kVA	1890	725	1761	3429	
6	BA-200F4B	BATTERY RACK GEL VRLA 7y AC UPS 15kVA	1890	725	1761	3429	
7	CB-200F3A	ISOLATOR BOX AC UPS 35kVA	600	300	800	100	
8	CB-200F3B	ISOLATOR BOX AC UPS 35kVA	600	300	800	100	
9	CB-200F4A	ISOLATOR BOX AC UPS 15kVA	600	300	800	100	
10	CB-200F4B	ISOLATOR BOX AC UPS 15kVA	600	300	800	100	
11	NC-200F2	NAVAID PANEL	1000	800	2600	535	
12	BA-200F2	BATTERY BOX NAVAID	958	993	1210	1552	
13	CB-200F2	ISOLATOR BOX NAVAID	500	400	765	70	
14	B3000-HSB-001	DISTRIBUTION & HVAC PANEL - AC/UPS ROOM	1600	600	2300	1150	
15	-	EYE WASH STATION	228	80	290	5	
16	BC-200F2	BATTERY CHARGER NAVAID	-	-	-	-	INCLUDED IN THE RACK OF NC-200F2

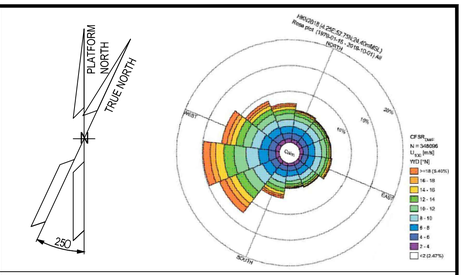

NOTES

1. ALL DIMENSIONS AND ELEVATIONS ARE GIVEN IN mm UNLESS OTHERWISE NOTED.
2. ELEVATIONS REFER TO T.O.S.
3. CABLE FOR LIGHTING PUSHBUTTON LOCATED OUTSIDE THE CONTAINER WILL ENTER THROUGH MCT
4. ELEVATION OF LAMPS ARE REFERRED TO THE BOTTOM OF THE LAMP

LEGEND

- LED NORMAL LUMINARIES
- LED EMERGENCY LUMINARIES
- LIGHTING PUSHBUTTON
- CONVENIENCE POWER SOCKET OUTLET 16A


TAG:	TAG
ELE:	ELEVATION
STD:	STANDARD

HOLDS

REFERENCE

DOCUMENT NUMBER	DOCUMENT TITLE
123A90-DDL-EL-DL-20106	ELECTRICAL EQUIPMENT LAYOUT UPSs & BATTERIES SWITCHROOM
123A90-DDL-EL-DL-20091	ELECTRICAL TYPICAL INSTALLATION DETAILS – LIGHTING SYSTEM
1724000049-AR-DA-00016	B-300 GENERAL ARRANGEMENT DRAWINGS
1724000049-EL-LIS-00045	B-300 ELECTRICAL COMPONENTS LIST AND DS – E&I SHELTERS

KEY PLAN

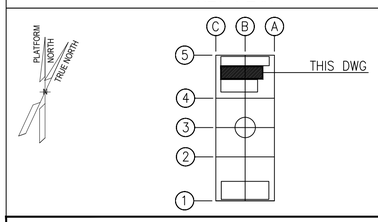

REV.	DATE	DRN	CHKD	APPD	DESCRIPTION
02	15/09/2025	SPS	FMA/AMA	CGI	AS-BUILT (ASB)
01	24/07/2024	ASR	FMA/AMA	FPA/DLO	ACCEPTED FOR CONSTRUCTION (AFC)
00	06/05/2024	SPS	FMA/AMA	FPA/DLO	ISSUE FOR REVIEW (IFR)

CROSSWIND

ROSETTI MARINO

TITLE :
BASE LOAD POWER HUB (BLPH)
LIGHTING & SOCKET LAYOUT
UPSs & BATTERIES SWITCHROOM

CONTRACT NO./TITLE	CW-I-WP4-2023-05/HOLLANDSE KUST NOORD WIND PARK		SCALE 1:50
DRAWN SPS	CHECKED FMA/AMA	APPROVED CGI	DATE 15/09/2025

A1	DRAWING NO. 123A90-DDL-EL-DL-20124	SHEET 001	REV. 02

File Name : 123A90-DDL-EL-DL-20124