BASE LOAD POWER HUB (BLPH)

EARTHING & LIGHTNING LAYOUT

LV SWITCHROOM

REV.	DATE	DRN	CHKD	APPD	DESCRIPTION
02	15/09/25	SPS	FMA/AMA	CGI	AS-BUILT (ASB)
01	25/07/24	ASR	FMA/AMA	FPA/DLO	ACCEPTED FOR CONSTRUCTION (AFC)
00	21/05/24	SPS	FMA/AMA	FPA/DLO	ISSUE FOR REVIEW (IFR)

CROSSWIND

ROSETTI MARINO

TITLE : BASE LOAD POWER HUB (BLPH)
EARTHING & LIGHTNING LAYOUT – LV SWITCHROOM
FRONT PAGE

CONTRACT NO./TITLE CW-I-WP4-2023-05/HOLLANDSE KUST NOORD WIND PARK

SCALE : NTS

A3

DRAWING NO. 123A90-DDL-EL-DL-20137


SHEET 001

REV. 02


F.to UNI A3: 420mmx297mm

File Name : 123A90-DDL-EL-DL-20137 Rev. 02

REV.	SHEET NUMBER	DESCRIPTION	REF. CODE
01	001	FRONT PAGE	
01	002	SUMMARY	
01	003	"B-200"LV SWITCHROOM	

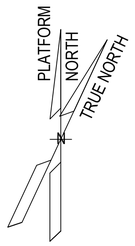

EQUIPMENT LIST		
REF.	TAG No.	DESCRIPTION
1	SG-200N1	400V SWITCHGEAR
2	DP-200N1	DISTRIBUTION BOARD FOR LIGHTING AND SMALL POWER B.O.P.
3		SERVICE TROLLEY FOR 400V SWITCHGEAR
4	CN-200N1	ICCP PANEL
5	B200-HSB-001	HVAC PANEL - LV ROOM
6		TOOL BOX
7		TABLE
8	SG-200D2	ACB PANEL FOR SOLAR PACKAGE

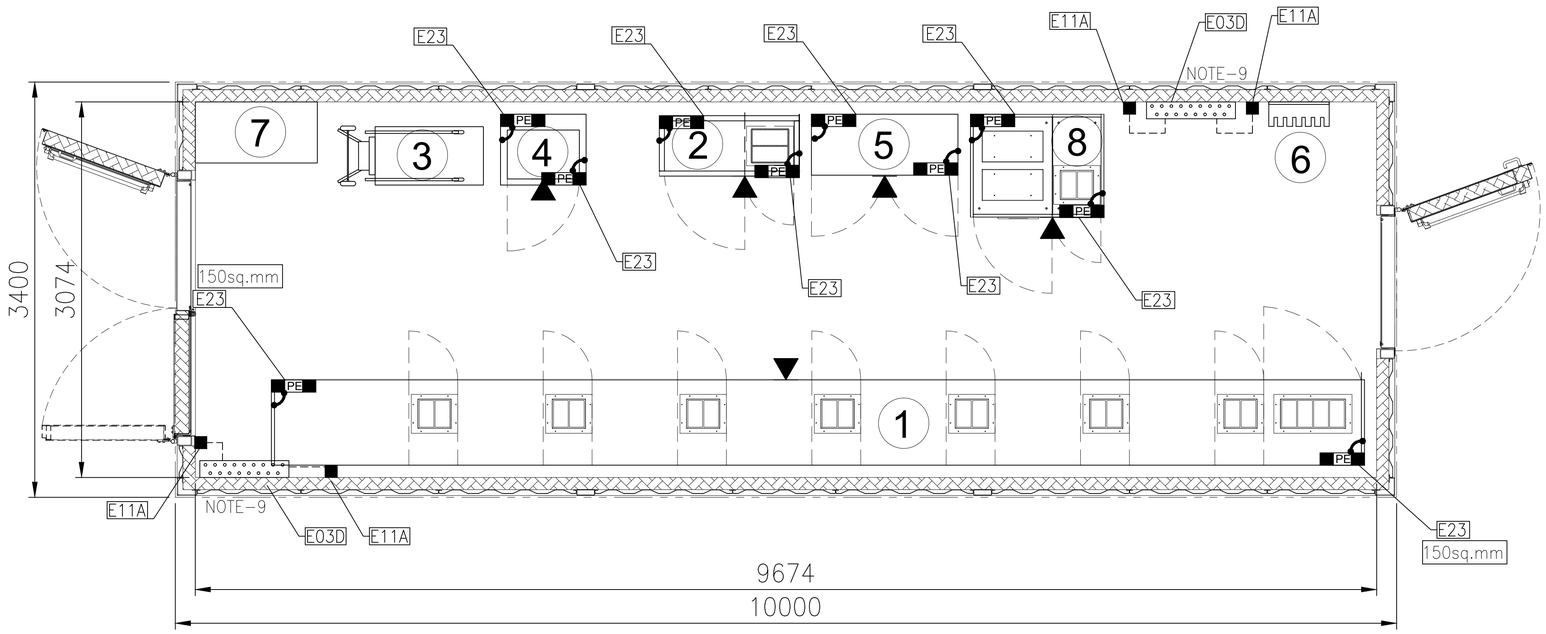

EARTHING LAYOUT
"B-200"LV SWITCHROOM
PLAN
EL.+ 23.310 T.O.S.

NOTES

1. THIS DOUCMENT IS VALID ONLY FOR EARTHING LAYOUT.
2. THE CABLE SIZE SHALL BE CONFIRMED.
3. THE EXACT POSITION OF EARTHING/MARSHALLING BUS BAR SHALL BE DEFINED BY VENDOR.
4. THE EARTHING BUS BAR INSTALLATION SHALL BE PREFERABLY IN VERTICAL MODE.
5. FOR TYPICAL DETAILS PLEASE REFER DOCUMENT "123A90-DDL-EL-DD-20090-ELECTRICAL TYPICAL INSTALLATION DETAILS- EARTHING SYSTEM".
6. DUE TO THE TOP CABLE ENTRIES THE EARTHING BUS BAR INSIDE THE CABINETS SHALL BE INSTALLED AT THE TOP OF THE CABINETS THEMSELVES.
7. FOR LIGHTNING PROTECTION SYSTEM SURGE PROTECTIVE DEVICES (SPD), REFER DOCUMENT 123A90-DDL-EL-RE-20154.
8. ALL NON WELDED OBJECTS SHALL BE EARTHED.
9. CONTAINER WILL HAVE A BTH (EARTHING BAR TINNED COPPER) WITH 2 EARTHING BOSS, INSTALLED IN THE SOUTH-WEST CORNER AT AN ELEVATION OF 2.5M FROM THE CONTAINER FLOOR. EARTHING BOSS SHALL BE INSTALLED AT SAME ELEVATION 2.5M.

SYMBOL	DESCRIPTION
PE	EARTHING BUS
	EARTHING BAR TINNED COPPER WITH no.18 HOLES
	35sq.mm Y/G INSULATED COPPER CONDUCTOR FOR PE
PE	PROTECTIVE EARTH
	EARTHING BOSS AISI316L
	JUMPER CONNECTION
	FRONT OF EQUIPMENT

REFERENCE	
DOCUMENT NUMBER	DOCUMENT TITLE
123A90-DDL-EL-DD-20090	ELECTRICAL TYPICAL INSTALLATION DETAILS -EARTHING SYSTEM
123A90-DDL-EL-DL-20105	ELECTRICAL EQUIPMENT LAYOUT-LV SWITCHROOM
1724000049-AR-DD-00019	B-200 DETAILED DRAWINGS - E&I SHELTERS

REV.	DATE	DRN	CHKD	APPD	DESCRIPTION
02	15/09/25	SPS	FMA/AMA	CGI	AS-BUILT (ASB)
01	25/07/24	ASR	FMA/AMA	FPA/DLO	ACCEPTED FOR CONSTRUCTION (AFC)
00	21/05/24	SPS	FMA/AMA	FPA/DLO	ISSUE FOR REVIEW (IFR)

CROSSWIND

ROSETTI MARINO

TITLE : BASE LOAD POWER HUB (BLPH)
EARTHING & LIGHTNING LAYOUT - LV SWITCHROOM
"B-200"LV SWITCHROOM

CONTRACT NO./TITLE CW-I-WP4-2023-05/HOLLANDSE KUST NOORD WIND PARK

SCALE : 1:50

A3

DRAWING NO. 123A90-DDL-EL-DL-20137

SHEET 003

REV. 02

F.to UNI A3: 420mmx297mm

File Name : 123A90-DDL-EL-DL-20137 Rev. 02