


DRAWING NO. 123A90-DDL-EL-DL-20140

REV. 02

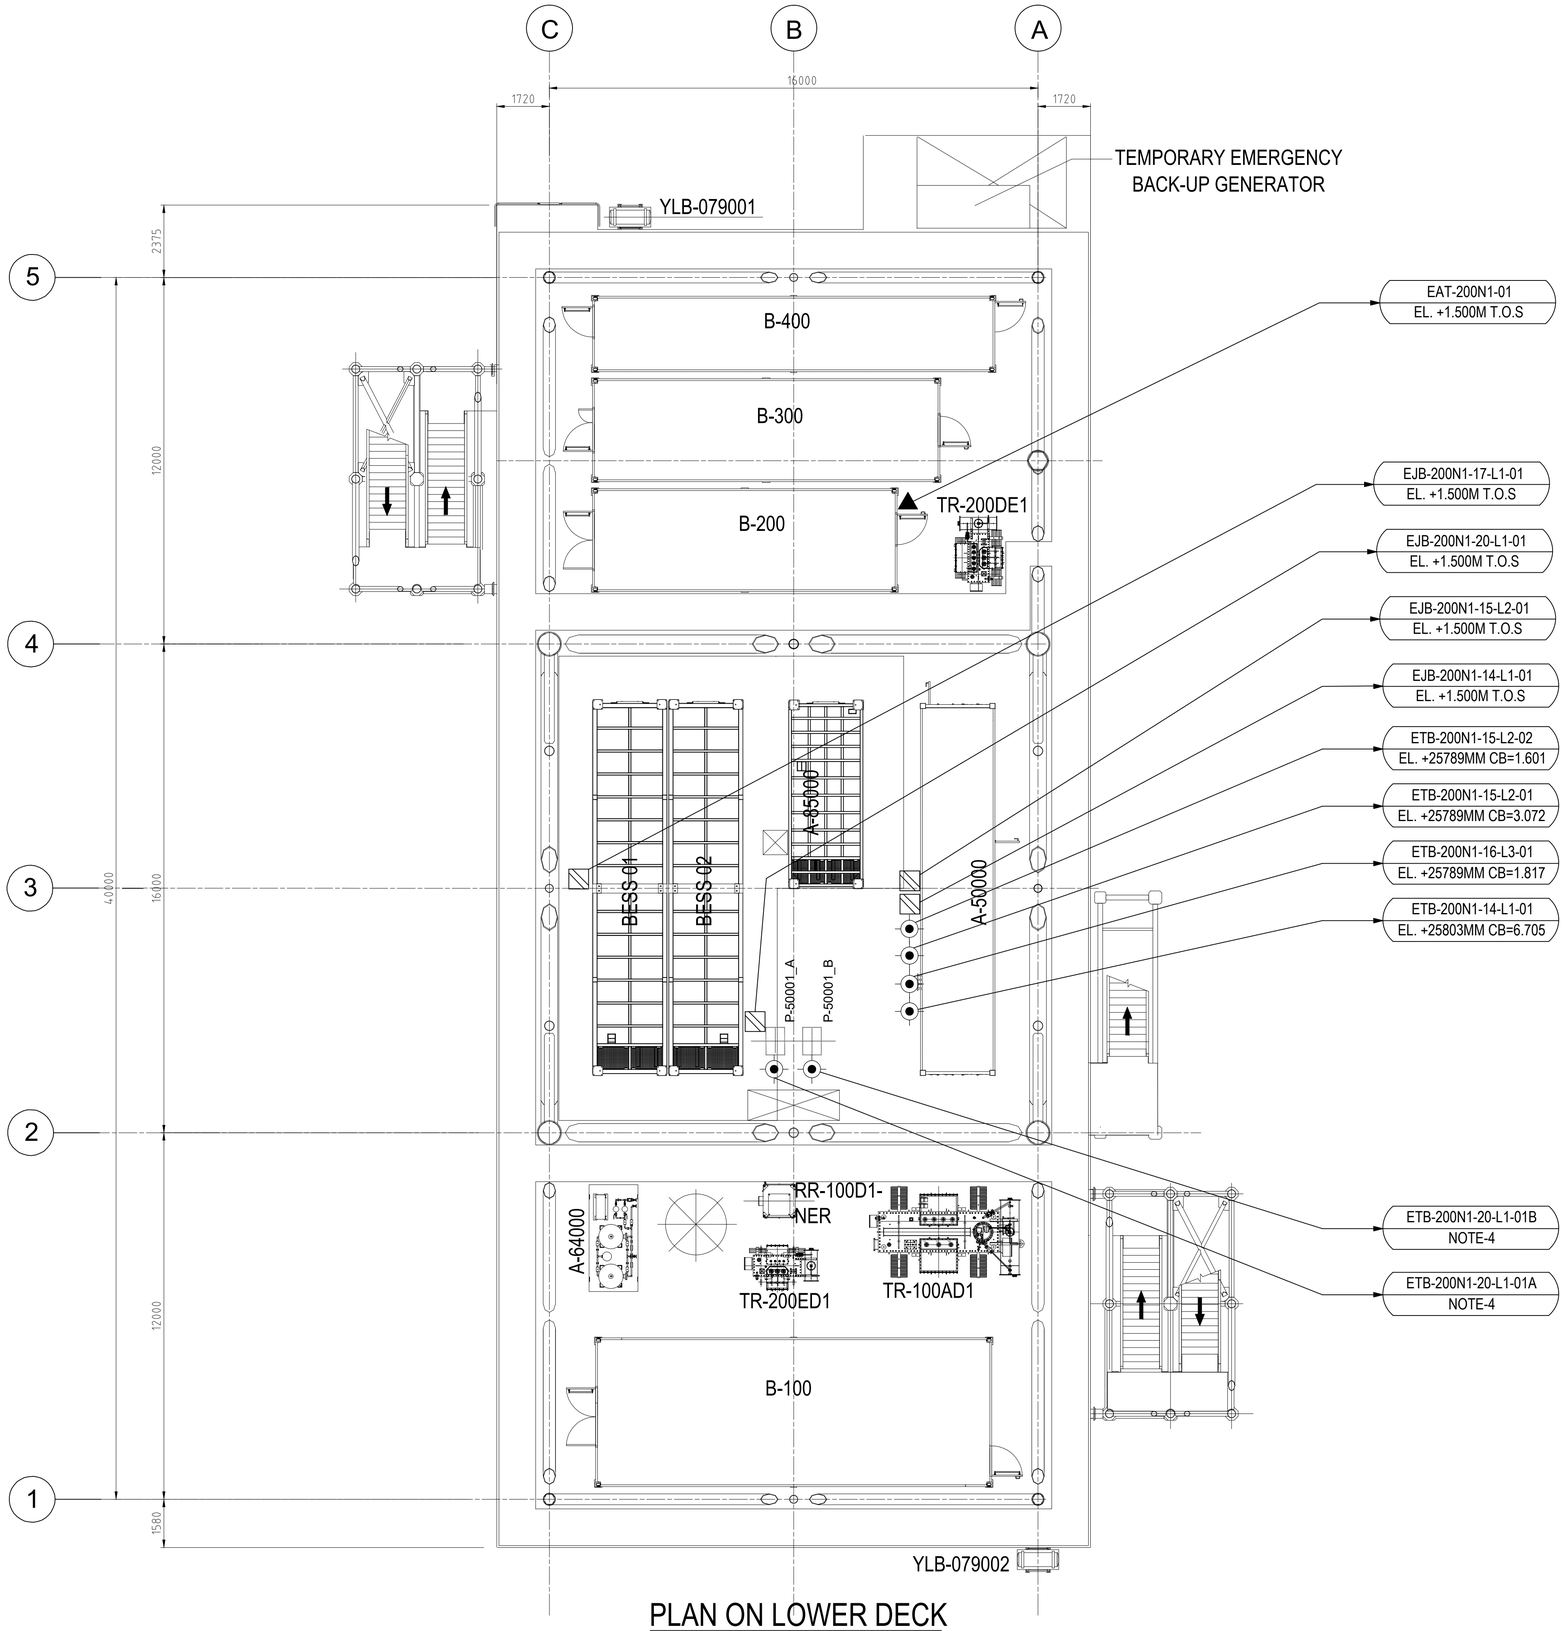

PLAN ON LOWER DECK
EL+23.310 T.O.S.

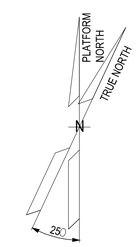

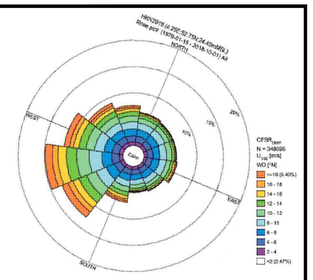

NOTES

1. ALL DIMENSIONS ARE IN MILLIMETERS
2. FOR PROCESS LINE LIST REFER TO DOCUMENT 123A90-DDL-PR-LIS-80035
3. FOR THE ELECTRICAL HEAT TRACING OF THE PIPE LINES OF WATER TREATMENT PACKAGE ONLY BOTH FLANGES OF BATTERY LIMIT (INLET AND OUTLET) AND ONE METER OF PIPE INSIDE THE PACKAGE WILL BE ELECTRICAL HEAT TRACED
4. HOT JB ARE IN THE VENDOR EQUIPMENT SCOPE
5. THIS DOCUMENT IS ONLY VALID FOR POSITIONING OF HEAT TRACING SYSTEM COMPONENTS.


LEGEND

- TRACE HEATING JUNCTION BOX (HOT JB)
- POWER SUPPLY JUNCTION BOX (COLD JB)
- TEMPERATURE CONTROL UNIT

EJB-200N1-14-L1-01 / EL. +1.500M T.O.S — TAG NUMBER – POWER SUPPLY JUNCTION BOX

ETB-200N1-14-L1-01 / EL. +30904MM CB=0.311 — TAG NUMBER – TRACE HEATING JUNCTION BOX WITH ELEVATION AND ABSORBED CURRENT CIRCUIT

KEY PLAN

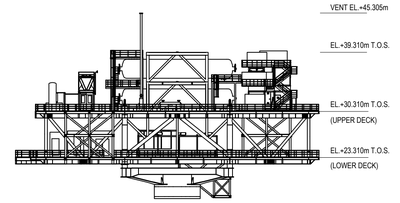

REFERENCE DOCUMENTS

123A90-DDL-PR-PID-80021	P&ID SEA WATER INTAKE SYSTEM
123A90-DDL-PR-PID-80022	P&ID SEA WATER INTAKE SYSTEM
123A90-DDL-PR-PID-80024	P&ID WATER TREATMENT PLANT
123A90-DDL-PR-PID-80029	P&ID HYDROGEN VENT DRUM
123A90-DDL-PR-LIS-80035	PROCESS LINE LIST
123A90-DDL-EL-DG-20162	ELECTRICAL SINGLE LINE DIAGRAMS (BoP)
1724001647-EL-DD-00004	ISOMETRICS EHT
1724001647-EL-DG-00006	EHT SINGLE LINE DIAGRAM
1724001647-EL-PL-00009	EHT PLOT PLAN

REV.	DATE	DRN	CHKD	APPD	DESCRIPTION
02	15/09/2025	SPS	FMA/AMA	CGI	AS-BUILT (ASB)
01	14/10/2024	SAM	FMA/AMA	FPA/DLO	ACCEPTED FOR CONSTRUCTION (AFC)
00	25/06/2024	SPS	FMA/AMA	FPA/DLO	ISSUE FOR REVIEW (IFR)

CROSSWIND

ROSETTI MARINO


TITLE : BASE LOAD POWER HUB (BLPH)
ELECTRICAL HEAT TRACING (EHT)
JUNCTION BOX LAYOUT

CONTRACT NO./TITLE	CW-I-WP4-2023-05/HOLLANDSE KUST NOORD WIND PARK		SCALE 1:100
DRAWN SPS	CHECKED FMA/AMA	APPROVED CGI	DATE 15/09/25
A1	DRAWING NO. 123A90-DDL-EL-DL-20140	SHEET 1of2	REV. 02


File Name : 123A90-DDL-EL-DL-20140_Rev.02


DRAWING NO. 123A90-DDL-EL-DL-20140

REV. 02

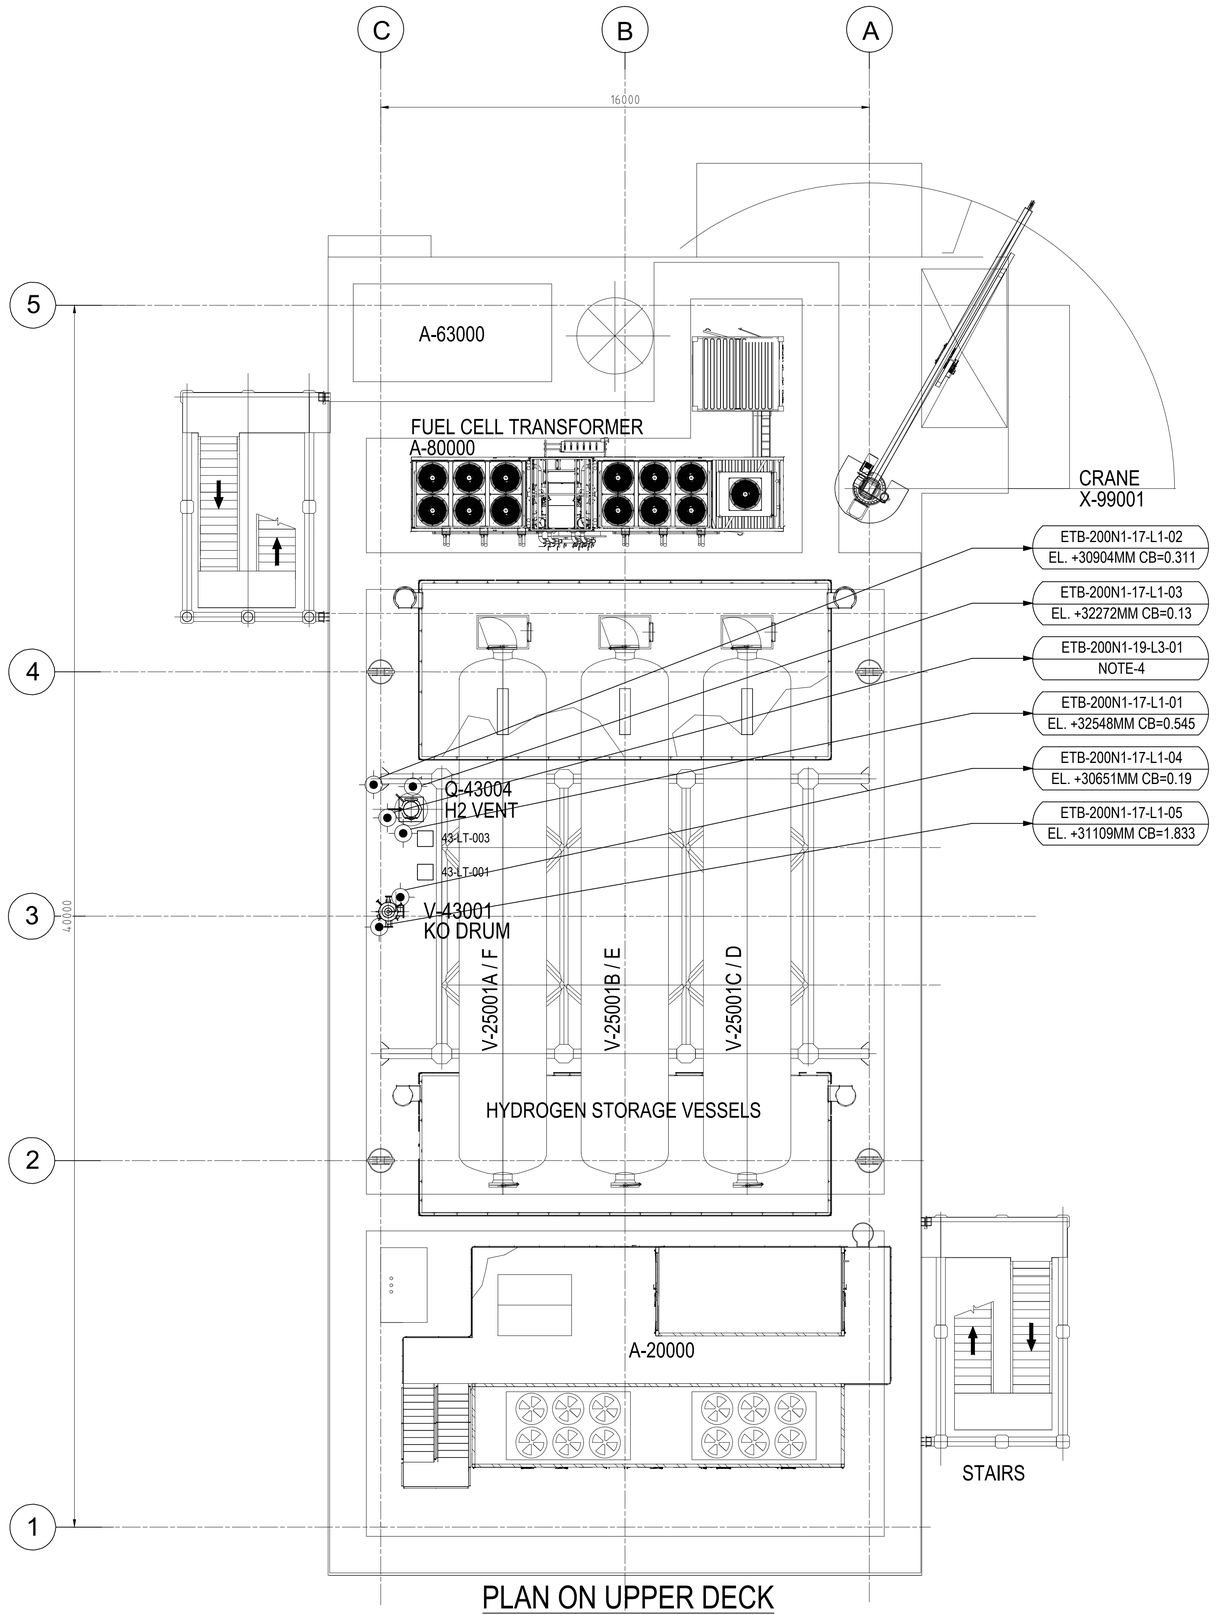

PLAN ON UPPER DECK
EL+30.310 T.O.S.

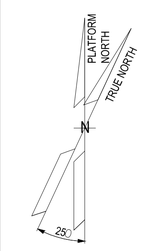

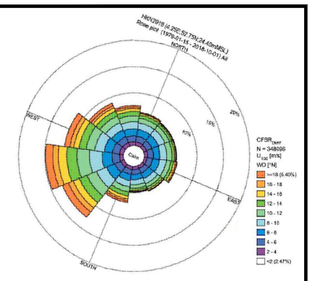

NOTES

1. ALL DIMENSIONS ARE IN MILLIMETERS
2. FOR PROCESS LINE LIST REFER TO DOCUMENT 123A90-DDL-PR-LIS-80035
3. FOR THE ELECTRICAL HEAT TRACING OF THE PIPE LINES OF WATER TREATMENT PACKAGE ONLY BOTH FLANGES OF BATTERY LIMIT (INLET AND OUTLET) AND ONE METER OF PIPE INSIDE THE PACKAGE WILL BE ELECTRICAL HEAT TRACED
4. HOT JB ARE IN THE VENDOR EQUIPMENT SCOPE
5. THIS DOCUMENT IS ONLY VALID FOR POSITIONING OF HEAT TRACING SYSTEM COMPONENTS.


LEGEND

- TRACE HEATING JUNCTION BOX (HOT JB)
- POWER SUPPLY JUNCTION BOX (COLD JB)
- TEMPERATURE CONTROL UNIT

EJB-200N1-14-L1-01 / EL. +1.500M T.O.S — TAG NUMBER – POWER SUPPLY JUNCTION BOX

ETB-200N1-14-L1-01 / EL. +30904MM CB=0.311 — TAG NUMBER – TRACE HEATING JUNCTION BOX WITH ELEVATION AND ABSORBED CURRENT CIRCUIT

KEY PLAN

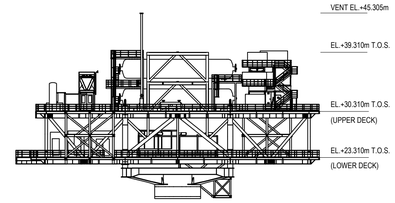

REFERENCE DOCUMENTS

123A90-DDL-PR-PID-80021	P&ID SEA WATER INTAKE SYSTEM
123A90-DDL-PR-PID-80022	P&ID SEA WATER INTAKE SYSTEM
123A90-DDL-PR-PID-80024	P&ID WATER TREATMENT PLANT
123A90-DDL-PR-PID-80029	P&ID HYDROGEN VENT DRUM
123A90-DDL-PR-LIS-80035	PROCESS LINE LIST
123A90-DDL-EL-DG-20162	ELECTRICAL SINGLE LINE DIAGRAMS (BoP)
1724001647-EL-DD-00004	ISOMETRICS EHT
1724001647-EL-DG-00006	EHT SINGLE LINE DIAGRAM
1724001647-EL-PL-00009	EHT PLOT PLAN

REV.	DATE	DRN	CHKD	APPD	DESCRIPTION
02	15/09/2025	SPS	FMA/AMA	CGI	AS-BUILT (ASB)
01	14/10/2024	SAM	FMA/AMA	FPA/DLO	ACCEPTED FOR CONSTRUCTION (AFC)
00	25/06/2024	SPS	FMA/AMA	FPA/DLO	ISSUE FOR REVIEW (IFR)

CROSSWIND

ROSETTI MARINO

TITLE :
BASE LOAD POWER HUB (BLPH)
ELECTRICAL HEAT TRACING (EHT)
JUNCTION BOX LAYOUT

CONTRACT NO./TITLE CW-I-WP4-2023-05/HOLLANDSE KUST NOORD WIND PARK		SCALE 1:100	
DRAWN SPS	CHECKED FMA/AMA	APPROVED CGI	DATE 15/09/25
A1	DRAWING NO. 123A90-DDL-EL-DL-20140	SHEET 2of2	REV. 02

File Name : 123A90-DDL-EL-DL-20140_Rev.02