DRAWING NO. 123A90-DDL-IN-DG-40015

REV. 02

RLMU LIST

REV.01B: SHEET 8, 28
REV.01C: SHEET 3
REV.01D: SHEET 22, 30
REV.01E: SHEET 3, 24, 33 ÷ 38, 41
REV.01F: SHEET 33 ÷ 38
REV.01G: SHEET 3
REV.01H: SHEET 7
REV.01I: SHEET 39, 40, 41, 42
REV.01J: SHEET 19, 20, 22, 37
REV.01K: SHEET 37

BASE LOAD POWER HUB (BLPH)

INSTRUMENT - PCS WIRING DIAGRAM

REV.	DATE	DRN	CHKD	APPD	DESCRIPTION
02	29/09/2025	SPS	LCA	CGI	AS-BUILT (ASB)
01	04/10/2024	VBA	DLO	CGI	ACCEPTED FOR CONSTRUCTION (AFC)
00	23/02/2024	VBA	DLO	CGI	ISSUE FOR REVIEW (IFR)

CROSSWIND

ROSETTI MARINO

TITLE : BASE LOAD POWER HUB (BLPH)
INSTRUMENT – PCS WIRING DIAGRAMS
COVER SHEET

CONTRACT NO./TITLE			SCALE N/A
DRAWN SPS	CHECKED LCA	APPROVED CGI	DATE 29/09/2025

A3	DRAWING NO. 123A90-DDL-IN-DG-40015	SHEET 001	REV. 02

File Name : 123A90-DDL-IN-DG-40015_Rev.02

DRAWING NO. 123A90-DDL-IN-DG-40015

REV. 02

SHEET NO.	DESCRIPTION	REV. NO.
01	COVER SHEET	01
02	INDEX / REVISION SHEET	01
03	GENERAL NOTES / LEGENDS	01
04	00-JE-11001 -SH. 1 OF 2	01
05	00-JE-11001 -SH. 2 OF 2	01
06	00-JE-11002	01
07	00-JE-11003 -SH. 1 OF 2	01
08	00-JE-11003 -SH. 2 OF 2	01
09	00-JE-11004	01
10	00-JE-11005	01
11	63-PT-003	01
12	SPARE	01
13	SPARE	01
14	SPARE	01
15	00-JE-12001 -SH. 1 OF 2	01
16	00-JE-12001 -SH. 2 OF 2	01
17	00-JE-12002	01
18	00-JE-12003	01
19	00-JE-12004 -SH. 1 OF 2	01
20	00-JE-12004 -SH. 2 OF 2	01
21	00-JE-12005	01
22	00-JE-12006 -SH. 1 OF 2	01
23	00-JE-12006 -SH. 2 OF 2	01
24	B-100÷400 - ACCESS CONTROL SIGNALS	01
25	SPARE	01
26	SPARE	01
27	SPARE	01
28	00-JE-13001	01
29	00-JE-13002	01
30	00-JE-13003	01
31	SPARE	01
32	SPARE	01
33	COMMUNICATION - CAT-6	01
34	COMMUNICATION - CAT-6	01
35	COMMUNICATION - CAT-6	01
36	COMMUNICATION - CAT-6	01
37	COMMUNICATION - CAT-6	01
38	COMMUNICATION - CAT-6	01
39	COMMUNICATION - F.O.	01
40	COMMUNICATION - F.O.	01
41	COMMUNICATION - F.O.	01

SHEET NO.	DESCRIPTION	REV. NO.

CROSSWIND

ROSETTI MARINO

TITLE :

BASE LOAD POWER HUB (BLPH)
INSTRUMENT – PCS WIRING DIAGRAMS
INDEX/REVISION SHEET

CONTRACT NO./TITLE			SCALE N/A
DRAWN SPS	CHECKED LCA	APPROVED CGI	DATE 29/09/2025

A3	DRAWING NO. 123A90-DDL-IN-DG-40015	SHEET 002	REV. 02


File Name : 123A90-DDL-IN-DG-40015_Rev.02

DRAWING NO. 123A90-DDL-IN-DG-40015

REV. 02

NOTES:

1. ALL SPARE ENTRIES SHALL BE PROVIDED WITH CERTIFIED EX PROOF PLUGS.
2. CABLE SCREENS / DRAIN WIRE SHALL BE SECURELY INSULATED AND TIED BACK IN THE INSTRUMENT SIDE AND SHAL BE TERMINATED IN THE MARSHALLING SIDE OF THE PANEL.
3. SPARE PAIRS / TRIADS SHALL BE CONNECTED TO TERMINALS IN JUNCTION BOX AND PANEL / MARSHALLING CABINETS.
4. ALL CABLE SCREENS TO BE TERMINATED AT THE INSTRUMENT EARTH BAR IN THE RESPECTIVE EARTH BARS (IS OR NIS) AS APPLICABLE IN THE MARSHALLING CABINET.
5. SWITCH TAG NAME AND PORT WILL BE DEFINED DURING THE CONSTRUCTION PHASE
6. FOR OPTICAL FIBERS, USE THE FOLLOWING COLOR CODING:
   01. RED
   02. GREEN
   03. BLUE
   04. YELLOW
   05. GRAY
   06. PURPLE
   07. BROWN
   08. ORANGE
   09. WHITE
   10. PINK
   11. BLACK
   12. TURQUOISE
7. CAT.6A CABLE SHALL BE TERMINATED MEETING REQUIREMENTS OF STANDARD EIA/TIA 568B:

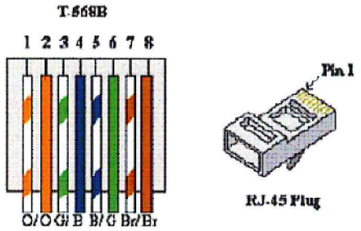

8. FOR INSTRISICALLY SAFE CIRCUIT USE LIGHT BLUE CABLE OF ALTENATIVELY ORANGE CABLE WITH HEAT SHRINKABLE SLEEVE BLUE AT BOTH END (SEE DOC. 123A90-FDL-IN-DD-40017).

LEGENDS & SYMBOLS:

LEGEND:

I.E.	- GREEN ———— - INSTRUMENT SIGNAL EARTH
P.E.	- GREEN / YELLOW —— P.E. EARTH / BONDING
	- TERMINAL BLOCK (TB)
WH	- WHITE
BK	- BLACK
RD	- RED
S	- SHIELD TERMINAL
OS	- OVERALL SHIELD TERMINAL
O/A Shld	- OVERALL SHIELD
I&O/A Shld	- INDIVIDUAL & OVERALL SHIELD
NIS	- NON INTRINSICALLY SAFE
IS	- INTRINSICALLY SAFE
P.E.	- PLANT EARTH
PCS	- PROCESS CONTROL SYSTEM
ESD	- EMERGENCY SHUTDOWN SYSTEM
SIS	- SAFETY INSTRUMENT SYSTEM
FGS	- FIRE & GAS SYSTEM
MC	- MARSHALLING CABINET
AI	- ANALOGUE INPUT
AO	- ANALOGUE OUTPUT
DI	- DIGITAL INPUT
DO	- DIGITAL OUTPUT
JE	- JUNCTION BOX FOR ELECTRICAL SIGNALS

REFERENCE DRAWINGS:

PIPING AND INSTRUMENT DIAGRAM	123A90-DDL-PR-PID-80009
INSTRUMENT INDEX	123A90-DDL-IN-LIS-40088
F&G DETECTORS LAYOUT	123A90-DDL-SAF-DL-30027

NOTES:


A. HEAT SHRINKABLE BLACK FOR SHIELD OF NIS INSTRUMENT CABLE. HEAT SHRINKABLE BLUE FOR SHIELD OF IS INSTRUMENT CABLE.

B. ABOVE DESCRIBED PHILOSOPHY IS INTENDED FOR CONNECTIONAS REPRESENTED. IN CASE OF CONNECTION FROM THE OPPESITE SIDE, ORDER OF FERULE TAG SHALL BE MIRRORED.


C. SAME TAGGING PHILOSOPHY SHALL APPLIED ALSO TO SHIELDS TERMINATED ON TERMINAL STRIP.

PHILOSOPHY OF CROSS - FERRULING:


INSTRUMENT CONNECTION THROUGH MARSHALLING JB TO CABINET

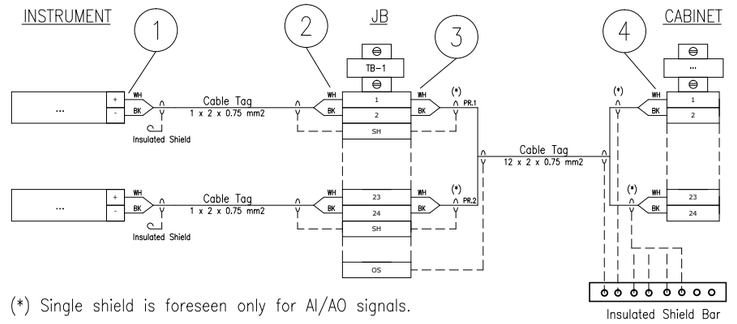

INSTRUMENT CONNECTION STRAIGHT TO CABINET

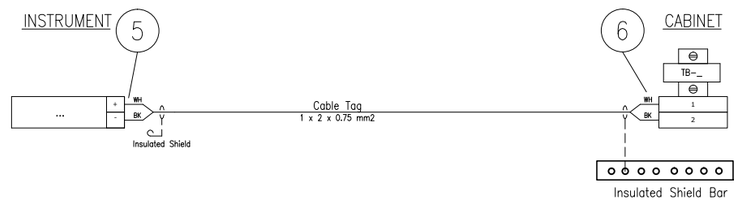

CABINET CONNECTION TO CABINET

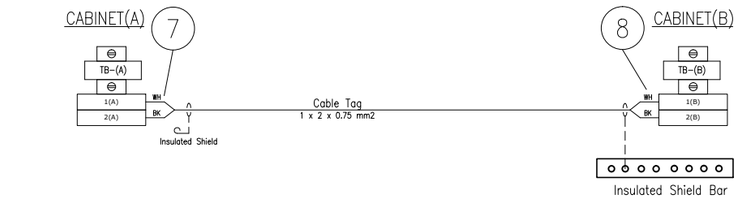

1 - INSTRUMENT TERMINAL NO. OR POLARITY/JB NO./JB TERMINAL NO.
2 - INSTRUMENT TERMINAL NO. OR POLARITY / INSTR TAG / JB TERMINAL NO.
3 - JB TERMINAL NO. / JB TERMINAL STRIP / CABINET TERMINAL STRIP / PAIR OR CORE NO.
4 - PAIR OR CORE NO./JB TAG./JB TERMINAL NO./ CABINET TERMINAL STRIP / CABINET TERMINAL NO.
5 - INSTR. TERMINAL NO. OR POLARITY / CABINET TAG / CABINET TERMINAL STRIP / CABINET TERMINAL NO.
6 - INSTR. TERMINAL NO. OR POLARITY / INSTR. TAG / CABINET TERMINAL STRIP / CABINET TERMINAL NO.
7 - TERMINAL NO. (A) TERMINAL STRIP (A) / CABINET TAG (B) / CABINET TERMINAL NO.(B) / PAIR OR CORE NO.
8 - PAIR OR CORE NO. / CABINET TERMINAL NO.(A) / CABINET TAG (A) / TERMINAL STRIP (B) / TERMINAL NO.(B)

CROSSWIND

ROSETTI MARINO

TITLE :

BASE LOAD POWER HUB (BLPH)
INSTRUMENT – PCS WIRING DIAGRAMS
GENERAL NOTES/LEGENDS


CONTRACT NO./TITLE			SCALE N/A
DRAWN SPS	CHECKED LCA	APPROVED CGI	DATE 29/09/2025
A3	DRAWING NO. 123A90-DDL-IN-DG-40015	SHEET 003	REV. 02

File Name : 123A90-DDL-IN-DG-40015_Rev.02

DRAWING NO. 123A90-DDL-IN-DG-40015

REV. 02

FIELD		MULTICABLE	I&T EQUIPMENT ROOM (ITER)
INSTRUMENTS	JUNCTION BOX 00-JE-11001	No.	MARSHALLING CABINET B400-PCS-002

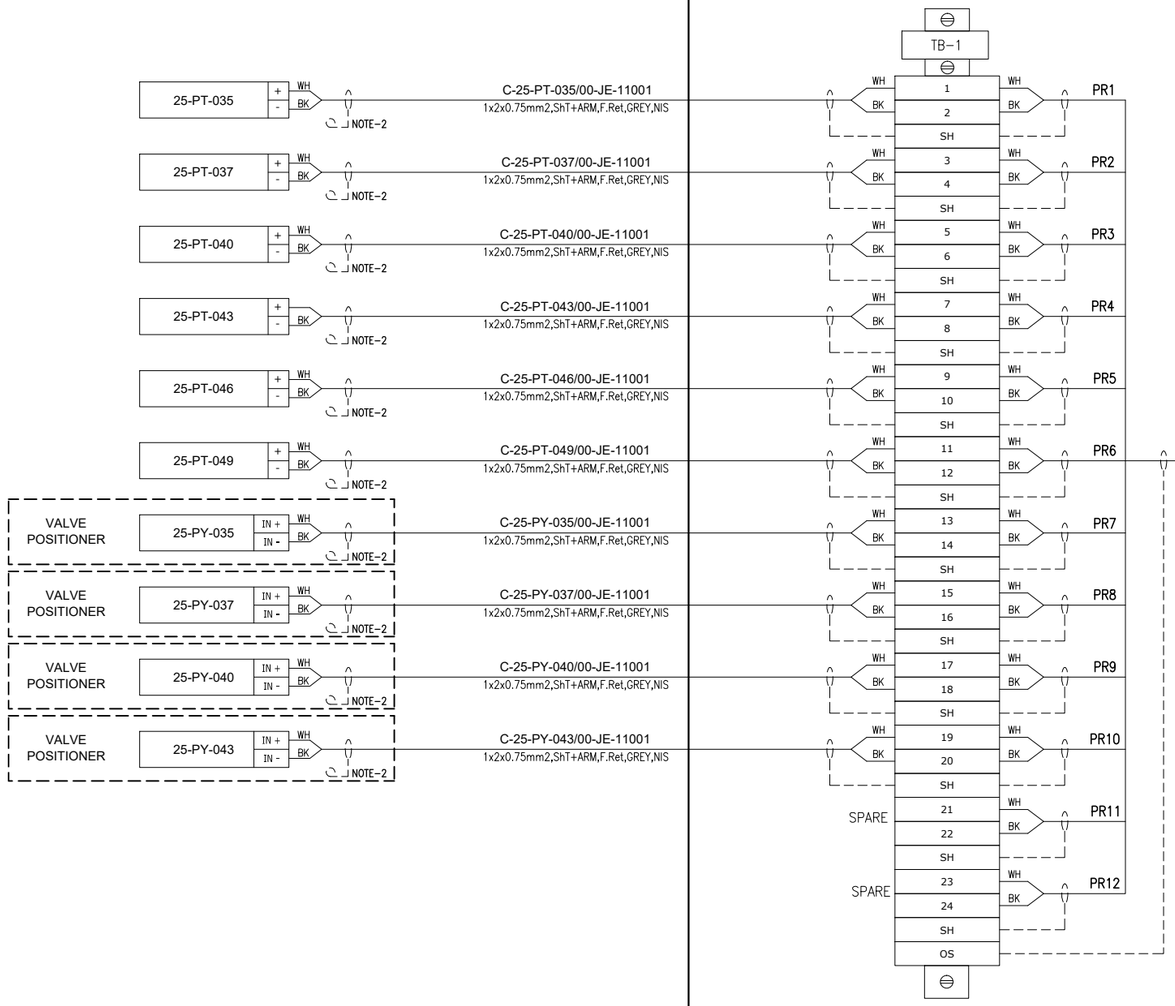

CROSSWIND

ROSETTI MARINO

TITLE :

BASE LOAD POWER HUB (BLPH)
INSTRUMENT – PCS WIRING DIAGRAMS
00–JE–11001–SH.1 OF 2


CONTRACT NO./TITLE			SCALE N/A
DRAWN SPS	CHECKED LCA	APPROVED CGI	DATE 29/09/2025
A3	DRAWING NO. 123A90–DDL–IN–DG–40015	SHEET 004	REV. 02

File Name : 123A90-DDL-IN-DG-40015_Rev.02

DRAWING NO. 123A90-DDL-IN-DG-40015

REV. 02

FIELD		MULTICABLE	I&T EQUIPMENT ROOM (ITER)
INSTRUMENTS	JUNCTION BOX 00-JE-11001	No.	MARSHALLING CABINET B400-PCS-002

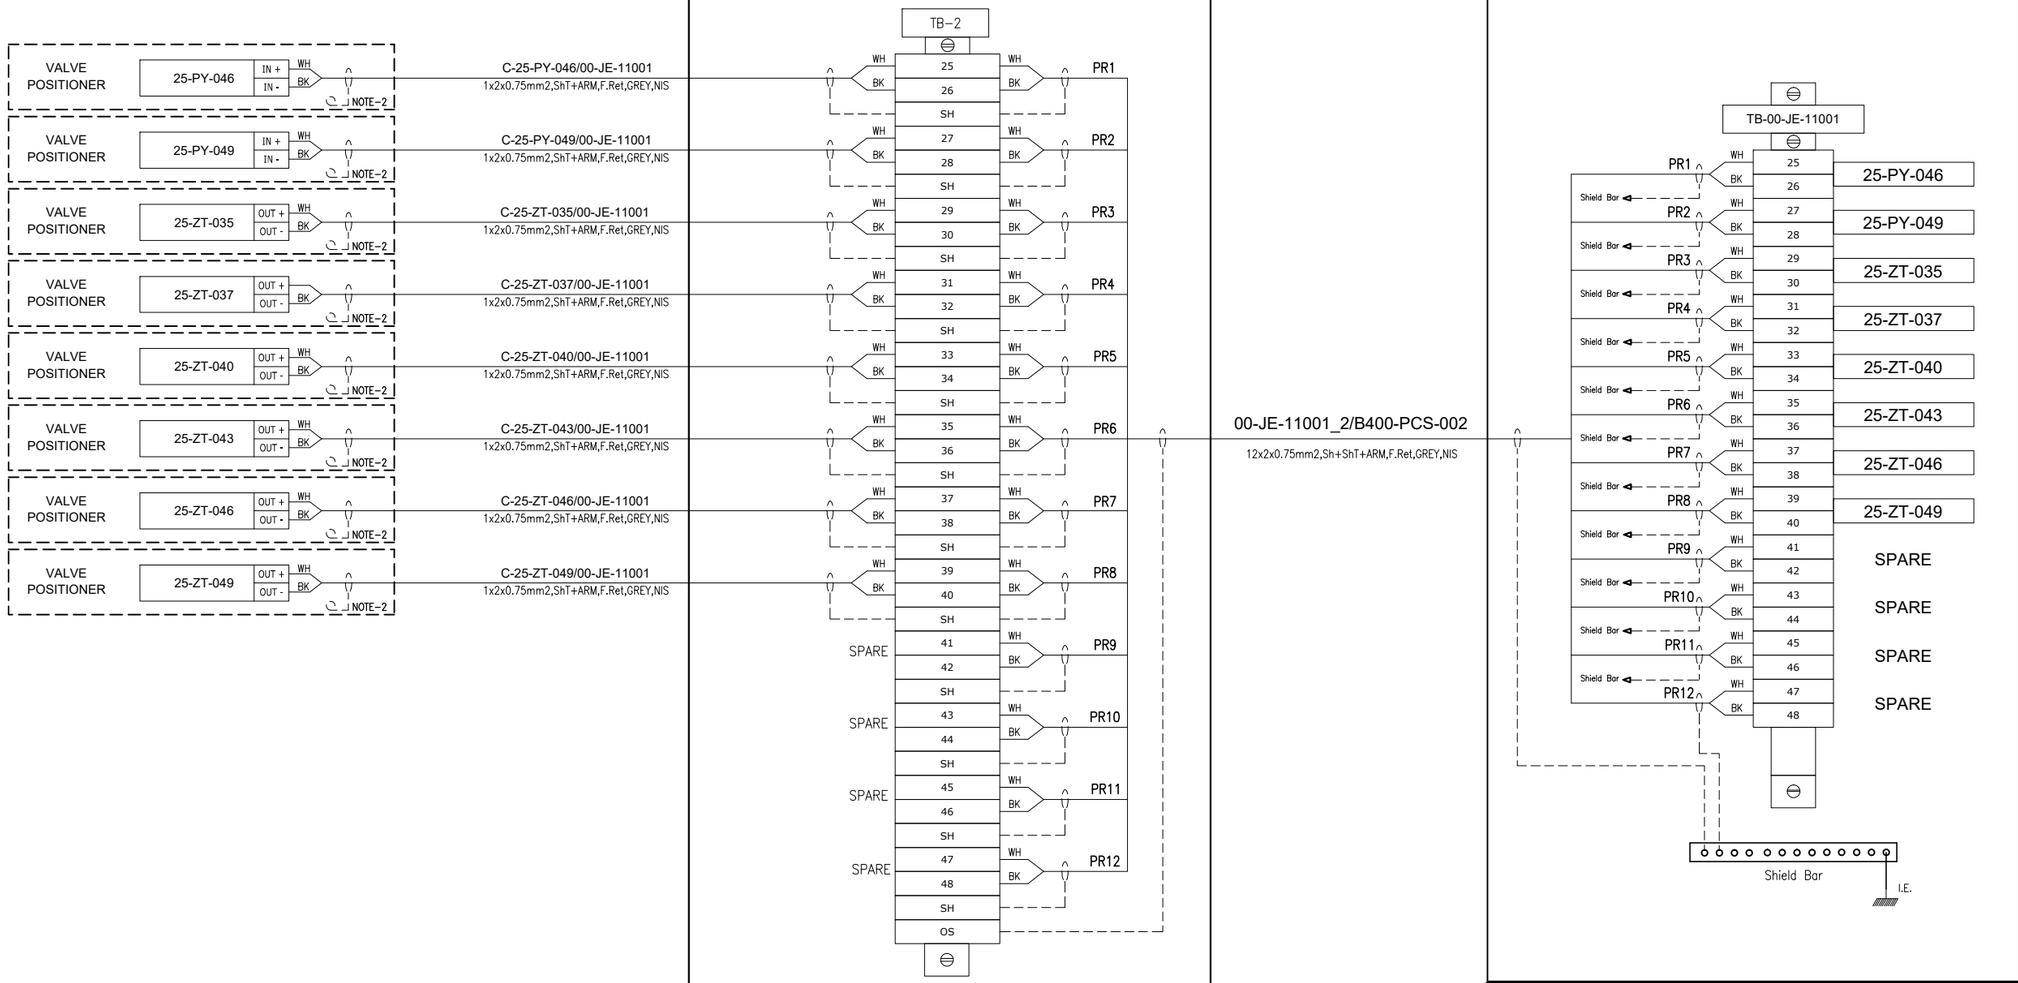

CROSSWIND

ROSETTI MARINO

TITLE :

BASE LOAD POWER HUB (BLPH)
INSTRUMENT – PCS WIRING DIAGRAMS
00–JE–11001–SH. 2 OF 2


CONTRACT NO./TITLE			SCALE N/A
DRAWN SPS	CHECKED LCA	APPROVED CGI	DATE 29/09/2025
A3	DRAWING NO. 123–A90–DDL–IN–40015	SHEET 005	REV. 02

File Name : 123A90-DDL-IN-DG-40015_Rev.02

DRAWING NO. 123A90-DDL-IN-DG-40015


REV. 02

FIELD		MULTICABLE	I&T EQUIPMENT ROOM (ITER)
INSTRUMENTS	JUNCTION BOX 00-JE-11002	No.	MARSHALLING CABINET B400-PCS-002

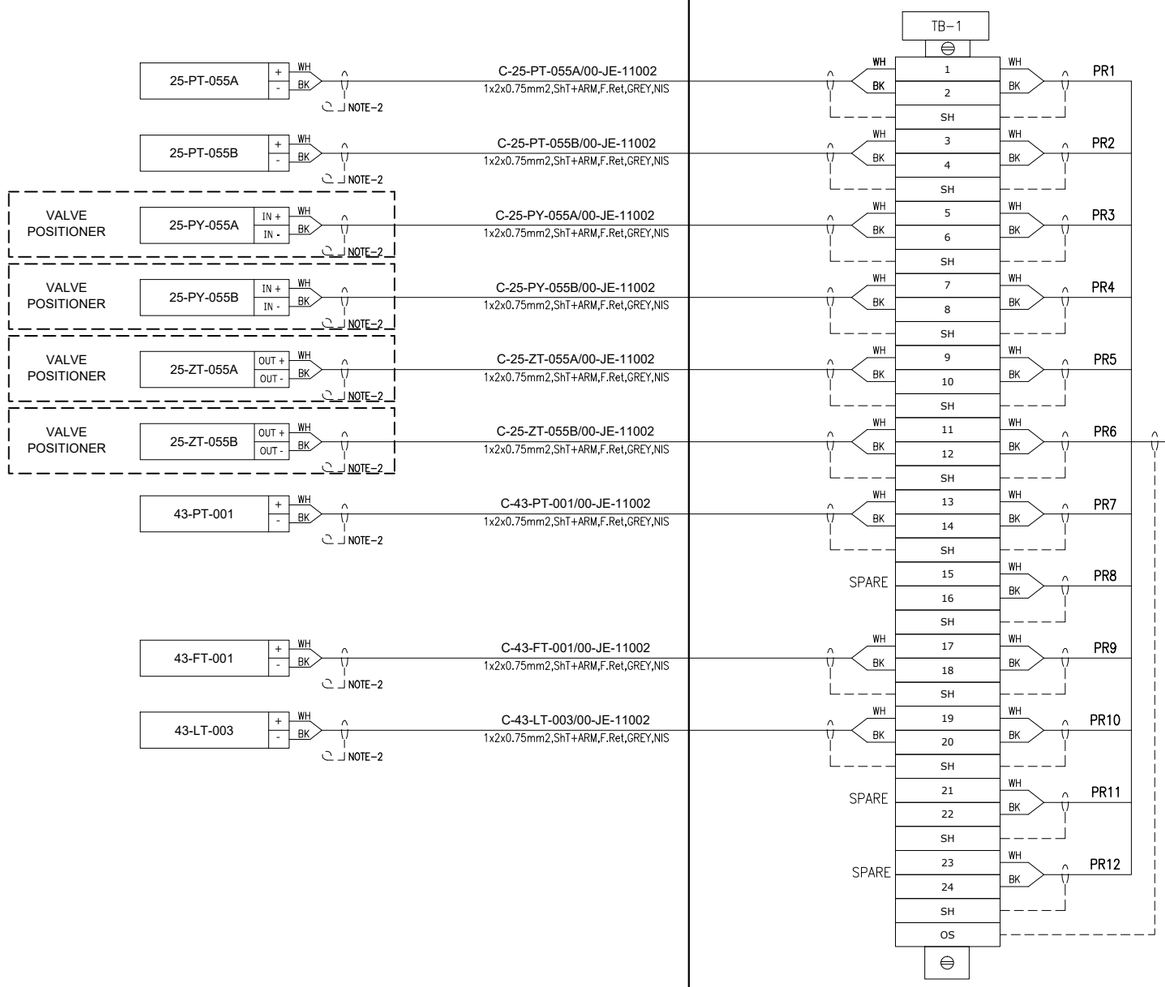

00-JE-11002/B400-PCS-002

12x2x0.75mm2,Sh+ShT+ARM,F.Ret,GREY,NIS

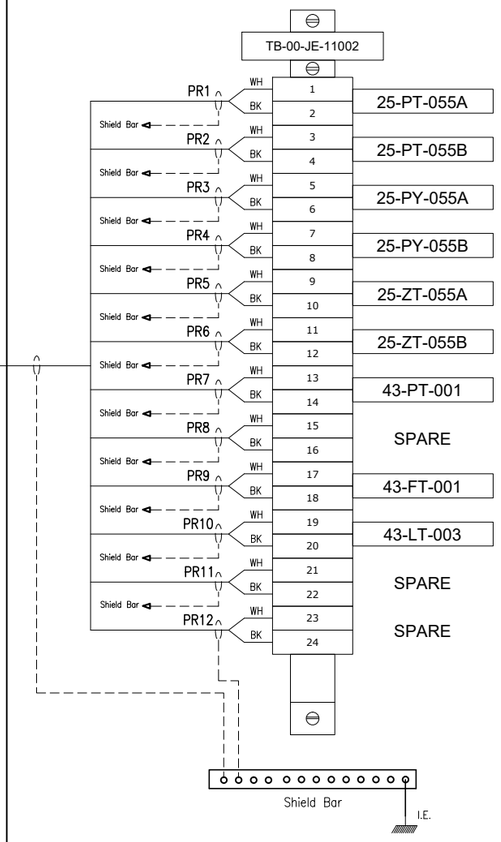

CROSSWIND

ROSETTI MARINO

TITLE :

BASE LOAD POWER HUB (BLPH)
INSTRUMENT – PCS WIRING DIAGRAMS
00–JE–11002–SH.1 OF 2

CONTRACT NO./TITLE			SCALE N/A
DRAWN SPS	CHECKED LCA	APPROVED CGI	DATE 29/09/2025
A3	DRAWING NO. 123–A90–DDL–40015	SHEET 006	REV. 02

File Name : 123A90-DDL-IN-DG-40015_Rev.02

DRAWING NO. 123A90-DDL-IN-DG-40015

REV. 02

FIELD

INSTRUMENTS

JUNCTION BOX

00-JE-11003


MULTICABLE

No.

I&T EQUIPMENT ROOM (ITER)

MARSHALLING CABINET

B400-PCS-002

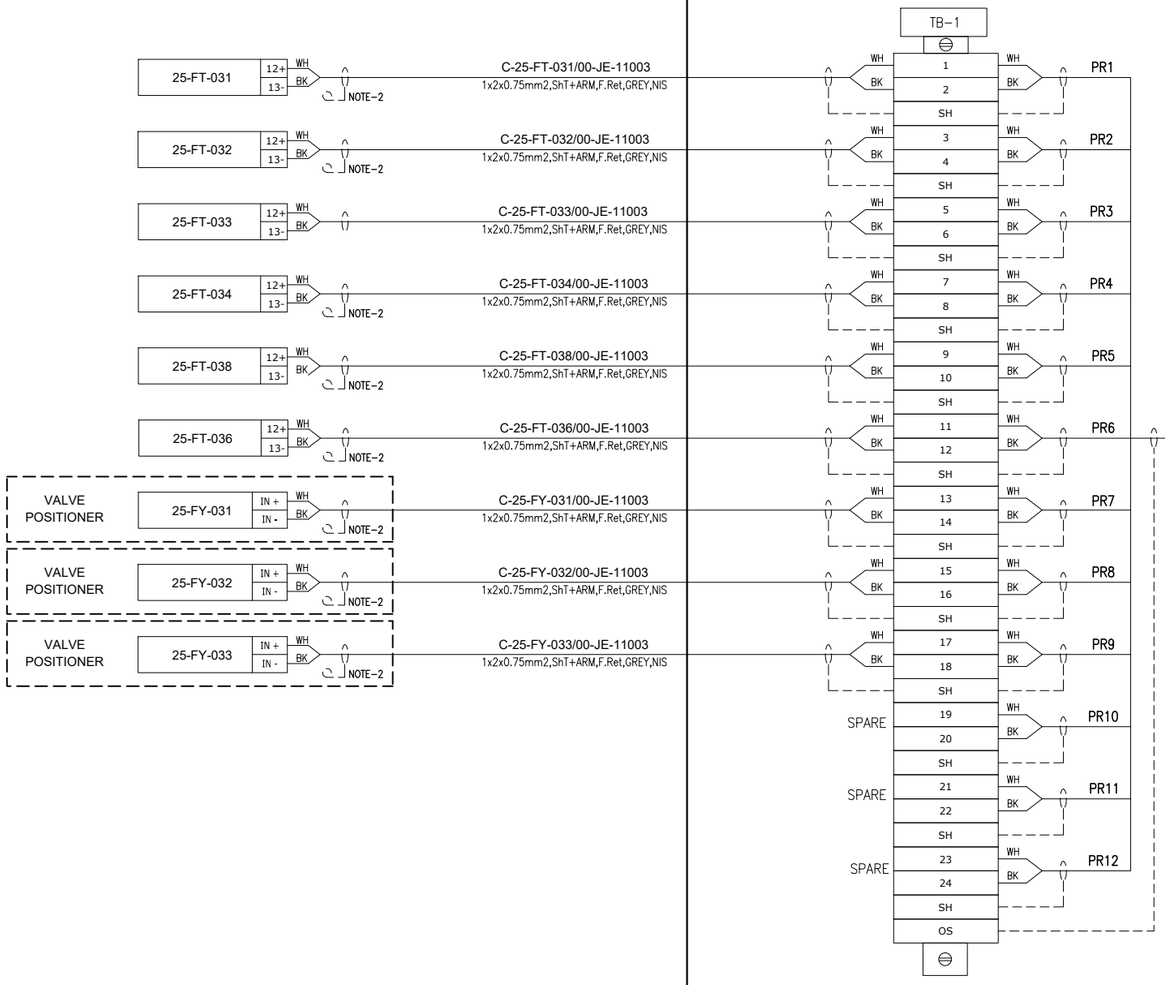

CROSSWIND

ROSETTI MARINO

TITLE :

BASE LOAD POWER HUB (BLPH)
INSTRUMENT – PCS WIRING DIAGRAMS
00-JE-11003-SH.1 OF 2

CONTRACT NO./TITLE			SCALE N/A
DRAWN SPS	CHECKED LCA	APPROVED CGI	DATE 29/09/2025


A3	DRAWING NO.	SHEET	REV.
	123A90-DDL-IN-DG-40015	007	02

File Name : 123A90-DDL-IN-DG-40015_Rev.02

DRAWING NO. 123A90-DDL-IN-DG-40015


REV. 02

FIELD		MULTICABLE	I&T EQUIPMENT ROOM (ITER)
INSTRUMENTS	JUNCTION BOX 00-JE-11003	No.	MARSHALLING CABINET B400-PCS-002

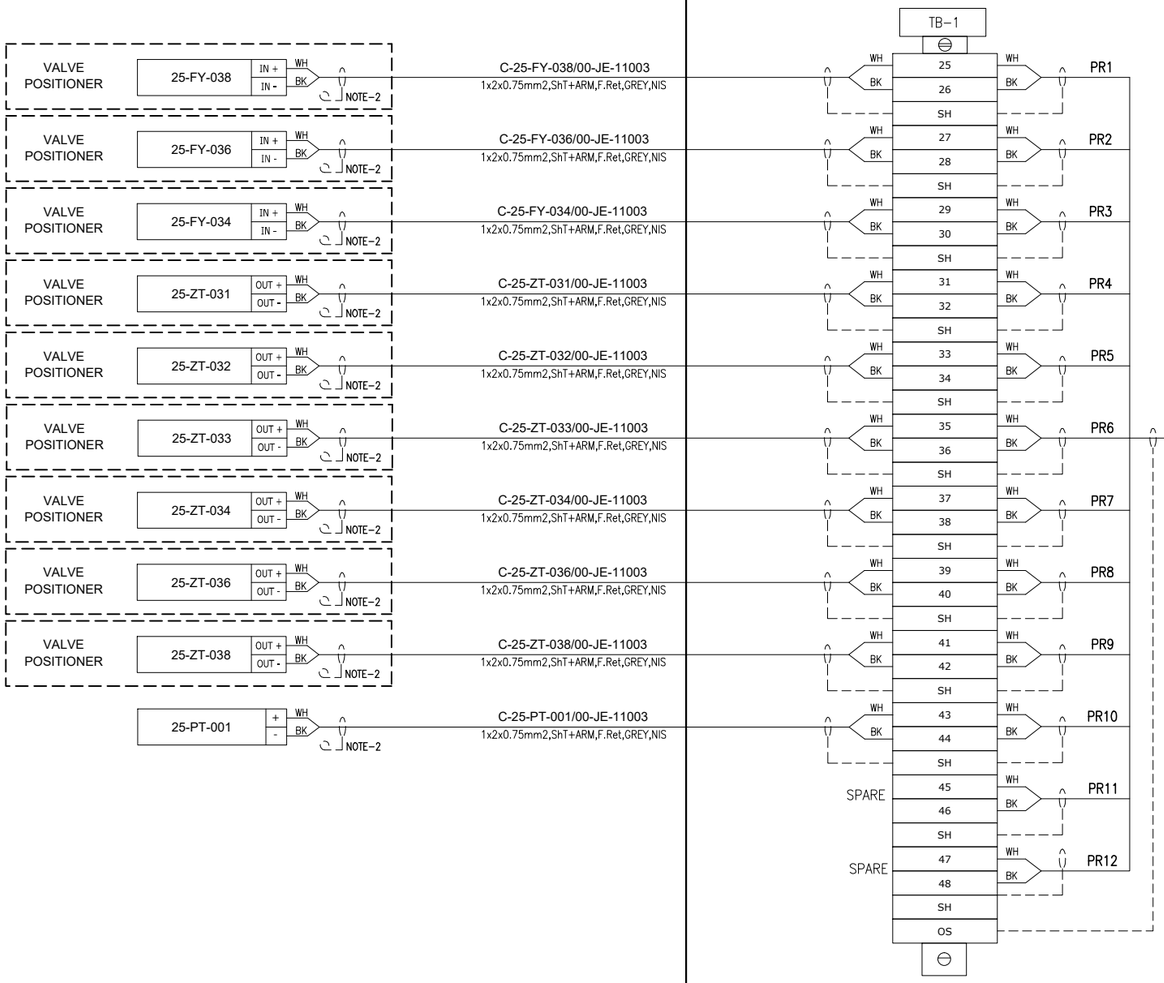

00-JE-11003_2/B400-PCS-002

12x2x0.75mm2,Sh+ShT+ARM,F.Ret,GREY,NIS

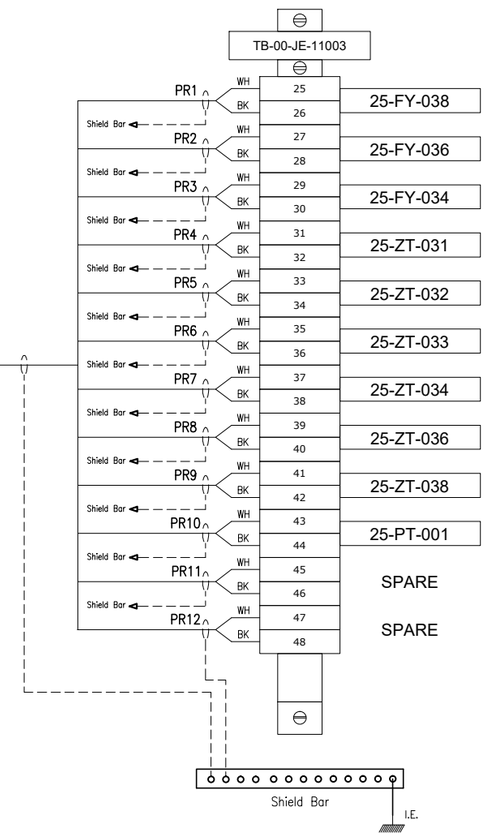

CROSSWIND

ROSETTI MARINO

TITLE :

BASE LOAD POWER HUB (BLPH)
INSTRUMENT – PCS WIRING DIAGRAMS
00–JE–11003–SH.2 OF 2


CONTRACT NO./TITLE			SCALE N/A
DRAWN SPS	CHECKED LCA	APPROVED CGI	DATE 29/09/2025
A3	DRAWING NO. 123–A90–DDL–IN–40015	SHEET 008	REV. 02

File Name : 123A90-DDL-IN-DG-40015_Rev.02

DRAWING NO. 123A90-DDL-IN-DG-40015


REV. 02

FIELD		MULTICABLE	I&T EQUIPMENT ROOM (ITER)
INSTRUMENTS	JUNCTION BOX 00-JE-11004	No.	MARSHALLING CABINET B400-PCS-002

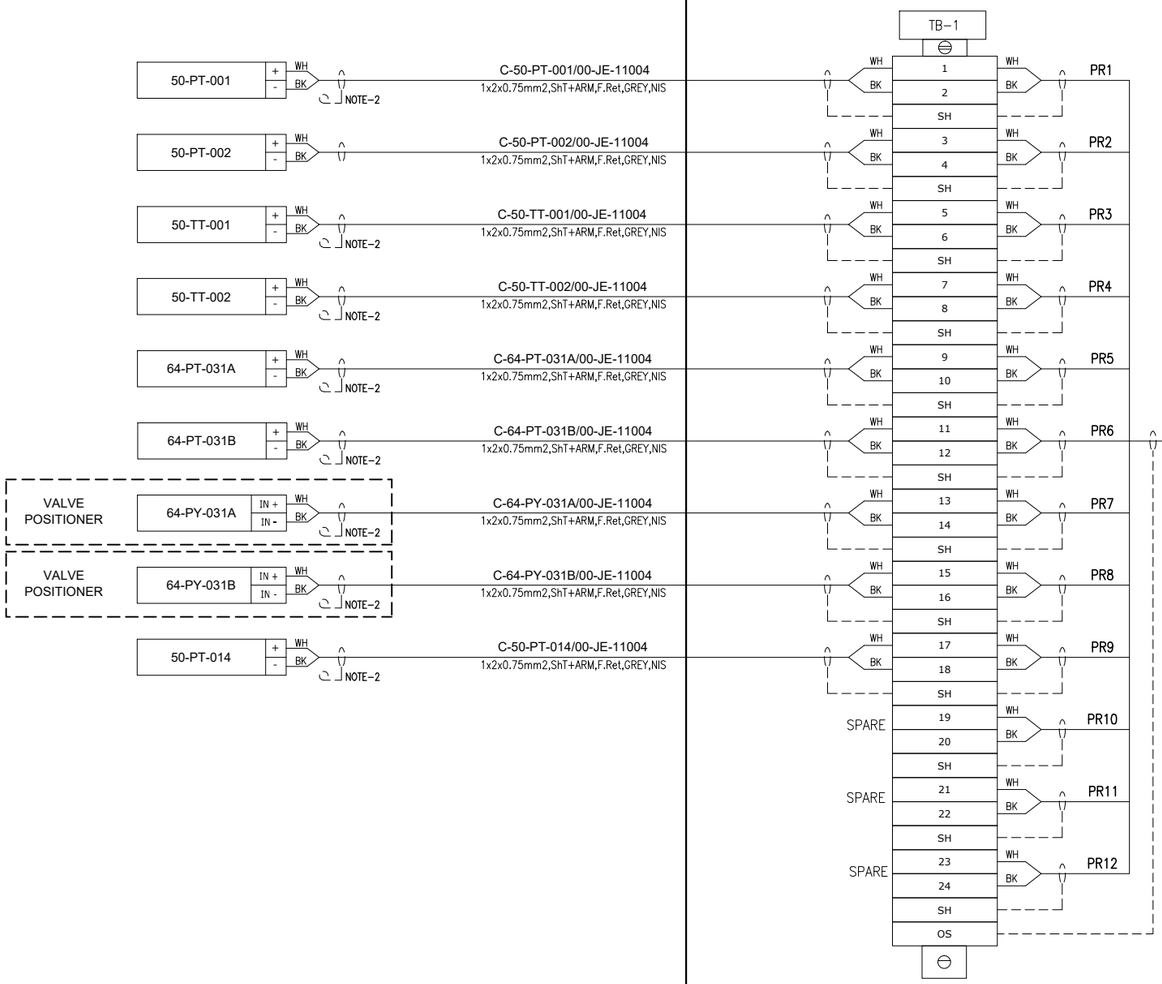

00-JE-11004/B400-PCS-002

12x2x0.75mm2,Sh+ShT+ARM,F.Ret,GREY,NIS

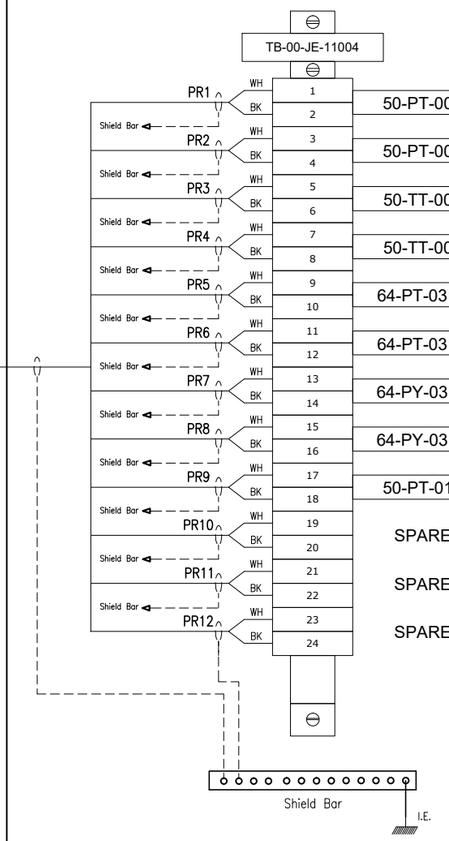

CROSSWIND

ROSETTI MARINO

TITLE :

BASE LOAD POWER HUB (BLPH)
INSTRUMENT – PCS WIRING DIAGRAMS
00–JE–11004–SH.1 OF 2


CONTRACT NO./TITLE			SCALE N/A
DRAWN SPS	CHECKED LCA	APPROVED CGI	DATE 29/09/2025
A3	DRAWING NO. 123A90–DDL–IN–DG–40015	SHEET 009	REV. 02

File Name : 123A90-DDL-IN-DG-40015_Rev.02

DRAWING NO. 123A90-DDL-IN-DG-40015

REV. 02

FIELD		MULTICABLE	I&T EQUIPMENT ROOM (ITER)
INSTRUMENTS	JUNCTION BOX 00-JE-11005	No.	MARSHALLING CABINET B400-PCS-002

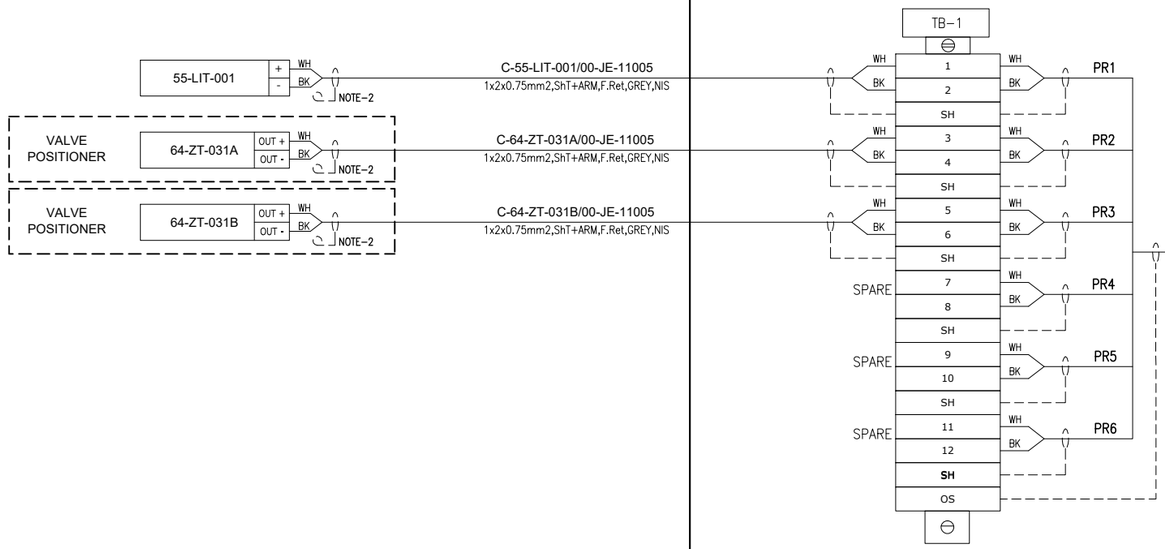

CROSSWIND

ROSETTI MARINO

TITLE :

BASE LOAD POWER HUB (BLPH)
INSTRUMENT – PCS WIRING DIAGRAMS
00–JE–11005

CONTRACT NO./TITLE			SCALE N/A
DRAWN SPS	CHECKED LCA	APPROVED CGI	DATE 29/09/2025


A3	DRAWING NO. 123A90–DDL–IN–DG–40015	SHEET 010	REV. 02

File Name : 123A90-DDL-IN-DG-40015_Rev.02

DRAWING NO. 123A90-DDL-IN-DG-40015

REV. 02

FIELD		I&T EQUIPMENT ROOM (ITER)
INSTRUMENTS	CABLE NO	MARSHALLING CABINET B400-PCS-002

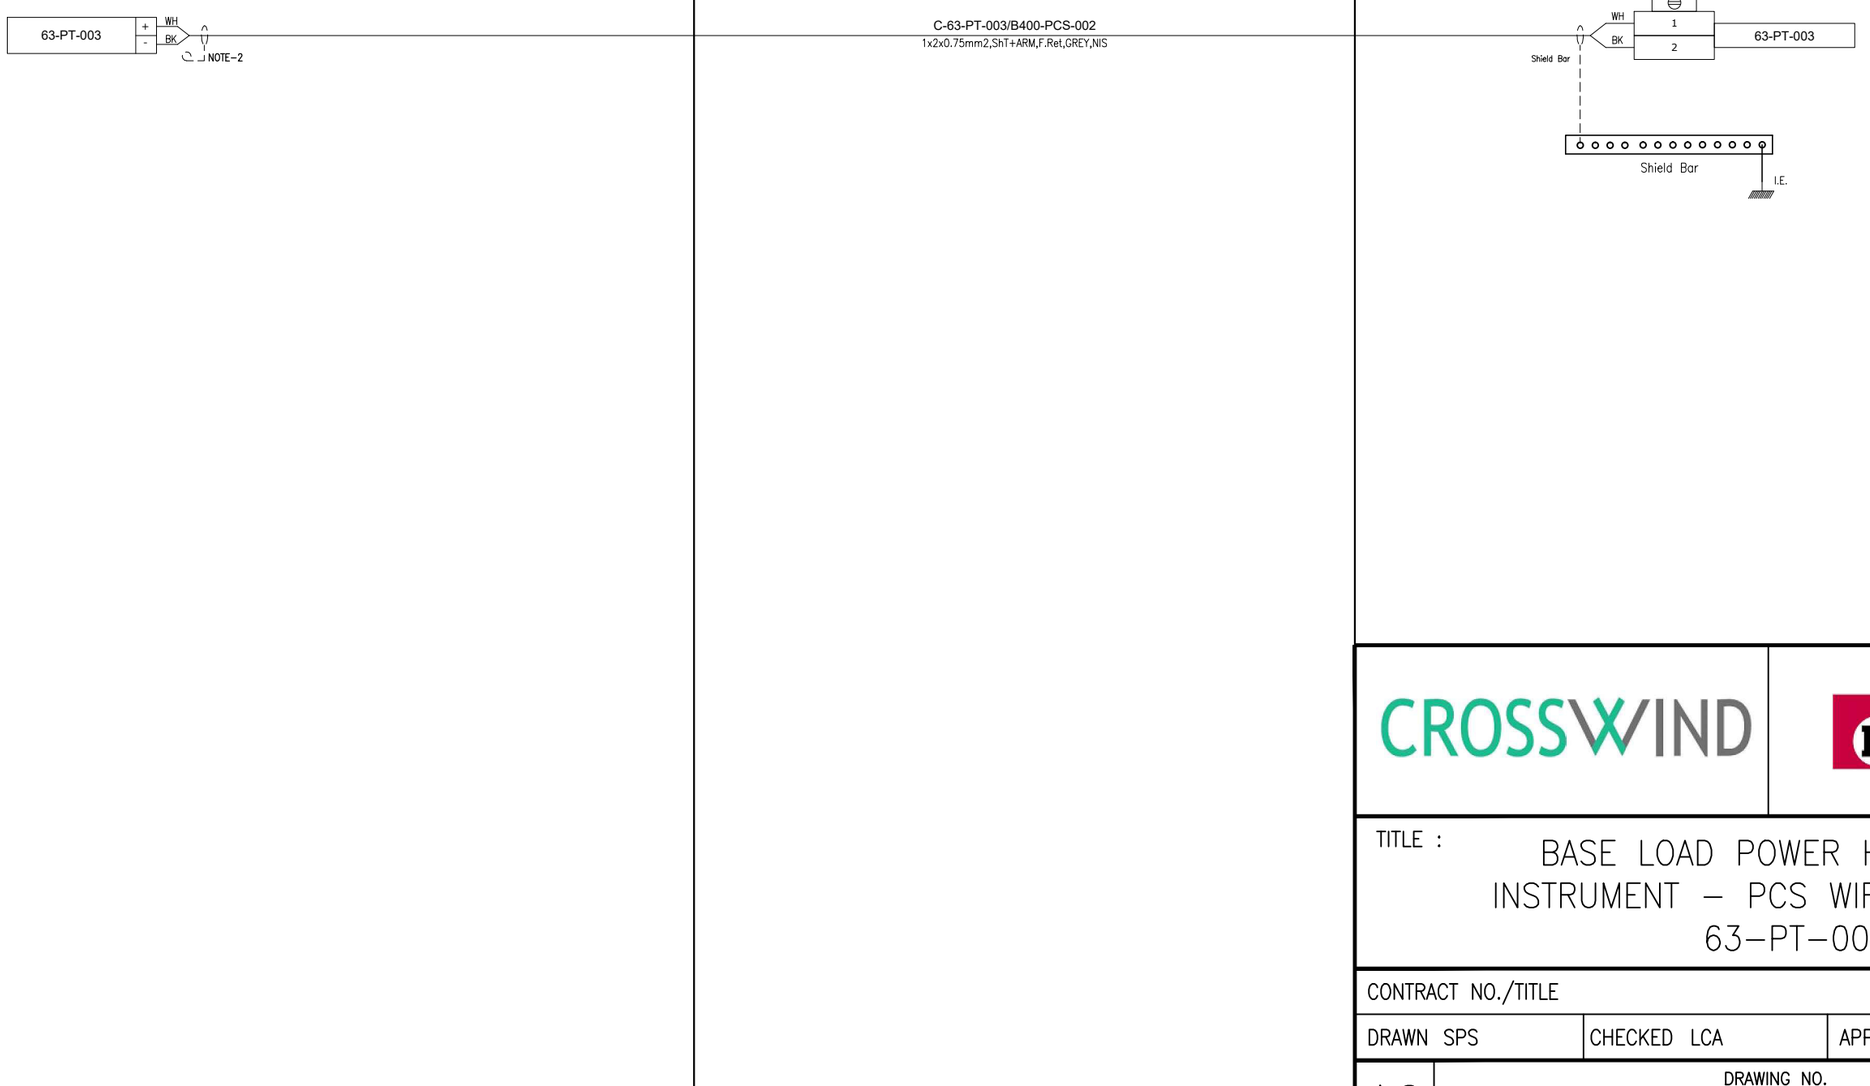

CROSSWIND

ROSETTI MARINO

TITLE :

BASE LOAD POWER HUB (BLPH)
INSTRUMENT – PCS WIRING DIAGRAMS
63–PT–003

CONTRACT NO./TITLE			SCALE N/A
DRAWN SPS	CHECKED LCA	APPROVED CGI	DATE 29/09/2025

A3	DRAWING NO. 123A90–DDL–IN–DG–40015	SHEET 011	REV. 02

File Name : 123A90-DDL-IN-DG-40015_Rev.02

DRAWING NO. 123A90-DDL-IN-DG-40015

REV. 02

SPARE SHEET

CROSSWIND

ROSETTI MARINO

TITLE : BASE LOAD POWER HUB (BLPH)
INSTRUMENT – PCS WIRING DIAGRAMS
SPARE SHEET

CONTRACT NO./TITLE			SCALE N/A
DRAWN SPS	CHECKED LCA	APPROVED CGI	DATE 29/09/2025

	DRAWING NO.	SHEET	REV.
A3	123A90-DDL-IN-DG-40015	012	02

File Name : 123A90-DDL-IN-DG-40015_Rev.02

DRAWING NO. 123A90-DDL-IN-DG-40015

REV. 02

SPARE SHEET

CROSSWIND

ROSETTI MARINO

TITLE : BASE LOAD POWER HUB (BLPH)
INSTRUMENT – PCS WIRING DIAGRAMS
SPARE SHEET

CONTRACT NO./TITLE			SCALE N/A
DRAWN SPS	CHECKED LCA	APPROVED CGI	DATE 29/09/2025

A3	DRAWING NO. 123A90–DDL–IN–DG–40015	SHEET 013	REV. 02

File Name : 123A90-DDL-IN-DG-40015_Rev.02

DRAWING NO. 123A90-DDL-IN-DG-40015

REV. 02

SPARE SHEET

CROSSWIND

ROSETTI MARINO

TITLE : BASE LOAD POWER HUB (BLPH)
INSTRUMENT – PCS WIRING DIAGRAMS
SPARE SHEET

CONTRACT NO./TITLE			SCALE N/A
DRAWN SPS	CHECKED LCA	APPROVED CGI	DATE 29/09/2025


A3	DRAWING NO. 123A90-DDL-IN-DG-40015	SHEET 014	REV. 02

File Name : 123A90-DDL-IN-DG-40015_Rev.02

DRAWING NO. 123A90-DDL-IN-DG-40015

REV. 02

FIELD		MULTICABLE	I&T EQUIPMENT ROOM (ITER)
INSTRUMENTS	JUNCTION BOX 00-JE-12001	No.	MARSHALLING CABINET B400-PCS-002

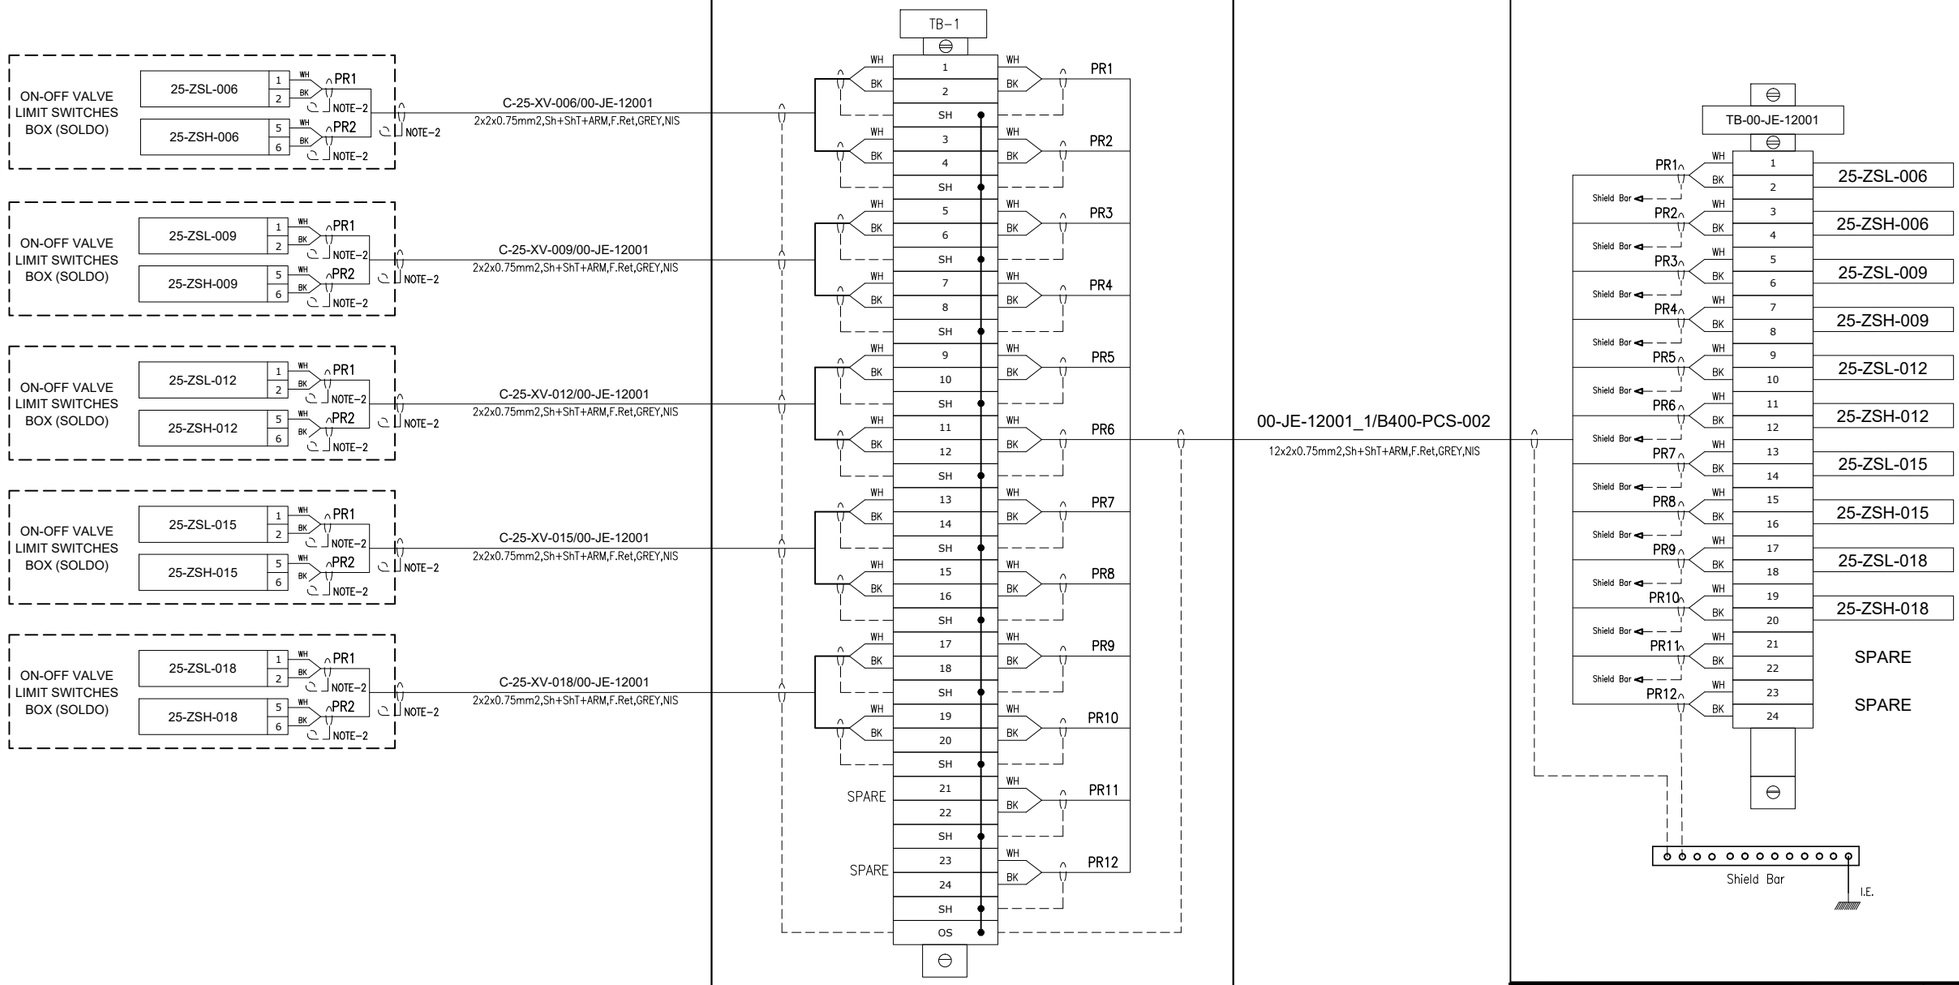

CROSSWIND

ROSETTI MARINO

TITLE :

BASE LOAD POWER HUB (BLPH)
INSTRUMENT – PCS WIRING DIAGRAMS
00-JE-12001-SH.1 OF 2


CONTRACT NO./TITLE			SCALE N/A
DRAWN SPS	CHECKED LCA	APPROVED CGI	DATE 29/09/2025
A3	DRAWING NO. 123A90-DDL-IN-DG-40015	SHEET 015	REV. 02

File Name : 123A90-DDL-IN-DG-40015_Rev.02

DRAWING NO. 123A90-DDL-IN-DG-40015

REV. 02

FIELD		MULTICABLE	I&T EQUIPMENT ROOM (ITER)
INSTRUMENTS	JUNCTION BOX 00-JE-12001	No.	MARSHALLING CABINET B400-PCS-002

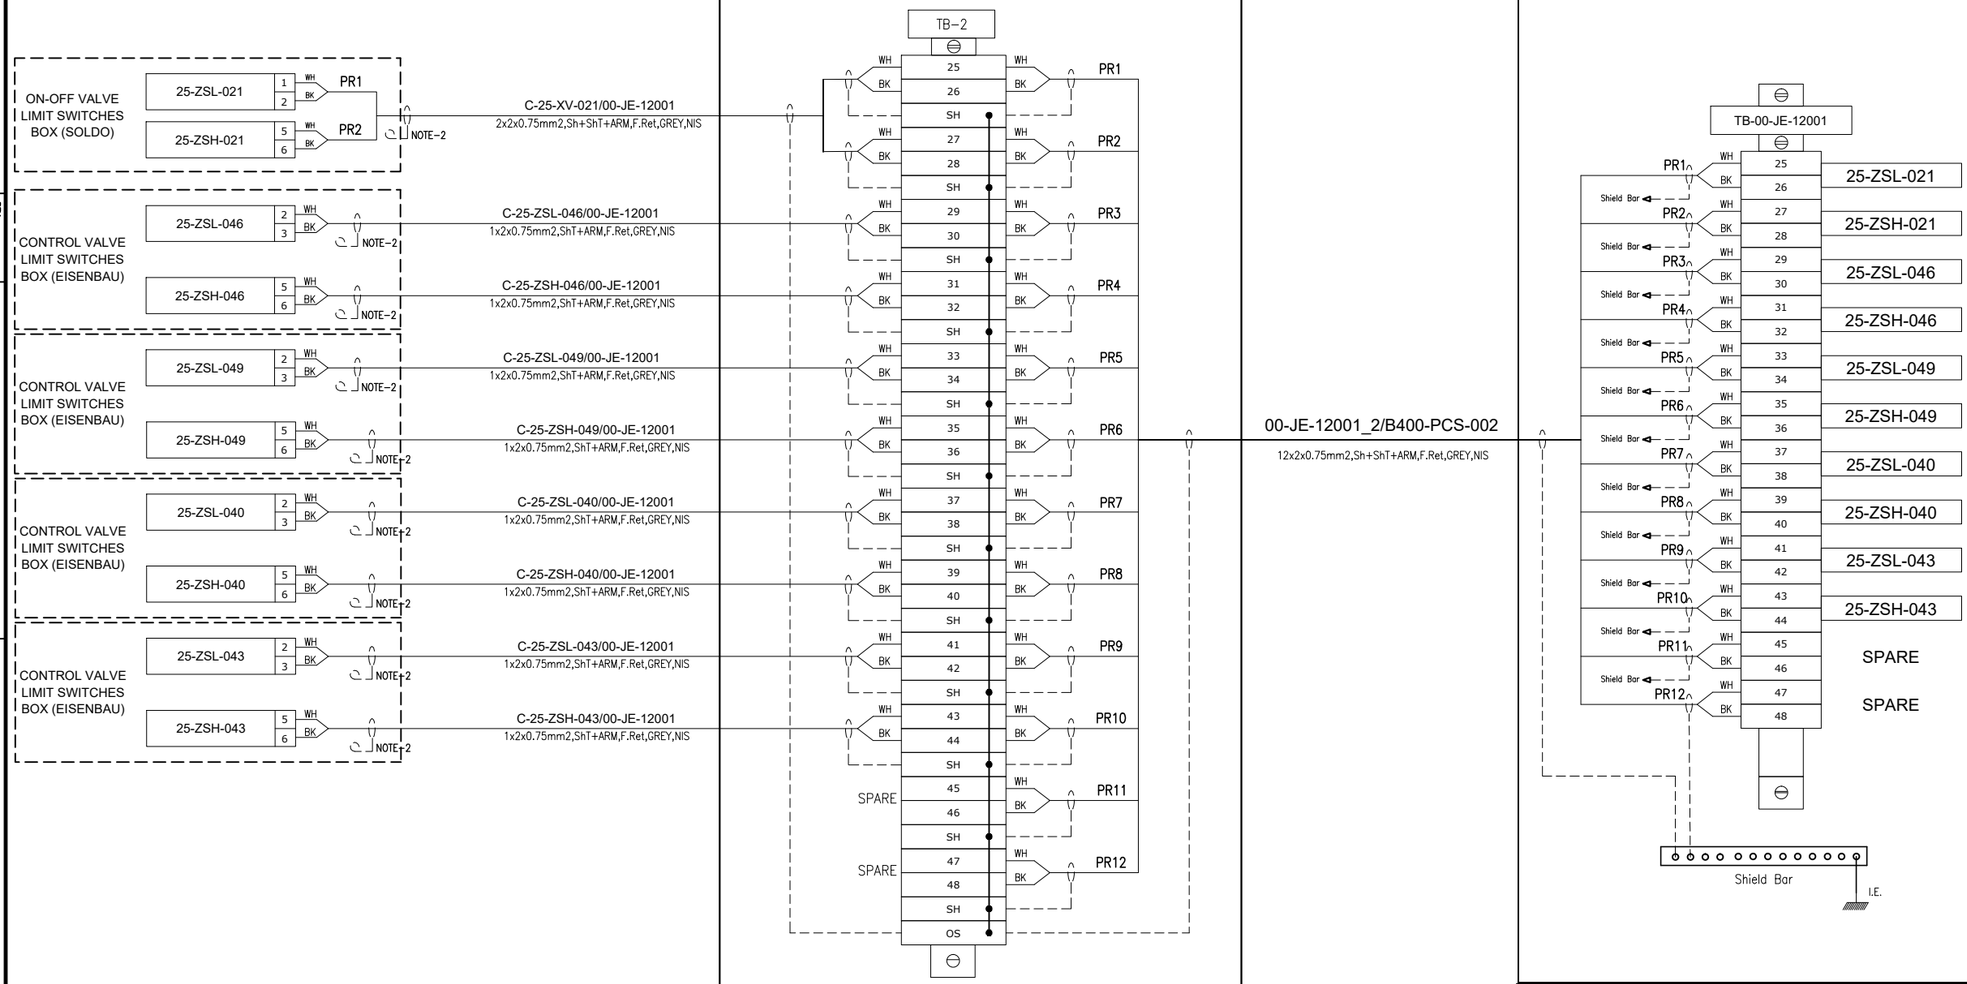

CROSSWIND

ROSETTI MARINO

TITLE :


BASE LOAD POWER HUB (BLPH)
INSTRUMENT – PCS WIRING DIAGRAMS
00-JE-12001-SH.2 OF 2

CONTRACT NO./TITLE			SCALE N/A
DRAWN SPS	CHECKED LCA	APPROVED CGI	DATE 29/09/2025
A3	DRAWING NO. 123A90-DDL-IN-DG-40015	SHEET 016	REV. 02

File Name : 123A90-DDL-IN-DG-40015_Rev.02

DRAWING NO. 123A90-DDL-IN-DG-40015 REV. 02

FIELD		MULTICABLE	I&T EQUIPMENT ROOM (ITER)
INSTRUMENTS	JUNCTION BOX 00-JE-12002	No.	MARSHALLING CABINET B400-PCS-002

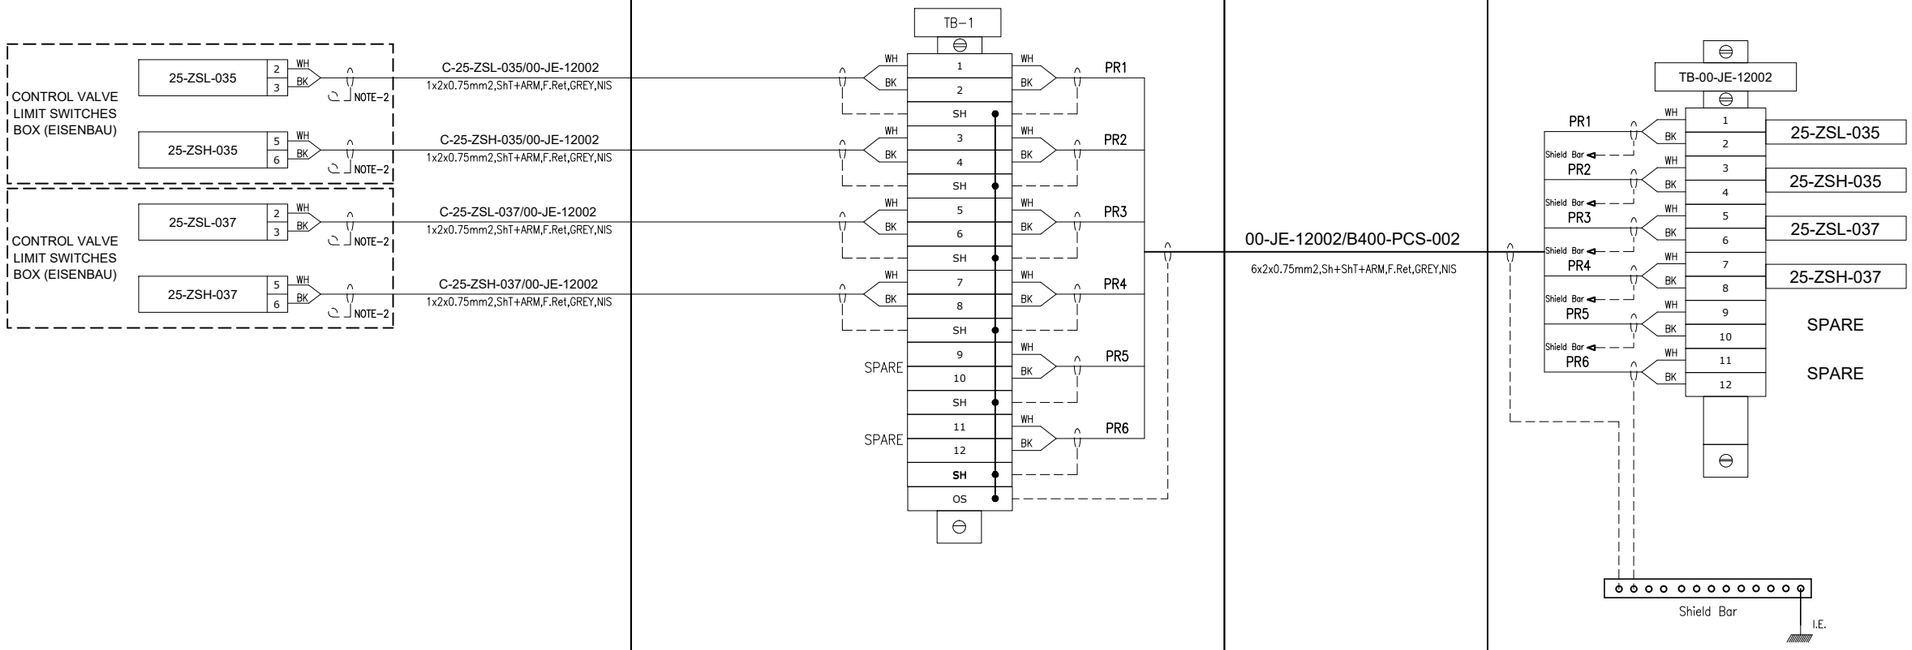

CROSSWIND

ROSETTI MARINO

TITLE :

BASE LOAD POWER HUB (BLPH)
INSTRUMENT – PCS WIRING DIAGRAMS
00-JE-12002


CONTRACT NO./TITLE			SCALE N/A
DRAWN SPS	CHECKED LCA	APPROVED CGI	DATE 29/09/2025
A3	DRAWING NO. 123A90-DDL-IN-DG-40015	SHEET 017	REV. 02

File Name : 123A90-DDL-IN-DG-40015_Rev.02

DRAWING NO. 123A90-DDL-IN-DG-40015

REV. 02

FIELD		MULTICABLE	I&T EQUIPMENT ROOM (ITER)
INSTRUMENTS	JUNCTION BOX 00-JE-12003	No.	MARSHALLING CABINET B400-PCS-002

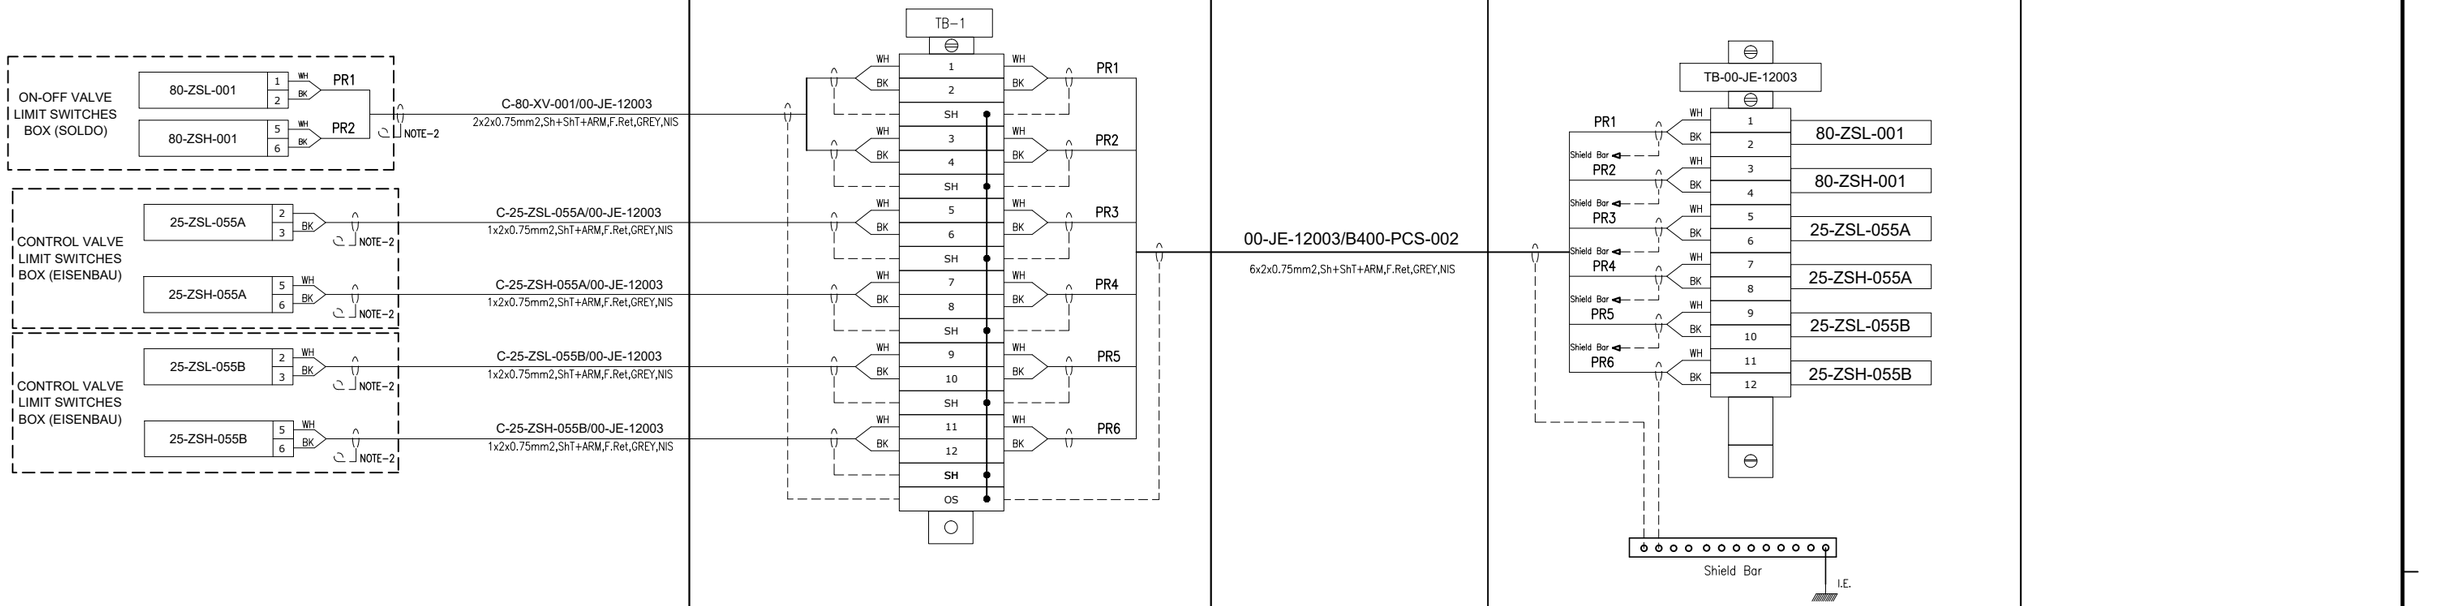

CROSSWIND

ROSETTI MARINO

TITLE : BASE LOAD POWER HUB (BLPH)
INSTRUMENT – PCS WIRING DIAGRAMS
00–JE–12003

CONTRACT NO./TITLE			SCALE N/A
DRAWN SPS	CHECKED LCA	APPROVED CGI	DATE 29/09/2025


A3	DRAWING NO. 123A90–DDL–IN–DG–40015	SHEET 018	REV. 02

File Name : 123A90-DDL-IN-DG-40015_Rev.02

DRAWING NO. 123A90-DDL-IN-DG-40015

REV. 02

FIELD		MULTICABLE	I&T EQUIPMENT ROOM (ITER)
INSTRUMENTS	JUNCTION BOX 00-JE-12004	No.	MARSHALLING CABINET B400-PCS-002

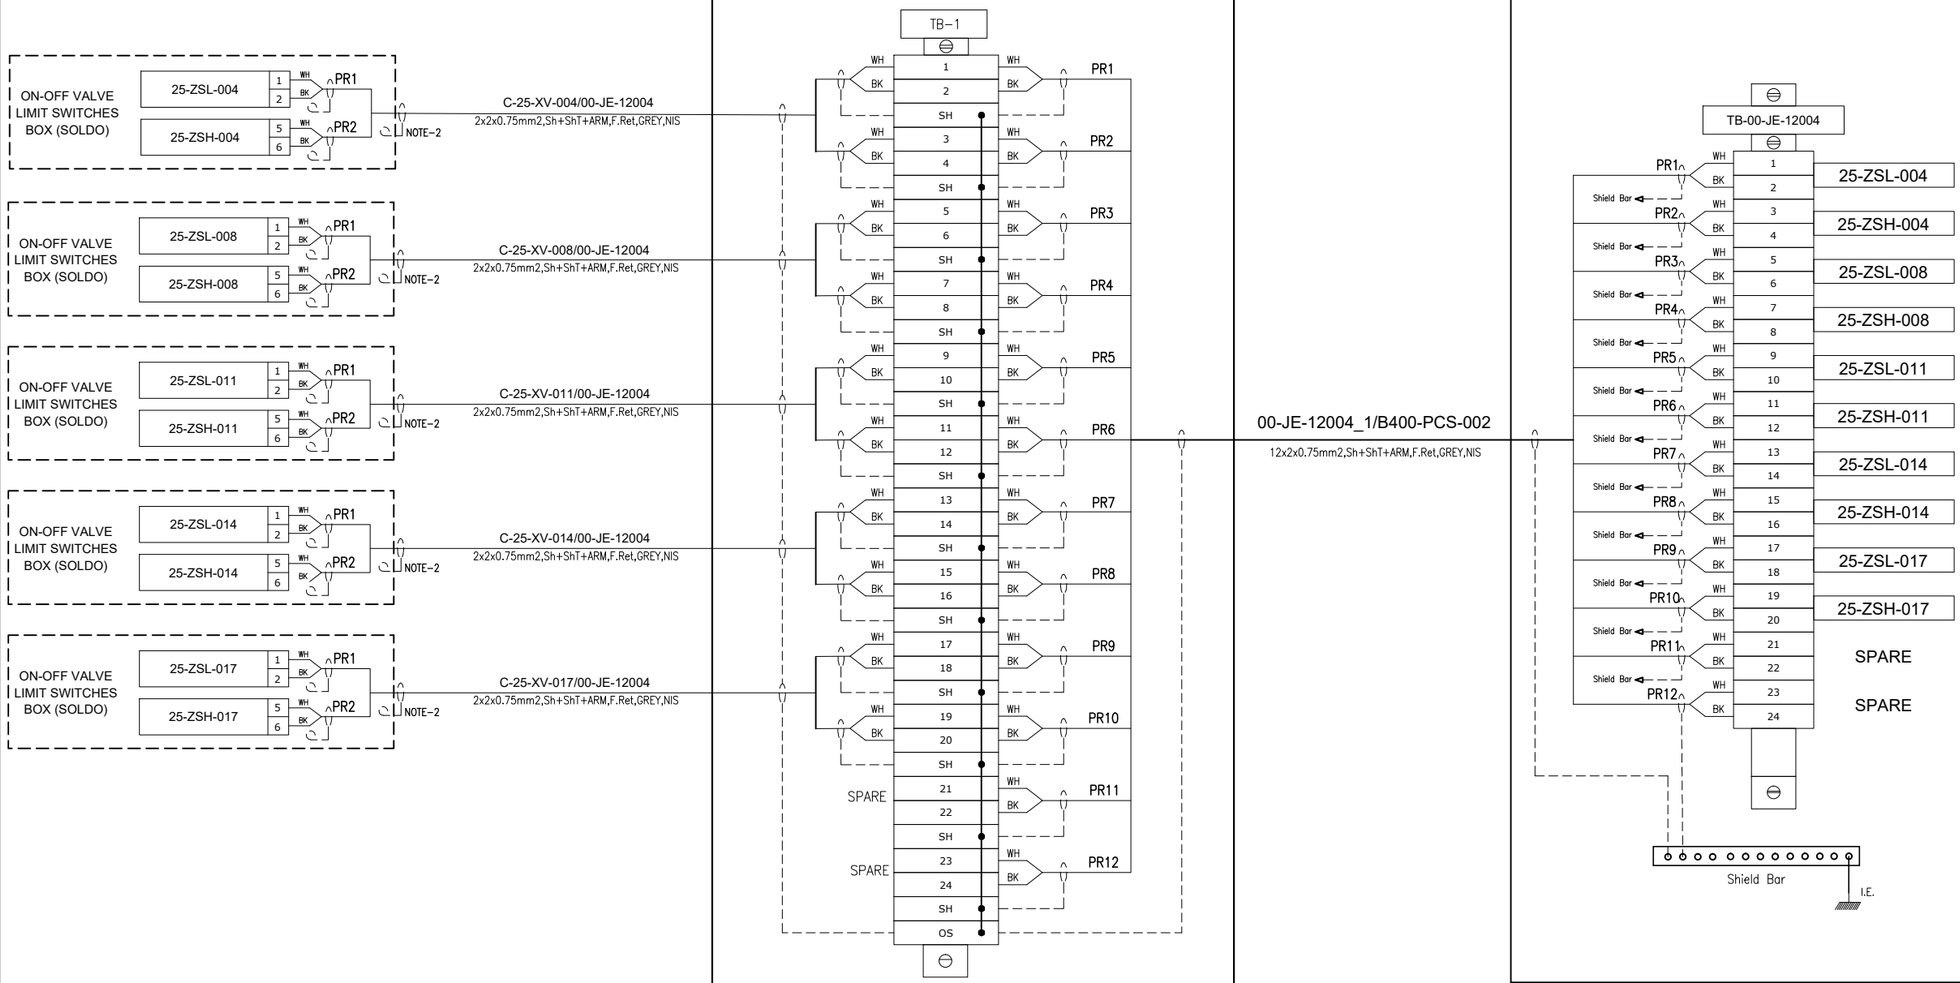

CROSSWIND

ROSETTI MARINO

TITLE :

BASE LOAD POWER HUB (BLPH)
INSTRUMENT – PCS WIRING DIAGRAMS
00–JE–12004–SH.1 OF 2

CONTRACT NO./TITLE			SCALE N/A
DRAWN SPS	CHECKED LCA	APPROVED CGI	DATE 29/09/2025

A3	DRAWING NO. 123A90–DDL–IN–DG–40015	SHEET 019	REV. 02

File Name : 123A90-DDL-IN-DG-40015_Rev.02

DRAWING NO. 123A90-DDL-IN-DG-40015

REV. 02

FIELD

INSTRUMENTS

JUNCTION BOX

00-JE-12004


MULTICABLE

No.

I&T EQUIPMENT ROOM (ITER)


MARSHALLING CABINET

B400-PCS-002

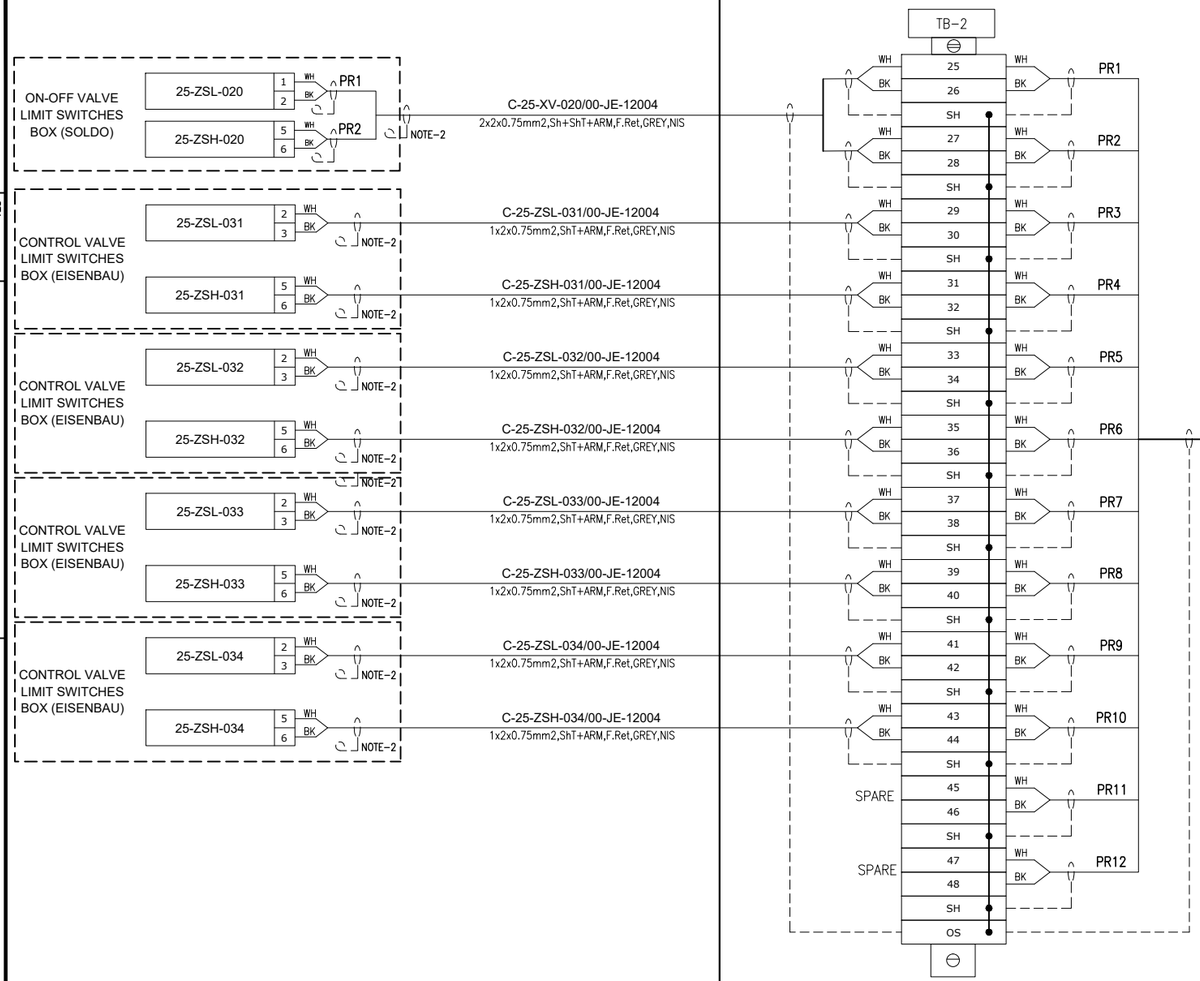

00-JE-12004_2/B400-PCS-002

12x2x0.75mm2,Sh+ShT+ARM,F.Ret,GREY,NIS

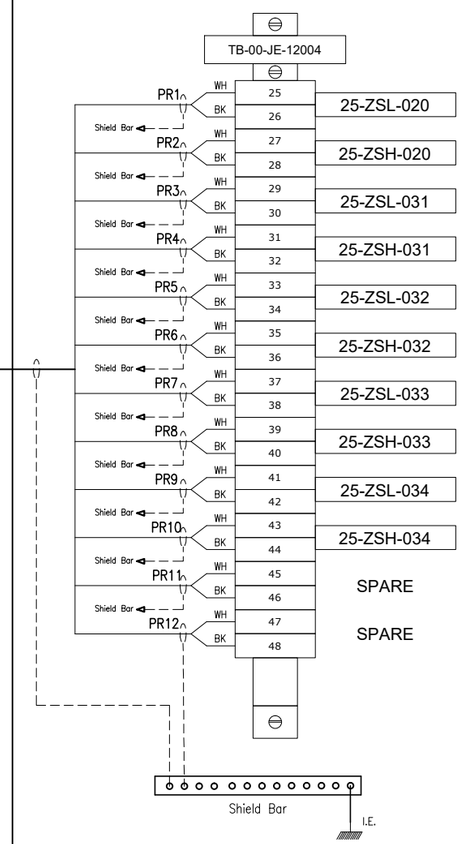

CROSSWIND

ROSETTI MARINO

TITLE :

BASE LOAD POWER HUB (BLPH)
INSTRUMENT – PCS WIRING DIAGRAMS
00-JE-12004-SH.2 OF 2

CONTRACT NO./TITLE			SCALE N/A
DRAWN SPS	CHECKED LCA	APPROVED CGI	DATE 29/09/2025


A3	DRAWING NO. 123A90-DDL-IN-DG-40015	SHEET 020	REV. 02

File Name : 123A90-DDL-IN-DG-40015_Rev.02

DRAWING NO. 123A90-DDL-IN-DG-40015

REV. 02

FIELD		MULTICABLE	I&T EQUIPMENT ROOM (ITER)
INSTRUMENTS	JUNCTION BOX 00-JE-12005	No.	MARSHALLING CABINET B400-PCS-002

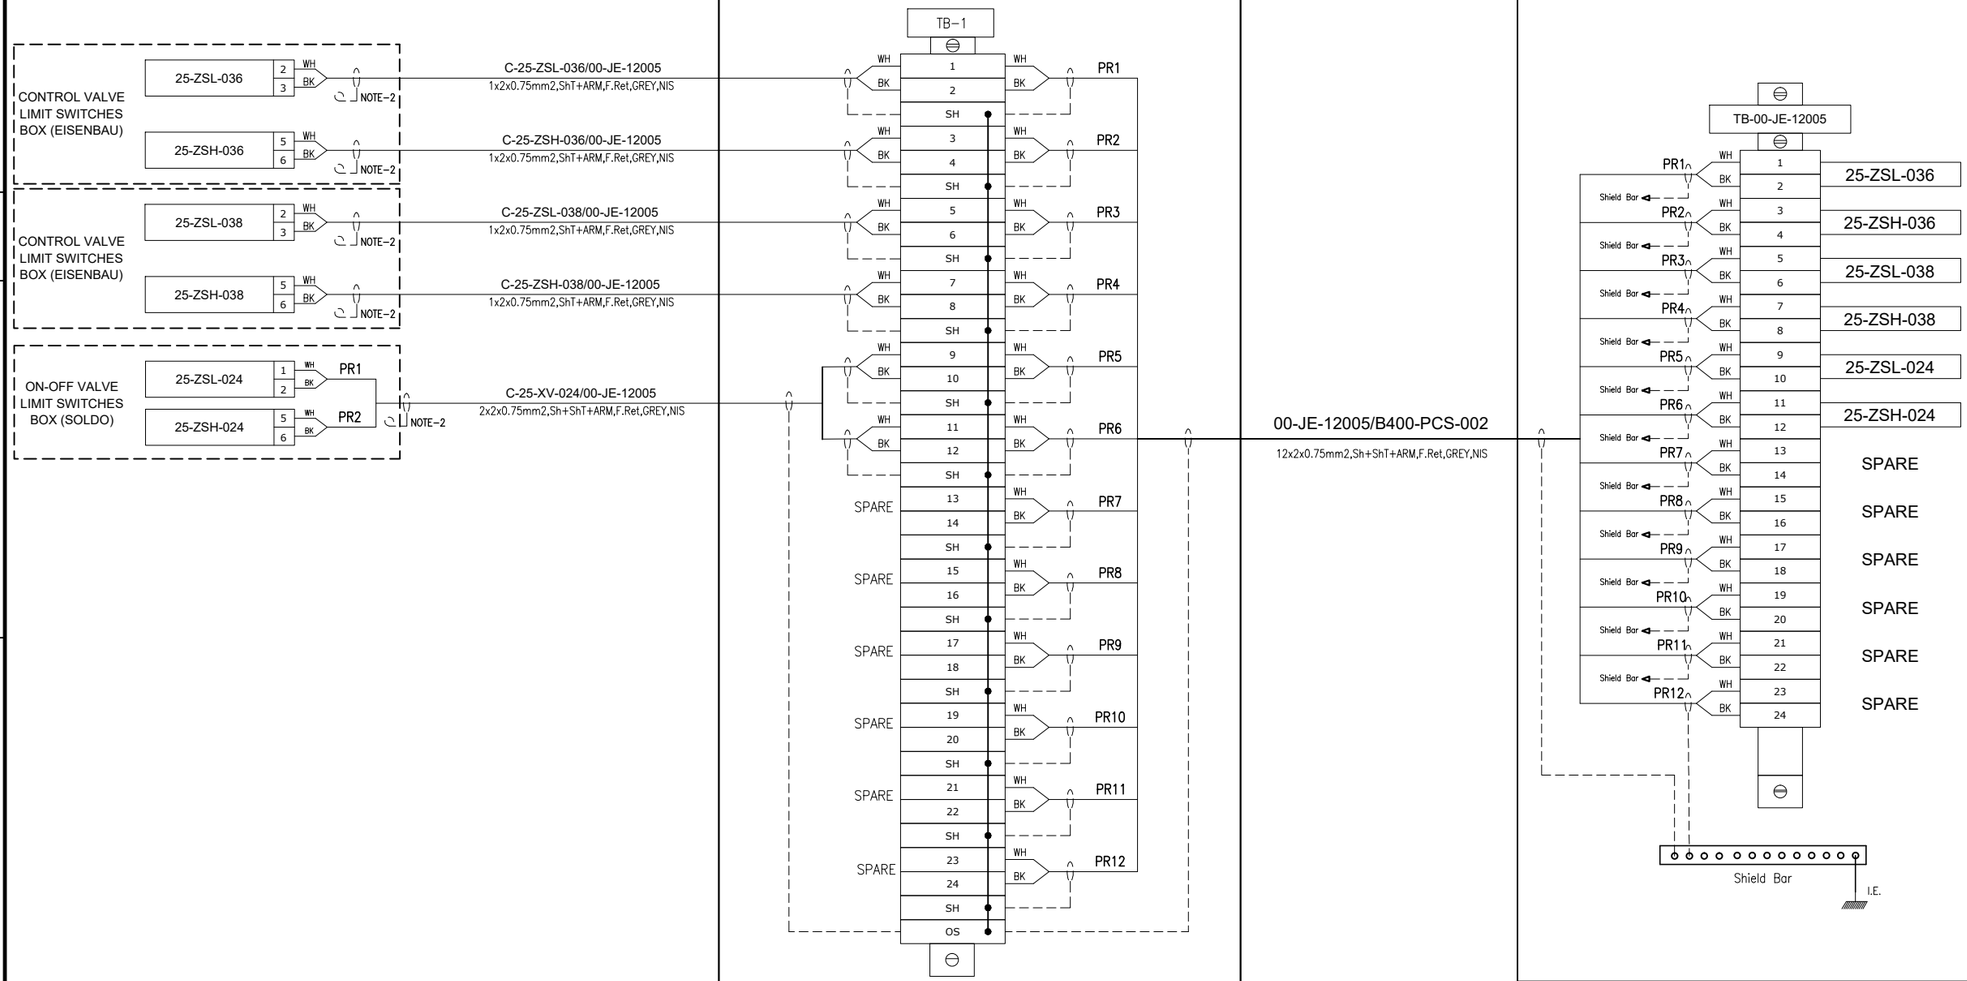

CROSSWIND

ROSETTI MARINO

TITLE :

BASE LOAD POWER HUB (BLPH)
INSTRUMENT – PCS WIRING DIAGRAMS
00–JE–12005


CONTRACT NO./TITLE			SCALE N/A
DRAWN SPS	CHECKED LCA	APPROVED CGI	DATE 29/09/2025
A3	DRAWING NO. 123A90–DDL–IN–DG–40015		SHEET 021 / REV. 02

File Name : 123A90-DDL-IN-DG-40015_Rev.02

DRAWING NO. 123A90-DDL-IN-DG-40015


REV. 02

FIELD		MULTICABLE	I&T EQUIPMENT ROOM (ITER)
INSTRUMENTS	JUNCTION BOX 00-JE-12006	No.	MARSHALLING CABINET B400-PCS-002

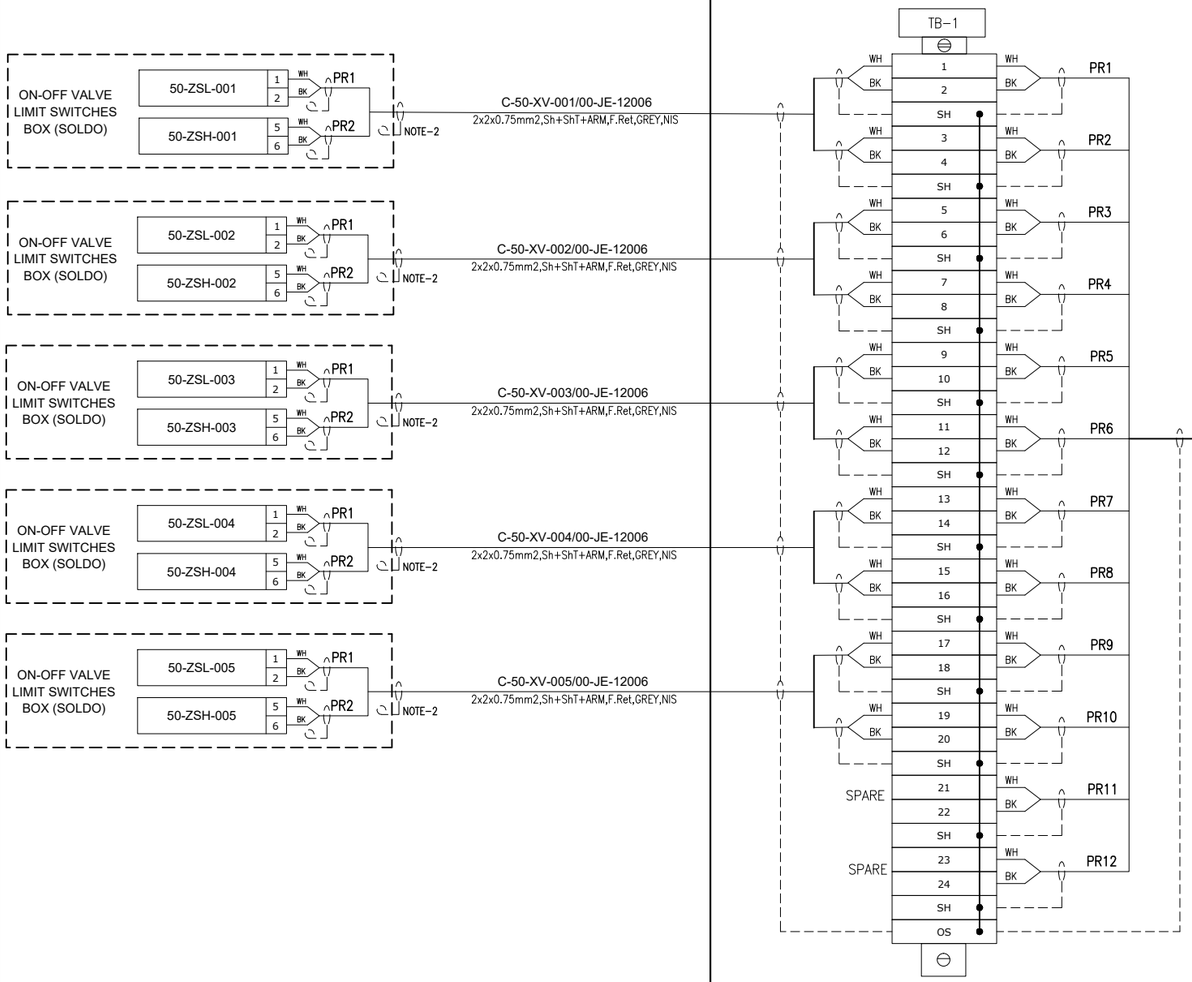

00-JE-12006_1/B400-PCS-002

12x2x0.75mm2,Sh+ShT+ARM,F.Ret,GREY,NIS

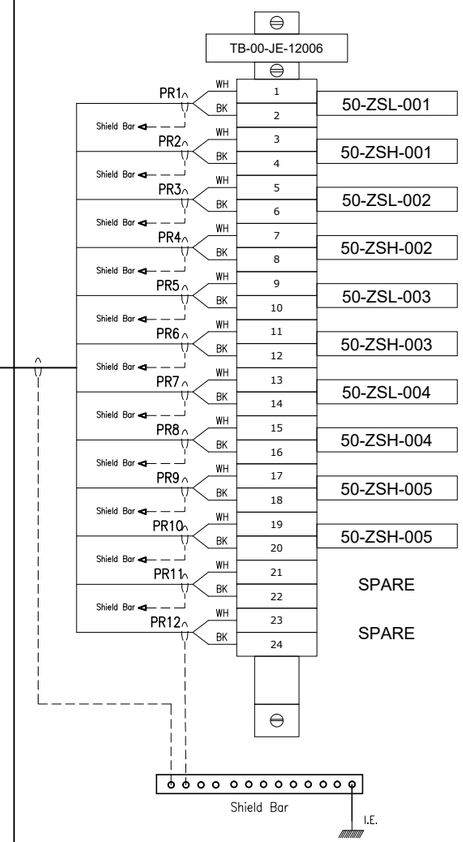

CROSSWIND

ROSETTI MARINO

TITLE :

BASE LOAD POWER HUB (BLPH)
INSTRUMENT – PCS WIRING DIAGRAMS
00-JE-12006-SH.1 OF 2

CONTRACT NO./TITLE			SCALE N/A
DRAWN SPS	CHECKED LCA	APPROVED CGI	DATE 29/09/2025


A3	DRAWING NO. 123A90-DDL-IN-DG-40015	SHEET 022	REV. 02

File Name : 123A90-DDL-IN-DG-40015_Rev.02

DRAWING NO. 123A90-DDL-IN-DG-40015

REV. 02

FIELD		MULTICABLE	I&T EQUIPMENT ROOM (ITER)
INSTRUMENTS	JUNCTION BOX 00-JE-12006	No.	MARSHALLING CABINET B400-PCS-002

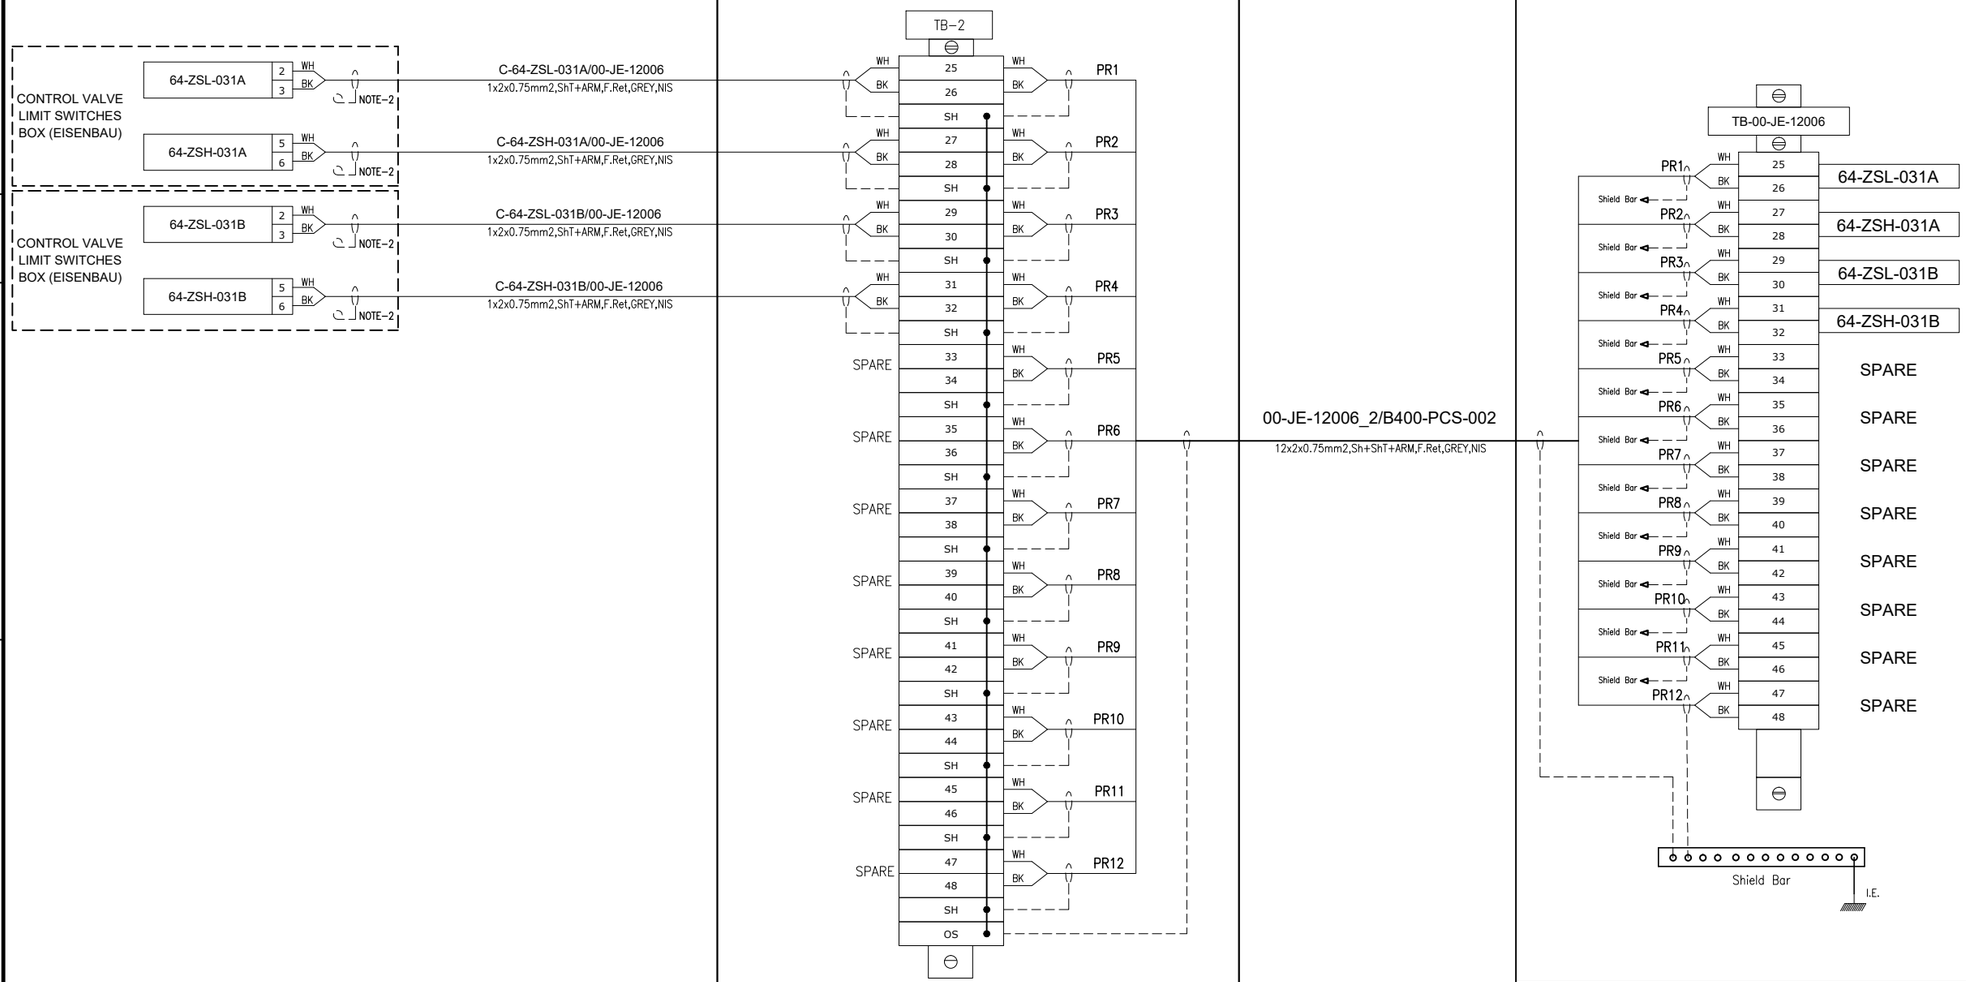

CROSSWIND

ROSETTI MARINO

TITLE :

BASE LOAD POWER HUB (BLPH)
INSTRUMENT – PCS WIRING DIAGRAMS
00-JE-12006-SH.2 OF 2

CONTRACT NO./TITLE			SCALE N/A
DRAWN SPS	CHECKED LCA	APPROVED CGI	DATE 29/09/2025
A3	DRAWING NO. 123A90-DDL-IN-DG-40015	SHEET 023	REV. 02

File Name : 123A90-DDL-IN-DG-40015_Rev.02

DRAWING NO. 123-A90-DDL-IN-DG-40015

REV. 02

FIELD		I&T EQUIPMENT ROOM (ITER)
EQUIPMENT ROOM	CABLE NO	MARSHALLING CABINET B400-PCS-002



CROSSWIND

ROSETTI MARINO

TITLE :

BASE LOAD POWER HUB (BLPH)
INSTRUMENT – PCS WIRING DIAGRAMS
B–100÷400 – ACCESS CONTROL SIGNALS

CONTRACT NO./TITLE			SCALE N/A
DRAWN SPS	CHECKED LCA	APPROVED CGI	DATE 29/09/2025

A3	DRAWING NO. 123A90–DDL–IN–DG–40015	SHEET 024	REV. 02

File Name : 123A90-DDL-IN-DG-40015_Rev.02

DRAWING NO. 123A90-DDL-IN-DG-40015

REV. 02

SPARE SHEET

CROSSWIND

ROSETTI MARINO

TITLE : BASE LOAD POWER HUB (BLPH)
INSTRUMENT – PCS WIRING DIAGRAMS
SPARE SHEET

CONTRACT NO./TITLE			SCALE N/A
DRAWN SPS	CHECKED LCA	APPROVED CGI	DATE 29/09/2025

A3	DRAWING NO. 123A90-DDL-IN-DG-40015	SHEET 025	REV. 02

File Name : 123A90-DDL-IN-DG-40015_Rev.02

DRAWING NO. 123A90-DDL-IN-DG-40015

REV. 02

SPARE SHEET

CROSSWIND

ROSETTI MARINO

TITLE :

BASE LOAD POWER HUB (BLPH)
INSTRUMENT – PCS WIRING DIAGRAMS
SPARE SHEET

CONTRACT NO./TITLE			SCALE N/A
DRAWN SPS	CHECKED LCA	APPROVED CGI	DATE 29/09/2025

	DRAWING NO.	SHEET	REV.
A3	123A90-DDL-IN-DG-40015	026	02

File Name : 123A90-DDL-IN-DG-40015_Rev.02

DRAWING NO. 123A90-DDL-IN-DG-40015

REV. 02

SPARE SHEET

CROSSWIND

ROSETTI MARINO

TITLE : BASE LOAD POWER HUB (BLPH)
INSTRUMENT – PCS WIRING DIAGRAMS
SPARE SHEET

CONTRACT NO./TITLE			SCALE N/A
DRAWN SPS	CHECKED LCA	APPROVED CGI	DATE 29/09/2025


A3	DRAWING NO. 123A90-DDL-IN-DG-40015	SHEET 027	REV. 02

File Name : 123A90-DDL-IN-DG-40015_Rev.02

DRAWING NO. 123A90-DDL-IN-DG-40015

REV. 02

FIELD		MULTICABLE	I&T EQUIPMENT ROOM (ITER)
INSTRUMENTS	JUNCTION BOX 00-JE-13001	No.	MARSHALLING CABINET B400-PCS-002

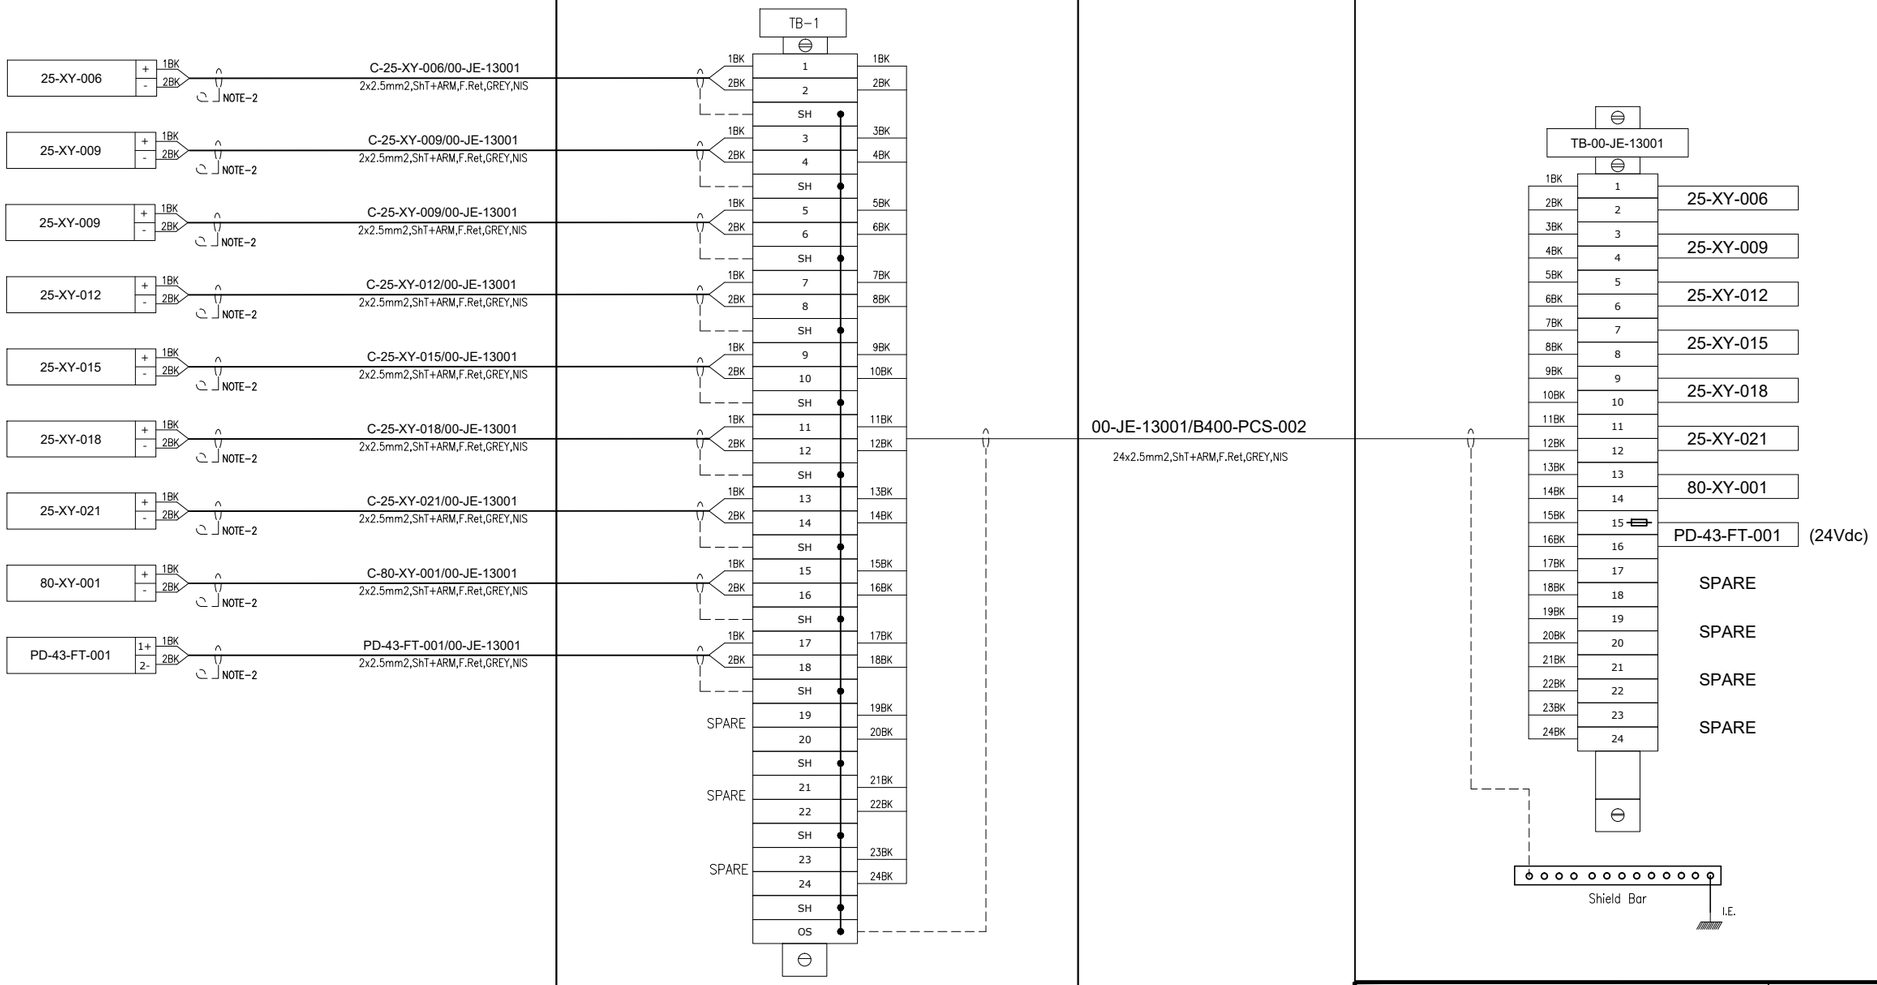

CROSSWIND

ROSETTI MARINO

TITLE :

BASE LOAD POWER HUB (BLPH)
INSTRUMENT – PCS WIRING DIAGRAMS
00–JE–13001


CONTRACT NO./TITLE			SCALE N/A
DRAWN SPS	CHECKED LCA	APPROVED CGI	DATE 29/09/2025
A3	DRAWING NO. 123A90–DDL–IN–DG–40015	SHEET 028	REV. 02

File Name : 123A90-DDL-IN-DG-40015_Rev.02

DRAWING NO. 123A90-DDL-IN-DG-40015

REV. 02

FIELD		MULTICABLE	I&T EQUIPMENT ROOM (ITER)
INSTRUMENTS	JUNCTION BOX 00-JE-13002	No.	MARSHALLING CABINET B400-PCS-002

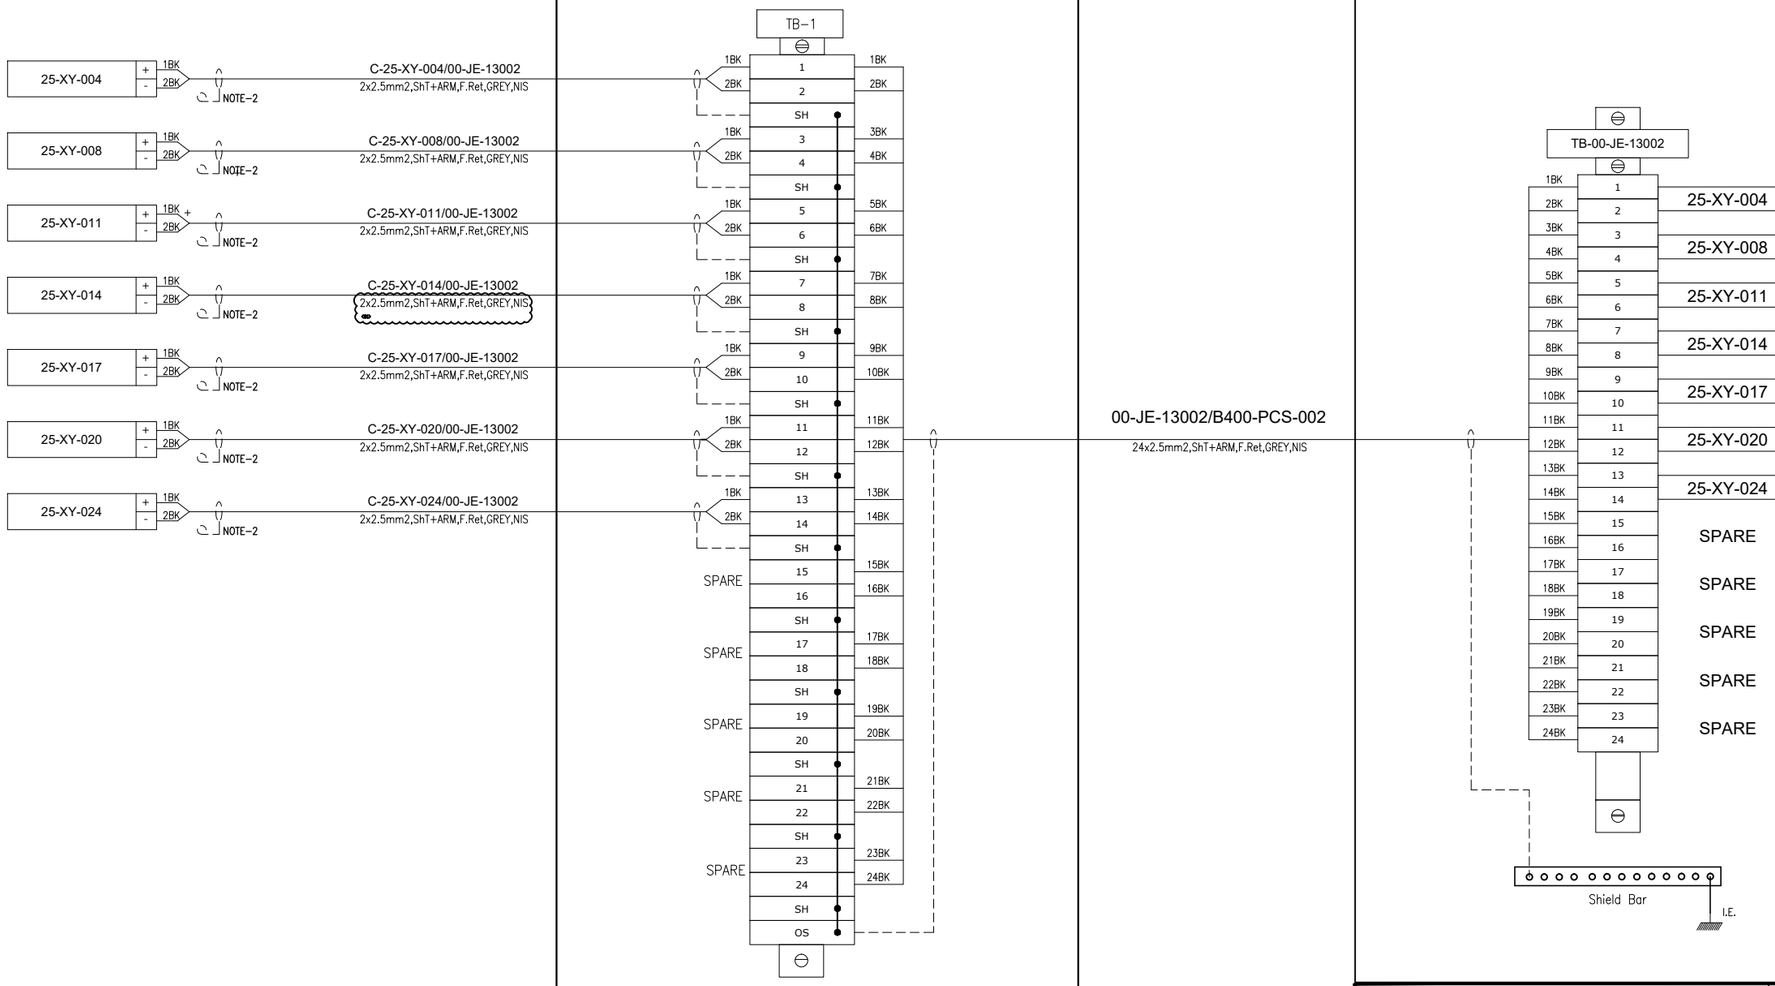

CROSSWIND

ROSETTI MARINO

TITLE : BASE LOAD POWER HUB (BLPH)
INSTRUMENT – PCS WIRING DIAGRAMS
00–JE–13002


CONTRACT NO./TITLE			SCALE N/A
DRAWN SPS	CHECKED LCA	APPROVED CGI	DATE 29/09/2025
A3	DRAWING NO. 123A90–DDL–IN–DG–40015		SHEET 029 / REV. 02

File Name : 123A90-DDL-IN-DG-40015_Rev.02

DRAWING NO. 123A90-DDL-IN-DG-40015

REV. 02

FIELD		MULTICABLE	I&T EQUIPMENT ROOM (ITER)
INSTRUMENTS	JUNCTION BOX 00-JE-13003	No.	MARSHALLING CABINET B400-PCS-002

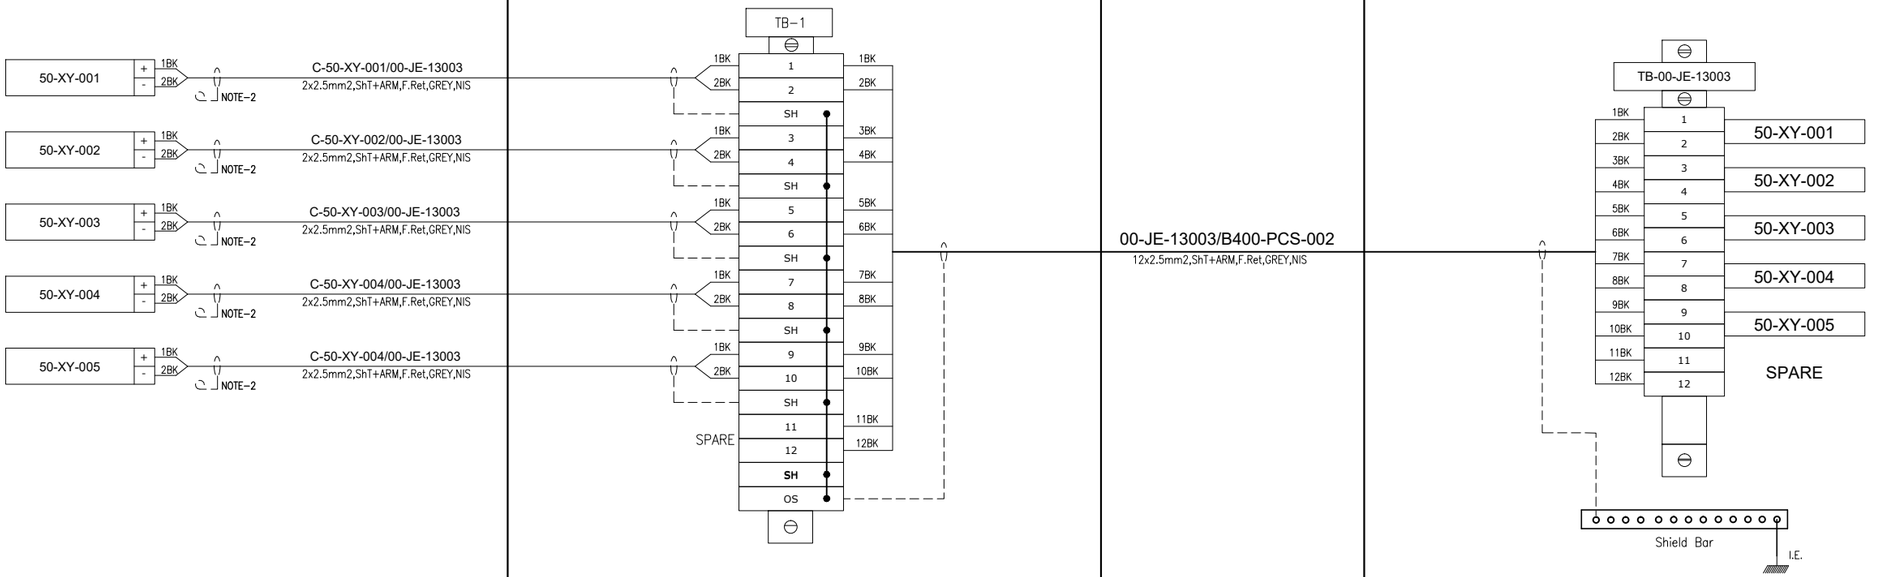

CROSSWIND

ROSETTI MARINO

TITLE : BASE LOAD POWER HUB (BLPH)
INSTRUMENT – PCS WIRING DIAGRAMS
00–JE–13003

CONTRACT NO./TITLE			SCALE N/A
DRAWN SPS	CHECKED LCA	APPROVED CGI	DATE 29/09/2025

A3	DRAWING NO. 123A90–DDL–IN–DG–40015	SHEET 030	REV. 02

File Name : 123A90-DDL-IN-DG-40015_Rev.02

DRAWING NO. 123A90-DDL-IN-DG-40015

REV. 02

SPARE SHEET

CROSSWIND

ROSETTI MARINO

TITLE : BASE LOAD POWER HUB (BLPH)
INSTRUMENT – PCS WIRING DIAGRAMS
SPARE SHEET

CONTRACT NO./TITLE			SCALE N/A
DRAWN SPS	CHECKED LCA	APPROVED CGI	DATE 29/09/2025

	DRAWING NO.	SHEET	REV.
A3	123A90–DDL–IN–DG–40015	031	02

File Name : 123A90-DDL-IN-DG-40015_Rev.02

DRAWING NO. 123A90-DDL-IN-DG-40015

REV. 02

SPARE SHEET

CROSSWIND

ROSETTI MARINO

TITLE : BASE LOAD POWER HUB (BLPH)
INSTRUMENT – PCS WIRING DIAGRAMS
SPARE SHEET

CONTRACT NO./TITLE			SCALE N/A
DRAWN SPS	CHECKED LCA	APPROVED CGI	DATE 29/09/2025

	DRAWING NO.	SHEET	REV.
A3	123A90–DDL–IN–DG–40015	032	02

File Name : 123A90-DDL-IN-DG-40015_Rev.02

DRAWING NO. 123A90-DDL-IN-DG-40015

REV. 02

HV SWITCHROOM (B-100)

I&T EQUIPMENT ROOM (ITER B400)

NETWORK CABINET - B400-NET-001

HVAC CABINET B100-HSB-001	ITEM: SCALANCE XC208 PORT: P3 LAN	RJ45	B100-HSB-001/B400-NET-001 CAT.6A4x2xAWG23,Sh+ShT+ARM,F.Ret,GREY,NIS	RJ45	SWITCH: COOP-01 PORT: P11	Ref. Vendor Doc.: 1724000049-HV-DA-00026
DCS UPS PANEL UP-200F1	ITEM: -A1 GCAU (/8.2) -A73 NCS-TCP/IP PORT: IN	RJ45	UP-200F1/B400-NET-001.01 CAT.6A4x2xAWG23,Sh+ShT+ARM,F.Ret,GREY,NIS	RJ45	SWITCH: COOP-01 PORT: P09	Ref. Vendor Doc.: 1724000372-EL-DG-00010
DCS UPS PANEL UP-200F1	ITEM: -A1 GCAU (/11.2) -A73 NCS-TCP/IP PORT: IN	RJ45	UP-200F1/B400-NET-001.02 CAT.6A4x2xAWG23,Sh+ShT+ARM,F.Ret,GREY,NIS	RJ45	SWITCH: COOP-01 PORT: P10	Ref. Vendor Doc.: 1724000372-EL-DG-00010
6.6kV SWITCHGEAR SG-100D1	ITEM: VT BUS BARS "A5" SWH.A PORT: 8	RJ45	SG-100D1/B400-NET-001.01 CAT.6A4x2xAWG23,Sh+ShT+ARM,F.Ret,GREY,NIS	RJ45	SWITCH: COOP-01 PORT: P20	Ref. Vendor Doc.: 1723002197-EL-DG-00022
6.6kV SWITCHGEAR SG-100D1	ITEM: VT BUS BARS "A5" SWH.B PORT: 8	RJ45	SG-100D1/B400-NET-001.02 CAT.6A4x2xAWG23,Sh+ShT+ARM,F.Ret,GREY,NIS	RJ45	SWITCH: COOP-01 PORT: P01	Ref. Vendor Doc.: 1723002197-EL-DG-00022
6.6kV SWITCHGEAR SG-100D1	ITEM: VT BUS BARS "A5" SWH.C PORT: 1	RJ45	SG-100D1/B400-NET-001.03 CAT.6A4x2xAWG23,Sh+ShT+ARM,F.Ret,GREY,NIS	RJ45	SWITCH: COOP-01 PORT: P03	Ref. Vendor Doc.: 1723002197-EL-DG-00022

CROSSWIND

ROSETTI MARINO

TITLE :

BASE LOAD POWER HUB (BLPH)
INSTRUMENT – PCS WIRING DIAGRAMS
COMMUNICATION – CAT-6

CONTRACT NO./TITLE			SCALE N/A
DRAWN SPS	CHECKED LCA	APPROVED CGI	DATE 29/09/2025

	DRAWING NO.	SHEET	REV.
A3	123A90-DDL-IN-DG-40015	033	02

File Name : 123A90-DDL-IN-DG-40015_Rev.02

DRAWING NO. 123A90-DDL-IN-DG-40015

REV. 02

LV SWITCHROOM (B-200)

I&T EQUIPMENT ROOM (ITER B400)

NETWORK CABINET - B400-NET-001

HVAC CABINET B200-HSB-001	ITEM: SCALANCE XC208 PORT: P3 LAN	RJ45	B200-HSB-001/B400-NET-001 CAT.6A4x2xAWG23,Sh+ShT+ARM,F.Ret,GREY,NIS	RJ45	SWITCH: COOP-01 PORT: P12
Ref. Vendor Doc.: 1724000049-HV-DA-00027					
400V SWITCHGEAR SG-200N1	ITEM: REF615 PROTECTION FUNCTION (ABB) PORT: X1	RJ45	SG-200N1/B400-NET-001.01 CAT.6A4x2xAWG23,Sh+ShT+ARM,F.Ret,GREY,NIS	RJ45	SWITCH: COOP-01 PORT: P15
Ref. Vendor Doc.: 1723002197-EL-DG-00030					
400V SWITCHGEAR SG-200N1	ITEM: REF615 PROTECTION FUNCTION (ABB) PORT: X3	RJ45	SG-200N1/B400-NET-001.02 CAT.6A4x2xAWG23,Sh+ShT+ARM,F.Ret,GREY,NIS	RJ45	SWITCH: COOP-01 PORT: P04
Ref. Vendor Doc.: 1723002197-EL-DG-00030					
400V SWITCHGEAR SG-200N1	ITEM: ETH, SWITCH RSP25 SW1 PORT: ETH/SFP - PORT 1	RJ45	SG-200N1/B400-NET-001.03 CAT.6A4x2xAWG23,Sh+ShT+ARM,F.Ret,GREY,NIS	RJ45	SWITCH: COOP-01 PORT: P02
Ref. Vendor Doc.: 1723002197-EL-DG-00030					
ACB PANEL SG-200D2	ITEM: ETH, SWITCH RSP25 SW1 PORT: ETH/SFP - PORT 1	RJ45	SG-200D2/B400-NET-001 CAT.6A4x2xAWG23,Sh+ShT+ARM,F.Ret,GREY,NIS	RJ45	SWITCH: COOP-01 PORT: P21
Ref. Vendor Doc.: 1723002197-EL-DG-00032					

CROSSWIND

ROSETTI MARINO

TITLE :

BASE LOAD POWER HUB (BLPH)
INSTRUMENT – PCS WIRING DIAGRAMS
COMMUNICATION – CAT-6

CONTRACT NO./TITLE			SCALE N/A
DRAWN SPS	CHECKED LCA	APPROVED CGI	DATE 29/09/2025

	DRAWING NO.	SHEET	REV.
A3	123A90-DDL-IN-DG-40015	034	02

File Name : 123A90-DDL-IN-DG-40015_Rev.02

DRAWING NO. 123A90-DDL-IN-DG-40015

REV. 02

AC UPS (B-300)

I&T EQUIPMENT ROOM (ITER B400)

NETWORK CABINET - B400-NET-001

HVAC CABINET B300-HSB-001	ITEM: SCALANCE XC208 PORT: P3 LAN	RJ45	B300-HSB-001/B400-NET-001 CAT.6A4x2xAWG23,Sh+ShT+ARM,F.Ret,GREEN,NIS	RJ45	SWITCH: COOP-01 PORT: P13
Ref. Vendor Doc.: 1724000049-HV-DA-00028						
AC UP 35kVA UP -200F3	ITEM: MULTICANCOM2 UPS1 -A9 / -A29.1 PORT: -X5	RJ45	UP-200F3/B400-NET-001.01 CAT.6A4x2xAWG23,Sh+ShT+ARM,F.Ret,GREEN,NIS	RJ45	SWITCH: COOP-01 PORT: P05
Ref. Vendor Doc.: 1724000372-EL-DG-00009						
AC UP 35kVA UP -200F3	ITEM: MULTICANCOM2 UPS2 -A9 / -A29.1 PORT: -X5	RJ45	UP-200F3/B400-NET-001.02 CAT.6A4x2xAWG23,Sh+ShT+ARM,F.Ret,GREEN,NIS	RJ45	SWITCH: COOP-01 PORT: P24
Ref. Vendor Doc.: 1724000372-EL-DG-00009						
AC UP 15kVA UP -200F4	ITEM: MULTICANCOM2 UPS2 -A9 / -A29.1 PORT: -X5	RJ45	UP-200F4/B400-NET-001.01 CAT.6A4x2xAWG23,Sh+ShT+ARM,F.Ret,GREEN,NIS	RJ45	SWITCH: COOP-01 PORT: P23
Ref. Vendor Doc.: 1724000372-EL-DG-00009						
AC UP 15kVA UP -200F4	ITEM: MULTICANCOM2 UPS2 -A9 / -A29.1 PORT: -X5	RJ45	UP-200F4/B400-NET-001.02 CAT.6A4x2xAWG23,Sh+ShT+ARM,F.Ret,GREEN,NIS	RJ45	SWITCH: COOP-01 PORT: P08
Ref. Vendor Doc.: 1724000372-EL-DG-00009						

CROSSWIND

ROSETTI MARINO

TITLE :

BASE LOAD POWER HUB (BLPH)
INSTRUMENT – PCS WIRING DIAGRAMS
COMMUNICATION – CAT-6

CONTRACT NO./TITLE			SCALE N/A
DRAWN SPS	CHECKED LCA	APPROVED CGI	DATE 29/09/2025

	DRAWING NO.	SHEET	REV.
A3	123A90-DDL-IN-DG-40015	035	02

File Name : 123A90-DDL-IN-DG-40015_Rev.02

DRAWING NO. 123A90-DDL-IN-DG-40015

REV. 02

I&T EQUIPMENT ROOM (ITER B400)

NETWORK CABINET - B400-NET-001

HVAC CABINET
B400-HSB-001

ITEM: SCALANCE XC208

PORT: P3 LAN

RJ45

B400-HSB-001/B400-NET-001
CAT.6A4x2xAWG23,Sh+ShT+ARM,F.Ret,GREEN,NIS

RJ45

SWITCH: COOP-01
PORT: P14

Ref. Vendor Doc.: 1724000049-HV-DA-00029

CROSSWIND

ROSETTI MARINO

TITLE :

BASE LOAD POWER HUB (BLPH)
INSTRUMENT – PCS WIRING DIAGRAMS
COMMUNICATION – CAT-6

CONTRACT NO./TITLE			SCALE N/A
DRAWN SPS	CHECKED LCA	APPROVED CGI	DATE 29/09/2025

	DRAWING NO.	SHEET	REV.
A3	123A90-DDL-IN-DG-40015	036	02

File Name : 123A90-DDL-IN-DG-40015_Rev.02

DRAWING NO. 123A90-DDL-IN-DG-40015

REV. 02

FIELD

I&T EQUIPMENT ROOM (ITER B400)

NETWORK CABINET - B400-NET-001

BESS (A-85000) P320 PLC	ITEM: RJ45 PORT PORT: 111A1	RJ45	P320PLC/B400-NET-001.01 CAT.6A4x2xAWG23,Sh+ShT+ARM,F.Ret,GREY,NIS	RJ45	SWITCH: COOP-02 PORT: P01
BESS (A-85000) P320 PLC	ITEM: RJ45 PORT PORT: 114A1	RJ45	P320PLC/B400-NET-001.02 CAT.6A4x2xAWG23,Sh+ShT+ARM,F.Ret,GREY,NIS	RJ45	SWITCH: COOP-02 PORT: P11
ELECTROLYSER (A-20000) 20-UCP-001	ITEM: RJ45 PORT PORT: 415K1	RJ45	20-UCP-001/B400-NET-001.01 CAT.6A4x2xAWG23,Sh+ShT+ARM,F.Ret,GREY,NIS	RJ45	SWITCH: COOP-02 PORT: P02
ELECTROLYSER (A-20000) 20-UCP-001	ITEM: RJ45 PORT PORT: 415K5	RJ45	20-UCP-001/B400-NET-001.02 CAT.6A4x2xAWG23,Sh+ShT+ARM,F.Ret,GREY,NIS	RJ45	SWITCH: COOP-02 PORT: P03
FUEL CELL (A-80000) 80-UCP-001	ITEM: NOTE 5 PORT: NOTE 5	RJ45	80-UCP-001/B400-NET-001.01 CAT.6A4x2xAWG23,Sh+ShT+ARM,F.Ret,GREY,NIS	RJ45	SWITCH: COOP-02 PORT: P10
FUEL CELL (A-80000) 80-UCP-001	ITEM: NOTE 5 PORT: NOTE 5	RJ45	80-UCP-001/B400-NET-001.02 CAT.6A4x2xAWG23,Sh+ShT+ARM,F.Ret,GREY,NIS	RJ45	SWITCH: COOP-02 PORT: P03

CROSSWIND

ROSETTI MARINO

TITLE :

BASE LOAD POWER HUB (BLPH)
INSTRUMENT – PCS WIRING DIAGRAMS
COMMUNICATION – CAT-6

CONTRACT NO./TITLE			SCALE N/A
DRAWN SPS	CHECKED LCA	APPROVED CGI	DATE 29/09/2025

	DRAWING NO.	SHEET	REV.
A3	123A90-DDL-IN-DG-40015	037	02

File Name : 123A90-DDL-IN-DG-40015_Rev.02

DRAWING NO. 123A90-DDL-IN-DG-40015

REV. 02

FIELD

I&T EQUIPMENT ROOM (ITER B400)

NETWORK CABINET - B400-NET-001

CP-500E1 UCP PANEL	SEA WATER TREAT. (A-50003) 50-LP-001	ITEM: PORT: P3	RJ45	50-LP-001 / B400-NET-001 CAT.6A4x2xAWG23,Sh+ShT+ARM,F.Ret,GREEN,NIS	RJ45	SWITCH: COOP-01 PORT: P16
	DOC: 1723000448-EL-DG-00015 Sh.13						
	I. A. PACKAGE (A-63000) 63-LP-001	ITEM: NOTE 5 PORT: NOTE 5	RJ45	63-LP-001 / B400-NET-001 CAT.6A4x2xAWG23,Sh+ShT+ARM,F.Ret,GREY,NIS	RJ45	SWITCH: COOP-01 PORT: P17
	DOC: 1723000428-MAC-DG-00009 Sh.13						
	NITROGEN SYSTEM (U-64000) 64-LP-001	ITEM: NOTE 5 PORT: NOTE 5	RJ45	64-LP-001 / B400-NET-001 CAT.6A4x2xAWG23,Sh+ShT+ARM,F.Ret,GREY	RJ45	SWITCH: COOP-01 PORT: P18
	DOC: 1723000437-MAC-DG-00009 Sh.13						
CP-100E3	TRANSFORMER TR-100AD1 AVR	ITEM: TAPCON 230 - EXPERT PORT: SCADA ETHERNET	RJ45	TR-100AD1 AVR/ B400-NET-001 CAT.6A4x2xAWG23,Sh+ShT+ARM,F.Ret,GREY,NIS	RJ45	SWITCH: COOP-01 PORT: P19
	DOC: 1723001697-EL-DG-00010 Sh.13						

CROSSWIND

ROSETTI MARINO

TITLE :

BASE LOAD POWER HUB (BLPH)
INSTRUMENT – PCS WIRING DIAGRAMS
COMMUNICATION – CAT-6

CONTRACT NO./TITLE			SCALE N/A
DRAWN SPS	CHECKED LCA	APPROVED CGI	DATE 29/09/2025

	DRAWING NO.	SHEET	REV.
A3	123A90-DDL-IN-DG-40015	038	02

File Name : 123A90-DDL-IN-DG-40015_Rev.02


DRAWING NO. 123A90-DDL-IN-DG-40015

REV. 02

FIELD - TRANSITION PIECE

I&T EQUIPMENT ROOM (ITER B400)

NETWORK CABINET - B400-NET-001

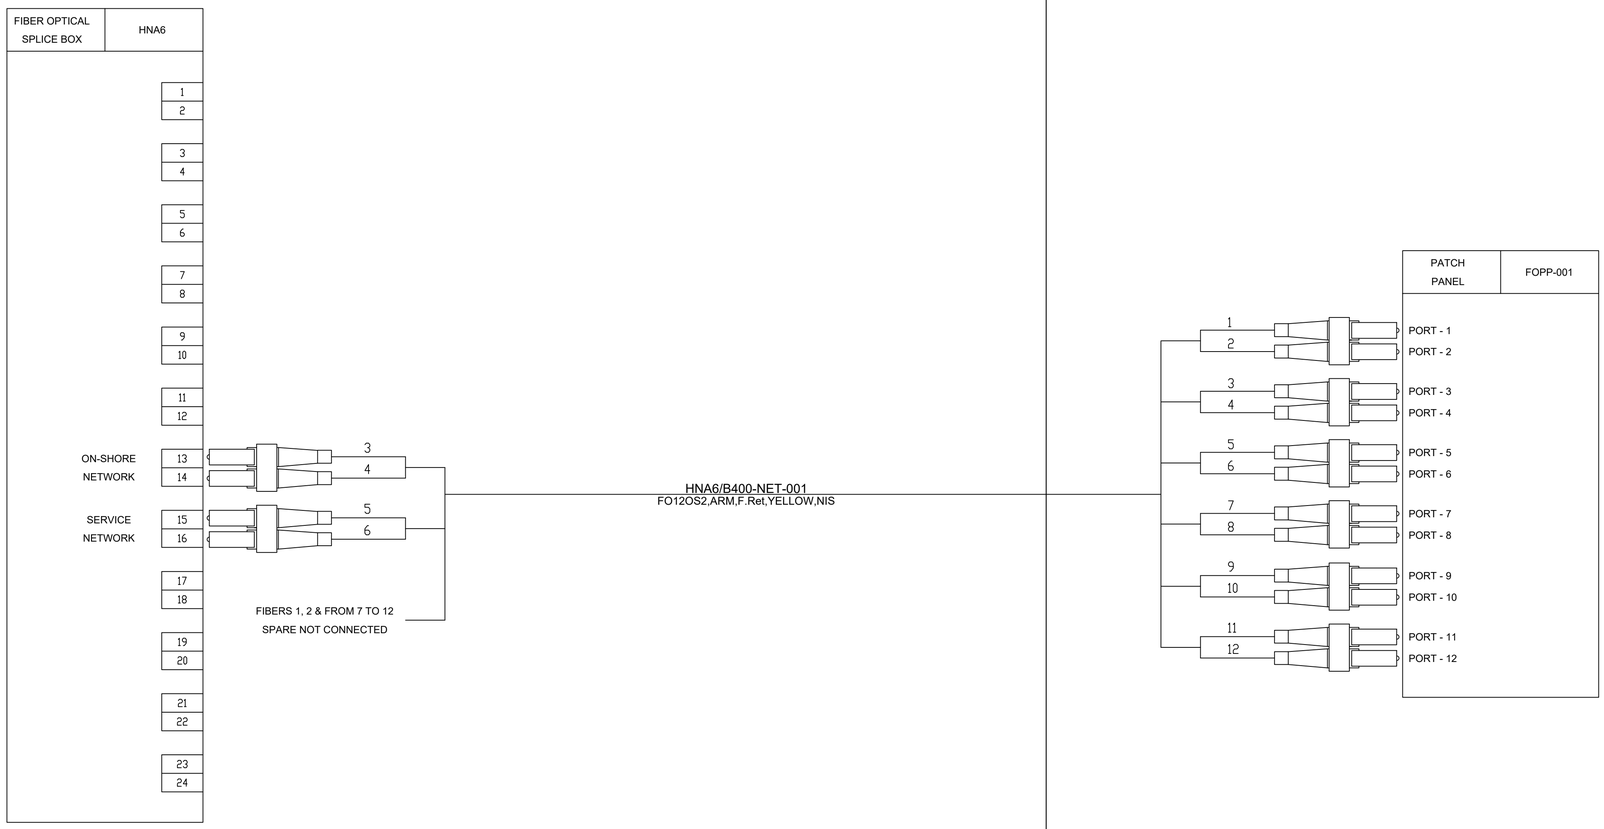

CROSSWIND

ROSETTI MARINO

TITLE :

BASE LOAD POWER HUB (BLPH)
INSTRUMENT – PCS WIRING DIAGRAMS
COMMUNICATION – F.O.

CONTRACT NO./TITLE			SCALE N/A
DRAWN SPS	CHECKED LCA	APPROVED CGI	DATE 29/09/2025

A3	DRAWING NO. 123A90-DDL-IN-DG-40015	SHEET 039	REV. 02

File Name : 123A90-DDL-IN-DG-40015_Rev.02


DRAWING NO. 123A90-DDL-IN-DG-40015

REV. 02

FIELD - TRANSITION PIECE

LV SWITCHROOM (B-200)

ICCP PANEL - CN-200N1

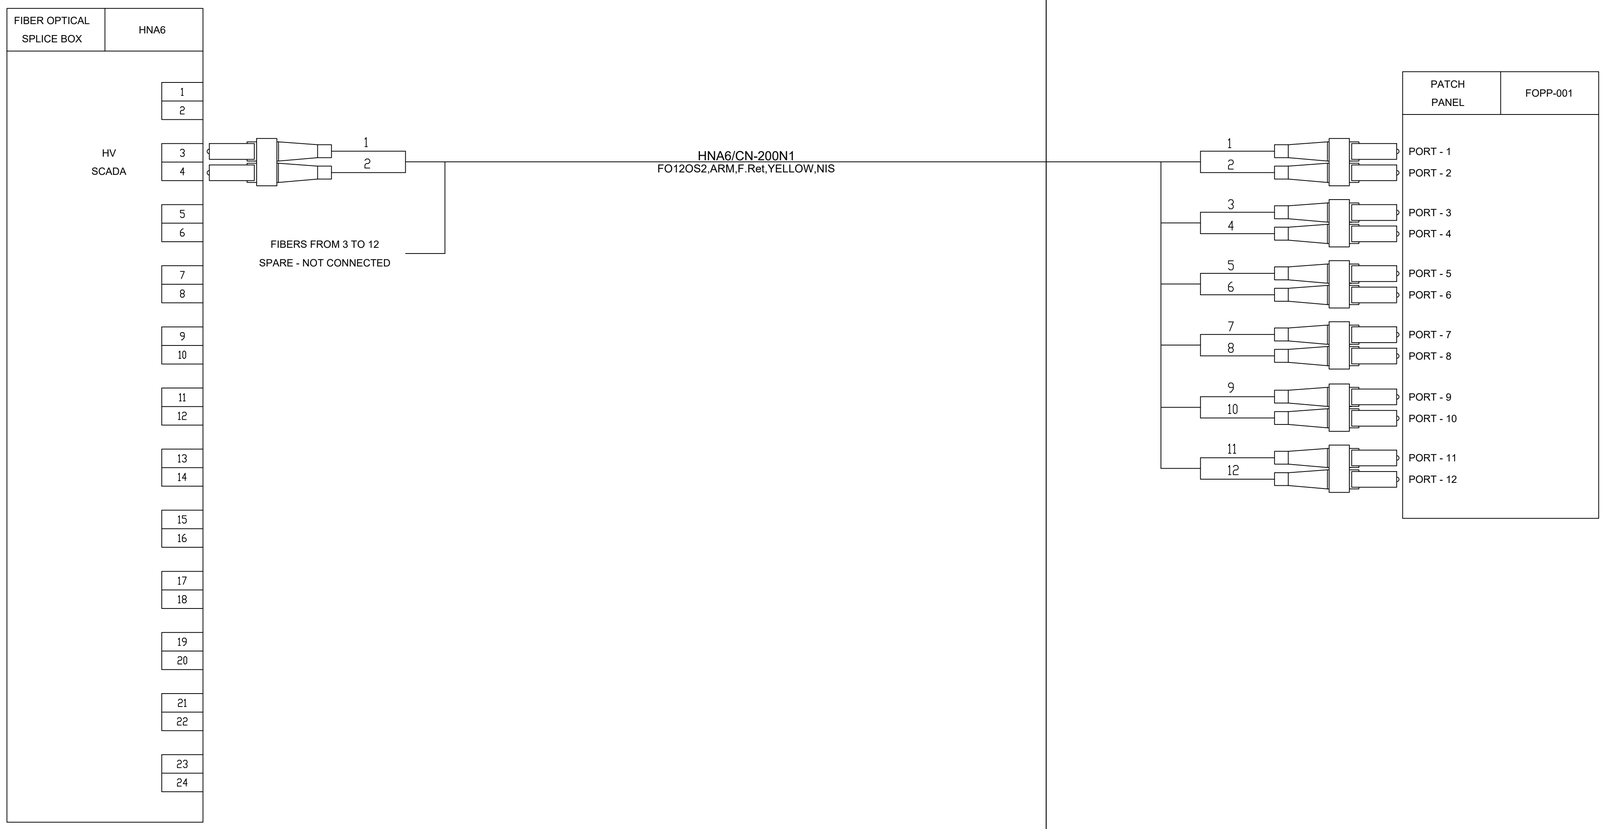

CROSSWIND

ROSETTI MARINO

TITLE :

BASE LOAD POWER HUB (BLPH)
INSTRUMENT – PCS WIRING DIAGRAMS
COMMUNICATION – F.O.

CONTRACT NO./TITLE			SCALE N/A
DRAWN SPS	CHECKED LCA	APPROVED CGI	DATE 29/09/2025

	DRAWING NO.	SHEET	REV.
A3	123A90-DDL-IN-DG-40015	040	02

File Name : 123A90-DDL-IN-DG-40015_Rev.02


DRAWING NO. 123A90-DDL-IN-DG-40015

REV. 02

HV SWITCHROOM (B-100)

I&T EQUIPMENT ROOM (ITER B400)

NETWORK SYSTEM - B400-NET-001

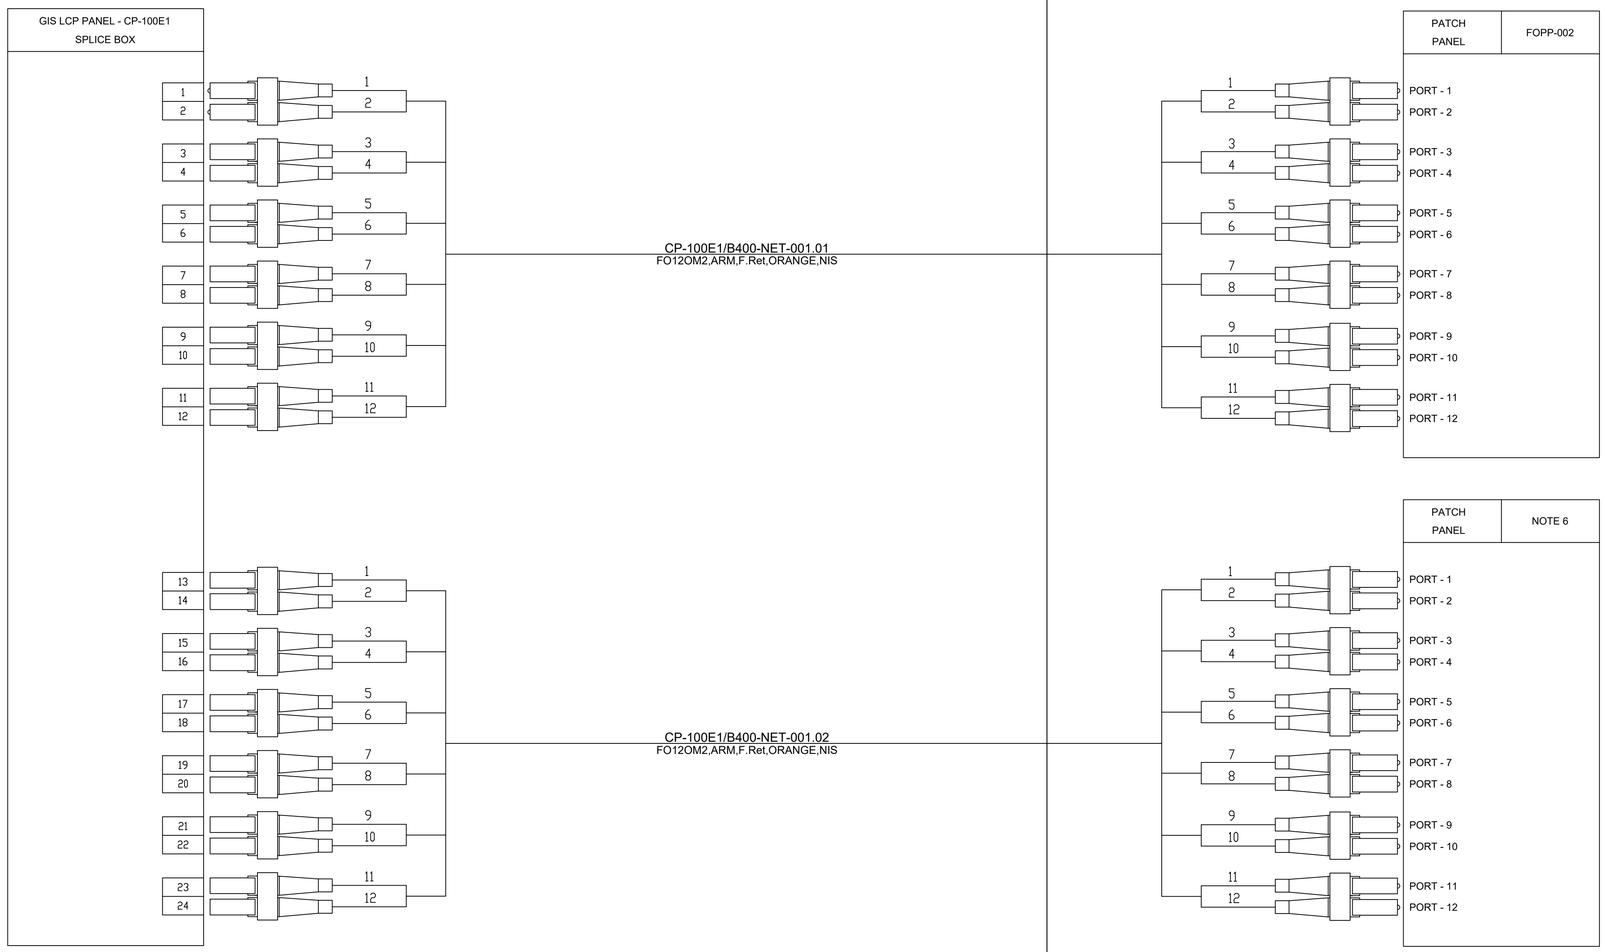

CROSSWIND

ROSETTI MARINO

TITLE :

BASE LOAD POWER HUB (BLPH)
INSTRUMENT – PCS WIRING DIAGRAMS
COMMUNICATION – F.O.

CONTRACT NO./TITLE			SCALE N/A
DRAWN SPS	CHECKED LCA	APPROVED CGI	DATE 29/09/2025

A3	DRAWING NO. 123A90-DDL-IN-DG-40015	SHEET 041	REV. 02

File Name : 123A90-DDL-IN-DG-40015_Rev.02

DRAWING NO. 123A90-DDL-IN-DG-40015

REV. 02

HV SWITCHROOM (B-100)

GIS

CP-100E1	HV-SCADA FDF

SPLICE BOX

PORT-1 — 1
PORT-2 — 2
PORT-3 — 3
PORT-4 — 4
PORT-5 — 5
PORT-6 — 6
PORT-7 — 7
PORT-8 — 8
PORT-9 — 9
PORT-10 — 10
PORT-11 — 11
PORT-12 — 12

CP-100E1/B400-HNA6
FO12OS2,ARM,F.Ret,YELLOW,NIS

FIELD - TRANSITION PIECE

HNA5	FIBER OPTICAL SPLICE BOX

1
2

PORT - 1
PORT - 2

FIBERS FROM 3 TO 12
SPARE NOT CONNECTED

CROSSWIND

ROSETTI MARINO

TITLE :

BASE LOAD POWER HUB (BLPH)
INSTRUMENT – PCS WIRING DIAGRAMS
COMMUNICATION – F.O.

CONTRACT NO./TITLE			SCALE N/A
DRAWN SPS	CHECKED LCA	APPROVED CGI	DATE 29/09/2025

A3	DRAWING NO.	SHEET	REV.
	123A90-DDL-IN-DG-40015	042	02

File Name : 123A90-DDL-IN-DG-40015_Rev.02