
DRAWING NO. 123A90-DDL-IN-DL-40081


REV. 03

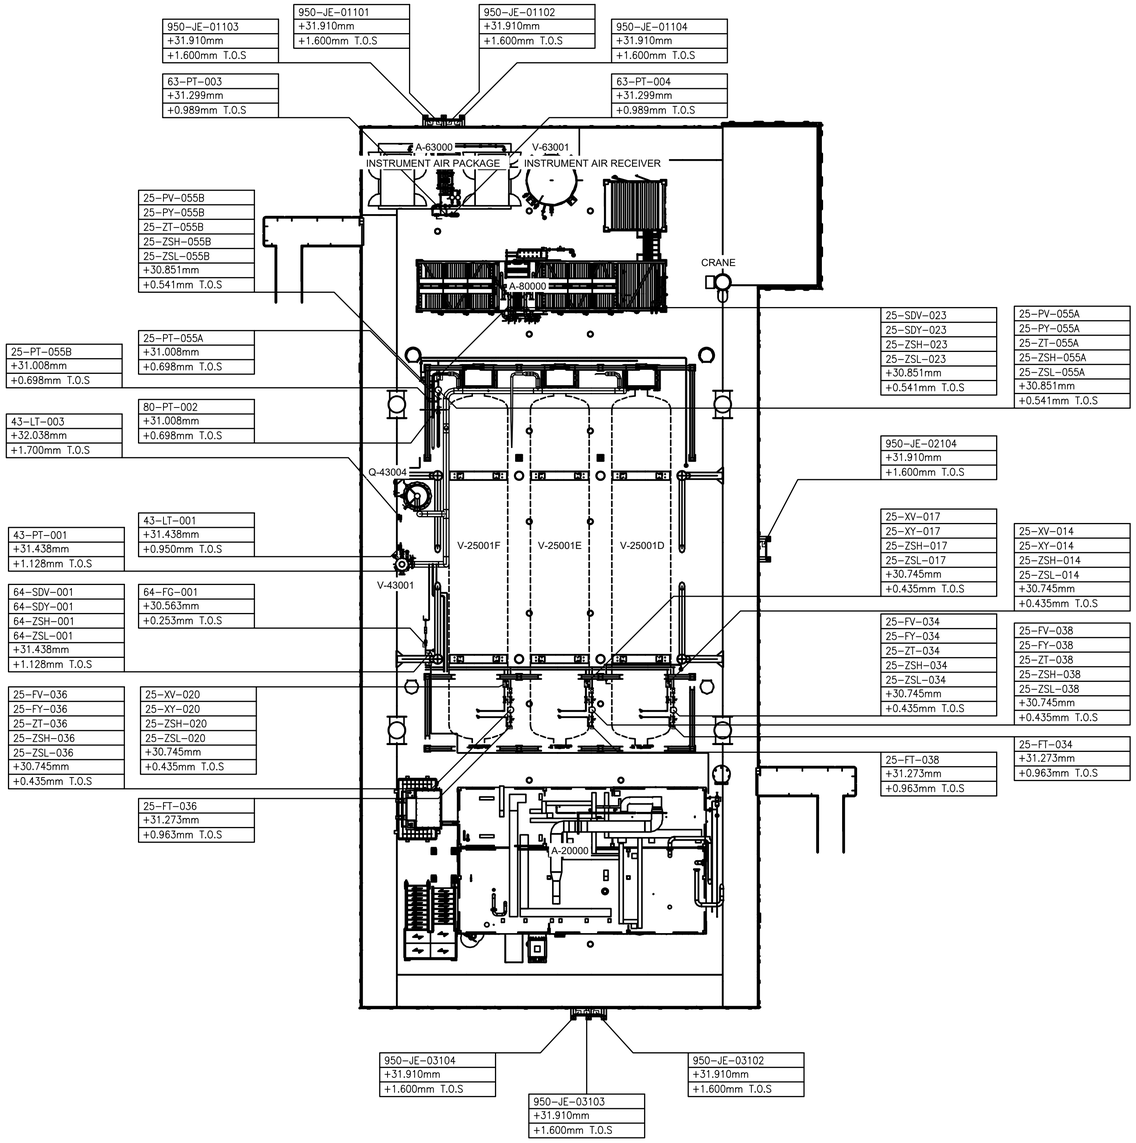

UPPER DECK

SCALE: 1:100

VIEW EL. 29310mm to 33740mm

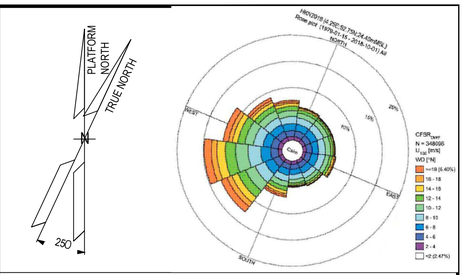

NOTES

1. ALL DIMENSIONS AND ELEVATIONS ARE GIVEN IN mm UNLESS OTHERWISE NOTED.
2. ELEVATIONS REFER TO T.O.S.
3. THIS DRAWING IS VALID ONLY FOR INSTRUMENT LOCATION LAYOUT.

LEGEND

- INSTRUMENT JUNCTION BOX
- ELECTRONIC INSTRUMENT
- CONTROL / ON-OFF VALVE

HOLDS

REFERENCE DOCUMENTS

123A90-DDL-PP-DL-70070	PLOT PLAN - LOWER & UPPER DECK
123A90-DDL-IN-DL-40080	INSTRUMENT LAYOUT - LOWER DECK
123A90-DDL-IN-LIS-40091	INSTRUMENT CABLE LIST
123A90-DDL-IN-DG-40015	INSTRUMENT-CCS WIRING DIAGRAMS
123A90-DDL-IN-DG-40016	INSTRUMENT-SAFETY SYSTEM WIRING DIAGRAMS
123A90-DDL-IN-DL-40083	INSTRUMENT MAIN CABLES ROUTING-LOWER DECK

INSERT SUBCONTRACTOR / VENDOR LOGO HERE

REV.	DATE	DRN	CHKD	APPD	DESCRIPTION
03	29/09/25	SPS	LCA	CGI	AS-BUILT (ASB)
02	04/10/24	VBA	LCA	DLO	ACCEPTED FOR CONSTRUCTION (AFC)
01	26/08/24	VBA	LCA	DLO	ACCEPTED FOR CONSTRUCTION (AFC)
00	22/12/23	VBA	LCA	DLO	ISSUE FOR REVIEW (IFR)

CROSSWIND

ROSETTI MARINO

TITLE : BASE LOAD POWER HUB (BLPH)
INSTRUMENT LOCATION LAYOUT–UPPER DECK
TOS EL. 30.310M


CONTRACT NO./TITLE CW-I-WP4-2023-05/HOLLANDSE KUST NOORD WIND PARK			SCALE 1:150
DRAWN SPS	CHECKED LCA	APPROVED CGI	DATE 29/09/25

A1	DRAWING NO. 123A90-DDL-IN-DL-40081	SHEET 001	REV. 03

File Name : 123A90-DDL-IN-DL-40081 REV03.dwg

DRAWING NO. 123A90-DDL-IN-DL-40081


REV. 03

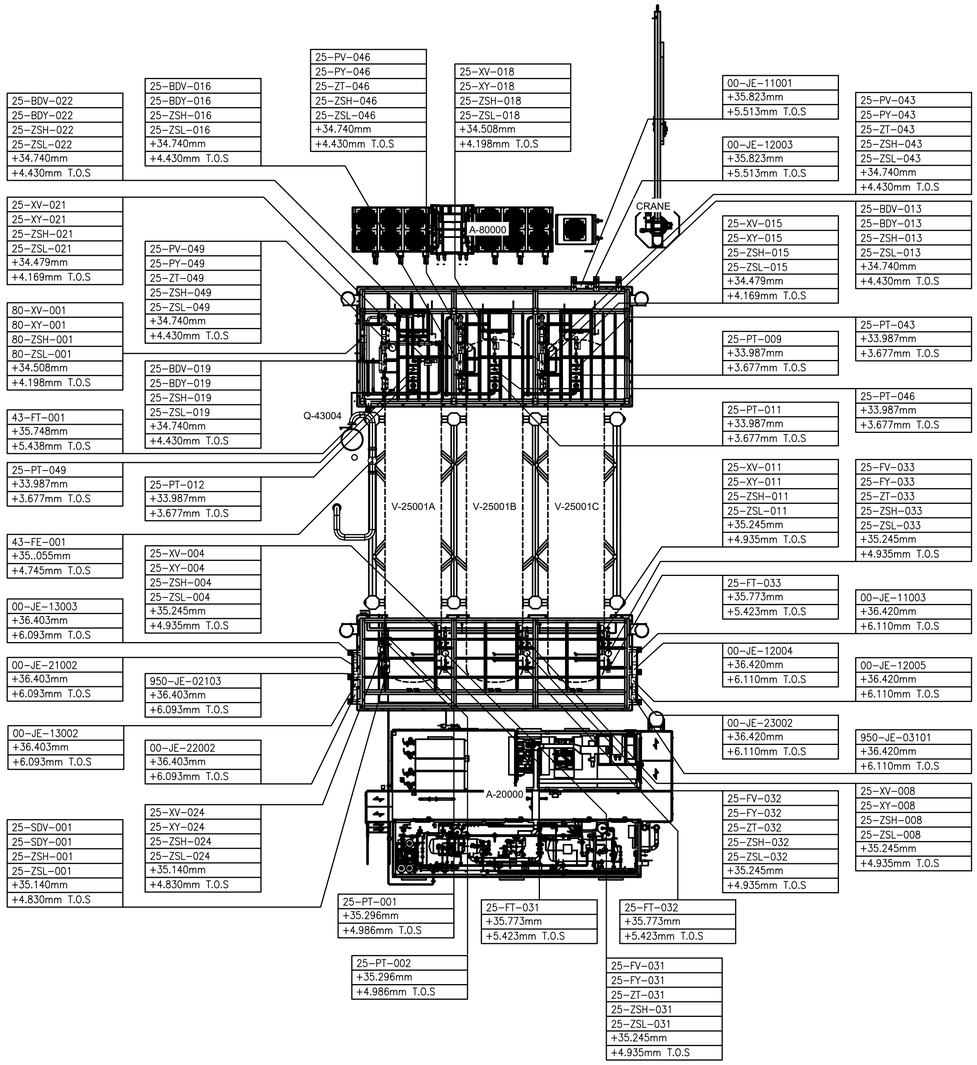

UPPER DECK

SCALE: 1:100

VIEW EL. 33740mm to 36500mm

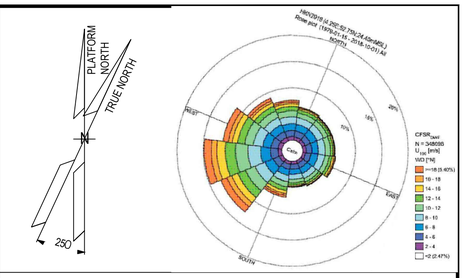

NOTES

1. ALL DIMENSIONS AND ELEVATIONS ARE GIVEN IN mm UNLESS OTHERWISE NOTED.
2. ELEVATIONS REFER TO T.O.S.
3. THIS DRAWING IS VALID ONLY FOR INSTRUMENT LOCATION LAYOUT.

LEGEND

- INSTRUMENT JUNCTION BOX
- ELECTRONIC INSTRUMENT
- CONTROL / ON-OFF VALVE

HOLDS

REFERENCE DOCUMENTS

123A90-DDL-PP-DL-70070	PLOT PLAN - LOWER & UPPER DECK
123A90-DDL-IN-DL-40080	INSTRUMENT LAYOUT -LOWER DECK
123A90-DDL-IN-LIS-40091	INSTRUMENT CABLE LIST
123A90-DDL-IN-DG-40015	INSTRUMENT-CCS WIRING DIAGRAMS
123A90-DDL-IN-DG-40016	INSTRUMENT-SAFETY SYSTEM WIRING DIAGRAMS
123A90-DDL-IN-DL-40083	INSTRUMENT MAIN CABLES ROUTING-LOWER DECK

INSERT SUBCONTRACTOR / VENDOR LOGO HERE

REV.	DATE	DRN	CHKD	APPD	DESCRIPTION
03	29/09/25	SPS	LCA	CGI	AS-BUILT (ASB)
02	04/10/24	VBA	LCA	DLO	ACCEPTED FOR CONSTRUCTION (AFC)
01	05/08/24	VBA	LCA	DLO	ACCEPTED FOR CONSTRUCTION (AFC)
00	22/12/23	VBA	LCA	DLO	ISSUE FOR REVIEW (IFR)

CROSSWIND

ROSETTI MARINO

TITLE :


BASE LOAD POWER HUB (BLPH)
INSTRUMENT LOCATION LAYOUT–UPPER DECK
TOS EL. 30.310M

CONTRACT NO./TITLE CW-I-WP4-2023-05/HOLLANDSE KUST NOORD WIND PARK			SCALE 1:150
DRAWN SPS	CHECKED LCA	APPROVED CGI	DATE 29/09/25
A1	DRAWING NO. 123A90-DDL-IN-DL-40081	SHEET 002	REV. 03

File Name : 123A90-DDL-IN-DL-40081 REV:03.dwg

DRAWING NO. 123A90-DDL-IN-DL-40081


REV. 03

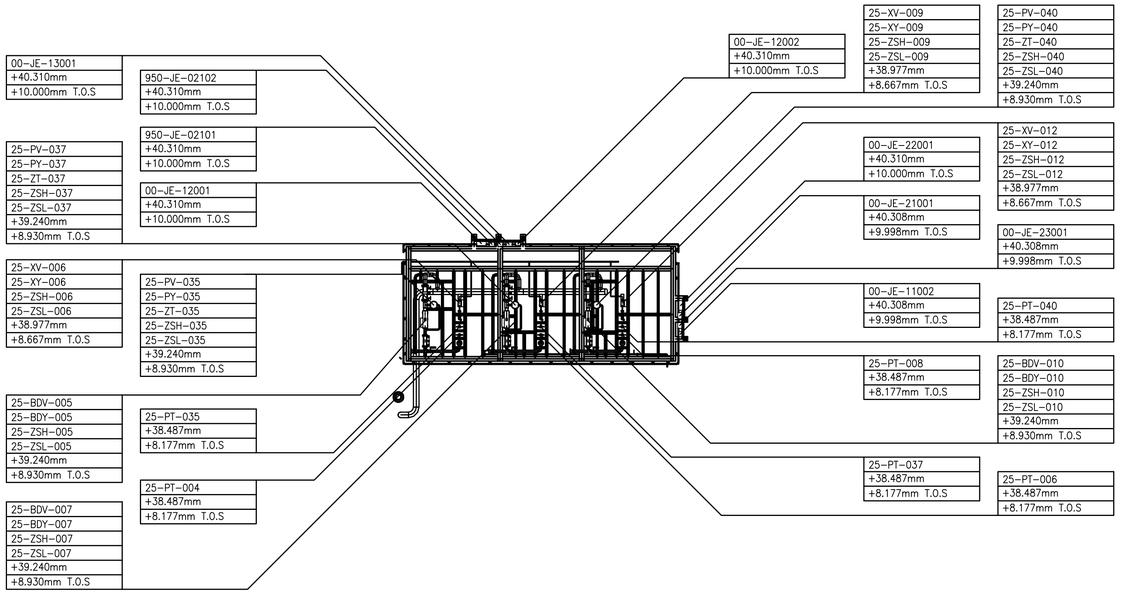

UPPER DECK

SCALE: 1:100

VIEW EL. 36500mm to 47060mm

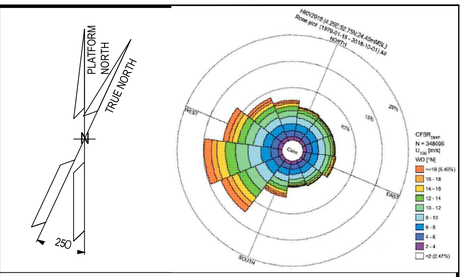

NOTES

1. ALL DIMENSIONS AND ELEVATIONS ARE GIVEN IN mm UNLESS OTHERWISE NOTED.
2. ELEVATIONS REFER TO T.O.S.
3. THIS DRAWING IS VALID ONLY FOR INSTRUMENT LOCATION LAYOUT.

LEGEND

- INSTRUMENT JUNCTION BOX
- ELECTRONIC INSTRUMENT
- CONTROL / ON-OFF VALVE

HOLDS

REFERENCE DOCUMENTS

123A90-DDL-PP-DL-70070	PLOT PLAN - LOWER & UPPER DECK
123A90-DDL-IN-DL-40080	INSTRUMENT LAYOUT - LOWER DECK
123A90-DDL-IN-LIS-40091	INSTRUMENT CABLE LIST
123A90-DDL-IN-DG-40015	INSTRUMENT-CCS WIRING DIAGRAMS
123A90-DDL-IN-DG-40016	INSTRUMENT-SAFETY SYSTEM WIRING DIAGRAMS
123A90-DDL-IN-DL-40083	INSTRUMENT MAIN CABLES ROUTING-LOWER DECK

INSERT SUBCONTRACTOR / VENDOR LOGO HERE

REV.	DATE	DRN	CHKD	APPD	DESCRIPTION
03	29/09/25	SPS	LCA	CGI	AS-BUILT (ASB)
02	04/10/24	VBA	LCA	DLO	ACCEPTED FOR CONSTRUCTION (AFC)
01	26/08/24	VBA	LCA	DLO	ACCEPT FOR CONSTRUCTION (AFC)
00	22/12/23	VBA	LCA	DLO	ISSUE FOR REVIEW (IFR)

CROSSWIND

ROSETTI MARINO

TITLE :
BASE LOAD POWER HUB (BLPH)
INSTRUMENT LOCATION LAYOUT-UPPER DECK
TOS EL. 30.310M

CONTRACT NO./TITLE CW-I-WP4-2023-05/HOLLANDSE KUST NOORD WIND PARK			SCALE 1:150
DRAWN SPS	CHECKED LCA	APPROVED CGI	DATE 29/09/25

A1	DRAWING NO. 123A90-DDL-IN-DL-40081	SHEET 003	REV. 03

File Name : 123A90-DDL-IN-DL-40081 REV:03.dwg