
DRAWING NO. 123A90-DDL-IN-DL-40083


REV. 03

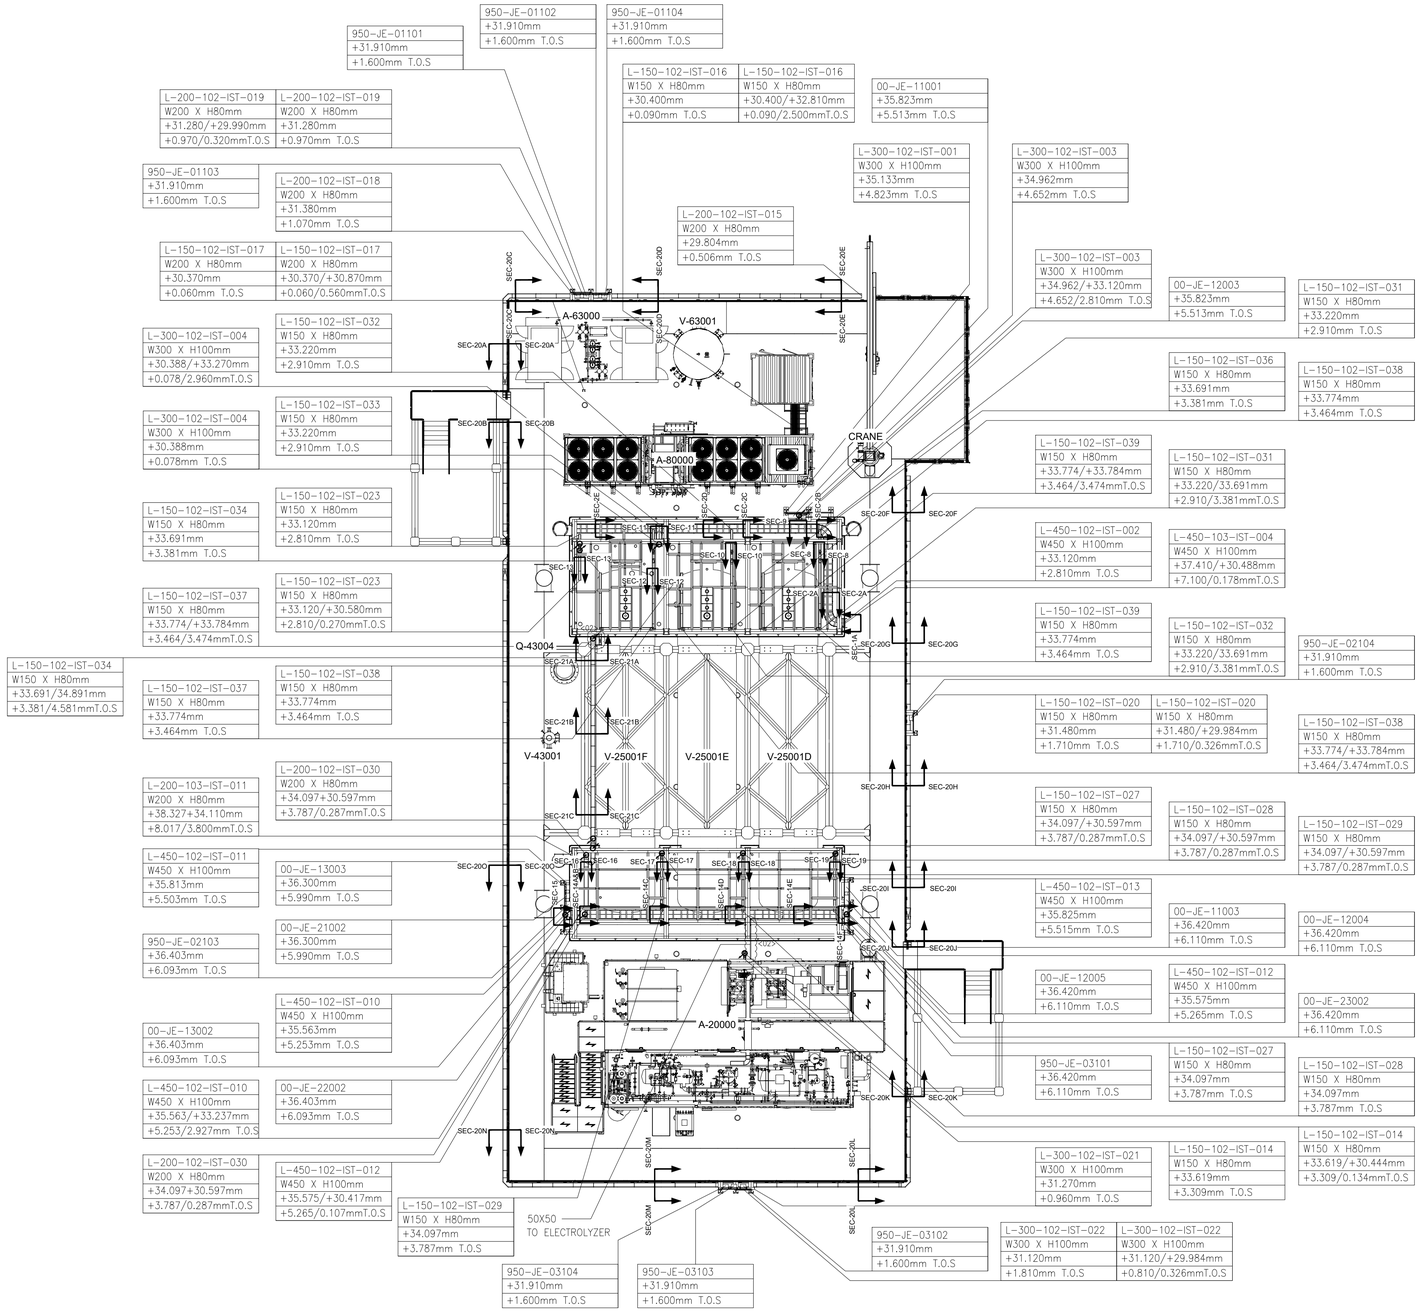

UPPER DECK

SCALE: 1:100

VIEW EL. 29310mm to 36500mm

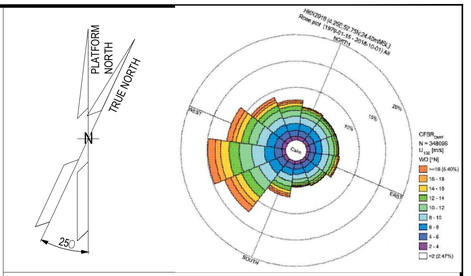

NOTES

1. ALL DIMENSIONS AND ELEVATIONS ARE GIVEN IN mm UNLESS OTHERWISE NOTED.
2. ELEVATIONS REFER TO T.O.S.
3. THIS DRAWING IS VALID ONLY FOR INSTRUMENT CABLE ROUTING LAYOUT.

LEGEND

- MAIN CABLE TRAY
- SECONDARY CABLE TRAY
- CABLE TRAY ELEVATION CHANGE
- INSTRUMENT CABLE TRAY VERTICAL RAISE
- INSTRUMENT CABLE TRAY VERTICAL DROP
- SEC-1A — CABLE TRAY SECTION
- TAG
- SIZE
- ELEVATION
- ELEVATION(T.O.S)

HOLDS

REFERENCE DOCUMENTS

123A90-DDL-PP-DL-70070	PLOT PLAN - LOWER & UPPER DECK
123A90-DDL-IN-DL-40080	INSTRUMENT LAYOUT - LOWER DECK
123A90-DDL-IN-DL-40081	INSTRUMENT LAYOUT - UPPER DECK
123A90-DDL-IN-LIS-40091	INSTRUMENT CABLE LIST
123A90-DDL-IN-DG-40015	INSTRUMENT-CCS WIRING DIAGRAMS
123A90-DDL-IN-DG-40016	INSTRUMENT-SAFETY SYSTEM WIRING DIAGRAMS
123A90-DDL-IN-DL-40082	INSTRUMENT MAIN CABLE ROUTING-LOWER DECK

INSERT SUBCONTRACTOR / VENDOR LOGO HERE

REV.	DATE	DRN	CHKD	APPD	DESCRIPTION
03	29/09/25	SPS	LCA	CGI	AS-BUILT (ASB)
02	04/10/24	VBA	LCA	DLO	ACCEPTED FOR CONSTRUCTION (AFC)
01	30/07/24	VBA	LCA	DLO	ACCEPTED FOR CONSTRUCTION (AFC)
00	22/12/23	VBA	LCA	DLO	ISSUE FOR REVIEW (IFR)

CROSSWIND

ROSETTI MARINO

TITLE :


BASE LOAD POWER HUB (BLPH)
INSTRUMENT MAIN CABLE ROUTING-UPPER DECK
TOS EL. 30.310M

CONTRACT NO./TITLE CW-1-WP4-2023-05/HOLLANDSE KUST NOORD WIND PARK			SCALE 1:150
DRAWN SPS	CHECKED LCA	APPROVED CGI	DATE 29/09/25
A1	DRAWING NO. 123A90-DDL-IN-DL-40083	SHEET 001	REV. 03

File Name : 123A90-DDL-IN-DL-40083 REV03.dwg

DRAWING NO. 123A90-DDL-IN-DL-40083


REV. 03

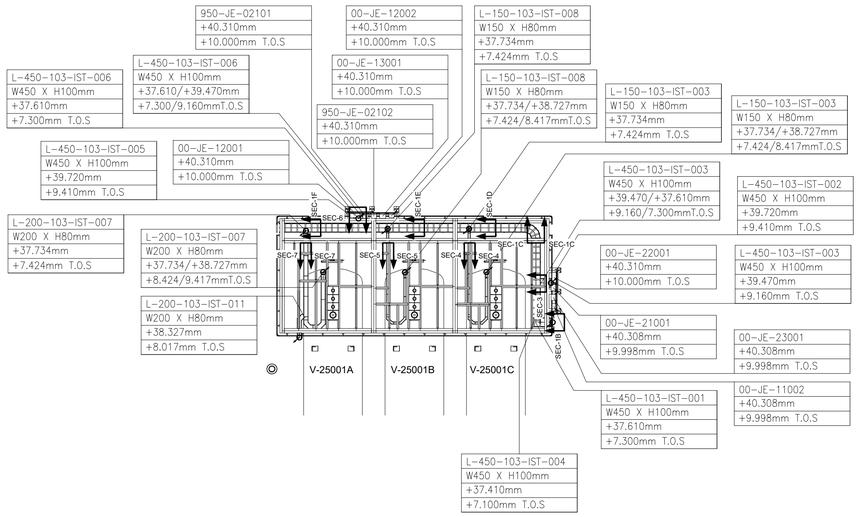

UPPER DECK

SCALE: 1:100

VIEW EL. 36500mm to 47106mm

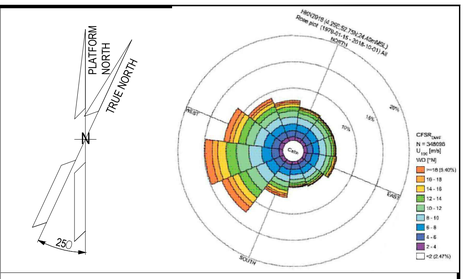

NOTES

1. ALL DIMENSIONS AND ELEVATIONS ARE GIVEN IN mm UNLESS OTHERWISE NOTED.
2. ELEVATIONS REFER TO T.O.S.
3. THIS DRAWING IS VALID ONLY FOR INSTRUMENT CABLE ROUTING LAYOUT.

LEGEND

- MAIN CABLE TRAY
- SECONDARY CABLE TRAY
- CABLE TRAY ELEVATION CHANGE
- INSTRUMENT CABLE TRAY VERTICAL RAISE
- INSTRUMENT CABLE TRAY VERTICAL DROP
- SEC-1A — CABLE TRAY SECTION
- TAG
- SIZE
- ELEVATION
- ELEVATION(T.O.S)

HOLDS

REFERENCE DOCUMENTS

123A90-DDL-PP-DL-70070	PLOT PLAN - LOWER & UPPER DECK
123A90-DDL-IN-DL-40080	INSTRUMENT LAYOUT - LOWER DECK
123A90-DDL-IN-DL-40081	INSTRUMENT LAYOUT - UPPER DECK
123A90-DDL-IN-LIS-40091	INSTRUMENT CABLE LIST
123A90-DDL-IN-DG-40015	INSTRUMENT-CCS WIRING DIAGRAMS
123A90-DDL-IN-DG-40016	INSTRUMENT-SAFETY SYSTEM WIRING DIAGRAMS
123A90-DDL-IN-DL-40082	INSTRUMENT MAIN CABLE ROUTING-LOWER DECK

INSERT SUBCONTRACTOR / VENDOR LOGO HERE

REV.	DATE	DRN	CHKD	APPD	DESCRIPTION
03	29/09/25	SPS	LCA	CGI	AS-BUILT (ASB)
02	04/10/24	VBA	LCA	DLO	ACCEPTED FOR CONSTRUCTION (AFC)
01	30/07/24	VBA	LCA	DLO	ACCEPTED FOR CONSTRUCTION (AFC)
00	22/12/23	VBA	LCA	DLO	ISSUE FOR REVIEW (IFR)

CROSSWIND

ROSETTI MARINO

TITLE :

BASE LOAD POWER HUB (BLPH)
INSTRUMENT MAIN CABLE ROUTING-UPPER DECK
TOS EL. 30.310M

CONTRACT NO./TITLE CW-I-WP4-2023-05/HOLLANDSE KUST NOORD WIND PARK			SCALE 1:150
DRAWN SPS	CHECKED LCA	APPROVED CGI	DATE 29/09/25


A1	DRAWING NO. 123A90-DDL-IN-DL-40083	SHEET 002	REV. 03

File Name : 123A90-DDL-IN-DL-40083 REV.03.dwg

DRAWING NO. 123A90-DDL-IN-DL-40083


REV. 03

U-SEC-1B-L-450-103-IST-004

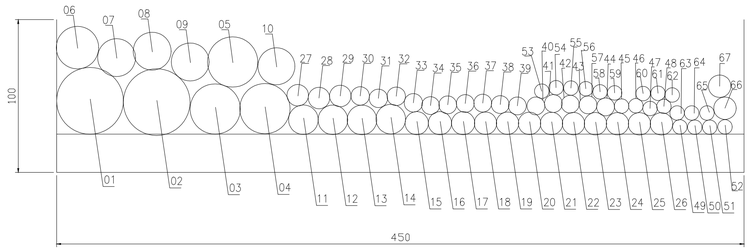


U-SEC-1B-L-450-103-IST-004				
POS	CABLENAME	FROM	TO	FORMATION
1	950-JE-02101/B400-FGS-002	950-JE-02101	B400-FGS-002	12x3x2.5mm2
2	950-JE-02102/B400-FGS-002	950-JE-02102	B400-FGS-002	12x3x2.5mm2
3	00-JE-21001/B400-SIS-001	00-JE-21001	B400-SIS-001	12x2x0.75mm2
4	00-JE-22001_1/B400-SIS-001	00-JE-22001_1	B400-SIS-001	12x2x0.75mm2
5	00-JE-22001_2/B400-SIS-001	00-JE-22001_2	B400-SIS-001	12x2x0.75mm2
6	00-JE-13001/B400-PCS-002	00-JE-13001	B400-PCS-002	24x2.5mm2
7	00-JE-11002/B400-PCS-002	00-JE-11002	B400-PCS-002	12x2x0.75mm2
8	00-JE-12001_1/B400-PCS-002	00-JE-12001_1	B400-PCS-002	12x2x0.75mm2
9	00-JE-12001_2/B400-PCS-002	00-JE-12001_2	B400-PCS-002	12x2x0.75mm2
10	00-JE-23001/B400-SIS-001	00-JE-23001	B400-SIS-001	12x2.5mm2
11	00-JE-12002/B400-PCS-002	00-JE-12002	B400-PCS-002	6x2x0.75mm2
12	C-25-BDV-013/00-JE-22001	25-BDV-013	00-JE-22001	2x2x0.75mm2
13	C-25-BDV-016/00-JE-22001	25-BDV-016	00-JE-22001	2x2x0.75mm2
14	C-25-BDV-019/00-JE-22001	25-BDV-019	00-JE-22001	2x2x0.75mm2
15	C-25-XV-015/00-JE-12001	25-XV-015	00-JE-12001	2x2x0.75mm2
16	C-25-XV-018/00-JE-12001	25-XV-018	00-JE-12001	2x2x0.75mm2
17	C-25-XV-021/00-JE-12001	25-XV-021	00-JE-12001	2x2x0.75mm2
18	C-950-FDZ-02101/950-JE-02101	950-FDZ-02101	950-JE-02101	3x2.5mm2
19	C-950-FDZ-02102/950-JE-02101	950-FDZ-02102	950-JE-02101	3x2.5mm2
20	C-950-FDZ-02103/950-JE-02101	950-FDZ-02103	950-JE-02101	3x2.5mm2
21	C-950-FDZ-02104/950-JE-02101	950-FDZ-02104	950-JE-02101	3x2.5mm2
22	C-950-GDZ-02101/950-JE-02101	950-GDZ-02101	950-JE-02101	3x2.5mm2
23	C-950-GDZ-02102/950-JE-02101	950-GDZ-02102	950-JE-02101	3x2.5mm2
24	C-950-GDZ-02103/950-JE-02101	950-GDZ-02103	950-JE-02101	3x2.5mm2
25	C-950-GDZ-02104/950-JE-02101	950-GDZ-02104	950-JE-02101	3x2.5mm2
26	C-950-GDZ-02106/950-JE-02101	950-GDZ-02106	950-JE-02101	3x2.5mm2
27	C-25-BDY-013/00-JE-23001	25-BDY-013	00-JE-23001	2x2.5mm2
28	C-25-BDY-016/00-JE-23001	25-BDY-016	00-JE-23001	2x2.5mm2
29	C-25-BDY-019/00-JE-23001	25-BDY-019	00-JE-23001	2x2.5mm2
30	C-25-XY-015/00-JE-13001	25-XY-015	00-JE-13001	2x2.5mm2
31	C-25-XY-018/00-JE-13001	25-XY-018	00-JE-13001	2x2.5mm2
32	C-25-XY-021/00-JE-13001	25-XY-021	00-JE-13001	2x2.5mm2
33	C-80-XY-001/00-JE-13001	80-XY-001	00-JE-13001	2x2.5mm2
34	C-25-PT-009/00-JE-21001	25-PT-009	00-JE-21001	1x2x0.75mm2
35	C-25-PT-011/00-JE-21001	25-PT-011	00-JE-21001	1x2x0.75mm2
36	C-25-PT-012/00-JE-21001	25-PT-012	00-JE-21001	1x2x0.75mm2
37	C-950-ASD-01101/00-JE-22001	950-ASD-01101	00-JE-22001	1x2x0.75mm2
38	C-950-MOB-01101/00-JE-22001	950-MOB-01101	00-JE-22001	1x2x0.75mm2
39	C-950-ESD-01101/00-JE-22001	950-ESD-01101	00-JE-22001	1x2x0.75mm2
40	C-950-ESDD-01101/00-JE-22001	950-ESDD-01101	00-JE-22001	1x2x0.75mm2
41	C-950-ASD-04101/00-JE-22001	950-ASD-04101	00-JE-22001	1x2x0.75mm2
42	C-950-MOB-04101/00-JE-22001	950-MOB-04101	00-JE-22001	1x2x0.75mm2
43	C-950-ESD-04101/00-JE-22001	950-ESD-04101	00-JE-22001	1x2x0.75mm2
44	C-950-ESDD-04101/00-JE-22001	950-ESDD-04101	00-JE-22001	1x2x0.75mm2
45	C-25-PT-035/00-JE-11001	25-PT-035	00-JE-11001	1x2x0.75mm2
46	C-25-PT-037/00-JE-11001	25-PT-037	00-JE-11001	1x2x0.75mm2
47	C-25-PT-040/00-JE-11001	25-PT-040	00-JE-11001	1x2x0.75mm2
48	C-25-PY-035/00-JE-11001	25-PY-035	00-JE-11001	1x2x0.75mm2
49	C-25-PY-037/00-JE-11001	25-PY-037	00-JE-11001	1x2x0.75mm2
50	C-25-PY-040/00-JE-11001	25-PY-040	00-JE-11001	1x2x0.75mm2
51	C-25-ZT-035/00-JE-11001	25-ZT-035	00-JE-11001	1x2x0.75mm2
52	C-25-ZT-037/00-JE-11001	25-ZT-037	00-JE-11001	1x2x0.75mm2
53	C-25-ZT-040/00-JE-11001	25-ZT-040	00-JE-11001	1x2x0.75mm2
54	C-25-PT-055A/00-JE-11002	25-PT-055A	00-JE-11002	1x2x0.75mm2
55	C-25-PT-055B/00-JE-11002	25-PT-055B	00-JE-11002	1x2x0.75mm2
56	C-25-PY-055A/00-JE-11002	25-PY-055A	00-JE-11002	1x2x0.75mm2
57	C-25-PY-055B/00-JE-11002	25-PY-055B	00-JE-11002	1x2x0.75mm2
58	C-25-ZT-055A/00-JE-11002	25-ZT-055A	00-JE-11002	1x2x0.75mm2
59	C-25-ZT-055B/00-JE-11002	25-ZT-055B	00-JE-11002	1x2x0.75mm2
60	C-25-ZSL-046/00-JE-12001	25-ZSL-046	00-JE-12001	1x2x0.75mm2
61	C-25-ZSH-046/00-JE-12001	25-ZSH-046	00-JE-12001	1x2x0.75mm2
62	C-25-ZSL-049/00-JE-12001	25-ZSL-049	00-JE-12001	1x2x0.75mm2
63	C-25-ZSH-049/00-JE-12001	25-ZSH-049	00-JE-12001	1x2x0.75mm2
64	C-25-ZSL-043/00-JE-12001	25-ZSL-043	00-JE-12001	1x2x0.75mm2
65	C-25-ZSH-043/00-JE-12001	25-ZSH-043	00-JE-12001	1x2x0.75mm2
66	C-950-GDZ-02108/950-JE-02102	950-GDZ-02108	950-JE-02102	3x2.5mm2
67	C-950-GDZ-02119/950-JE-02103	950-GDZ-02119	950-JE-02103	3x2.5mm2

U-SEC-1C-L-450-103-IST-001

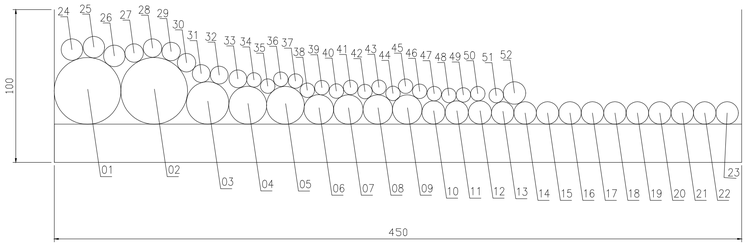

U-SEC-1C-L-450-103-IST-001				
POS	CABLENAME	FROM	TO	FORMATION
1	950-JE-02101/B400-FGS-002	950-JE-02101	B400-FGS-002	12x3x2.5mm2
2	950-JE-02102/B400-FGS-002	950-JE-02102	B400-FGS-002	12x3x2.5mm2
3	00-JE-13001/B400-PCS-002	00-JE-13001	B400-PCS-002	24x2.5mm2
4	00-JE-12001_1/B400-PCS-002	00-JE-12001_1	B400-PCS-002	12x2x0.75mm2
5	00-JE-12001_2/B400-PCS-002	00-JE-12001_2	B400-PCS-002	12x2x0.75mm2
6	00-JE-12002/B400-PCS-002	00-JE-12002	B400-PCS-002	6x2x0.75mm2
7	C-25-BDV-005/00-JE-22001	25-BDV-005	00-JE-22001	2x2x0.75mm2
8	C-25-BDV-007/00-JE-22001	25-BDV-007	00-JE-22001	2x2x0.75mm2
9	C-25-BDV-010/00-JE-22001	25-BDV-010	00-JE-22001	2x2x0.75mm2
10	C-25-XV-015/00-JE-12001	25-XV-015	00-JE-12001	2x2x0.75mm2
11	C-25-XV-018/00-JE-12001	25-XV-018	00-JE-12001	2x2x0.75mm2
12	C-25-XV-021/00-JE-12001	25-XV-021	00-JE-12001	2x2x0.75mm2
13	C-950-FDZ-02101/950-JE-02101	950-FDZ-02101	950-JE-02101	3x2.5mm2
14	C-950-FDZ-02102/950-JE-02101	950-FDZ-02102	950-JE-02101	3x2.5mm2
15	C-950-FDZ-02103/950-JE-02101	950-FDZ-02103	950-JE-02101	3x2.5mm2
16	C-950-FDZ-02104/950-JE-02101	950-FDZ-02104	950-JE-02101	3x2.5mm2
17	C-950-GDZ-02101/950-JE-02101	950-GDZ-02101	950-JE-02101	3x2.5mm2
18	C-950-GDZ-02102/950-JE-02101	950-GDZ-02102	950-JE-02101	3x2.5mm2
19	C-950-GDZ-02103/950-JE-02101	950-GDZ-02103	950-JE-02101	3x2.5mm2
20	C-950-GDZ-02104/950-JE-02101	950-GDZ-02104	950-JE-02101	3x2.5mm2
21	C-950-GDZ-02105/950-JE-02101	950-GDZ-02105	950-JE-02101	3x2.5mm2
22	C-950-GDZ-02106/950-JE-02101	950-GDZ-02106	950-JE-02101	3x2.5mm2
23	C-950-GDZ-02108/950-JE-02102	950-GDZ-02108	950-JE-02102	3x2.5mm2
24	C-25-BDY-005/00-JE-23001	25-BDY-005	00-JE-23001	2x2.5mm2
25	C-25-BDY-007/00-JE-23001	25-BDY-007	00-JE-23001	2x2.5mm2
26	C-25-BDY-010/00-JE-23001	25-BDY-010	00-JE-23001	2x2.5mm2
27	C-25-XY-015/00-JE-13001	25-XY-015	00-JE-13001	2x2.5mm2
28	C-25-XY-018/00-JE-13001	25-XY-018	00-JE-13001	2x2.5mm2
29	C-25-XY-021/00-JE-13001	25-XY-021	00-JE-13001	2x2.5mm2
30	C-80-XY-001/00-JE-13001	80-XY-001	00-JE-13001	2x2.5mm2
31	C-25-PT-004/00-JE-21001	25-PT-004	00-JE-21001	1x2x0.75mm2
32	C-25-PT-006/00-JE-21001	25-PT-006	00-JE-21001	1x2x0.75mm2
33	C-25-PT-008/00-JE-21001	25-PT-008	00-JE-21001	1x2x0.75mm2
34	C-25-PT-035/00-JE-11001	25-PT-035	00-JE-11001	1x2x0.75mm2
35	C-25-PT-037/00-JE-11001	25-PT-037	00-JE-11001	1x2x0.75mm2
36	C-25-PT-040/00-JE-11001	25-PT-040	00-JE-11001	1x2x0.75mm2
37	C-25-PY-035/00-JE-11001	25-PY-035	00-JE-11001	1x2x0.75mm2
38	C-25-PY-037/00-JE-11001	25-PY-037	00-JE-11001	1x2x0.75mm2
39	C-25-PY-040/00-JE-11001	25-PY-040	00-JE-11001	1x2x0.75mm2
40	C-25-ZT-035/00-JE-11001	25-ZT-035	00-JE-11001	1x2x0.75mm2
41	C-25-ZT-037/00-JE-11001	25-ZT-037	00-JE-11001	1x2x0.75mm2
42	C-25-ZT-040/00-JE-11001	25-ZT-040	00-JE-11001	1x2x0.75mm2
43	C-43-PT-001/00-JE-11002	43-PT-001	00-JE-11002	1x2x0.75mm2
44	C-43-LT-003/00-JE-11002	43-LT-001	00-JE-11002	1x2x0.75mm2
45	C-43-FT-001/00-JE-11002	43-FT-001	00-JE-11002	1x2x0.75mm2
46	C-25-ZSL-046/00-JE-12001	25-ZSL-046	00-JE-12001	1x2x0.75mm2
47	C-25-ZSH-046/00-JE-12001	25-ZSH-046	00-JE-12001	1x2x0.75mm2
48	C-25-ZSL-049/00-JE-12001	25-ZSL-049	00-JE-12001	1x2x0.75mm2
49	C-25-ZSH-049/00-JE-12001	25-ZSH-049	00-JE-12001	1x2x0.75mm2
50	C-25-ZSL-043/00-JE-12001	25-ZSL-043	00-JE-12001	1x2x0.75mm2
51	C-25-ZSH-043/00-JE-12001	25-ZSH-043	00-JE-12001	1x2x0.75mm2
52	C-950-GDZ-02119/950-JE-02103	950-GDZ-02119	950-JE-02103	3x2.5mm2

U-SEC-1A-L-450-103-IST-004

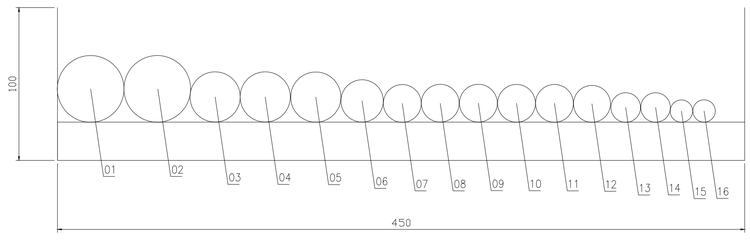

U-SEC-1A-L-450-103-IST-004				
POS	CABLENAME	FROM	TO	FORMATION
1	950-JE-02101/B400-FGS-002	950-JE-02101	B400-FGS-002	12x3x2.5mm2
2	950-JE-02102/B400-FGS-002	950-JE-02102	B400-FGS-002	12x3x2.5mm2
3	00-JE-21001/B400-SIS-001	00-JE-21001	B400-SIS-001	12x2x0.75mm2
4	00-JE-22001_1/B400-SIS-001	00-JE-22001_1	B400-SIS-001	12x2x0.75mm2
5	00-JE-22001_2/B400-SIS-001	00-JE-22001_2	B400-SIS-001	12x2x0.75mm2
6	00-JE-13001/B400-PCS-002	00-JE-13001	B400-PCS-002	24x2.5mm2
7	00-JE-11001_1/B400-PCS-002	00-JE-11001_1	B400-PCS-002	12x2x0.75mm2
8	00-JE-11001_2/B400-PCS-002	00-JE-11001_2	B400-PCS-002	12x2x0.75mm2
9	00-JE-11002/B400-PCS-002	00-JE-11002	B400-PCS-002	12x2x0.75mm2
10	00-JE-12001_1/B400-PCS-002	00-JE-12001_1	B400-PCS-002	12x2x0.75mm2
11	00-JE-12001_2/B400-PCS-002	00-JE-12001_2	B400-PCS-002	12x2x0.75mm2
12	00-JE-23001/B400-SIS-001	00-JE-23001	B400-SIS-001	12x2.5mm2
13	00-JE-12002/B400-PCS-002	00-JE-12002	B400-PCS-002	6x2x0.75mm2
14	00-JE-12003/B400-PCS-002	00-JE-12003	B400-PCS-002	6x2x0.75mm2
15	C-950-FDZ-02103/950-JE-02101	950-FDZ-02103	950-JE-02101	3x2.5mm2
16	C-950-FDZ-02104/950-JE-02101	950-FDZ-02104	950-JE-02101	3x2.5mm2

INSERT SUBCONTRACTOR / VENDOR LOGO HERE

REV.	DATE	DRN	CHKD	APPD	DESCRIPTION
03	29/09/25	SPS	LCA	CGI	AS-BUILT (ASB)
02	04/10/24	VBA	LCA	DLO	ACCEPTED FOR CONSTRUCTION (AFC)
01	30/07/24	VBA	LCA	DLO	ACCEPTED FOR CONSTRUCTION (AFC)
00	22/12/23	VBA	LCA	DLO	ISSUE FOR REVIEW (IFR)

CROSSWIND

ROSETTI MARINO

TITLE :
BASE LOAD POWER HUB (BLPH)
INSTRUMENT MAIN CABLE ROUTING-UPPER DECK
TOS EL. 30.310M


CONTRACT NO./TITLE CW-I-WP4-2023-05/HOLLANDSE KUST NOORD WIND PARK			SCALE 1:150
DRAWN SPS	CHECKED LCA	APPROVED CGI	DATE 29/09/25
A1	DRAWING NO. 123A90-DDL-IN-DL-40083	SHEET 003	REV. 03

File Name : 123A90-DDL-IN-DL-40083_REV03.dwg

DRAWING NO. 123A90-DDL-IN-DL-40083


REV. 03

U-SEC-1E-L-450-103-IST-001

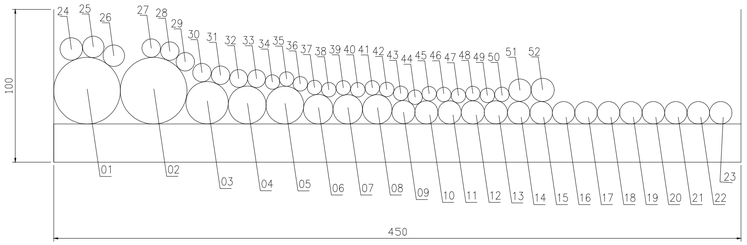


U-SEC-1E-L-450-103-IST-001				
POS	CABLENAME	FROM	TO	FORMATION
1	950-JE-02101/B400-FGS-002	950-JE-02101	B400-FGS-002	12x3x2.5mm2
2	950-JE-02102/B400-FGS-002	950-JE-02102	B400-FGS-002	12x3x2.5mm2
3	00-JE-13001/B400-PCS-002	00-JE-13001	B400-PCS-002	24x2.5mm2
4	00-JE-12001_1/B400-PCS-002	00-JE-12001_1	B400-PCS-002	12x2x0.75mm2
5	00-JE-12001_2/B400-PCS-002	00-JE-12001_2	B400-PCS-002	12x2x0.75mm2
6	00-JE-12002/B400-PCS-002	00-JE-12002	B400-PCS-002	6x2x0.75mm2
7	C-25-BDV-005/00-JE-22001	25-BDV-005	00-JE-22001	2x2x0.75mm2
8	C-25-BDV-007/00-JE-22001	25-BDV-007	00-JE-22001	2x2x0.75mm2
9	C-25-XV-012/00-JE-12001	25-XV-012	00-JE-12001	2x2x0.75mm2
10	C-25-XV-015/00-JE-12001	25-XV-015	00-JE-12001	2x2x0.75mm2
11	C-25-XV-018/00-JE-12001	25-XV-018	00-JE-12001	2x2x0.75mm2
12	C-25-XV-021/00-JE-12001	25-XV-021	00-JE-12001	2x2x0.75mm2
13	C-950-FDZ-02101/950-JE-02101	950-FDZ-02101	950-JE-02101	3x2.5mm2
14	C-950-FDZ-02102/950-JE-02101	950-FDZ-02102	950-JE-02101	3x2.5mm2
15	C-950-FDZ-02103/950-JE-02101	950-FDZ-02103	950-JE-02101	3x2.5mm2
16	C-950-FDZ-02104/950-JE-02101	950-FDZ-02104	950-JE-02101	3x2.5mm2
17	C-950-GDZ-02101/950-JE-02101	950-GDZ-02101	950-JE-02101	3x2.5mm2
18	C-950-GDZ-02102/950-JE-02101	950-GDZ-02102	950-JE-02101	3x2.5mm2
19	C-950-GDZ-02103/950-JE-02101	950-GDZ-02103	950-JE-02101	3x2.5mm2
20	C-950-GDZ-02104/950-JE-02101	950-GDZ-02104	950-JE-02101	3x2.5mm2
21	C-950-GDZ-02105/950-JE-02101	950-GDZ-02105	950-JE-02101	3x2.5mm2
22	C-950-GDZ-02106/950-JE-02101	950-GDZ-02106	950-JE-02101	3x2.5mm2
23	C-950-GDZ-02108/950-JE-02102	950-GDZ-02108	950-JE-02102	3x2.5mm2
24	C-25-BDY-005/00-JE-23001	25-BDY-005	00-JE-23001	2x2.5mm2
25	C-25-BDY-007/00-JE-23001	25-BDY-007	00-JE-23001	2x2.5mm2
26	C-25-XY-009/00-JE-13001	25-XY-009	00-JE-13001	2x2.5mm2
27	C-25-XY-012/00-JE-13001	25-XY-012	00-JE-13001	2x2.5mm2
28	C-25-XY-015/00-JE-13001	25-XY-015	00-JE-13001	2x2.5mm2
29	C-25-XY-018/00-JE-13001	25-XY-018	00-JE-13001	2x2.5mm2
30	C-25-XY-021/00-JE-13001	25-XY-021	00-JE-13001	2x2.5mm2
31	C-80-XY-001/00-JE-13001	80-XY-001	00-JE-13001	2x2.5mm2
32	C-25-PT-004/00-JE-21001	25-PT-004	00-JE-21001	1x2x0.75mm2
33	C-25-PT-006/00-JE-21001	25-PT-006	00-JE-21001	1x2x0.75mm2
34	C-25-PT-035/00-JE-11001	25-PT-035	00-JE-11001	1x2x0.75mm2
35	C-25-PT-037/00-JE-11001	25-PT-037	00-JE-11001	1x2x0.75mm2
36	C-25-PY-035/00-JE-11001	25-PY-035	00-JE-11001	1x2x0.75mm2
37	C-25-PY-037/00-JE-11001	25-PY-037	00-JE-11001	1x2x0.75mm2
38	C-25-ZT-035/00-JE-11001	25-ZT-035	00-JE-11001	1x2x0.75mm2
39	C-25-ZT-037/00-JE-11001	25-ZT-037	00-JE-11001	1x2x0.75mm2
40	C-43-PT-001/00-JE-11002	43-PT-001	00-JE-11002	1x2x0.75mm2
41	C-43-FT-001/00-JE-11002	43-FT-001	00-JE-11002	1x2x0.75mm2
42	C-43-LT-003/00-JE-11002	43-LT-003	00-JE-11002	1x2x0.75mm2
43	C-25-ZSL-046/00-JE-12001	25-ZSL-046	00-JE-12001	1x2x0.75mm2
44	C-25-ZSH-046/00-JE-12001	25-ZSH-046	00-JE-12001	1x2x0.75mm2
45	C-25-ZSL-049/00-JE-12001	25-ZSL-049	00-JE-12001	1x2x0.75mm2
46	C-25-ZSH-049/00-JE-12001	25-ZSH-049	00-JE-12001	1x2x0.75mm2
47	C-25-ZSL-040/00-JE-12001	25-ZSL-040	00-JE-12001	1x2x0.75mm2
48	C-25-ZSH-040/00-JE-12001	25-ZSH-040	00-JE-12001	1x2x0.75mm2
49	C-25-ZSL-043/00-JE-12001	25-ZSL-043	00-JE-12001	1x2x0.75mm2
50	C-25-ZSH-043/00-JE-12001	25-ZSH-043	00-JE-12001	1x2x0.75mm2
51	C-950-GDZ-02119/950-JE-02103	950-GDZ-02119	950-JE-02103	3x2.5mm2
52	C-25-XV-009/00-JE-12001	25-XV-009	00-JE-12001	2x2x0.75mm2

U-SEC-1D-L-450-103-IST-001

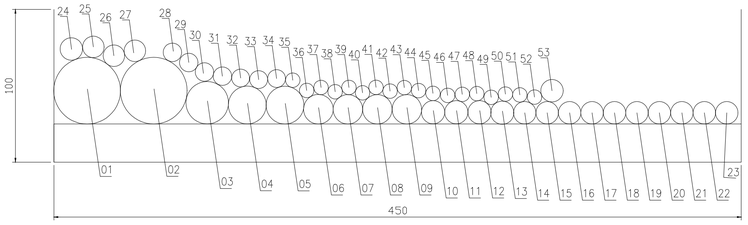

U-SEC-1D-L-450-103-IST-001				
POS	CABLENAME	FROM	TO	FORMATION
1	950-JE-02101/B400-FGS-002	950-JE-02101	B400-FGS-002	12x3x2.5mm2
2	950-JE-02102/B400-FGS-002	950-JE-02102	B400-FGS-002	12x3x2.5mm2
3	00-JE-13001/B400-PCS-002	00-JE-13001	B400-PCS-002	24x2.5mm2
4	00-JE-12001_1/B400-PCS-002	00-JE-12001_1	B400-PCS-002	12x2x0.75mm2
5	00-JE-12001_2/B400-PCS-002	00-JE-12001_2	B400-PCS-002	12x2x0.75mm2
6	00-JE-12002/B400-PCS-002	00-JE-12002	B400-PCS-002	6x2x0.75mm2
7	C-25-BDV-005/00-JE-22001	25-BDV-005	00-JE-22001	2x2x0.75mm2
8	C-25-BDV-007/00-JE-22001	25-BDV-007	00-JE-22001	2x2x0.75mm2
9	C-25-BDV-010/00-JE-22001	25-BDV-010	00-JE-22001	2x2x0.75mm2
10	C-25-XV-012/00-JE-12001	25-XV-012	00-JE-12001	2x2x0.75mm2
11	C-25-XV-015/00-JE-12001	25-XV-015	00-JE-12001	2x2x0.75mm2
12	C-25-XV-018/00-JE-12001	25-XV-018	00-JE-12001	2x2x0.75mm2
13	C-25-XV-021/00-JE-12001	25-XV-021	00-JE-12001	2x2x0.75mm2
14	C-950-FDZ-02101/950-JE-02101	950-FDZ-02101	950-JE-02101	3x2.5mm2
15	C-950-FDZ-02102/950-JE-02101	950-FDZ-02102	950-JE-02101	3x2.5mm2
16	C-950-FDZ-02103/950-JE-02101	950-FDZ-02103	950-JE-02101	3x2.5mm2
17	C-950-FDZ-02104/950-JE-02101	950-FDZ-02104	950-JE-02101	3x2.5mm2
18	C-950-GDZ-02101/950-JE-02101	950-GDZ-02101	950-JE-02101	3x2.5mm2
19	C-950-GDZ-02102/950-JE-02101	950-GDZ-02102	950-JE-02101	3x2.5mm2
20	C-950-GDZ-02103/950-JE-02101	950-GDZ-02103	950-JE-02101	3x2.5mm2
21	C-950-GDZ-02104/950-JE-02101	950-GDZ-02104	950-JE-02101	3x2.5mm2
22	C-950-GDZ-02105/950-JE-02101	950-GDZ-02105	950-JE-02101	3x2.5mm2
23	C-950-GDZ-02106/950-JE-02101	950-GDZ-02106	950-JE-02101	3x2.5mm2
24	C-950-GDZ-02108/950-JE-02102	950-GDZ-02108	950-JE-02102	3x2.5mm2
25	C-25-BDY-005/00-JE-23001	25-BDY-005	00-JE-23001	2x2.5mm2
26	C-25-BDY-007/00-JE-23001	25-BDY-007	00-JE-23001	2x2.5mm2
27	C-25-BDY-010/00-JE-23001	25-BDY-010	00-JE-23001	2x2.5mm2
28	C-25-XY-015/00-JE-13001	25-XY-015	00-JE-13001	2x2.5mm2
29	C-25-XY-018/00-JE-13001	25-XY-018	00-JE-13001	2x2.5mm2
30	C-25-XY-021/00-JE-13001	25-XY-021	00-JE-13001	2x2.5mm2
31	C-80-XY-001/00-JE-13001	80-XY-001	00-JE-13001	2x2.5mm2
32	C-25-PT-004/00-JE-21001	25-PT-004	00-JE-21001	1x2x0.75mm2
33	C-25-PT-006/00-JE-21001	25-PT-006	00-JE-21001	1x2x0.75mm2
34	C-25-PT-008/00-JE-21001	25-PT-008	00-JE-21001	1x2x0.75mm2
35	C-25-PT-035/00-JE-11001	25-PT-035	00-JE-11001	1x2x0.75mm2
36	C-25-PT-037/00-JE-11001	25-PT-037	00-JE-11001	1x2x0.75mm2
37	C-25-PT-040/00-JE-11001	25-PT-040	00-JE-11001	1x2x0.75mm2
38	C-25-PY-035/00-JE-11001	25-PY-035	00-JE-11001	1x2x0.75mm2
39	C-25-PY-037/00-JE-11001	25-PY-037	00-JE-11001	1x2x0.75mm2
40	C-25-PY-040/00-JE-11001	25-PY-040	00-JE-11001	1x2x0.75mm2
41	C-25-ZT-035/00-JE-11001	25-ZT-035	00-JE-11001	1x2x0.75mm2
42	C-25-ZT-037/00-JE-11001	25-ZT-037	00-JE-11001	1x2x0.75mm2
43	C-25-ZT-040/00-JE-11001	25-ZT-040	00-JE-11001	1x2x0.75mm2
44	C-43-PT-001/00-JE-11002	43-PT-001	00-JE-11002	1x2x0.75mm2
45	C-43-FT-001/00-JE-11002	43-FT-001	00-JE-11002	1x2x0.75mm2
46	C-43-LT-003/00-JE-11002	43-LT-003	00-JE-11002	1x2x0.75mm2
47	C-25-ZSL-046/00-JE-12001	25-ZSL-046	00-JE-12001	1x2x0.75mm2
48	C-25-ZSH-046/00-JE-12001	25-ZSH-046	00-JE-12001	1x2x0.75mm2
49	C-25-ZSL-049/00-JE-12001	25-ZSL-049	00-JE-12001	1x2x0.75mm2
50	C-25-ZSH-049/00-JE-12001	25-ZSH-049	00-JE-12001	1x2x0.75mm2
51	C-25-ZSL-043/00-JE-12001	25-ZSL-043	00-JE-12001	1x2x0.75mm2
52	C-25-ZSH-043/00-JE-12001	25-ZSH-043	00-JE-12001	1x2x0.75mm2
53	C-950-GDZ-02119/950-JE-02103	950-GDZ-02119	950-JE-02103	3x2.5mm2

U-SEC-1F-L-450-103-IST-001

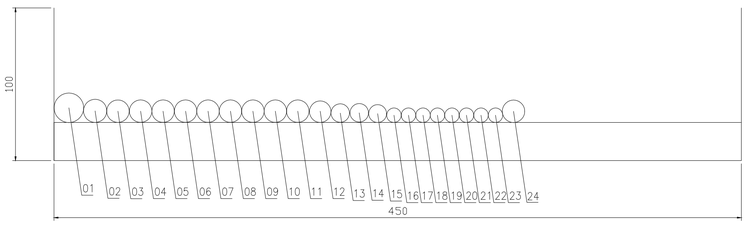

U-SEC-1F-L-450-103-IST-001				
POS	CABLENAME	FROM	TO	FORMATION
1	C-25-BDV-005/00-JE-22001	C-25-BDV-005	00-JE-22001	2x2x0.75mm2
2	C-25-XV-006/00-JE-12001	C-25-XV-006	00-JE-12001	2x2x0.75mm2
3	C-950-GDZ-02107/950-JE-02102	C-950-GDZ-02107	950-JE-02102	3x2.5mm2
4	C-950-GDZ-02109/950-JE-02102	C-950-GDZ-02109	950-JE-02102	3x2.5mm2
5	C-950-GDZ-02110/950-JE-02102	C-950-GDZ-02110	950-JE-02102	3x2.5mm2
6	C-950-GDZ-02111/950-JE-02102	C-950-GDZ-02111	950-JE-02102	3x2.5mm2
7	C-950-GDZ-02112/950-JE-02102	C-950-GDZ-02112	950-JE-02102	3x2.5mm2
8	C-950-GDZ-02113/950-JE-02102	C-950-GDZ-02113	950-JE-02102	3x2.5mm2
9	C-950-GDZ-02114/950-JE-02102	C-950-GDZ-02114	950-JE-02102	3x2.5mm2
10	C-950-GDZ-02115/950-JE-02102	C-950-GDZ-02115	950-JE-02102	3x2.5mm2
11	C-950-GDZ-02116/950-JE-02102	C-950-GDZ-02116	950-JE-02102	3x2.5mm2
12	C-25-BDY-005/00-JE-23001	C-25-BDY-005	00-JE-23001	2x2.5mm2
13	C-25-XY-006/00-JE-13001	C-25-XY-006	00-JE-13001	2x2.5mm2
14	PD-43-FT-001/00-JE-13001	PD-43-FT-001	00-JE-13001	2x2.5mm2
15	C-25-PT-004/00-JE-21001	C-25-PT-004	00-JE-21001	1x2x0.75mm2
16	C-25-PT-035/00-JE-11001	C-25-PT-035	00-JE-11001	1x2x0.75mm2
17	C-25-PY-035/00-JE-11001	C-25-PY-035	00-JE-11001	1x2x0.75mm2
18	C-25-ZT-035/00-JE-11001	C-25-ZT-035	00-JE-11001	1x2x0.75mm2
19	C-43-PT-001/00-JE-11002	C-43-PT-001	00-JE-11002	1x2x0.75mm2
20	C-43-FT-001/00-JE-11002	C-43-FT-001	00-JE-11002	1x2x0.75mm2
21	C-43-LT-003/00-JE-11002	C-43-LT-003	00-JE-11002	1x2x0.75mm2
22	C-25-ZSL-035/00-JE-12002	C-25-ZSL-035	00-JE-12002	1x2x0.75mm2
23	C-25-ZSH-035/00-JE-12002	C-25-ZSH-035	00-JE-12002	1x2x0.75mm2
24	C-950-GDZ-02119/950-JE-02103	950-GDZ-02119	950-JE-02103	3x2.5mm2

INSERT SUBCONTRACTOR / VENDOR LOGO HERE

REV.	DATE	DRN	CHKD	APPD	DESCRIPTION
03	29/09/25	SPS	LCA	CGI	AS-BUILT (ASB)
02	04/10/24	VBA	LCA	DLO	ACCEPTED FOR CONSTRUCTION (AFC)
01	30/07/24	VBA	LCA	DLO	ACCEPTED FOR CONSTRUCTION (AFC)
00	22/12/23	VBA	LCA	DLO	ISSUE FOR REVIEW (IFR)

CROSSWIND

ROSETTI MARINO

TITLE :
BASE LOAD POWER HUB (BLPH)
INSTRUMENT MAIN CABLE ROUTING-UPPER DECK
TOS EL. 30.310M

CONTRACT NO./TITLE CW-I-WP4-2023-05/HOLLANDSE KUST NOORD WIND PARK | SCALE 1:150

DRAWN SPS | CHECKED LCA | APPROVED CGI | DATE 29/09/25


A1 | DRAWING NO. 123A90-DDL-IN-DL-40083 | SHEET 004 | REV. 03

File Name : 123A90-DDL-IN-DL-40083 REV03.dwg

DRAWING NO. 123A90-DDL-IN-DL-40083


REV. 03

U-SEC-2A-L-450-102-IST-002

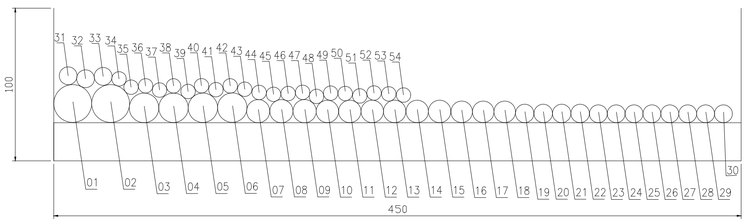


U-SEC-2A-L-450-102-IST-002				
POS	CABLENAME	FROM	TO	FORMATION
1	00-JE-11001_1/B400-PCS-002	00-JE-11001_1	B400-PCS-002	12x2x0.75mm2
2	00-JE-11001_2/B400-PCS-002	00-JE-11001_2	B400-PCS-002	12x2x0.75mm2
3	00-JE-12003/B400-PCS-002	00-JE-12003	B400-PCS-002	6x2x0.75mm2
4	C-25-BDV-013/00-JE-22001	25-BDV-013	00-JE-22001	2x2x0.75mm2
5	C-25-BDV-016/00-JE-22001	25-BDV-016	00-JE-22001	2x2x0.75mm2
6	C-25-BDV-019/00-JE-22001	25-BDV-019	00-JE-22001	2x2x0.75mm2
7	C-25-XV-015/00-JE-12001	25-XV-015	00-JE-12001	2x2x0.75mm2
8	C-25-XV-018/00-JE-12001	25-XV-018	00-JE-12001	2x2x0.75mm2
9	C-25-XV-021/00-JE-12001	25-XV-021	00-JE-12001	2x2x0.75mm2
10	C-950-FDZ-02101/950-JE-02101	950-FDZ-02101	950-JE-02101	3x2.5mm2
11	C-950-FDZ-02102/950-JE-02101	950-FDZ-02102	950-JE-02101	3x2.5mm2
12	C-950-GDZ-02101/950-JE-02101	950-GDZ-02101	950-JE-02101	3x2.5mm2
13	C-950-GDZ-02102/950-JE-02101	950-GDZ-02102	950-JE-02101	3x2.5mm2
14	C-950-GDZ-02103/950-JE-02101	950-GDZ-02103	950-JE-02101	3x2.5mm2
15	C-950-GDZ-02104/950-JE-02101	950-GDZ-02104	950-JE-02101	3x2.5mm2
16	C-25-BDY-013/00-JE-23001	25-BDY-013	00-JE-23001	2x2.5mm2
17	C-25-BDY-016/00-JE-23001	25-BDY-016	00-JE-23001	2x2.5mm2
18	C-25-BDY-019/00-JE-23001	25-BDY-019	00-JE-23001	2x2.5mm2
19	C-25-XY-015/00-JE-13001	25-XY-015	00-JE-13001	2x2.5mm2
20	C-25-XY-018/00-JE-13001	25-XY-018	00-JE-13001	2x2.5mm2
21	C-25-XY-021/00-JE-13001	25-XY-021	00-JE-13001	2x2.5mm2
22	C-80-XY-001/00-JE-13001	80-XY-001	00-JE-13001	2x2.5mm2
23	C-25-PT-009/00-JE-21001	25-PT-009	00-JE-21001	1x2x0.75mm2
24	C-25-PT-011/00-JE-21001	25-PT-011	00-JE-21001	1x2x0.75mm2
25	C-25-PT-012/00-JE-21001	25-PT-012	00-JE-21001	1x2x0.75mm2
26	C-950-ASD-01101/00-JE-22001	950-ASD-01101	00-JE-22001	1x2x0.75mm2
27	C-950-MOB-01101/00-JE-22001	950-MOB-01101	00-JE-22001	1x2x0.75mm2
28	C-950-ESD-01101/00-JE-22001	950-ESD-01101	00-JE-22001	1x2x0.75mm2
29	C-950-ESDD-01101/00-JE-22001	950-ESDD-01101	00-JE-22001	1x2x0.75mm2
30	C-950-ASD-04101/00-JE-22001	950-ASD-04101	00-JE-22001	1x2x0.75mm2
31	C-950-MOB-04101/00-JE-22001	950-MOB-04101	00-JE-22001	1x2x0.75mm2
32	C-950-ESD-04101/00-JE-22001	950-ESD-04101	00-JE-22001	1x2x0.75mm2
33	C-950-ESDD-04101/00-JE-22001	950-ESDD-04101	00-JE-22001	1x2x0.75mm2
34	C-25-PT-035/00-JE-11001	25-PT-035	00-JE-11001	1x2x0.75mm2
35	C-25-PT-037/00-JE-11001	25-PT-037	00-JE-11001	1x2x0.75mm2
36	C-25-PT-040/00-JE-11001	25-PT-040	00-JE-11001	1x2x0.75mm2
37	C-25-PY-035/00-JE-11001	25-PY-035	00-JE-11001	1x2x0.75mm2
38	C-25-PY-037/00-JE-11001	25-PY-037	00-JE-11001	1x2x0.75mm2
39	C-25-PY-040/00-JE-11001	25-PY-040	00-JE-11001	1x2x0.75mm2
40	C-25-ZT-035/00-JE-11001	25-ZT-035	00-JE-11001	1x2x0.75mm2
41	C-25-ZT-037/00-JE-11001	25-ZT-037	00-JE-11001	1x2x0.75mm2
42	C-25-ZT-040/00-JE-11001	25-ZT-040	00-JE-11001	1x2x0.75mm2
43	C-25-PT-055A/00-JE-11002	25-PT-055A	00-JE-11002	1x2x0.75mm2
44	C-25-PT-055B/00-JE-11002	25-PT-055B	00-JE-11002	1x2x0.75mm2
45	C-25-PY-055A/00-JE-11002	25-PY-055A	00-JE-11002	1x2x0.75mm2
46	C-25-PY-055B/00-JE-11002	25-PY-055B	00-JE-11002	1x2x0.75mm2
47	C-25-ZT-055A/00-JE-11002	25-ZT-055A	00-JE-11002	1x2x0.75mm2
48	C-25-ZT-055B/00-JE-11002	25-ZT-055B	00-JE-11002	1x2x0.75mm2
49	C-25-ZSL-046/00-JE-12001	25-ZSL-046	00-JE-12001	1x2x0.75mm2
50	C-25-ZSH-046/00-JE-12001	25-ZSH-046	00-JE-12001	1x2x0.75mm2
51	C-25-ZSL-049/00-JE-12001	25-ZSL-049	00-JE-12001	1x2x0.75mm2
52	C-25-ZSH-049/00-JE-12001	25-ZSH-049	00-JE-12001	1x2x0.75mm2
53	C-25-ZSL-043/00-JE-12001	25-ZSL-043	00-JE-12001	1x2x0.75mm2
54	C-25-ZSH-043/00-JE-12001	25-ZSH-043	00-JE-12001	1x2x0.75mm2

U-SEC-2B-L-450-102-IST-002

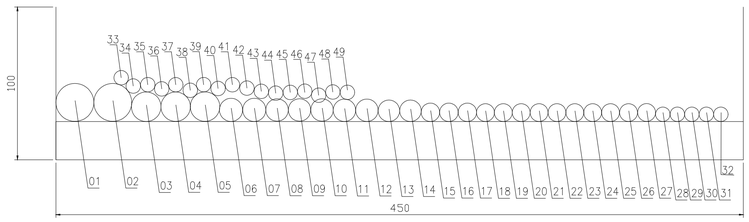

U-SEC-2B-L-450-102-IST-002				
POS	CABLENAME	FROM	TO	FORMATION
1	00-JE-11001_1/B400-PCS-002	00-JE-11001_1	B400-PCS-002	12x2x0.75mm2
2	00-JE-11001_2/B400-PCS-002	00-JE-11001_2	B400-PCS-002	12x2x0.75mm2
3	00-JE-12003/B400-PCS-002	00-JE-12003	B400-PCS-002	6x2x0.75mm2
4	C-25-BDV-016/00-JE-22001	25-BDV-016	00-JE-22001	2x2x0.75mm2
5	C-25-BDV-019/00-JE-22001	25-BDV-019	00-JE-22001	2x2x0.75mm2
6	C-25-XV-018/00-JE-12001	25-XV-018	00-JE-12001	2x2x0.75mm2
7	C-25-XV-021/00-JE-12001	25-XV-021	00-JE-12001	2x2x0.75mm2
8	C-950-FDZ-02101/950-JE-02101	950-FDZ-02101	950-JE-02101	3x2.5mm2
9	C-950-FDZ-02102/950-JE-02101	950-FDZ-02102	950-JE-02101	3x2.5mm2
10	C-950-GDZ-02101/950-JE-02101	950-GDZ-02101	950-JE-02101	3x2.5mm2
11	C-950-GDZ-02102/950-JE-02101	950-GDZ-02102	950-JE-02101	3x2.5mm2
12	C-950-GDZ-02103/950-JE-02101	950-GDZ-02103	950-JE-02101	3x2.5mm2
13	C-25-BDY-016/00-JE-23001	25-BDY-016	00-JE-23001	2x2.5mm2
14	C-25-BDY-019/00-JE-23001	25-BDY-019	00-JE-23001	2x2.5mm2
15	C-25-XY-018/00-JE-13001	25-XY-018	00-JE-13001	2x2.5mm2
16	C-25-XY-021/00-JE-13001	25-XY-021	00-JE-13001	2x2.5mm2
17	C-80-XY-001/00-JE-13001	80-XY-001	00-JE-13001	2x2.5mm2
18	C-25-PT-011/00-JE-21001	25-PT-011	00-JE-21001	1x2x0.75mm2
19	C-25-PT-012/00-JE-21001	25-PT-012	00-JE-21001	1x2x0.75mm2
20	C-950-ASD-01101/00-JE-22001	950-ASD-01101	00-JE-22001	1x2x0.75mm2
21	C-950-MOB-01101/00-JE-22001	950-MOB-01101	00-JE-22001	1x2x0.75mm2
22	C-950-ESD-01101/00-JE-22001	950-ESD-01101	00-JE-22001	1x2x0.75mm2
23	C-950-ESDD-01101/00-JE-22001	950-ESDD-01101	00-JE-22001	1x2x0.75mm2
24	C-950-ASD-04101/00-JE-22001	950-ASD-04101	00-JE-22001	1x2x0.75mm2
25	C-950-MOB-04101/00-JE-22001	950-MOB-04101	00-JE-22001	1x2x0.75mm2
26	C-950-ESD-04101/00-JE-22001	950-ESD-04101	00-JE-22001	1x2x0.75mm2
27	C-950-ESDD-04101/00-JE-22001	950-ESDD-04101	00-JE-22001	1x2x0.75mm2
28	C-25-PT-035/00-JE-11001	25-PT-035	00-JE-11001	1x2x0.75mm2
29	C-25-PT-037/00-JE-11001	25-PT-037	00-JE-11001	1x2x0.75mm2
30	C-25-PT-040/00-JE-11001	25-PT-040	00-JE-11001	1x2x0.75mm2
31	C-25-PT-043/00-JE-11001	25-PT-043	00-JE-11001	1x2x0.75mm2
32	C-25-PY-035/00-JE-11001	25-PY-035	00-JE-11001	1x2x0.75mm2
33	C-25-PY-037/00-JE-11001	25-PY-037	00-JE-11001	1x2x0.75mm2
34	C-25-PY-040/00-JE-11001	25-PY-040	00-JE-11001	1x2x0.75mm2
35	C-25-PY-043/00-JE-11001	25-PY-043	00-JE-11001	1x2x0.75mm2
36	C-25-ZT-035/00-JE-11001	25-ZT-035	00-JE-11001	1x2x0.75mm2
37	C-25-ZT-037/00-JE-11001	25-ZT-037	00-JE-11001	1x2x0.75mm2
38	C-25-ZT-040/00-JE-11001	25-ZT-040	00-JE-11001	1x2x0.75mm2
39	C-25-ZT-043/00-JE-11001	25-ZT-043	00-JE-11001	1x2x0.75mm2
40	C-25-PT-055A/00-JE-11002	25-PT-055A	00-JE-11002	1x2x0.75mm2
41	C-25-PT-055B/00-JE-11002	25-PT-055B	00-JE-11002	1x2x0.75mm2
42	C-25-PY-055A/00-JE-11002	25-PY-055A	00-JE-11002	1x2x0.75mm2
43	C-25-PY-055B/00-JE-11002	25-PY-055B	00-JE-11002	1x2x0.75mm2
44	C-25-ZT-055A/00-JE-11002	25-ZT-055A	00-JE-11002	1x2x0.75mm2
45	C-25-ZT-055B/00-JE-11002	25-ZT-055B	00-JE-11002	1x2x0.75mm2
46	C-25-ZSL-046/00-JE-12001	25-ZSL-046	00-JE-12001	1x2x0.75mm2
47	C-25-ZSH-046/00-JE-12001	25-ZSH-046	00-JE-12001	1x2x0.75mm2
48	C-25-ZSL-049/00-JE-12001	25-ZSL-049	00-JE-12001	1x2x0.75mm2
49	C-25-ZSH-049/00-JE-12001	25-ZSH-049	00-JE-12001	1x2x0.75mm2

U-SEC-2D-L-450-102-IST-002

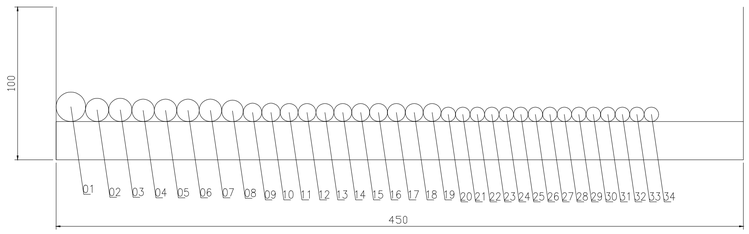

U-SEC-2D-L-450-102-IST-002				
POS	CABLENAME	FROM	TO	FORMATION
1	C-25-BDV-019/00-JE-22001	25-BDV-019	00-JE-22001	2x2x0.75mm2
2	C-25-XV-021/00-JE-12001	25-XV-021	00-JE-12001	2x2x0.75mm2
3	C-80-XV-001/00-JE-12003	80-XV-001	00-JE-12003	2x2x0.75mm2
4	C-950-FDZ-02101/950-JE-02101	950-FDZ-02101	950-JE-02101	3x2.5mm2
5	C-950-FDZ-02102/950-JE-02101	950-FDZ-02102	950-JE-02101	3x2.5mm2
6	C-950-GDZ-02101/950-JE-02101	950-GDZ-02101	950-JE-02101	3x2.5mm2
7	C-950-GDZ-02102/950-JE-02101	950-GDZ-02102	950-JE-02101	3x2.5mm2
8	C-25-BDY-019/00-JE-23001	25-BDY-019	00-JE-23001	2x2.5mm2
9	C-25-XY-021/00-JE-13001	25-XY-021	00-JE-13001	2x2.5mm2
10	C-80-XY-001/00-JE-13001	80-XY-001	00-JE-13001	2x2.5mm2
11	C-25-PT-012/00-JE-21001	25-PT-012	00-JE-21001	1x2x0.75mm2
12	C-950-ASD-01101/00-JE-22001	950-ASD-01101	00-JE-22001	1x2x0.75mm2
13	C-950-MOB-01101/00-JE-22001	950-MOB-01101	00-JE-22001	1x2x0.75mm2
14	C-950-ESD-01101/00-JE-22001	950-ESD-01101	00-JE-22001	1x2x0.75mm2
15	C-950-ESDD-01101/00-JE-22001	950-ESDD-01101	00-JE-22001	1x2x0.75mm2
16	C-950-ASD-04101/00-JE-22001	950-ASD-04101	00-JE-22001	1x2x0.75mm2
17	C-950-MOB-04101/00-JE-22001	950-MOB-04101	00-JE-22001	1x2x0.75mm2
18	C-950-ESD-04101/00-JE-22001	950-ESD-04101	00-JE-22001	1x2x0.75mm2
19	C-950-ESDD-04101/00-JE-22001	950-ESDD-04101	00-JE-22001	1x2x0.75mm2
20	C-25-PT-049/00-JE-11001	25-PT-049	00-JE-11001	1x2x0.75mm2
21	C-25-PY-049/00-JE-11001	25-PY-049	00-JE-11001	1x2x0.75mm2
22	C-25-ZT-049/00-JE-11001	25-ZT-049	00-JE-11001	1x2x0.75mm2
23	C-25-PT-055A/00-JE-11002	25-PT-055A	00-JE-11002	1x2x0.75mm2
24	C-25-PT-055B/00-JE-11002	25-PT-055B	00-JE-11002	1x2x0.75mm2
25	C-25-PY-055A/00-JE-11002	25-PY-055A	00-JE-11002	1x2x0.75mm2
26	C-25-PY-055B/00-JE-11002	25-PY-055B	00-JE-11002	1x2x0.75mm2
27	C-25-ZT-055A/00-JE-11002	25-ZT-055A	00-JE-11002	1x2x0.75mm2
28	C-25-ZT-055B/00-JE-11002	25-ZT-055B	00-JE-11002	1x2x0.75mm2
29	C-25-ZSL-049/00-JE-12001	25-ZSL-049	00-JE-12001	1x2x0.75mm2
30	C-25-ZSH-049/00-JE-12001	25-ZSH-049	00-JE-12001	1x2x0.75mm2
31	C-25-ZSL-055A/00-JE-12003	25-ZSL-055A	00-JE-12003	1x2x0.75mm2
32	C-25-ZSH-055A/00-JE-12003	25-ZSH-055A	00-JE-12003	1x2x0.75mm2
33	C-25-ZSL-055B/00-JE-12003	25-ZSL-055B	00-JE-12003	1x2x0.75mm2
34	C-25-ZSH-055B/00-JE-12003	25-ZSH-055B	00-JE-12003	1x2x0.75mm2

INSERT SUBCONTRACTOR / VENDOR LOGO HERE

REV.	DATE	DRN	CHKD	APPD	DESCRIPTION
03	29/09/25	SPS	LCA	CGI	AS-BUILT (ASB)
02	04/10/24	VBA	LCA	DLO	ACCEPTED FOR CONSTRUCTION (AFC)
01	30/07/24	VBA	LCA	DLO	ACCEPTED FOR CONSTRUCTION (AFC)
00	22/12/23	VBA	LCA	DLO	ISSUE FOR REVIEW (IFR)

CROSSWIND

ROSETTI MARINO

TITLE :
BASE LOAD POWER HUB (BLPH)
INSTRUMENT MAIN CABLE ROUTING-UPPER DECK
TOS EL. 30.310M

CONTRACT NO./TITLE CW-I-WP4-2023-05/HOLLANDSE KUST NOORD WIND PARK | SCALE 1:150

DRAWN SPS | CHECKED LCA | APPROVED C | DATE 29/09/25


A1 | DRAWING NO. 123A90-DDL-IN-DL-40083 | SHEET 005 | REV. 03

File Name : 123A90-DDL-IN-DL-40083 REV:03.dwg

DRAWING NO. 123A90-DDL-IN-DL-40083


REV. 03

U-SEC-2C-L-450-102-IST-002

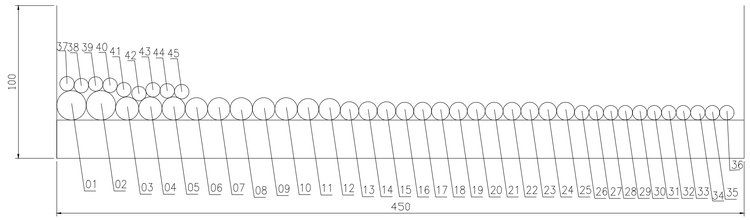


U-SEC-2C-L-450-102-IST-002				
POS	CABLENAME	FROM	TO	FORMATION
1	C-25-BDV-016/00-JE-22001	25-BDV-016	00-JE-22001	2x2x0.75mm2
2	C-25-BDV-019/00-JE-22001	25-BDV-019	00-JE-22001	2x2x0.75mm2
3	C-25-XV-018/00-JE-12001	25-XV-018	00-JE-12001	2x2x0.75mm2
4	C-25-XV-021/00-JE-12001	25-XV-021	00-JE-12001	2x2x0.75mm2
5	C-80-XV-001/00-JE-12003	80-XV-001	00-JE-12003	2x2x0.75mm2
6	C-950-FDZ-02101/950-JE-02101	950-FDZ-02101	950-JE-02101	3x2.5mm2
7	C-950-FDZ-02102/950-JE-02101	950-FDZ-02102	950-JE-02101	3x2.5mm2
8	C-950-GDZ-02101/950-JE-02101	950-GDZ-02101	950-JE-02101	3x2.5mm2
9	C-950-GDZ-02102/950-JE-02101	950-GDZ-02102	950-JE-02101	3x2.5mm2
10	C-950-GDZ-02103/950-JE-02101	950-GDZ-02103	950-JE-02101	3x2.5mm2
11	C-25-BDY-016/00-JE-23001	25-BDY-016	00-JE-23001	2x2.5mm2
12	C-25-BDY-019/00-JE-23001	25-BDY-019	00-JE-23001	2x2.5mm2
13	C-25-XY-018/00-JE-13001	25-XY-018	00-JE-13001	2x2.5mm2
14	C-25-XY-021/00-JE-13001	25-XY-021	00-JE-13001	2x2.5mm2
15	C-80-XY-001/00-JE-13001	80-XY-001	00-JE-13001	2x2.5mm2
16	C-25-PT-011/00-JE-21001	25-PT-011	00-JE-21001	1x2x0.75mm2
17	C-25-PT-012/00-JE-21001	25-PT-012	00-JE-21001	1x2x0.75mm2
18	C-950-ASD-01101/00-JE-22001	950-ASD-01101	00-JE-22001	1x2x0.75mm2
19	C-950-MOB-01101/00-JE-22001	950-MOB-01101	00-JE-22001	1x2x0.75mm2
20	C-950-ESD-01101/00-JE-22001	950-ESD-01101	00-JE-22001	1x2x0.75mm2
21	C-950-ESDD-01101/00-JE-22001	950-ESDD-01101	00-JE-22001	1x2x0.75mm2
22	C-950-ASD-04101/00-JE-22001	950-ASD-04101	00-JE-22001	1x2x0.75mm2
23	C-950-MOB-04101/00-JE-22001	950-MOB-04101	00-JE-22001	1x2x0.75mm2
24	C-950-ESD-04101/00-JE-22001	950-ESD-04101	00-JE-22001	1x2x0.75mm2
25	C-950-ESDD-04101/00-JE-22001	950-ESDD-04101	00-JE-22001	1x2x0.75mm2
26	C-25-PT-046/00-JE-11001	25-PT-046	00-JE-11001	1x2x0.75mm2
27	C-25-PT-049/00-JE-11001	25-PT-049	00-JE-11001	1x2x0.75mm2
28	C-25-PY-046/00-JE-11001	25-PY-046	00-JE-11001	1x2x0.75mm2
29	C-25-PY-049/00-JE-11001	25-PY-049	00-JE-11001	1x2x0.75mm2
30	C-25-ZT-046/00-JE-11001	25-ZT-046	00-JE-11001	1x2x0.75mm2
31	C-25-ZT-049/00-JE-11001	25-ZT-049	00-JE-11001	1x2x0.75mm2
32	C-25-PT-055A/00-JE-11002	25-PT-055A	00-JE-11002	1x2x0.75mm2
33	C-25-PT-055B/00-JE-11002	25-PT-055B	00-JE-11002	1x2x0.75mm2
34	C-25-PY-055A/00-JE-11002	25-PY-055A	00-JE-11002	1x2x0.75mm2
35	C-25-PY-055B/00-JE-11002	25-PY-055B	00-JE-11002	1x2x0.75mm2
36	C-25-ZT-055A/00-JE-11002	25-ZT-055A	00-JE-11002	1x2x0.75mm2
37	C-25-ZT-055B/00-JE-11002	25-ZT-055B	00-JE-11002	1x2x0.75mm2
38	C-25-ZSL-046/00-JE-12001	25-ZSL-046	00-JE-12001	1x2x0.75mm2
39	C-25-ZSH-046/00-JE-12001	25-ZSH-046	00-JE-12001	1x2x0.75mm2
40	C-25-ZSL-049/00-JE-12001	25-ZSL-049	00-JE-12001	1x2x0.75mm2
41	C-25-ZSH-049/00-JE-12001	25-ZSH-049	00-JE-12001	1x2x0.75mm2
42	C-25-ZSL-055A/00-JE-12003	25-ZSL-055A	00-JE-12003	1x2x0.75mm2
43	C-25-ZSH-055A/00-JE-12003	25-ZSH-055A	00-JE-12003	1x2x0.75mm2
44	C-25-ZSL-055B/00-JE-12003	25-ZSL-055B	00-JE-12003	1x2x0.75mm2
45	C-25-ZSH-055B/00-JE-12003	25-ZSH-055B	00-JE-12003	1x2x0.75mm2

U-SEC-2E-L-450-102-IST-002

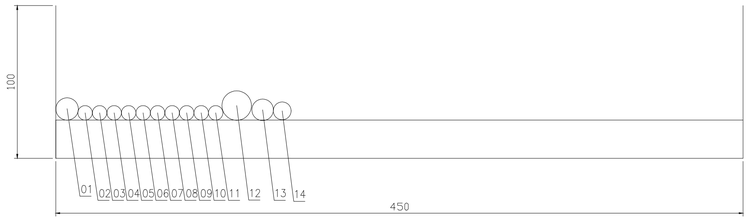


U-SEC-2E-L-450-102-IST-002				
POS	CABLENAME	FROM	TO	FORMATION
1	C-950-GDZ-02101/950-JE-02101	950-GDZ-02101	950-JE-02101	3x2.5mm2
2	C-25-PT-055A/00-JE-11002	25-PT-055A	00-JE-11002	1x2x0.75mm2
3	C-25-PT-055B/00-JE-11002	25-PT-055B	00-JE-11002	1x2x0.75mm2
4	C-25-PY-055A/00-JE-11002	25-PY-055A	00-JE-11002	1x2x0.75mm2
5	C-25-PY-055B/00-JE-11002	25-PY-055B	00-JE-11002	1x2x0.75mm2
6	C-25-ZT-055A/00-JE-11002	25-ZT-055A	00-JE-11002	1x2x0.75mm2
7	C-25-ZT-055B/00-JE-11002	25-ZT-055B	00-JE-11002	1x2x0.75mm2
8	C-25-ZSL-055A/00-JE-12003	25-ZSL-055A	00-JE-12003	1x2x0.75mm2
9	C-25-ZSH-055A/00-JE-12003	25-ZSH-055A	00-JE-12003	1x2x0.75mm2
10	C-25-ZSL-055B/00-JE-12003	25-ZSL-055B	00-JE-12003	1x2x0.75mm2
11	C-25-ZSH-055B/00-JE-12003	25-ZSH-055B	00-JE-12003	1x2x0.75mm2
12	C-25-SDV-023/00-JE-22002	25-SDV-023	00-JE-22002	2x2x0.75 mm2
13	C-25-SDY-023/00-JE-23002	25-SDY-023	00-JE-23002	2x2.5 mm2
14	C-80-PT-002/00-JE-21002	80-PT-002	00-JE-21002	1x2x0.75mm2

U-SEC-4-L-150-103-IST-003

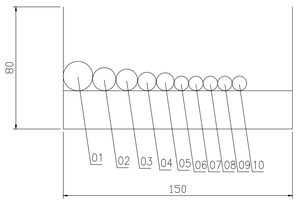

U-SEC-4-L-150-103-IST-003				
POS	CABLENAME	FROM	TO	FORMATION
1	C-25-BDV-010/00-JE-22001	25-BDV-010	00-JE-22001	2x2x0.75mm2
2	C-25-XV-012/00-JE-12001	25-XV-012	00-JE-12001	2x2x0.75mm2
3	C-25-BDY-010/00-JE-23001	25-BDY-010	00-JE-23001	2x2.5mm2
4	C-25-XY-012/00-JE-13001	25-XY-012	00-JE-13001	2x2.5mm2
5	C-25-PT-008/00-JE-21001	25-PT-008	00-JE-21001	1x2x0.75mm2
6	C-25-PT-040/00-JE-11001	25-PT-040	00-JE-11001	1x2x0.75mm2
7	C-25-PY-040/00-JE-11001	25-PY-040	00-JE-11001	1x2x0.75mm2
8	C-25-ZT-040/00-JE-11001	25-ZT-040	00-JE-11001	1x2x0.75mm2
9	C-25-ZSL-040/00-JE-12001	25-ZSL-040	00-JE-12001	1x2x0.75mm2
10	C-25-ZSH-040/00-JE-12001	25-ZSH-040	00-JE-12001	1x2x0.75mm2

U-SEC-3-L-L-450-102-IST-003

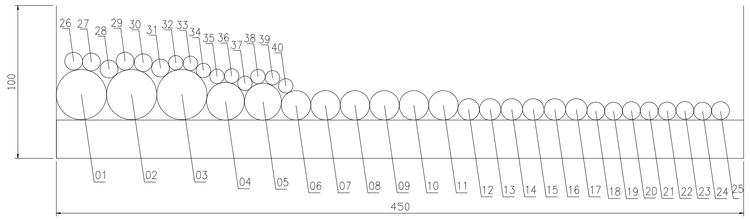

U-SEC-3-L-L-450-102-IST-003				
POS	CABLENAME	FROM	TO	FORMATION
1	00-JE-21001/B400-SIS-001	00-JE-21001	B400-SIS-001	12x2x0.75mm2
2	00-JE-22001_1/B400-SIS-001	00-JE-22001_1	B400-SIS-001	12x2x0.75mm2
3	00-JE-22001_2/B400-SIS-001	00-JE-22001_2	B400-SIS-001	12x2x0.75mm2
4	00-JE-11002/B400-PCS-002	00-JE-11002	B400-PCS-002	12x2x0.75mm2
5	00-JE-23001/B400-SIS-001	00-JE-23001	B400-SIS-001	12x2.5mm2
6	C-25-BDV-005/00-JE-22001	25-BDV-005	00-JE-22001	2x2x0.75mm2
7	C-25-BDV-007/00-JE-22001	25-BDV-007	00-JE-22001	2x2x0.75mm2
8	C-25-BDV-010/00-JE-22001	25-BDV-010	00-JE-22001	2x2x0.75mm2
9	C-25-BDV-013/00-JE-22001	25-BDV-013	00-JE-22001	2x2x0.75mm2
10	C-25-BDV-016/00-JE-22001	25-BDV-016	00-JE-22001	2x2x0.75mm2
11	C-25-BDV-019/00-JE-22001	25-BDV-019	00-JE-22001	2x2x0.75mm2
12	C-25-BDY-005/00-JE-23001	25-BDY-005	00-JE-23001	2x2.5mm2
13	C-25-BDY-007/00-JE-23001	25-BDY-007	00-JE-23001	2x2.5mm2
14	C-25-BDY-010/00-JE-23001	25-BDY-010	00-JE-23001	2x2.5mm2
15	C-25-BDY-013/00-JE-23001	25-BDY-013	00-JE-23001	2x2.5mm2
16	C-25-BDY-016/00-JE-23001	25-BDY-016	00-JE-23001	2x2.5mm2
17	C-25-BDY-019/00-JE-23001	25-BDY-019	00-JE-23001	2x2.5mm2
18	C-25-PT-004/00-JE-21001	25-PT-004	00-JE-21001	1x2x0.75mm2
19	C-25-PT-006/00-JE-21001	25-PT-006	00-JE-21001	1x2x0.75mm2
20	C-25-PT-008/00-JE-21001	25-PT-008	00-JE-21001	1x2x0.75mm2
21	C-25-PT-009/00-JE-21001	25-PT-009	00-JE-21001	1x2x0.75mm2
22	C-25-PT-011/00-JE-21001	25-PT-011	00-JE-21001	1x2x0.75mm2
23	C-25-PT-012/00-JE-21001	25-PT-012	00-JE-21001	1x2x0.75mm2
24	C-950-ASD-01101/00-JE-22001	950-ASD-01101	00-JE-22001	1x2x0.75mm2
25	C-950-MOB-01101/00-JE-22001	950-MOB-01101	00-JE-22001	1x2x0.75mm2
26	C-950-ESD-01101/00-JE-22001	950-ESD-01101	00-JE-22001	1x2x0.75mm2
27	C-950-ESDD-01101/00-JE-22001	950-ESDD-01101	00-JE-22001	1x2x0.75mm2
28	C-950-ASD-04101/00-JE-22001	950-ASD-04101	00-JE-22001	1x2x0.75mm2
29	C-950-MOB-04101/00-JE-22001	950-MOB-04101	00-JE-22001	1x2x0.75mm2
30	C-950-ESD-04101/00-JE-22001	950-ESD-04101	00-JE-22001	1x2x0.75mm2
31	C-950-ESDD-04101/00-JE-22001	950-ESDD-04101	00-JE-22001	1x2x0.75mm2
32	C-25-PT-055A/00-JE-11002	25-PT-055A	00-JE-11002	1x2x0.75mm2
33	C-25-PT-055B/00-JE-11002	25-PT-055B	00-JE-11002	1x2x0.75mm2
34	C-25-PY-055A/00-JE-11002	25-PY-055A	00-JE-11002	1x2x0.75mm2
35	C-25-PY-055B/00-JE-11002	25-PY-055B	00-JE-11002	1x2x0.75mm2
36	C-25-ZT-055A/00-JE-11002	25-ZT-055A	00-JE-11002	1x2x0.75mm2
37	C-25-ZT-055B/00-JE-11002	25-ZT-055B	00-JE-11002	1x2x0.75mm2
38	C-43-PT-001/00-JE-11002	43-PT-001	00-JE-11002	1x2x0.75mm2
39	C-43-FT-001/00-JE-11002	43-FT-001	00-JE-11002	1x2x0.75mm2
40	C-43-LT-003/00-JE-11002	43-LT-003	00-JE-11002	1x2x0.75mm2

INSERT SUBCONTRACTOR / VENDOR LOGO HERE

REV.	DATE	DRN	CHKD	APPD	DESCRIPTION
03	29/09/25	SPS	LCA	CGI	AS-BUILT (ASB)
02	04/10/24	VBA	LCA	DLO	ACCEPTED FOR CONSTRUCTION (AFC)
01	30/07/24	VBA	LCA	DLO	ACCEPTED FOR CONSTRUCTION (AFC)
00	22/12/23	VBA	LCA	DLO	ISSUE FOR REVIEW (IFR)

CROSSWIND

ROSETTI MARINO

TITLE :
BASE LOAD POWER HUB (BLPH)
INSTRUMENT MAIN CABLE ROUTING-UPPER DECK
TOS EL. 30.310M

CONTRACT NO./TITLE CW-I-WP4-2023-05/HOLLANDSE KUST NOORD WIND PARK | SCALE 1:150

DRAWN SPS | CHECKED LCA | APPROVED CGI | DATE 29/09/25


A1 | DRAWING NO. 123A90-DDL-IN-DL-40083 | SHEET 006 | REV. 03

File Name : 123A90-DDL-IN-DL-40083 REV03.dwg

DRAWING NO. 123A90-DDL-IN-DL-40083


REV. 03

U-SEC-5-L-150-103-IST-002

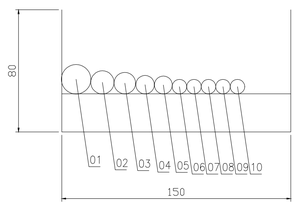


U-SEC-5-L-150-103-IST-002				
POS	CABLENAME	FROM	TO	FORMATION
1	C-25-BDV-007/00-JE-22001	25-BDV-007	00-JE-22001	2x2x0.75mm2
2	C-25-XV-009/00-JE-12001	25-XV-009	00-JE-12001	2x2x0.75mm2
3	C-25-BDY-007/00-JE-23001	25-BDY-007	00-JE-23001	2x2.5mm2
4	C-25-XY-009/00-JE-13001	25-XY-009	00-JE-13001	2x2.5mm2
5	C-25-PT-006/00-JE-21001	25-PT-006	00-JE-21001	1x2x0.75mm2
6	C-25-PT-037/00-JE-11001	25-PT-037	00-JE-11001	1x2x0.75mm2
7	C-25-PY-037/00-JE-11001	25-PY-037	00-JE-11001	1x2x0.75mm2
8	C-25-ZT-037/00-JE-11001	25-ZT-037	00-JE-11001	1x2x0.75mm2
9	C-25-ZSL-037/00-JE-12002	25-ZSL-037	00-JE-12002	1x2x0.75mm2
10	C-25-ZSH-037/00-JE-12002	25-ZSH-037	00-JE-12002	1x2x0.75mm2

U-SEC-7-L-200-103-IST-007

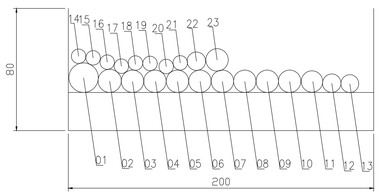


U-SEC-7-L-200-103-IST-007				
POS	CABLENAME	FROM	TO	FORMATION
1	C-25-BDV-005/00-JE-22001	25-BDV-005	00-JE-22001	2x2x0.75mm2
2	C-25-XV-006/00-JE-12001	25-XV-006	00-JE-12001	2x2x0.75mm2
3	C-950-GDZ-02109/950-JE-02102	950-GDZ-02109	950-JE-02102	3x2.5mm2
4	C-950-GDZ-02110/950-JE-02102	950-GDZ-02110	950-JE-02102	3x2.5mm2
5	C-950-GDZ-02111/950-JE-02102	950-GDZ-02111	950-JE-02102	3x2.5mm2
6	C-950-GDZ-02112/950-JE-02102	950-GDZ-02112	950-JE-02102	3x2.5mm2
7	C-950-GDZ-02113/950-JE-02102	950-GDZ-02113	950-JE-02102	3x2.5mm2
8	C-950-GDZ-02114/950-JE-02102	950-GDZ-02114	950-JE-02102	3x2.5mm2
9	C-950-GDZ-02115/950-JE-02102	950-GDZ-02115	950-JE-02102	3x2.5mm2
10	C-950-GDZ-02116/950-JE-02102	950-GDZ-02116	950-JE-02102	3x2.5mm2
11	C-25-BDY-005/00-JE-23001	25-BDY-005	00-JE-23001	2x2.5mm2
12	C-25-XY-006/00-JE-13001	25-XY-006	00-JE-13001	2x2.5mm2
13	C-25-PT-004/00-JE-21001	25-PT-004	00-JE-21001	1x2x0.75mm2
14	C-25-PT-035/00-JE-11001	25-PT-035	00-JE-11001	1x2x0.75mm2
15	C-25-PY-035/00-JE-11001	25-PY-035	00-JE-11001	1x2x0.75mm2
16	C-25-ZT-035/00-JE-11001	25-ZT-035	00-JE-11001	1x2x0.75mm2
17	C-43-PT-001/00-JE-11002	43-PT-001	00-JE-11002	1x2x0.75mm2
18	C-43-LT-003/00-JE-11002	43-LT-003	00-JE-11002	1x2x0.75mm2
19	C-25-ZSL-035/00-JE-12002	25-ZSL-035	00-JE-12002	1x2x0.75mm2
20	C-25-ZSH-035/00-JE-12002	25-ZSH-035	00-JE-12002	1x2x0.75mm2
21	C-43-FT-001/00-JE-11002	43-FT-001	00-JE-11002	1x2x0.75 mm2
22	PD-43-FT-001/00-JE-13001	43-FT-001	00-JE-13001	2x2.5 mm2
23	C-950-GDZ-02119/950-JE-02103	950-GDZ-02119	950-JE-02103	3x2.5mm2

U-SEC-6-L-450-103-IST-006

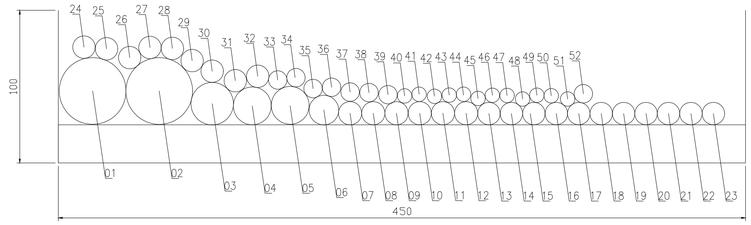


U-SEC-6-L-450-103-IST-006				
POS	CABLENAME	FROM	TO	FORMATION
1	950-JE-02101/B400-FGS-002	950-JE-02101	B400-FGS-002	12x3x2.5mm2
2	950-JE-02102/B400-FGS-002	950-JE-02102	B400-FGS-002	12x3x2.5mm2
3	00-JE-13001/B400-PCS-002	00-JE-13001	B400-PCS-002	24x2.5mm2
4	00-JE-12001_1/B400-PCS-002	00-JE-12001_1	B400-PCS-002	12x2x0.75mm2
5	00-JE-12001_2/B400-PCS-002	00-JE-12001_2	B400-PCS-002	12x2x0.75mm2
6	00-JE-12002/B400-PCS-002	00-JE-12002	B400-PCS-002	6x2x0.75mm2
7	C-25-XV-006/00-JE-12001	25-XV-006	00-JE-12001	2x2x0.75mm2
8	C-25-XV-009/00-JE-12001	25-XV-009	00-JE-12001	2x2x0.75mm2
9	C-25-XV-012/00-JE-12001	25-XV-012	00-JE-12001	2x2x0.75mm2
10	C-25-XV-015/00-JE-12001	25-XV-015	00-JE-12001	2x2x0.75mm2
11	C-25-XV-018/00-JE-12001	25-XV-018	00-JE-12001	2x2x0.75mm2
12	C-25-XV-021/00-JE-12001	25-XV-021	00-JE-12001	2x2x0.75mm2
13	C-950-FDZ-02101/950-JE-02101	950-FDZ-02101	950-JE-02101	3x2.5mm2
14	C-950-FDZ-02102/950-JE-02101	950-FDZ-02102	950-JE-02101	3x2.5mm2
15	C-950-FDZ-02103/950-JE-02101	950-FDZ-02103	950-JE-02101	3x2.5mm2
16	C-950-FDZ-02104/950-JE-02101	950-FDZ-02104	950-JE-02101	3x2.5mm2
17	C-950-GDZ-02101/950-JE-02101	950-GDZ-02101	950-JE-02101	3x2.5mm2
18	C-950-GDZ-02102/950-JE-02101	950-GDZ-02102	950-JE-02101	3x2.5mm2
19	C-950-GDZ-02103/950-JE-02101	950-GDZ-02103	950-JE-02101	3x2.5mm2
20	C-950-GDZ-02104/950-JE-02101	950-GDZ-02104	950-JE-02101	3x2.5mm2
21	C-950-GDZ-02105/950-JE-02101	950-GDZ-02105	950-JE-02101	3x2.5mm2
22	C-950-GDZ-02106/950-JE-02101	950-GDZ-02106	950-JE-02101	3x2.5mm2
23	C-950-GDZ-02107/950-JE-02102	950-GDZ-02107	950-JE-02102	3x2.5mm2
24	C-950-GDZ-02108/950-JE-02102	950-GDZ-02108	950-JE-02102	3x2.5mm2
25	C-950-GDZ-02109/950-JE-02102	950-GDZ-02109	950-JE-02102	3x2.5mm2
26	C-950-GDZ-02110/950-JE-02102	950-GDZ-02110	950-JE-02102	3x2.5mm2
27	C-950-GDZ-02111/950-JE-02102	950-GDZ-02111	950-JE-02102	3x2.5mm2
28	C-950-GDZ-02112/950-JE-02102	950-GDZ-02112	950-JE-02102	3x2.5mm2
29	C-950-GDZ-02113/950-JE-02102	950-GDZ-02113	950-JE-02102	3x2.5mm2
30	C-950-GDZ-02114/950-JE-02102	950-GDZ-02114	950-JE-02102	3x2.5mm2
31	C-950-GDZ-02115/950-JE-02102	950-GDZ-02115	950-JE-02102	3x2.5mm2
32	C-950-GDZ-02116/950-JE-02102	950-GDZ-02116	950-JE-02102	3x2.5mm2
33	C-25-XY-006/00-JE-13001	25-XY-006	00-JE-13001	2x2.5mm2
34	C-25-XY-009/00-JE-13001	25-XY-009	00-JE-13001	2x2.5mm2
35	C-25-XY-012/00-JE-13001	25-XY-012	00-JE-13001	2x2.5mm2
36	C-25-XY-015/00-JE-13001	25-XY-015	00-JE-13001	2x2.5mm2
37	C-25-XY-018/00-JE-13001	25-XY-018	00-JE-13001	2x2.5mm2
38	C-25-XY-021/00-JE-13001	25-XY-021	00-JE-13001	2x2.5mm2
39	C-80-XY-001/00-JE-13001	80-XY-001	00-JE-13001	2x2.5mm2
40	C-25-ZSL-046/00-JE-12001	25-ZSL-046	00-JE-12001	1x2x0.75mm2
41	C-25-ZSH-046/00-JE-12001	25-ZSH-046	00-JE-12001	1x2x0.75mm2
42	C-25-ZSL-049/00-JE-12001	25-ZSL-049	00-JE-12001	1x2x0.75mm2
43	C-25-ZSH-049/00-JE-12001	25-ZSH-049	00-JE-12001	1x2x0.75mm2
44	C-25-ZSL-040/00-JE-12001	25-ZSL-040	00-JE-12001	1x2x0.75mm2
45	C-25-ZSH-040/00-JE-12001	25-ZSH-040	00-JE-12001	1x2x0.75mm2
46	C-25-ZSL-043/00-JE-12001	25-ZSL-043	00-JE-12001	1x2x0.75mm2
47	C-25-ZSH-043/00-JE-12001	25-ZSH-043	00-JE-12001	1x2x0.75mm2
48	C-25-ZSL-035/00-JE-12002	25-ZSL-035	00-JE-12002	1x2x0.75mm2
49	C-25-ZSH-035/00-JE-12002	25-ZSH-035	00-JE-12002	1x2x0.75mm2
50	C-25-ZSL-037/00-JE-12002	25-ZSL-037	00-JE-12002	1x2x0.75mm2
51	C-25-ZSH-037/00-JE-12002	25-ZSH-037	00-JE-12002	1x2x0.75mm2
52	PD-43-FT-001/00-JE-13001	43-FT-001	00-JE-13001	2x2.5 mm2

U-SEC-8-L-150-102-IST-031

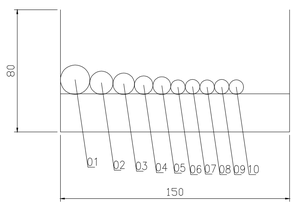

U-SEC-8-L-150-102-IST-031				
POS	CABLENAME	FROM	TO	FORMATION
1	C-25-BDV-013/00-JE-22001	25-BDV-013	00-JE-22001	2x2x0.75mm2
2	C-25-XV-015/00-JE-12001	25-XV-015	00-JE-12001	2x2x0.75mm2
3	C-25-BDY-013/00-JE-23001	25-BDY-013	00-JE-23001	2x2.5mm2
4	C-25-XY-015/00-JE-13001	25-XY-015	00-JE-13001	2x2.5mm2
5	C-25-PT-009/00-JE-21001	25-PT-009	00-JE-21001	1x2x0.75mm2
6	C-25-PT-043/00-JE-11001	25-PT-043	00-JE-11001	1x2x0.75mm2
7	C-25-PY-043/00-JE-11001	25-PY-043	00-JE-11001	1x2x0.75mm2
8	C-25-ZT-043/00-JE-11001	25-ZT-043	00-JE-11001	1x2x0.75mm2
9	C-25-ZSL-043/00-JE-12001	25-ZSL-043	00-JE-12001	1x2x0.75mm2
10	C-25-ZSH-043/00-JE-12001	25-ZSH-043	00-JE-12001	1x2x0.75mm2

U-SEC-9-L-300-102-IST-003

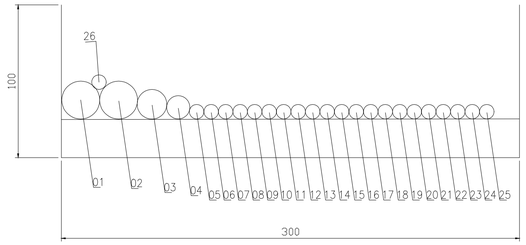

U-SEC-9-L-300-102-IST-003				
POS	CABLENAME	FROM	TO	FORMATION
1	00-JE-11001_1/B400-PCS-002	00-JE-11001_1	B400-PCS-002	12x2x0.75mm2
2	00-JE-11001_2/B400-PCS-002	00-JE-11001_2	B400-PCS-002	12x2x0.75mm2
3	00-JE-12003/B400-PCS-002	00-JE-12003	B400-PCS-002	6x2x0.75mm2
4	C-80-XV-001/00-JE-12003	80-XV-001	00-JE-12003	2x2x0.75mm2
5	C-25-PT-035/00-JE-11001	25-PT-035	00-JE-11001	1x2x0.75mm2
6	C-25-PT-037/00-JE-11001	25-PT-037	00-JE-11001	1x2x0.75mm2
7	C-25-PT-040/00-JE-11001	25-PT-040	00-JE-11001	1x2x0.75mm2
8	C-25-PT-043/00-JE-11001	25-PT-043	00-JE-11001	1x2x0.75mm2
9	C-25-PT-046/00-JE-11001	25-PT-046	00-JE-11001	1x2x0.75mm2
10	C-25-PT-049/00-JE-11001	25-PT-049	00-JE-11001	1x2x0.75mm2
11	C-25-PY-035/00-JE-11001	25-PY-035	00-JE-11001	1x2x0.75mm2
12	C-25-PY-037/00-JE-11001	25-PY-037	00-JE-11001	1x2x0.75mm2
13	C-25-PY-040/00-JE-11001	25-PY-040	00-JE-11001	1x2x0.75mm2
14	C-25-PY-043/00-JE-11001	25-PY-043	00-JE-11001	1x2x0.75mm2
15	C-25-PY-046/00-JE-11001	25-PY-046	00-JE-11001	1x2x0.75mm2
16	C-25-PY-049/00-JE-11001	25-PY-049	00-JE-11001	1x2x0.75mm2
17	C-25-ZT-035/00-JE-11001	25-ZT-035	00-JE-11001	1x2x0.75mm2
18	C-25-ZT-037/00-JE-11001	25-ZT-037	00-JE-11001	1x2x0.75mm2
19	C-25-ZT-040/00-JE-11001	25-ZT-040	00-JE-11001	1x2x0.75mm2
20	C-25-ZT-043/00-JE-11001	25-ZT-043	00-JE-11001	1x2x0.75mm2
21	C-25-ZT-046/00-JE-11001	25-ZT-046	00-JE-11001	1x2x0.75mm2
22	C-25-ZT-049/00-JE-11001	25-ZT-049	00-JE-11001	1x2x0.75mm2
23	C-25-ZSL-055A/00-JE-12003	25-ZSL-055A	00-JE-12003	1x2x0.75mm2
24	C-25-ZSH-055A/00-JE-12003	25-ZSH-055A	00-JE-12003	1x2x0.75mm2
25	C-25-ZSL-055B/00-JE-12003	25-ZSL-055B	00-JE-12003	1x2x0.75mm2
26	C-25-ZSH-055B/00-JE-12003	25-ZSH-055B	00-JE-12003	1x2x0.75mm2

INSERT SUBCONTRACTOR / VENDOR LOGO HERE

REV.	DATE	DRN	CHKD	APPD	DESCRIPTION
03	29/09/25	SPS	LCA	CGI	AS-BUILT (ASB)
02	04/10/24	VBA	LCA	DLO	ACCEPTED FOR CONSTRUCTION (AFC)
01	30/07/24	VBA	LCA	DLO	ACCEPTED FOR CONSTRUCTION (AFC)
00	22/12/23	VBA	LCA	DLO	ISSUE FOR REVIEW (IFR)

CROSSWIND

ROSETTI MARINO

TITLE :

BASE LOAD POWER HUB (BLPH)
INSTRUMENT MAIN CABLE ROUTING-UPPER DECK
TOS EL. 30.310M


CONTRACT NO./TITLE CW-I-WP4-2023-05/HOLLANDSE KUST NOORD WIND PARK			SCALE 1:150
DRAWN SPS	CHECKED LCA	APPROVED CGI	DATE 29/09/25
A1	DRAWING NO. 123A90-DDL-IN-DL-40083	SHEET 007	REV. 03

File Name : 123A90-DDL-IN-DL-40083 REV03.dwg

DRAWING NO. 123A90-DDL-IN-DL-40083


REV. 03

U-SEC-10-L-150-102-IST-032

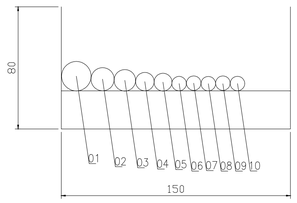


U-SEC-10-L-150-102-IST-032				
POS	CABLENAME	FROM	TO	FORMATION
1	C-25-BDV-016/00-JE-22001	25-BDV-016	00-JE-22001	2x2x0.75mm2
2	C-25-XV-018/00-JE-12001	25-XV-018	00-JE-12001	2x2x0.75mm2
3	C-25-BDY-016/00-JE-23001	25-BDY-016	00-JE-23001	2x2.5mm2
4	C-25-XY-018/00-JE-13001	25-XY-018	00-JE-13001	2x2.5mm2
5	C-25-PT-011/00-JE-21001	25-PT-011	00-JE-21001	1x2x0.75mm2
6	C-25-PT-046/00-JE-11001	25-PT-046	00-JE-11001	1x2x0.75mm2
7	C-25-PY-046/00-JE-11001	25-PY-046	00-JE-11001	1x2x0.75mm2
8	C-25-ZT-046/00-JE-11001	25-ZT-046	00-JE-11001	1x2x0.75mm2
9	C-25-ZSL-046/00-JE-12001	25-ZSL-046	00-JE-12001	1x2x0.75mm2
10	C-25-ZSH-046/00-JE-12001	25-ZSH-046	00-JE-12001	1x2x0.75mm2

U-SEC-11-L-300-102-IST-004

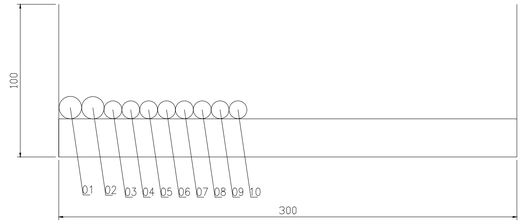


U-SEC-11-L-300-102-IST-004				
POS	CABLENAME	FROM	TO	FORMATION
1	C-950-FDZ-02101/950-JE-02101	950-FDZ-02101	950-JE-02101	3x2.5mm2
2	C-950-FDZ-02102/950-JE-02101	950-FDZ-02102	950-JE-02101	3x2.5mm2
3	C-950-ASD-01101/00-JE-22001	950-ASD-01101	00-JE-22001	1x2x0.75mm2
4	C-950-MOB-01101/00-JE-22001	950-MOB-01101	00-JE-22001	1x2x0.75mm2
5	C-950-ESD-01101/00-JE-22001	950-ESD-01101	00-JE-22001	1x2x0.75mm2
6	C-950-ESDD-01101/00-JE-22001	950-ESDD-01101	00-JE-22001	1x2x0.75mm2
7	C-950-ASD-04101/00-JE-22001	950-ASD-04101	00-JE-22001	1x2x0.75mm2
8	C-950-MOB-04101/00-JE-22001	950-MOB-04101	00-JE-22001	1x2x0.75mm2
9	C-950-ESD-04101/00-JE-22001	950-ESD-04101	00-JE-22001	1x2x0.75mm2
10	C-950-ESDD-04101/00-JE-22001	950-ESDD-04101	00-JE-22001	1x2x0.75mm2

U-SEC-12-L-150-102-IST-033

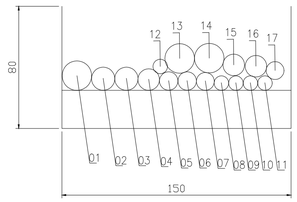


U-SEC-12-L-150-102-IST-033				
POS	CABLENAME	FROM	TO	FORMATION
1	C-25-BDV-019/00-JE-22001	25-BDV-019	00-JE-22001	2x2x0.75mm2
2	C-25-XV-021/00-JE-12001	25-XV-021	00-JE-12001	2x2x0.75mm2
3	C-80-XV-001/00-JE-12003	80-XV-001	00-JE-12003	2x2x0.75mm2
4	C-25-BDY-019/00-JE-23001	25-BDY-019	00-JE-23001	2x2.5mm2
5	C-25-XY-021/00-JE-13001	25-XY-021	00-JE-13001	2x2.5mm2
6	C-80-XY-001/00-JE-13001	80-XY-001	00-JE-13001	2x2.5mm2
7	C-25-PT-012/00-JE-21001	25-PT-012	00-JE-21001	1x2x0.75mm2
8	C-25-PT-049/00-JE-11001	25-PT-049	00-JE-11001	1x2x0.75mm2
9	C-25-PY-049/00-JE-11001	25-PY-049	00-JE-11001	1x2x0.75mm2
10	C-25-ZT-049/00-JE-11001	25-ZT-049	00-JE-11001	1x2x0.75mm2
11	C-25-ZSL-049/00-JE-12001	25-ZSL-049	00-JE-12001	1x2x0.75mm2
12	C-25-ZSH-049/00-JE-12001	25-ZSH-049	00-JE-12001	1x2x0.75mm2
13	C-25-SDV-023/00-JE-22002	25-SDV-023	00-JE-22002	2x2x0.75 mm2
14	C-25-BDV-022/00-JE-22002	25-BDV-022	00-JE-22002	2x2x0.75 mm2
15	C-25-BDY-022/00-JE-23002	25-BDY-022	00-JE-23002	2x2.5 mm2
16	C-25-SDY-023/00-JE-23002	25-SDY-023	00-JE-23002	2x2.5 mm2
17	C-80-PT-002/00-JE-21002	80-PT-002	00-JE-21002	1x2x0.75mm2

U-SEC-14A-L-450-102-IST-012

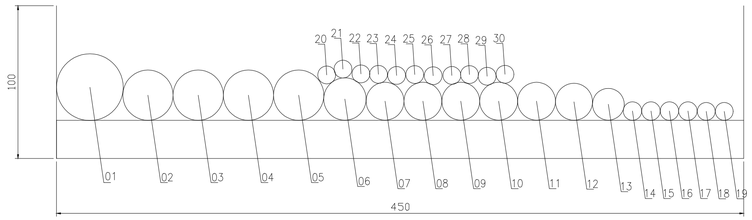

U-SEC-14A-L-450-102-IST-012				
POS	CABLENAME	FROM	TO	FORMATION
1	950-JE-03101/B400-FGS-002	950-JE-03101	B400-FGS-002	12x3x2.5 mm2
2	00-JE-21002/B400-SIS-001	00-JE-21002	B400-SIS-001	12x2x0.75mm2
3	00-JE-22002_1/B400-SIS-001	00-JE-22002_1	B400-SIS-001	12x2x0.75mm2
4	00-JE-22002_2/B400-SIS-001	00-JE-22002_2	B400-SIS-001	12x2x0.75mm2
5	950-JE-02103/B400-FGS-002	950-JE-02103	B400-FGS-002	6x3x2.5mm2
6	00-JE-13002/B400-PCS-002	00-JE-13002	B400-PCS-002	24x2.5mm2
7	00-JE-11003_1/B400-PCS-002	00-JE-11003_1	B400-PCS-002	12x2x0.75mm2
8	00-JE-11003_2/B400-PCS-002	00-JE-11003_2	B400-PCS-002	12x2x0.75mm2
9	00-JE-12004_1/B400-PCS-002	00-JE-12004_1	B400-PCS-002	12x2x0.75mm2
10	00-JE-12004_2/B400-PCS-002	00-JE-12004_2	B400-PCS-002	12x2x0.75mm2
11	00-JE-12005/B400-PCS-002	00-JE-12005	B400-PCS-002	12x2x0.75mm2
12	00-JE-23002/B400-SIS-001	00-JE-23002	B400-SIS-001	12x2.5mm2
13	00-JE-13003/B400-PCS-002	00-JE-13003	B400-PCS-002	12x2.5mm2
14	C-50-XY-001/00-JE-13003	50-XY-001	00-JE-13003	2x2.5mm2
15	C-50-XY-002/00-JE-13003	50-XY-002	00-JE-13003	2x2.5mm2
16	C-50-XY-003/00-JE-13003	50-XY-003	00-JE-13003	2x2.5mm2
17	C-50-XY-004/00-JE-13003	50-XY-004	00-JE-13003	2x2.5mm2
18	C-64-PT-002/00-JE-21002	64-PT-002	00-JE-21002	1x2x0.75mm2
19	C-950-ASD-03101/00-JE-22002	950-ASD-03101	00-JE-22002	1x2x0.75mm2
20	C-950-MOB-03101/00-JE-22002	950-MOB-03101	00-JE-22002	1x2x0.75mm2
21	C-950-ESD-03101/00-JE-22002	950-ESD-03101	00-JE-22002	1x2x0.75mm2
22	C-950-ESDD-03101/00-JE-22002	950-ESDD-03101	00-JE-22002	1x2x0.75mm2
23	C-950-ASD-06101/00-JE-22002	950-ASD-06101	00-JE-22002	1x2x0.75mm2
24	C-950-MOB-06101/00-JE-22002	950-MOB-06101	00-JE-22002	1x2x0.75mm2
25	C-950-ESD-06101/00-JE-22002	950-ESD-06101	00-JE-22002	1x2x0.75mm2
26	C-950-ESDD-06101/00-JE-22002	950-ESDD-06101	00-JE-22002	1x2x0.75mm2
27	C-950-ASD-07101/00-JE-22002	950-ASD-07101	00-JE-22002	1x2x0.75mm2
28	C-950-MOB-07101/00-JE-22002	950-MOB-07101	00-JE-22002	1x2x0.75mm2
29	C-950-ESD-07101/00-JE-22002	950-ESD-07101	00-JE-22002	1x2x0.75mm2
30	C-950-ESDD-07101/00-JE-22002	950-ESDD-07101	00-JE-22002	1x2x0.75mm2

U-SEC-13-L-150-102-IST-023

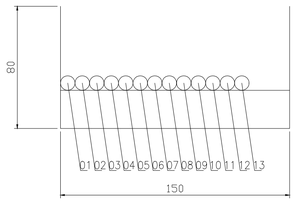

U-SEC-13-L-150-102-IST-023				
POS	CABLENAME	FROM	TO	FORMATION
1	C-25-SDV-023/00-JE-22002	25-SDV-023	00-JE-22002	2x2x0.75mm2
2	C-25-SDY-023/00-JE-23002	25-SDY-023	00-JE-23002	2x2.5mm2
3	C-80-PT-002/00-JE-21002	80-PT-002	00-JE-21002	1x2x0.75mm2
4	C-25-PT-055A/00-JE-11002	25-PT-055A	00-JE-11002	1x2x0.75mm2
5	C-25-PT-055B/00-JE-11002	25-PT-055B	00-JE-11002	1x2x0.75mm2
6	C-25-PY-055A/00-JE-11002	25-PY-055A	00-JE-11002	1x2x0.75mm2
7	C-25-PY-055B/00-JE-11002	25-PY-055B	00-JE-11002	1x2x0.75mm2
8	C-25-ZT-055A/00-JE-11002	25-ZT-055A	00-JE-11002	1x2x0.75mm2
9	C-25-ZT-055B/00-JE-11002	25-ZT-055B	00-JE-11002	1x2x0.75mm2
10	C-25-ZSL-055A/00-JE-12003	25-ZSL-055A	00-JE-12003	1x2x0.75mm2
11	C-25-ZSH-055A/00-JE-12003	25-ZSH-055A	00-JE-12003	1x2x0.75mm2
12	C-25-ZSL-055B/00-JE-12003	25-ZSL-055B	00-JE-12003	1x2x0.75mm2
13	C-25-ZSH-055B/00-JE-12003	25-ZSH-055B	00-JE-12003	1x2x0.75mm2

INSERT SUBCONTRACTOR / VENDOR LOGO HERE

REV.	DATE	DRN	CHKD	APPD	DESCRIPTION
03	29/09/25	SPS	LCA	CGI	AS-BUILT (ASB)
02	04/10/24	VBA	LCA	DLO	ACCEPTED FOR CONSTRUCTION (AFC)
01	30/07/24	VBA	LCA	DLO	ACCEPTED FOR CONSTRUCTION (AFC)
00	22/12/23	VBA	LCA	DLO	ISSUE FOR REVIEW (IFR)

CROSSWIND

ROSETTI MARINO

TITLE :
BASE LOAD POWER HUB (BLPH)
INSTRUMENT MAIN CABLE ROUTING-UPPER DECK
TOS EL. 30.310M


CONTRACT NO./TITLE CW-I-WP4-2023-05/HOLLANDSE KUST NOORD WIND PARK			SCALE 1:150
DRAWN SPS	CHECKED LCA	APPROVED CGI	DATE 29/09/25
A1	DRAWING NO. 123A90-DDL-IN-DL-40083	SHEET 008	REV. 03

File Name : 123A90-DDL-IN-DL-40083 REV03.dwg

DRAWING NO. 123A90-DDL-IN-DL-40083


REV. 03

U-SEC-14B-L-450-102-IST-012

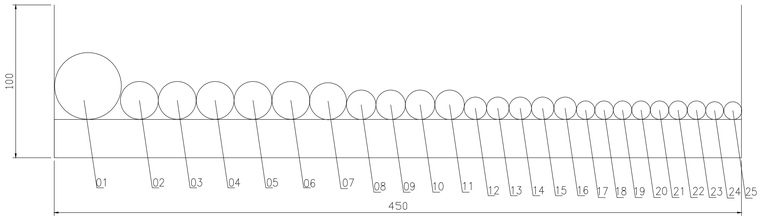


U-SEC-14B-L-450-102-IST-012				
POS	CABLENAME	FROM	TO	FORMATION
1	950-JE-03101/B400-FGS-002	950-JE-03101	B400-FGS-002	12x3x2.5 mm2
2	00-JE-11003_1/B400-PCS-002	00-JE-11003_1	B400-PCS-002	12x2x0.75mm2
3	00-JE-11003_2/B400-PCS-002	00-JE-11003_2	B400-PCS-002	12x2x0.75mm2
4	00-JE-12004_1/B400-PCS-002	00-JE-12004_1	B400-PCS-002	12x2x0.75mm2
5	00-JE-12004_2/B400-PCS-002	00-JE-12004_2	B400-PCS-002	12x2x0.75mm2
6	00-JE-12005/B400-PCS-002	00-JE-12005	B400-PCS-002	12x2x0.75mm2
7	00-JE-23002/B400-SIS-001	00-JE-23002	B400-SIS-001	12x2.5mm2
8	C-25-SDV-001/00-JE-22002	25-SDV-001	00-JE-22002	2x2x0.75mm2
9	C-25-SDV-023/00-JE-22002	25-SDV-023	00-JE-22002	2x2x0.75mm2
10	C-25-BDV-022/00-JE-22002	25-BDV-022	00-JE-22002	2x2x0.75mm2
11	C-64-SDV-001/00-JE-22002	64-SDV-001	00-JE-22002	2x2x0.75mm2
12	C-950-GDZ-02117/950-JE-02103	950-GDZ-02117	950-JE-02103	3x2.5mm2
13	C-950-GDZ-02118/950-JE-02103	950-GDZ-02118	950-JE-02103	3x2.5mm2
14	C-950-GDZ-02119/950-JE-02103	950-GDZ-02119	950-JE-02103	3x2.5mm2
15	C-950-GDZ-02120/950-JE-02103	950-GDZ-02120	950-JE-02103	3x2.5mm2
16	C-25-XY-004/00-JE-13002	25-XY-004	00-JE-13002	2x2.5mm2
17	C-25-XY-008/00-JE-13002	25-XY-008	00-JE-13002	2x2.5mm2
18	C-25-XY-011/00-JE-13002	25-XY-011	00-JE-13002	2x2.5mm2
19	C-25-XY-014/00-JE-13002	25-XY-014	00-JE-13002	2x2.5mm2
20	C-25-XY-017/00-JE-13002	25-XY-017	00-JE-13002	2x2.5mm2
21	C-25-XY-020/00-JE-13002	25-XY-020	00-JE-13002	2x2.5mm2
22	C-25-XY-024/00-JE-13002	25-XY-024	00-JE-13002	2x2.5mm2
23	C-25-PT-002/00-JE-21002	25-PT-002	00-JE-21002	1x2x0.75mm2
24	C-80-PT-002/00-JE-21002	80-PT-002	00-JE-21002	1x2x0.75mm2
25	C-43-LT-001/00-JE-21002	43-LT-002	00-JE-21002	1x2x0.75mm2

U-SEC-14C-L-450-102-IST-012

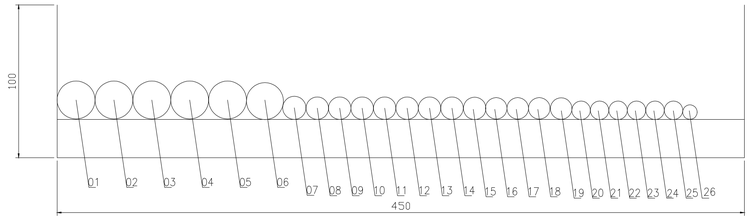


U-SEC-14C-L-450-102-IST-012				
POS	CABLENAME	FROM	TO	FORMATION
1	00-JE-11003_1/B400-PCS-002	00-JE-11003_1	B400-PCS-002	12x2x0.75mm2
2	00-JE-11003_2/B400-PCS-002	00-JE-11003_2	B400-PCS-002	12x2x0.75mm2
3	00-JE-12004_1/B400-PCS-002	00-JE-12004_1	B400-PCS-002	12x2x0.75mm2
4	00-JE-12004_2/B400-PCS-002	00-JE-12004_2	B400-PCS-002	12x2x0.75mm2
5	00-JE-12005/B400-PCS-002	00-JE-12005	B400-PCS-002	12x2x0.75mm2
6	00-JE-23002/B400-SIS-001	00-JE-23002	B400-SIS-001	12x2.5mm2
7	C-25-XV-024/00-JE-12005	25-XV-024	00-JE-12005	2x2x0.75mm2
8	C-950-GDZ-02120/950-JE-02103	950-GDZ-02120	950-JE-02103	3x2.5mm2
9	C-950-GDZ-02110/950-JE-02102	950-GDZ-02110	950-JE-02102	3x2.5mm2
10	C-950-GDZ-02111/950-JE-02102	950-GDZ-02111	950-JE-02102	3x2.5mm2
11	C-950-GDZ-02112/950-JE-02102	950-GDZ-02112	950-JE-02102	3x2.5mm2
12	C-950-GDZ-02113/950-JE-02102	950-GDZ-02113	950-JE-02102	3x2.5mm2
13	C-950-GDZ-02114/950-JE-02102	950-GDZ-02114	950-JE-02102	3x2.5mm2
14	C-950-GDZ-02115/950-JE-02102	950-GDZ-02115	950-JE-02102	3x2.5mm2
15	C-950-GDZ-02116/950-JE-02102	950-GDZ-02116	950-JE-02102	3x2.5mm2
16	C-25-SDY-001/00-JE-23002	25-SDY-001	00-JE-23002	2x2.5mm2
17	C-25-BDY-022/00-JE-23002	25-BDY-022	00-JE-23002	2x2.5mm2
18	C-25-SDY-023/00-JE-23002	25-SDY-023	00-JE-23002	2x2.5mm2
19	C-64-SDY-001/00-JE-23002	64-SDY-023	00-JE-23002	2x2.5mm2
20	C-25-XY-004/00-JE-13002	25-XY-004	00-JE-13002	2x2.5mm2
21	C-25-XY-008/00-JE-13002	25-XY-008	00-JE-13002	2x2.5mm2
22	C-25-XY-011/00-JE-13002	25-XY-011	00-JE-13002	2x2.5mm2
23	C-25-XY-014/00-JE-13002	25-XY-014	00-JE-13002	2x2.5mm2
24	C-25-XY-017/00-JE-13002	25-XY-017	00-JE-13002	2x2.5mm2
25	C-25-XY-020/00-JE-13002	25-XY-020	00-JE-13002	2x2.5mm2
26	C-25-PT-001/00-JE-11003	25-PT-001	00-JE-11003	1x2x0.75mm2

U-SEC-14D-L-450-102-IST-012

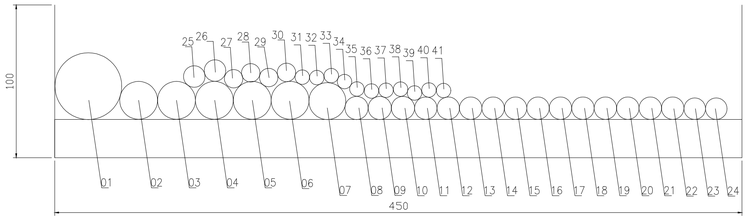


U-SEC-14D-L-450-102-IST-012				
POS	CABLENAME	FROM	TO	FORMATION
1	950-JE-03101/B400-FGS-002	950-JE-03101	B400-FGS-002	12x3x2.5 mm2
2	00-JE-11003_1/B400-PCS-002	00-JE-11003_1	B400-PCS-002	12x2x0.75mm2
3	00-JE-11003_2/B400-PCS-002	00-JE-11003_2	B400-PCS-002	12x2x0.75mm2
4	00-JE-12004_1/B400-PCS-002	00-JE-12004_1	B400-PCS-002	12x2x0.75mm2
5	00-JE-12004_2/B400-PCS-002	00-JE-12004_2	B400-PCS-002	12x2x0.75mm2
6	00-JE-12005/B400-PCS-002	00-JE-12005	B400-PCS-002	12x2x0.75mm2
7	00-JE-23002/B400-SIS-001	00-JE-23002	B400-SIS-001	12x2.5mm2
8	C-25-XV-004/00-JE-12004	25-XV-004	00-JE-12004	2x2x0.75mm2
9	C-25-XV-020/00-JE-12004	25-XV-020	00-JE-12004	2x2x0.75mm2
10	C-25-XV-024/00-JE-12005	25-XV-024	00-JE-12005	2x2x0.75mm2
11	C-950-GDZ-03101/950-JE-03101	950-GDZ-03101	950-JE-03101	3x2.5mm2
12	C-950-GDZ-03102/950-JE-03101	950-GDZ-03102	950-JE-03101	3x2.5mm2
13	C-950-GDZ-03103/950-JE-03101	950-GDZ-03103	950-JE-03101	3x2.5mm2
14	C-950-GDZ-03104/950-JE-03101	950-GDZ-03104	950-JE-03101	3x2.5mm2
15	C-950-GDZ-03105/950-JE-03101	950-GDZ-03105	950-JE-03101	3x2.5mm2
16	C-950-GDZ-03107/950-JE-03101	950-GDZ-03107	950-JE-03101	3x2.5mm2
17	C-950-GDZ-03108/950-JE-03101	950-GDZ-03108	950-JE-03101	3x2.5mm2
18	C-950-GDZ-02120/950-JE-02103	950-GDZ-02120	950-JE-02103	3x2.5mm2
19	C-950-GDZ-02111/950-JE-02102	950-GDZ-02111	950-JE-02102	3x2.5mm2
20	C-950-GDZ-02112/950-JE-02102	950-GDZ-02112	950-JE-02102	3x2.5mm2
21	C-950-GDZ-02113/950-JE-02102	950-GDZ-02113	950-JE-02102	3x2.5mm2
22	C-950-GDZ-02114/950-JE-02102	950-GDZ-02114	950-JE-02102	3x2.5mm2
23	C-25-SDY-001/00-JE-23002	25-SDY-001	00-JE-23002	2x2.5mm2
24	C-25-BDY-022/00-JE-23002	25-BDY-022	00-JE-23002	2x2.5mm2
25	C-25-SDY-023/00-JE-23002	25-SDY-023	00-JE-23002	2x2.5mm2
26	C-64-SDY-001/00-JE-23002	64-SDY-023	00-JE-23002	2x2.5mm2
27	C-25-XY-008/00-JE-13002	25-XY-008	00-JE-13002	2x2.5mm2
28	C-25-XY-011/00-JE-13002	25-XY-011	00-JE-13002	2x2.5mm2
29	C-25-XY-014/00-JE-13002	25-XY-014	00-JE-13002	2x2.5mm2
30	C-25-XY-017/00-JE-13002	25-XY-017	00-JE-13002	2x2.5mm2
31	C-25-FT-031/00-JE-11003	25-FT-031	00-JE-11003	1x2x0.75mm2
32	C-25-FT-036/00-JE-11003	25-FT-036	00-JE-11003	1x2x0.75mm2
33	C-25-FY-031/00-JE-11003	25-FY-031	00-JE-11003	1x2x0.75mm2
34	C-25-FY-036/00-JE-11003	25-FY-036	00-JE-11003	1x2x0.75mm2
35	C-25-ZT-031/00-JE-11003	25-ZT-031	00-JE-11003	1x2x0.75mm2
36	C-25-ZT-036/00-JE-11003	25-ZT-036	00-JE-11003	1x2x0.75mm2
37	C-25-PT-001/00-JE-11003	25-PT-001	00-JE-11003	1x2x0.75mm2
38	C-25-ZSL-031/00-JE-12004	25-ZSL-031	00-JE-12004	1x2x0.75mm2
39	C-25-ZSH-031/00-JE-12004	25-ZSH-031	00-JE-12004	1x2x0.75mm2
40	C-25-ZSL-036/00-JE-12005	25-ZSL-036	00-JE-12005	1x2x0.75mm2
41	C-25-ZSH-036/00-JE-12005	25-ZSH-036	00-JE-12005	1x2x0.75mm2

U-SEC-16-L-200-102-IST-030

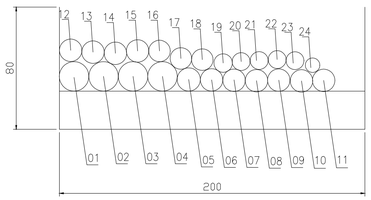

U-SEC-16-L-200-102-IST-030				
POS	CABLENAME	FROM	TO	FORMATION
1	C-25-SDV-001/00-JE-22002	25-SDV-001	00-JE-22002	2x2x0.75mm2
2	C-25-SDV-023/00-JE-22002	25-SDV-023	00-JE-22002	2x2x0.75mm2
3	C-25-BDV-022/00-JE-22002	25-BDV-022	00-JE-22002	2x2x0.75mm2
4	C-64-SDV-001/00-JE-22002	64-SDV-001	00-JE-22002	2x2x0.75mm2
5	C-25-XV-024/00-JE-12005	25-XV-024	00-JE-12005	2x2x0.75mm2
6	C-950-GDZ-02117/950-JE-02103	950-GDZ-02117	950-JE-02103	3x2.5mm2
7	C-950-GDZ-02118/950-JE-02103	950-GDZ-02118	950-JE-02103	3x2.5mm2
8	C-950-GDZ-02119/950-JE-02103	950-GDZ-02119	950-JE-02103	3x2.5mm2
9	C-950-GDZ-02110/950-JE-02102	950-GDZ-02110	950-JE-02102	3x2.5mm2
10	C-950-GDZ-02111/950-JE-02102	950-GDZ-02111	950-JE-02102	3x2.5mm2
11	C-950-GDZ-02112/950-JE-02102	950-GDZ-02112	950-JE-02102	3x2.5mm2
12	C-950-GDZ-02113/950-JE-02102	950-GDZ-02113	950-JE-02102	3x2.5mm2
13	C-950-GDZ-02114/950-JE-02102	950-GDZ-02114	950-JE-02102	3x2.5mm2
14	C-950-GDZ-02115/950-JE-02102	950-GDZ-02115	950-JE-02102	3x2.5mm2
15	C-950-GDZ-02116/950-JE-02102	950-GDZ-02116	950-JE-02102	3x2.5mm2
16	C-25-SDY-001/00-JE-23002	25-SDY-001	00-JE-23002	2x2.5mm2
17	C-25-BDY-022/00-JE-23002	25-BDY-022	00-JE-23002	2x2.5mm2
18	C-25-SDY-023/00-JE-23002	25-SDY-023	00-JE-23002	2x2.5mm2
19	C-64-SDY-001/00-JE-23002	64-SDY-023	00-JE-23002	2x2.5mm2
20	C-25-XY-024/00-JE-13002	25-XY-024	00-JE-13002	2x2.5mm2
21	C-25-PT-002/00-JE-21002	25-PT-002	00-JE-21002	1x2x0.75mm2
22	C-80-PT-002/00-JE-21002	80-PT-002	00-JE-21002	1x2x0.75mm2
23	C-43-LT-001/00-JE-21002	43-LT-002	00-JE-21002	1x2x0.75mm2
24	C-25-PT-001/00-JE-11003	25-PT-001	00-JE-11003	1x2x0.75mm2

U-SEC-17-L-150-102-IST-029

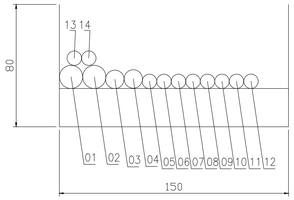

U-SEC-17-L-150-102-IST-029				
POS	CABLENAME	FROM	TO	FORMATION
1	C-25-XV-004/00-JE-12004	25-XV-004	00-JE-12004	2x2x0.75mm2
2	C-25-XV-020/00-JE-12004	25-XV-020	00-JE-12004	2x2x0.75mm2
3	C-25-XY-004/00-JE-13002	25-XY-004	00-JE-13002	2x2.5mm2
4	C-25-XY-020/00-JE-13002	25-XY-020	00-JE-13002	2x2.5mm2
5	C-25-FT-031/00-JE-11003	25-FT-031	00-JE-11003	1x2x0.75mm2
6	C-25-FT-036/00-JE-11003	25-FT-036	00-JE-11003	1x2x0.75mm2
7	C-25-FY-031/00-JE-11003	25-FY-031	00-JE-11003	1x2x0.75mm2
8	C-25-FY-036/00-JE-11003	25-FY-036	00-JE-11003	1x2x0.75mm2
9	C-25-ZT-031/00-JE-11003	25-ZT-031	00-JE-11003	1x2x0.75mm2
10	C-25-ZT-036/00-JE-11003	25-ZT-036	00-JE-11003	1x2x0.75mm2
11	C-25-ZSL-031/00-JE-12004	25-ZSL-031	00-JE-12004	1x2x0.75mm2
12	C-25-ZSH-031/00-JE-12004	25-ZSH-031	00-JE-12004	1x2x0.75mm2
13	C-25-ZSL-036/00-JE-12005	25-ZSL-036	00-JE-12005	1x2x0.75mm2
14	C-25-ZSH-036/00-JE-12005	25-ZSH-036	00-JE-12005	1x2x0.75mm2

INSERT SUBCONTRACTOR / VENDOR LOGO HERE

REV.	DATE	DRN	CHKD	APPD	DESCRIPTION
03	29/09/25	SPS	LCA	CGI	AS-BUILT (ASB)
02	04/10/24	VBA	LCA	DLO	ACCEPTED FOR CONSTRUCTION (AFC)
01	30/07/24	VBA	LCA	DLO	ACCEPTED FOR CONSTRUCTION (AFC)
00	22/12/23	VBA	LCA	DLO	ISSUE FOR REVIEW (IFR)

CROSSWIND

ROSETTI MARINO

TITLE :
BASE LOAD POWER HUB (BLPH)
INSTRUMENT MAIN CABLE ROUTING-UPPER DECK
TOS EL. 30.310M


CONTRACT NO./TITLE	CW-I-WP4-2023-05/HOLLANDSE KUST NOORD WIND PARK		SCALE 1:150
DRAWN SPS	CHECKED LCA	APPROVED CGI	DATE 29/09/25
A1	DRAWING NO. 123A90-DDL-IN-DL-40083	SHEET 009	REV. 03

File Name : 123A90-DDL-IN-DL-40083 REV03.dwg

DRAWING NO. 123A90-DDL-IN-DL-40083


REV. 03

U-SEC-14E-L-450-102-IST-012

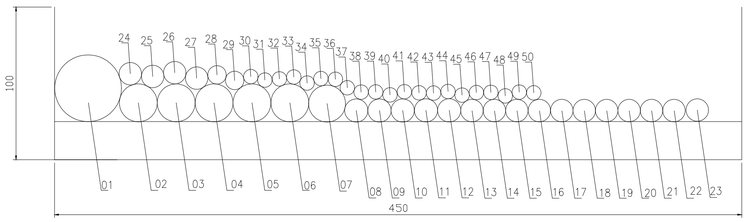


U-SEC-14E-L-450-102-IST-012				
POS	CABLENAME	FROM	TO	FORMATION
1	950-JE-03101/B400-FGS-002	950-JE-03101	B400-FGS-002	12x3x2.5 mm2
2	00-JE-11003_1/B400-PCS-002	00-JE-11003_1	B400-PCS-002	12x2x0.75mm2
3	00-JE-11003_2/B400-PCS-002	00-JE-11003_2	B400-PCS-002	12x2x0.75mm2
4	00-JE-12004_1/B400-PCS-002	00-JE-12004_1	B400-PCS-002	12x2x0.75mm2
5	00-JE-12004_2/B400-PCS-002	00-JE-12004_2	B400-PCS-002	12x2x0.75mm2
6	00-JE-12005/B400-PCS-002	00-JE-12005	B400-PCS-002	12x2x0.75mm2
7	00-JE-23002/B400-SIS-001	00-JE-23002	B400-SIS-001	12x2.5mm2
8	C-25-XV-004/00-JE-12004	25-XV-004	00-JE-12004	2x2x0.75mm2
9	C-25-XV-008/00-JE-12004	25-XV-008	00-JE-12004	2x2x0.75mm2
10	C-25-XV-017/00-JE-12004	25-XV-017	00-JE-12004	2x2x0.75mm2
11	C-25-XV-020/00-JE-12004	25-XV-020	00-JE-12004	2x2x0.75mm2
12	C-25-XV-024/00-JE-12005	25-XV-024	00-JE-12005	2x2x0.75mm2
13	C-950-GDZ-02120/950-JE-02103	950-GDZ-02120	950-JE-02103	3x2.5mm2
14	C-950-GDZ-03101/950-JE-03101	950-GDZ-03101	950-JE-03101	3x2.5mm2
15	C-950-GDZ-03102/950-JE-03101	950-GDZ-03102	950-JE-03101	3x2.5mm2
16	C-950-GDZ-03103/950-JE-03101	950-GDZ-03103	950-JE-03101	3x2.5mm2
17	C-950-GDZ-03104/950-JE-03101	950-GDZ-03104	950-JE-03101	3x2.5mm2
18	C-950-GDZ-03105/950-JE-03101	950-GDZ-03105	950-JE-03101	3x2.5mm2
19	C-950-GDZ-03107/950-JE-03101	950-GDZ-03107	950-JE-03101	3x2.5mm2
20	C-950-GDZ-03108/950-JE-03101	950-GDZ-03108	950-JE-03101	3x2.5mm2
21	C-950-GDZ-03109/950-JE-03101	950-GDZ-03109	950-JE-03101	3x2.5mm2
22	C-950-GDZ-02112/950-JE-02102	950-GDZ-02112	950-JE-02102	3x2.5mm2
23	C-950-GDZ-02113/950-JE-02102	950-GDZ-02113	950-JE-02102	3x2.5mm2
24	C-25-SDY-001/00-JE-23002	25-SDY-001	00-JE-23002	2x2.5mm2
25	C-25-BDY-022/00-JE-23002	25-BDY-022	00-JE-23002	2x2.5mm2
26	C-25-SDY-023/00-JE-23002	25-SDY-023	00-JE-23002	2x2.5mm2
27	C-64-SDY-001/00-JE-23002	64-SDY-023	00-JE-23002	2x2.5mm2
28	C-25-XY-011/00-JE-13002	25-XY-011	00-JE-13002	2x2.5mm2
29	C-25-XY-014/00-JE-13002	25-XY-014	00-JE-13002	2x2.5mm2
30	C-25-FT-031/00-JE-11003	25-FT-031	00-JE-11003	1x2x0.75mm2
31	C-25-FT-032/00-JE-11003	25-FT-032	00-JE-11003	1x2x0.75mm2
32	C-25-FT-038/00-JE-11003	25-FT-038	00-JE-11003	1x2x0.75mm2
33	C-25-FT-036/00-JE-11003	25-FT-036	00-JE-11003	1x2x0.75mm2
34	C-25-FY-031/00-JE-11003	25-FY-031	00-JE-11003	1x2x0.75mm2
35	C-25-FY-032/00-JE-11003	25-FY-032	00-JE-11003	1x2x0.75mm2
36	C-25-FY-038/00-JE-11003	25-FY-038	00-JE-11003	1x2x0.75mm2
37	C-25-FY-036/00-JE-11003	25-FY-036	00-JE-11003	1x2x0.75mm2
38	C-25-ZT-031/00-JE-11003	25-ZT-031	00-JE-11003	1x2x0.75mm2
39	C-25-ZT-032/00-JE-11003	25-ZT-032	00-JE-11003	1x2x0.75mm2
40	C-25-ZT-036/00-JE-11003	25-ZT-036	00-JE-11003	1x2x0.75mm2
41	C-25-ZT-038/00-JE-11003	25-ZT-038	00-JE-11003	1x2x0.75mm2
42	C-25-PT-001/00-JE-11003	25-PT-001	00-JE-11003	1x2x0.75mm2
43	C-25-ZSL-031/00-JE-12004	25-ZSL-031	00-JE-12004	1x2x0.75mm2
44	C-25-ZSH-031/00-JE-12004	25-ZSH-031	00-JE-12004	1x2x0.75mm2
45	C-25-ZSL-032/00-JE-12004	25-ZSL-032	00-JE-12004	1x2x0.75mm2
46	C-25-ZSH-032/00-JE-12004	25-ZSH-032	00-JE-12004	1x2x0.75mm2
47	C-25-ZSL-036/00-JE-12005	25-ZSL-036	00-JE-12005	1x2x0.75mm2
48	C-25-ZSH-036/00-JE-12005	25-ZSH-036	00-JE-12005	1x2x0.75mm2
49	C-25-ZSL-038/00-JE-12005	25-ZSL-038	00-JE-12005	1x2x0.75mm2
50	C-25-ZSH-038/00-JE-12005	25-ZSH-038	00-JE-12005	1x2x0.75mm2

U-SEC-14F-L-450-102-IST-012

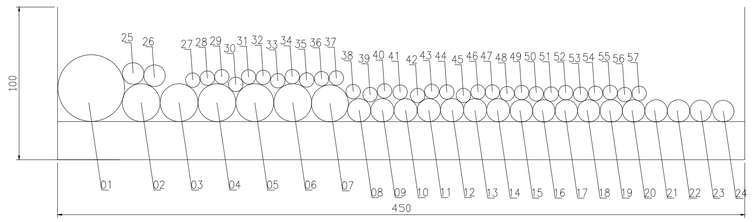

U-SEC-14F-L-450-102-IST-012				
POS	CABLENAME	FROM	TO	FORMATION
1	950-JE-03101/B400-FGS-002	950-JE-03101	B400-FGS-002	12x3x2.5 mm2
2	00-JE-11003_1/B400-PCS-002	00-JE-11003_1	B400-PCS-002	12x2x0.75mm2
3	00-JE-11003_2/B400-PCS-002	00-JE-11003_2	B400-PCS-002	12x2x0.75mm2
4	00-JE-12004_1/B400-PCS-002	00-JE-12004_1	B400-PCS-002	12x2x0.75mm2
5	00-JE-12004_2/B400-PCS-002	00-JE-12004_2	B400-PCS-002	12x2x0.75mm2
6	00-JE-12005/B400-PCS-002	00-JE-12005	B400-PCS-002	12x2x0.75mm2
7	00-JE-23002/B400-SIS-001	00-JE-23002	B400-SIS-001	12x2.5mm2
8	C-25-XV-004/00-JE-12004	25-XV-004	00-JE-12004	2x2x0.75mm2
9	C-25-XV-008/00-JE-12004	25-XV-008	00-JE-12004	2x2x0.75mm2
10	C-25-XV-011/00-JE-12004	25-XV-011	00-JE-12004	2x2x0.75mm2
11	C-25-XV-014/00-JE-12004	25-XV-014	00-JE-12004	2x2x0.75mm2
12	C-25-XV-017/00-JE-12004	25-XV-017	00-JE-12004	2x2x0.75mm2
13	C-25-XV-020/00-JE-12004	25-XV-020	00-JE-12004	2x2x0.75mm2
14	C-25-XV-024/00-JE-12005	25-XV-024	00-JE-12005	2x2x0.75mm2
15	C-950-GDZ-03101/950-JE-03101	950-GDZ-03101	950-JE-03101	3x2.5mm2
16	C-950-GDZ-03102/950-JE-03101	950-GDZ-03102	950-JE-03101	3x2.5mm2
17	C-950-GDZ-03103/950-JE-03101	950-GDZ-03103	950-JE-03101	3x2.5mm2
18	C-950-GDZ-03104/950-JE-03101	950-GDZ-03104	950-JE-03101	3x2.5mm2
19	C-950-GDZ-03105/950-JE-03101	950-GDZ-03105	950-JE-03101	3x2.5mm2
20	C-950-GDZ-03107/950-JE-03101	950-GDZ-03107	950-JE-03101	3x2.5mm2
21	C-950-GDZ-03108/950-JE-03101	950-GDZ-03108	950-JE-03101	3x2.5mm2
22	C-950-GDZ-03109/950-JE-03101	950-GDZ-03109	950-JE-03101	3x2.5mm2
23	C-25-SDY-001/00-JE-23002	25-SDY-001	00-JE-23002	2x2.5mm2
24	C-25-BDY-022/00-JE-23002	25-BDY-022	00-JE-23002	2x2.5mm2
25	C-25-SDY-023/00-JE-23002	25-SDY-023	00-JE-23002	2x2.5mm2
26	C-64-SDY-001/00-JE-23002	64-SDY-023	00-JE-23002	2x2.5mm2
27	C-25-FT-031/00-JE-11003	25-FT-031	00-JE-11003	1x2x0.75mm2
28	C-25-FT-032/00-JE-11003	25-FT-032	00-JE-11003	1x2x0.75mm2
29	C-25-FT-033/00-JE-11003	25-FT-033	00-JE-11003	1x2x0.75mm2
30	C-25-FT-034/00-JE-11003	25-FT-034	00-JE-11003	1x2x0.75mm2
31	C-25-FT-038/00-JE-11003	25-FT-038	00-JE-11003	1x2x0.75mm2
32	C-25-FT-036/00-JE-11003	25-FT-036	00-JE-11003	1x2x0.75mm2
33	C-25-FY-031/00-JE-11003	25-FY-031	00-JE-11003	1x2x0.75mm2
34	C-25-FY-032/00-JE-11003	25-FY-032	00-JE-11003	1x2x0.75mm2
35	C-25-FY-033/00-JE-11003	25-FY-033	00-JE-11003	1x2x0.75mm2
36	C-25-FY-038/00-JE-11003	25-FY-038	00-JE-11003	1x2x0.75mm2
37	C-25-FY-036/00-JE-11003	25-FY-036	00-JE-11003	1x2x0.75mm2
38	C-25-FY-034/00-JE-11003	25-FY-034	00-JE-11003	1x2x0.75mm2
39	C-25-ZT-031/00-JE-11003	25-ZT-031	00-JE-11003	1x2x0.75mm2
40	C-25-ZT-032/00-JE-11003	25-ZT-032	00-JE-11003	1x2x0.75mm2
41	C-25-ZT-033/00-JE-11003	25-ZT-033	00-JE-11003	1x2x0.75mm2
42	C-25-ZT-034/00-JE-11003	25-ZT-034	00-JE-11003	1x2x0.75mm2
43	C-25-ZT-036/00-JE-11003	25-ZT-036	00-JE-11003	1x2x0.75mm2
44	C-25-ZT-038/00-JE-11003	25-ZT-038	00-JE-11003	1x2x0.75mm2
45	C-25-PT-001/00-JE-11003	25-PT-001	00-JE-11003	1x2x0.75mm2
46	C-25-ZSL-031/00-JE-12004	25-ZSL-031	00-JE-12004	1x2x0.75mm2
47	C-25-ZSH-031/00-JE-12004	25-ZSH-031	00-JE-12004	1x2x0.75mm2
48	C-25-ZSL-032/00-JE-12004	25-ZSL-032	00-JE-12004	1x2x0.75mm2
49	C-25-ZSH-032/00-JE-12004	25-ZSH-032	00-JE-12004	1x2x0.75mm2
50	C-25-ZSL-033/00-JE-12004	25-ZSL-033	00-JE-12004	1x2x0.75mm2
51	C-25-ZSH-033/00-JE-12004	25-ZSH-033	00-JE-12004	1x2x0.75mm2
52	C-25-ZSL-034/00-JE-12004	25-ZSL-034	00-JE-12004	1x2x0.75mm2
53	C-25-ZSH-034/00-JE-12004	25-ZSH-034	00-JE-12004	1x2x0.75mm2
54	C-25-ZSL-036/00-JE-12005	25-ZSL-036	00-JE-12005	1x2x0.75mm2
55	C-25-ZSH-036/00-JE-12005	25-ZSH-036	00-JE-12005	1x2x0.75mm2
56	C-25-ZSL-038/00-JE-12005	25-ZSL-038	00-JE-12005	1x2x0.75mm2
57	C-25-ZSH-038/00-JE-12005	25-ZSH-038	00-JE-12005	1x2x0.75mm2

U-SEC-15-L-450-102-IST-011

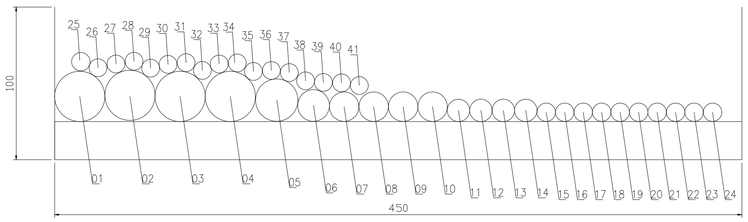

U-SEC-15-L-450-102-IST-011				
POS	CABLENAME	FROM	TO	FORMATION
1	00-JE-21002/B400-SIS-001	00-JE-21002	B400-SIS-001	12x2x0.75mm2
2	00-JE-22002_1/B400-SIS-001	00-JE-22002_1	B400-SIS-001	12x2x0.75mm2
3	00-JE-22002_2/B400-SIS-001	00-JE-22002_2	B400-SIS-001	12x2x0.75mm2
4	950-JE-02103/B400-FGS-002	950-JE-02103	B400-FGS-002	6x3x2.5mm2
5	00-JE-13002/B400-PCS-002	00-JE-13002	B400-PCS-002	24x2.5mm2
6	00-JE-13003/B400-PCS-002	00-JE-13003	B400-PCS-002	12x2.5mm2
7	C-25-SDV-001/00-JE-22002	25-SDV-001	00-JE-22002	2x2x0.75mm2
8	C-25-SDV-023/00-JE-22002	25-SDV-023	00-JE-22002	2x2x0.75mm2
9	C-25-BDV-022/00-JE-22002	25-BDV-022	00-JE-22002	2x2x0.75mm2
10	C-64-SDV-001/00-JE-22002	64-SDV-001	00-JE-22002	2x2x0.75mm2
11	C-950-GDZ-02117/950-JE-02103	950-GDZ-02117	950-JE-02103	3x2.5mm2
12	C-950-GDZ-02118/950-JE-02103	950-GDZ-02118	950-JE-02103	3x2.5mm2
13	C-950-GDZ-02119/950-JE-02103	950-GDZ-02119	950-JE-02103	3x2.5mm2
14	C-950-GDZ-02120/950-JE-02103	950-GDZ-02120	950-JE-02103	3x2.5mm2
15	C-25-XY-004/00-JE-13002	25-XY-004	00-JE-13002	2x2.5mm2
16	C-25-XY-008/00-JE-13002	25-XY-008	00-JE-13002	2x2.5mm2
17	C-25-XY-011/00-JE-13002	25-XY-011	00-JE-13002	2x2.5mm2
18	C-25-XY-014/00-JE-13002	25-XY-014	00-JE-13002	2x2.5mm2
19	C-25-XY-017/00-JE-13002	25-XY-017	00-JE-13002	2x2.5mm2
20	C-25-XY-020/00-JE-13002	25-XY-020	00-JE-13002	2x2.5mm2
21	C-25-XY-024/00-JE-13002	25-XY-024	00-JE-13002	2x2.5mm2
22	C-50-XY-001/00-JE-13003	50-XY-001	00-JE-13003	2x2.5mm2
23	C-50-XY-002/00-JE-13003	50-XY-002	00-JE-13003	2x2.5mm2
24	C-50-XY-003/00-JE-13003	50-XY-003	00-JE-13003	2x2.5mm2
25	C-50-XY-004/00-JE-13003	50-XY-004	00-JE-13003	2x2.5mm2
26	C-25-PT-002/00-JE-21002	25-PT-002	00-JE-21002	1x2x0.75mm2
27	C-80-PT-002/00-JE-21002	80-PT-002	00-JE-21002	1x2x0.75mm2
28	C-43-LT-001/00-JE-21002	43-LT-002	00-JE-21002	1x2x0.75mm2
29	C-64-PT-002/00-JE-21002	64-PT-002	00-JE-21002	1x2x0.75mm2
30	C-950-ASD-03101/00-JE-22002	950-ASD-03101	00-JE-22002	1x2x0.75mm2
31	C-950-MOB-03101/00-JE-22002	950-MOB-03101	00-JE-22002	1x2x0.75mm2
32	C-950-ESD-03101/00-JE-22002	950-ESD-03101	00-JE-22002	1x2x0.75mm2
33	C-950-ESDD-03101/00-JE-22002	950-ESDD-03101	00-JE-22002	1x2x0.75mm2
34	C-950-ASD-06101/00-JE-22002	950-ASD-06101	00-JE-22002	1x2x0.75mm2
35	C-950-MOB-06101/00-JE-22002	950-MOB-06101	00-JE-22002	1x2x0.75mm2
36	C-950-ESD-06101/00-JE-22002	950-ESD-06101	00-JE-22002	1x2x0.75mm2
37	C-950-ESDD-06101/00-JE-22002	950-ESDD-06101	00-JE-22002	1x2x0.75mm2
38	C-950-ASD-07101/00-JE-22002	950-ASD-07101	00-JE-22002	1x2x0.75mm2
39	C-950-MOB-07101/00-JE-22002	950-MOB-07101	00-JE-22002	1x2x0.75mm2
40	C-950-ESD-07101/00-JE-22002	950-ESD-07101	00-JE-22002	1x2x0.75mm2
41	C-950-ESDD-07101/00-JE-22002	950-ESDD-07101	00-JE-22002	1x2x0.75mm2

INSERT SUBCONTRACTOR / VENDOR LOGO HERE

REV.	DATE	DRN	CHKD	APPD	DESCRIPTION
03	29/09/25	SPS	LCA	CGI	AS-BUILT (ASB)
02	04/10/24	VBA	LCA	DLO	ACCEPTED FOR CONSTRUCTION (AFC)
01	30/07/24	VBA	LCA	DLO	ACCEPTED FOR CONSTRUCTION (AFC)
00	22/12/23	VBA	LCA	DLO	ISSUE FOR REVIEW (IFR)

CROSSWIND

ROSETTI MARINO

TITLE :
BASE LOAD POWER HUB (BLPH)
INSTRUMENT MAIN CABLE ROUTING-UPPER DECK
TOS EL. 30.310M

CONTRACT NO./TITLE CW-I-WP4-2023-05/HOLLANDSE KUST NOORD WIND PARK | SCALE 1:150

DRAWN SPS | CHECKED LCA | APPROVED CGI | DATE 29/09/25


A1 | DRAWING NO. 123A90-DDL-IN-DL-40083 | SHEET 010 | REV. 03

File Name : 123A90-DDL-IN-DL-40083_REV03.dwg

DRAWING NO. 123A90-DDL-IN-DL-40083


REV. 03

U-SEC-18-L-150-102-IST-028

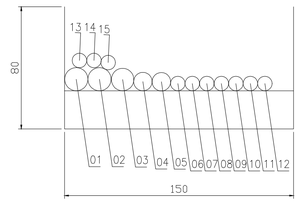


U-SEC-18-L-150-102-IST-028				
POS	CABLENAME	FROM	TO	FORMATION
1	C-25-XV-008/00-JE-12004	25-XV-008	00-JE-12004	2x2x0.75mm2
2	C-25-XV-017/00-JE-12004	25-XV-017	00-JE-12004	2x2x0.75mm2
3	C-950-GDZ-02111/950-JE-02102	950-GDZ-02111	950-JE-02102	3x2.5mm2
4	C-25-XY-008/00-JE-13002	25-XY-008	00-JE-13002	2x2.5mm2
5	C-25-XY-017/00-JE-13002	25-XY-017	00-JE-13002	2x2.5mm2
6	C-25-FT-032/00-JE-11003	25-FT-032	00-JE-11003	1x2x0.75mm2
7	C-25-FT-038/00-JE-11003	25-FT-038	00-JE-11003	1x2x0.75mm2
8	C-25-FY-032/00-JE-11003	25-FY-032	00-JE-11003	1x2x0.75mm2
9	C-25-FY-038/00-JE-11003	25-FY-038	00-JE-11003	1x2x0.75mm2
10	C-25-ZT-032/00-JE-11003	25-ZT-032	00-JE-11003	1x2x0.75mm2
11	C-25-ZT-038/00-JE-11003	25-ZT-038	00-JE-11003	1x2x0.75mm2
12	C-25-ZSL-032/00-JE-12004	25-ZSL-032	00-JE-12004	1x2x0.75mm2
13	C-25-ZSH-032/00-JE-12004	25-ZSH-032	00-JE-12004	1x2x0.75mm2
14	C-25-ZSL-038/00-JE-12005	25-ZSL-038	00-JE-12005	1x2x0.75mm2
15	C-25-ZSH-038/00-JE-12005	25-ZSH-038	00-JE-12005	1x2x0.75mm2

U-SEC-19-L-150-102-IST-027

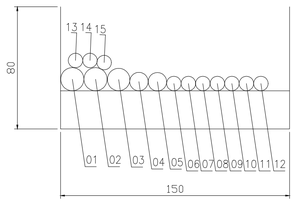


U-SEC-19-L-150-102-IST-027				
POS	CABLENAME	FROM	TO	FORMATION
1	C-25-XV-011/00-JE-12004	25-XV-011	00-JE-12004	2x2x0.75mm2
2	C-25-XV-014/00-JE-12004	25-XV-014	00-JE-12004	2x2x0.75mm2
3	C-950-GDZ-02120/950-JE-02103	950-GDZ-02120	950-JE-02103	3x2.5mm2
4	C-25-XY-011/00-JE-13002	25-XY-011	00-JE-13002	2x2.5mm2
5	C-25-XY-014/00-JE-13002	25-XY-014	00-JE-13002	2x2.5mm2
6	C-25-FT-033/00-JE-11003	25-FT-033	00-JE-11003	1x2x0.75mm2
7	C-25-FT-034/00-JE-11003	25-FT-034	00-JE-11003	1x2x0.75mm2
8	C-25-FY-033/00-JE-11003	25-FY-033	00-JE-11003	1x2x0.75mm2
9	C-25-FY-034/00-JE-11003	25-FY-034	00-JE-11003	1x2x0.75mm2
10	C-25-ZT-033/00-JE-11003	25-ZT-033	00-JE-11003	1x2x0.75mm2
11	C-25-ZT-034/00-JE-11003	25-ZT-034	00-JE-11003	1x2x0.75mm2
12	C-25-ZSL-033/00-JE-12004	25-ZSL-033	00-JE-12004	1x2x0.75mm2
13	C-25-ZSH-033/00-JE-12004	25-ZSH-033	00-JE-12004	1x2x0.75mm2
14	C-25-ZSL-034/00-JE-12004	25-ZSL-034	00-JE-12004	1x2x0.75mm2
15	C-25-ZSH-034/00-JE-12004	25-ZSH-034	00-JE-12004	1x2x0.75mm2

U-SEC-20A-L-200-102-IST-015

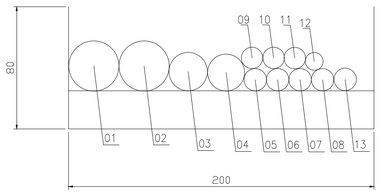


U-SEC-20A-L-200-102-IST-015				
POS	CABLENAME	FROM	TO	FORMATION
1	950-JE-01101/B400-FGS-002	950-JE-01101	B400-FGS-002	6x3x2,5mm2
2	950-JE-01102/B400-FGS-002	950-JE-01102	B400-FGS-002	6x3x2,5mm2
3	950-JE-01103/B400-FGS-002	950-JE-01103	B400-FGS-002	6x2x0,75mm2
4	950-JE-01104/B400-FGS-002	950-JE-01104	B400-FGS-002	12x2,5mm2
5	C-950-FDZ-02101/950-JE-02101	950-FDZ-02101	950-JE-02101	3x2.5mm2
6	C-950-XL-01101/950-JE-01104	950-XL-01101	950-JE-01104	2x2.5mm2
7	C-950-XL-01102/950-JE-01104	950-XL-01102	950-JE-01104	2x2.5mm2
8	C-950-XZ-01101/950-JE-01104	950-XZ-01101	950-JE-01104	2x2.5mm2
9	C-950-MFA-01101/950-JE-01103	950-MFA-01101	950-JE-01103	1x2x0.75mm2
10	C-950-FDZ-01101/950-JE-01101	950-FDZ-01101	950-JE-01101	3x2.5mm2
11	C-950-FDZ-01104/950-JE-01101	950-FDZ-01104	950-JE-01101	3x2.5mm2
12	C-GPSANT/B400-NET-001	GPSANT	B400-NET-001	STD-VENDOR

U-SEC-20B-L-200-102-IST-015

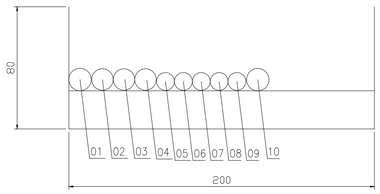


U-SEC-20B-L-200-102-IST-015				
POS	CABLENAME	FROM	TO	FORMATION
1	C-950-FDZ-01101/950-JE-01101	950-FDZ-01101	950-JE-01101	3x2.5mm2
2	C-950-XL-01101/950-JE-01104	950-XL-01101	950-JE-01104	2x2.5mm2
3	C-950-XL-01102/950-JE-01104	950-XL-01102	950-JE-01104	2x2.5mm2
4	C-950-XZ-01101/950-JE-01104	950-XZ-01101	950-JE-01104	2x2.5mm2
5	C-950-ASD-01101/00-JE-22001	950-ASD-01101	00-JE-22001	1x2x0,75mm2
6	C-950-MOB-01101/00-JE-22001	950-MOB-01101	00-JE-22001	1x2x0,75mm2
7	C-950-ESD-01101/00-JE-22001	950-ESD-01101	00-JE-22001	1x2x0,75mm2
8	C-950-ESDD-01101/00-JE-22001	950-ESDD-01101	00-JE-22001	1x2x0,75mm2
9	C-950-MFA-01101/950-JE-01103	950-MFA-01101	950-JE-01103	1x2x0.75mm2
10	C-950-FDZ-01104/950-JE-01101	950-FDZ-01104	950-JE-01101	3x2.5mm2

U-SEC-20C-L-200-102-IST-015

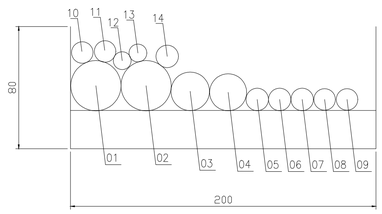


U-SEC-20C-L-200-102-IST-015				
POS	CABLENAME	FROM	TO	FORMATION
1	950-JE-01101/B400-FGS-002	950-JE-01101	B400-FGS-002	6x3x2,5mm2
2	950-JE-01102/B400-FGS-002	950-JE-01102	B400-FGS-002	6x3x2,5mm2
3	950-JE-01103/B400-FGS-002	950-JE-01103	B400-FGS-002	6x2x0,75mm2
4	950-JE-01104/B400-FGS-002	950-JE-01104	B400-FGS-002	12x2,5mm2
5	C-950-FDZ-02101/950-JE-02101	950-FDZ-02101	950-JE-02101	3x2.5mm2
6	C-950-FDZ-01101/950-JE-01101	950-FDZ-01101	950-JE-01101	3x2.5mm2
7	C-950-FDZ-01102/950-JE-01101	950-FDZ-01102	950-JE-01101	3x2.5mm2
8	C-950-XL-01101/950-JE-01104	950-XL-01101	950-JE-01104	2x2.5mm2
9	C-950-XL-01102/950-JE-01104	950-XL-01102	950-JE-01104	2x2.5mm2
10	C-950-XZ-01101/950-JE-01104	950-XZ-01101	950-JE-01104	2x2.5mm2
11	C-950-XZ-01102/950-JE-01104	950-XZ-01102	950-JE-01104	2x2.5mm2
12	C-950-MFA-01101/950-JE-01103	950-MFA-01101	950-JE-01103	1x2x0.75mm2
13	C-950-MFA-01102/950-JE-01103	950-MFA-01102	950-JE-01103	1x2x0.75mm2
14	C-950-FDZ-01104/950-JE-01101	950-FDZ-01104	950-JE-01101	3x2.5mm2
15	C-GPSANT/B400-NET-001	GPSANT	B400-NET-001	STD-VENDOR

U-SEC-20D-L-200-102-IST-015

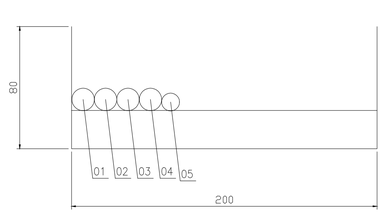

U-SEC-20D-L-200-102-IST-015				
POS	CABLENAME	FROM	TO	FORMATION
1	C-950-GDZ-01103/950-JE-01102	950-GDZ-01103	950-JE-01102	3x2.5mm2
2	C-950-FDZ-01103/950-JE-01101	950-FDZ-01103	950-JE-01101	3x2.5mm2
3	C-950-GDZ-01102/950-JE-01102	950-GDZ-01102	950-JE-01102	3x2.5mm2
4	C-950-GDZ-01101/950-JE-01102	950-GDZ-011031	950-JE-01102	3x2.5mm2
5	C-950-MFA-01103/950-JE-01103	950-MFA-01103	950-JE-01103	1x2x0.75mm2

U-SEC-20E-L-200-102-IST-015

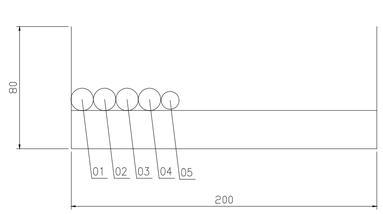

U-SEC-20E-L-200-102-IST-015				
POS	CABLENAME	FROM	TO	FORMATION
1	C-950-FDZ-01103/950-JE-01101	950-FDZ-01103	950-JE-01101	3x2.5mm2
2	C-950-GDZ-01102/950-JE-01102	950-GDZ-01102	950-JE-01102	3x2.5mm2
3	C-950-GDZ-01103/950-JE-01102	950-GDZ-01103	950-JE-01102	3x2.5mm2
4	C-950-GDZ-01101/950-JE-01102	950-GDZ-011031	950-JE-01102	3x2.5mm2
5	C-950-MFA-01103/950-JE-01103	950-MFA-01103	950-JE-01103	1x2x0.75mm2

INSERT SUBCONTRACTOR / VENDOR LOGO HERE

REV.	DATE	DRN	CHKD	APPD	DESCRIPTION
03	29/09/25	SPS	LCA	CGI	AS-BUILT (ASB)
02	04/10/24	VBA	LCA	DLO	ACCEPTED FOR CONSTRUCTION (AFC)
01	30/07/24	VBA	LCA	DLO	ACCEPTED FOR CONSTRUCTION (AFC)
00	22/12/23	VBA	LCA	DLO	ISSUE FOR REVIEW (IFR)

CROSSWIND

ROSETTI MARINO

TITLE :
BASE LOAD POWER HUB (BLPH)
INSTRUMENT MAIN CABLE ROUTING-UPPER DECK
TOS EL. 30.310M

CONTRACT NO./TITLE CW-I-WP4-2023-05/HOLLANDSE KUST NOORD WIND PARK | SCALE 1:150

DRAWN SPS | CHECKED LCA | APPROVED CGI | DATE 29/09/25


A1 | DRAWING NO. 123A90-DDL-IN-DL-40083 | SHEET 011 | REV. 03

File Name : 123A90-DDL-IN-DL-40083 REV:03.dwg

DRAWING NO. 123A90-DDL-IN-DL-40083


REV. 03

U-SEC-20F-L-200-102-IST-015

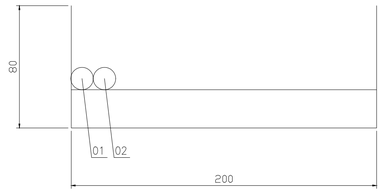


U-SEC-20F-L-200-102-IST-015				
POS	CABLENAME	FROM	TO	FORMATION
1	C-950-FDZ-01104/950-JE-01101	950-FDZ-01104	950-JE-01101	3x2.5mm2
2	C-950-FDZ-02103/950-JE-02101	950-FDZ-02102	950-JE-02101	3x2.5mm2

U-SEC-20G-L-200-102-IST-015

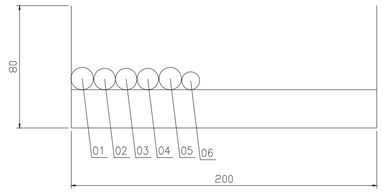

U-SEC-20G-L-200-102-IST-015				
POS	CABLENAME	FROM	TO	FORMATION
1	C-950-FDZ-01104/950-JE-01101	950-FDZ-01104	950-JE-01101	3x2.5mm2
2	C-950-XZ-02101/950-JE-02104	C-950-XZ-02101	950-JE-02104	2x2.5mm2
3	C-950-XL-02101/950-JE-02104	C-950-XL-02101	950-JE-02104	2x2.5mm2
4	C-950-XL-02102/950-JE-02104	C-950-XL-02102	950-JE-02104	2x2.5mm2
5	C-950-FDZ-02103/950-JE-02101	950-FDZ-02103	950-JE-02101	3x2.5mm2
6	C-950-MFA-02101/B400-FGS-002	950-MFA-02101	B400-FGS-002	1x2x0.75mm2

U-SEC-20H-L-200-102-IST-015

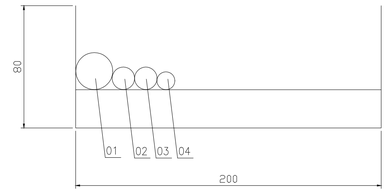


U-SEC-20H-L-200-102-IST-015				
POS	CABLENAME	FROM	TO	FORMATION
1	950-JE-02104/B400-FGS-002	950-JE-02104	B400-FGS-002	12x2.5mm2
2	C-950-FDZ-01104/950-JE-01101	950-FDZ-01104	950-JE-01101	3x2.5mm2
3	C-950-FDZ-02104/950-JE-02101	950-FDZ-02104	950-JE-02101	3x2.5mm2
4	C-950-MFA-02101/B400-FGS-002	950-MFA-02101	B400-FGS-002	1x2x0.75mm2

U-SEC-20I-L-200-102-IST-015




U-SEC-20I-L-200-102-IST-015				
POS	CABLENAME	FROM	TO	FORMATION
1	C-950-FDZ-02104/950-JE-02101	950-FDZ-02104	950-JE-02101	3x2.5mm2

U-SEC-20J-L-200-102-IST-015

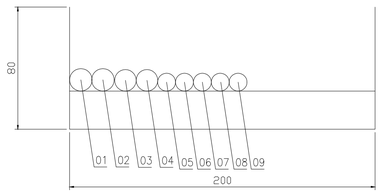


U-SEC-20J-L-200-102-IST-015				
POS	CABLENAME	FROM	TO	FORMATION
1	C-950-FDZ-03104/950-JE-03102	950-FDZ-03104	950-JE-03102	3x2.5mm2
2	C-950-FDZ-02104/950-JE-02101	950-FDZ-02104	950-JE-02101	3x2.5mm2
3	C-950-XL-03103/950-JE-03104	950-XL-03103	950-JE-03104	2x2.5mm2
4	C-950-XL-03104/950-JE-03104	950-XL-03104	950-JE-03104	2x2.5mm2
5	C-950-MOB-03101/00-JE-22002	950-MOB-03101	00-JE-22002	1x2x0,75mm2
6	C-950-ESD-03101/00-JE-22002	950-ESD-03101	00-JE-22002	1x2x0,75mm2
7	C-950-ESDD-03101/00-JE-22002	950-ESDD-03101	00-JE-22002	1x2x0,75mm2
8	C-950-ASD-03101/00-JE-22002	950-ASD-03101	00-JE-22002	1x2x0,75mm2
9	C-950-MFA-03104/950-JE-03103	950-MFA-03104	950-JE-03103	1x2x0.75mm2

U-SEC-20K-L-200-102-IST-015

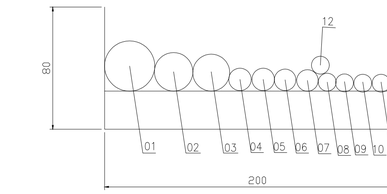

U-SEC-20K-L-200-102-IST-015				
POS	CABLENAME	FROM	TO	FORMATION
1	950-JE-03102/B400-FGS-002	950-JE-031002	B400-FGS-002	6x3x2,5mm2
2	950-JE-03103/B400-FGS-002	950-JE-031003	B400-FGS-002	6x2x0,75mm2
3	950-JE-03104/B400-FGS-002	950-JE-031004	B400-FGS-002	12x2,5mm2
4	C-950-FDZ-03104/950-JE-03102	950-FDZ-03104	950-JE-03102	3x2.5mm2
5	C-950-FDZ-02104/950-JE-02101	950-FDZ-02104	950-JE-02101	3x2.5mm2
6	C-950-XL-03103/950-JE-03104	950-XZ-03103	950-JE-03104	2x2.5mm2
7	C-950-XL-03104/950-JE-03104	950-XZ-03104	950-JE-03104	2x2.5mm2
8	C-950-MFA-03104/950-JE-03103	950-MFA-03104	950-JE-03103	1x2x0.75mm2
9	C-950-MOB-03101/00-JE-22002	950-MOB-03101	00-JE-22002	1x2x0,75mm2
10	C-950-ESD-03101/00-JE-22002	950-ESD-03101	00-JE-22002	1x2x0,75mm2
11	C-950-ESDD-03101/00-JE-22002	950-ESDD-03101	00-JE-22002	1x2x0,75mm2
12	C-950-ASD-03101/00-JE-22002	950-ASD-03101	00-JE-22002	1x2x0,75mm2

U-SEC-20L-L-200-102-IST-015

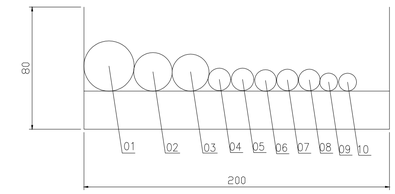

U-SEC-20L-L-200-102-IST-015				
POS	CABLENAME	FROM	TO	FORMATION
1	950-JE-03102/B400-FGS-002	950-JE-031002	B400-FGS-002	6x3x2,5mm2
2	950-JE-03103/B400-FGS-002	950-JE-031003	B400-FGS-002	6x2x0,75mm2
3	950-JE-03104/B400-FGS-002	950-JE-031004	B400-FGS-002	12x2,5mm2
4	C-950-FDZ-03103/950-JE-03102	950-FDZ-03103	950-JE-03102	3x2.5mm2
5	C-950-FDZ-03104/950-JE-03102	950-FDZ-03103	950-JE-03102	3x2.5mm2
6	C-950-XZ-03101/950-JE-03104	950-XZ-03101	950-JE-03104	2x2.5mm2
7	C-950-XL-03103/950-JE-03104	950-XZ-03103	950-JE-03104	2x2.5mm2
8	C-950-XL-03104/950-JE-03104	950-XZ-03104	950-JE-03104	2x2.5mm2
9	C-950-MFA-03101/950-JE-03103	950-MFA-03101	950-JE-03103	1x2x0.75mm2
10	C-950-MFA-03104/950-JE-03103	950-MFA-03104	950-JE-03103	1x2x0.75mm2

INSERT SUBCONTRACTOR / VENDOR LOGO HERE

REV.	DATE	DRN	CHKD	APPD	DESCRIPTION
03	29/09/25	SPS	LCA	CGI	AS-BUILT (ASB)
02	04/10/24	VBA	LCA	DLO	ACCEPTED FOR CONSTRUCTION (AFC)
01	30/07/24	VBA	LCA	DLO	ACCEPTED FOR CONSTRUCTION (AFC)
00	22/12/23	VBA	LCA	DLO	ISSUE FOR REVIEW (IFR)

CROSSWIND

ROSETTI MARINO

TITLE :
BASE LOAD POWER HUB (BLPH)
INSTRUMENT MAIN CABLE ROUTING-UPPER DECK
TOS EL. 30.310M

CONTRACT NO./TITLE CW-I-WP4-2023-05/HOLLANDSE KUST NOORD WIND PARK | SCALE 1:150

DRAWN SPS | CHECKED LCA | APPROVED CGI | DATE 29/09/25


A1 | DRAWING NO. 123A90-DDL-IN-DL-40083 | SHEET 012 | REV. 03

File Name : 123A90-DDL-IN-DL-40083 REV03.dwg

DRAWING NO. 123A90-DDL-IN-DL-40083


REV. 03

U-SEC-20M-L-200-102-IST-015

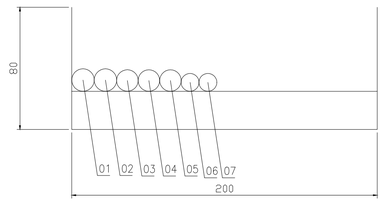


U-SEC-20M-L-200-102-IST-015				
POS	CABLENAME	FROM	TO	FORMATION
1	C-950-FDZ-03101/950-JE-03102	950-FDZ-03101	950-JE-03102	3x2.5mm2
2	C-950-FDZ-03102/950-JE-03102	950-FDZ-03102	950-JE-03102	3x2.5mm2
3	C-950-XZ-03102/950-JE-03104	950-XZ-03102	950-JE-03104	2x2.5mm2
4	C-950-XL-03101/950-JE-03104	950-XL-03101	950-JE-03104	2x2.5mm2
5	C-950-XL-03102/950-JE-03104	950-XL-03102	950-JE-03104	2x2.5mm2
6	C-950-MFA-03102/950-JE-03103	950-MFA-03102	950-JE-03103	1x2x0.75mm2
7	C-950-MFA-03103/950-JE-03103	950-MFA-03103	950-JE-03103	1x2x0.75mm2

U-SEC-20N-L-200-102-IST-015

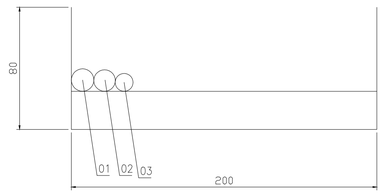


U-SEC-20N-L-200-102-IST-015				
POS	CABLENAME	FROM	TO	FORMATION
1	C-950-FDZ-03101/950-JE-03102	950-FDZ-03101	950-JE-03102	3x2.5mm2
2	C-950-XZ-03102/950-JE-03104	950-XZ-03102	950-JE-03104	2x2.5mm2
3	C-950-MFA-03102/950-JE-03103	950-MFA-03102	950-JE-03103	1x2x0.75mm2

U-SEC-20O-L-200-102-IST-015

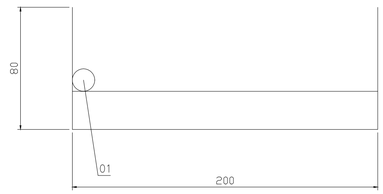


U-SEC-20O-L-200-102-IST-015				
POS	CABLENAME	FROM	TO	FORMATION
1	C-950-FDZ-02102/950-JE-02101	950-FDZ-02102	950-JE-02101	3x2.5mm2

U-SEC-21A-L-200-103-IST-011

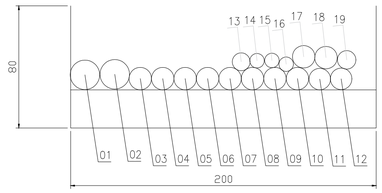


U-SEC-21A-L-200-103-IST-011				
POS	CABLENAME	FROM	TO	FORMATION
1	C-25-SDV-023/00-JE-22002	25-SDV-023	00-JE-22002	2x2x0.75mm2
2	C-25-BDV-022/00-JE-22002	25-BDV-022	00-JE-22002	2x2x0.75mm2
3	C-950-GDZ-02109/950-JE-02102	950-GDZ-02109	950-JE-02102	3x2.5mm2
4	C-950-GDZ-02110/950-JE-02102	950-GDZ-02110	950-JE-02102	3x2.5mm2
5	C-950-GDZ-02111/950-JE-02102	950-GDZ-02111	950-JE-02102	3x2.5mm2
6	C-950-GDZ-02112/950-JE-02102	950-GDZ-02112	950-JE-02102	3x2.5mm2
7	C-950-GDZ-02113/950-JE-02102	950-GDZ-02113	950-JE-02102	3x2.5mm2
8	C-950-GDZ-02114/950-JE-02102	950-GDZ-02114	950-JE-02102	3x2.5mm2
9	C-950-GDZ-02115/950-JE-02102	950-GDZ-02115	950-JE-02102	3x2.5mm2
10	C-950-GDZ-02116/950-JE-02102	950-GDZ-02116	950-JE-02102	3x2.5mm2
11	C-25-BDY-022/00-JE-23002	25-BDY-022	00-JE-23002	2x2.5mm2
12	C-25-SDY-023/00-JE-23002	25-SDY-023	00-JE-23002	2x2.5mm2
13	C-80-PT-002/00-JE-21002	80-PT-002	00-JE-21002	1x2x0.75mm2
14	C-43-PT-001/00-JE-11002	43-PT-001	00-JE-11002	1x2x0.75mm2
15	C-43-FT-001/00-JE-11002	43-FT-001	00-JE-11002	1x2x0.75mm2
16	C-43-LT-003/00-JE-11002	43-LT-003	00-JE-21002	1x2x0.75mm2
17	C-950-GDZ-02117/950-JE-02103	950-GDZ-02117	950-JE-02103	3x2.5mm2
18	C-950-GDZ-02119/950-JE-02103	950-GDZ-02119	950-JE-02103	3x2.5mm2
19	PD-43-FT-001/00-JE-13001	43-FT-001	00-JE-13001	2x2.5 mm2
20	C-43-FT-001/43-FE-001A	43-FT-001	43-FE-001A	STD-VENDOR
21	C-43-FT-001/43-FE-001B	43-FT-001	43-FE-001B	STD-VENDOR

U-SEC-21B-L-200-103-IST-011

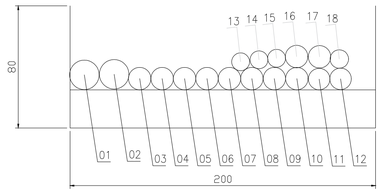

U-SEC-21B-L-200-103-IST-011				
POS	CABLENAME	FROM	TO	FORMATION
1	C-25-SDV-023/00-JE-22002	25-SDV-023	00-JE-22002	2x2x0.75mm2
2	C-25-BDV-022/00-JE-22002	25-BDV-022	00-JE-22002	2x2x0.75mm2
3	C-950-GDZ-02109/950-JE-02102	950-GDZ-02109	950-JE-02102	3x2.5mm2
4	C-950-GDZ-02110/950-JE-02102	950-GDZ-02110	950-JE-02102	3x2.5mm2
5	C-950-GDZ-02111/950-JE-02102	950-GDZ-02111	950-JE-02102	3x2.5mm2
6	C-950-GDZ-02112/950-JE-02102	950-GDZ-02112	950-JE-02102	3x2.5mm2
7	C-950-GDZ-02113/950-JE-02102	950-GDZ-02113	950-JE-02102	3x2.5mm2
8	C-950-GDZ-02114/950-JE-02102	950-GDZ-02114	950-JE-02102	3x2.5mm2
9	C-950-GDZ-02115/950-JE-02102	950-GDZ-02115	950-JE-02102	3x2.5mm2
10	C-950-GDZ-02116/950-JE-02102	950-GDZ-02116	950-JE-02102	3x2.5mm2
11	C-25-BDY-022/00-JE-23002	25-BDY-022	00-JE-23002	2x2.5mm2
12	C-25-SDY-023/00-JE-23002	25-SDY-023	00-JE-23002	2x2.5mm2
13	C-80-PT-002/00-JE-21002	80-PT-002	00-JE-21002	1x2x0.75mm2
14	C-43-PT-001/00-JE-11002	43-PT-001	00-JE-11002	1x2x0.75mm2
15	C-43-FT-001/00-JE-11002	43-FT-001	00-JE-11002	1x2x0.75mm2
16	C-950-GDZ-02117/950-JE-02103	950-GDZ-02117	950-JE-02103	3x2.5mm2
17	C-950-GDZ-02119/950-JE-02103	950-GDZ-02119	950-JE-02103	3x2.5mm2
18	PD-43-FT-001/00-JE-13001	43-FT-001	00-JE-13001	2x2.5 mm2
19	C-43-FT-001/43-FE-001A	43-FT-001	43-FE-001A	STD-VENDOR
20	C-43-FT-001/43-FE-001B	43-FT-001	43-FE-001A	STD-VENDOR

U-SEC-21C-L-200-103-IST-011

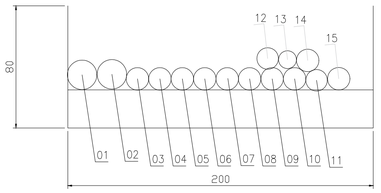

U-SEC-21C-L-200-103-IST-011				
POS	CABLENAME	FROM	TO	FORMATION
1	C-25-SDV-023/00-JE-22002	25-SDV-023	00-JE-22002	2x2x0.75mm2
2	C-25-BDV-022/00-JE-22002	25-BDV-022	00-JE-22002	2x2x0.75mm2
3	C-950-GDZ-02109/950-JE-02102	950-GDZ-02109	950-JE-02102	3x2.5mm2
4	C-950-GDZ-02110/950-JE-02102	950-GDZ-02110	950-JE-02102	3x2.5mm2
5	C-950-GDZ-02111/950-JE-02102	950-GDZ-02111	950-JE-02102	3x2.5mm2
6	C-950-GDZ-02112/950-JE-02102	950-GDZ-02112	950-JE-02102	3x2.5mm2
7	C-950-GDZ-02113/950-JE-02102	950-GDZ-02113	950-JE-02102	3x2.5mm2
8	C-950-GDZ-02114/950-JE-02102	950-GDZ-02114	950-JE-02102	3x2.5mm2
9	C-950-GDZ-02115/950-JE-02102	950-GDZ-02115	950-JE-02102	3x2.5mm2
10	C-950-GDZ-02116/950-JE-02102	950-GDZ-02116	950-JE-02102	3x2.5mm2
11	C-25-BDY-022/00-JE-23002	25-BDY-022	00-JE-23002	2x2.5mm2
12	C-25-SDY-023/00-JE-23002	25-SDY-023	00-JE-23002	2x2.5mm2
13	C-80-PT-002/00-JE-21002	80-PT-002	00-JE-21002	1x2x0.75mm2
14	C-950-GDZ-02117/950-JE-02103	950-GDZ-02117	950-JE-02103	3x2.5mm2
15	C-950-GDZ-02119/950-JE-02103	950-GDZ-02119	950-JE-02103	3x2.5mm2

INSERT SUBCONTRACTOR / VENDOR LOGO HERE

REV.	DATE	DRN	CHKD	APPD	DESCRIPTION
03	29/09/25	SPS	LCA	CGI	AS-BUILT (ASB)
02	04/10/24	VBA	LCA	DLO	ACCEPTED FOR CONSTRUCTION (AFC)
01	30/07/24	VBA	LCA	DLO	ACCEPTED FOR CONSTRUCTION (AFC)
00	22/12/23	VBA	LCA	DLO	ISSUE FOR REVIEW (IFR)

CROSSWIND

ROSETTI MARINO

TITLE :
BASE LOAD POWER HUB (BLPH)
INSTRUMENT MAIN CABLE ROUTING-UPPER DECK
TOS EL. 30.310M

CONTRACT NO./TITLE CW-I-WP4-2023-05/HOLLANDSE KUST NOORD WIND PARK | SCALE 1:150

DRAWN SPS | CHECKED LCA | APPROVED CGI | DATE 29/09/25

A1 | DRAWING NO. 123A90-DDL-IN-DL-40083 | SHEET 013 | REV. 03

File Name : 123A90-DDL-IN-DL-40083 REV:03.dwg