

DRAWING NO. 12390-DDL-IN-DL-40084

REV. 02

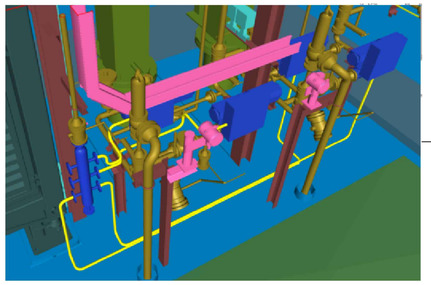

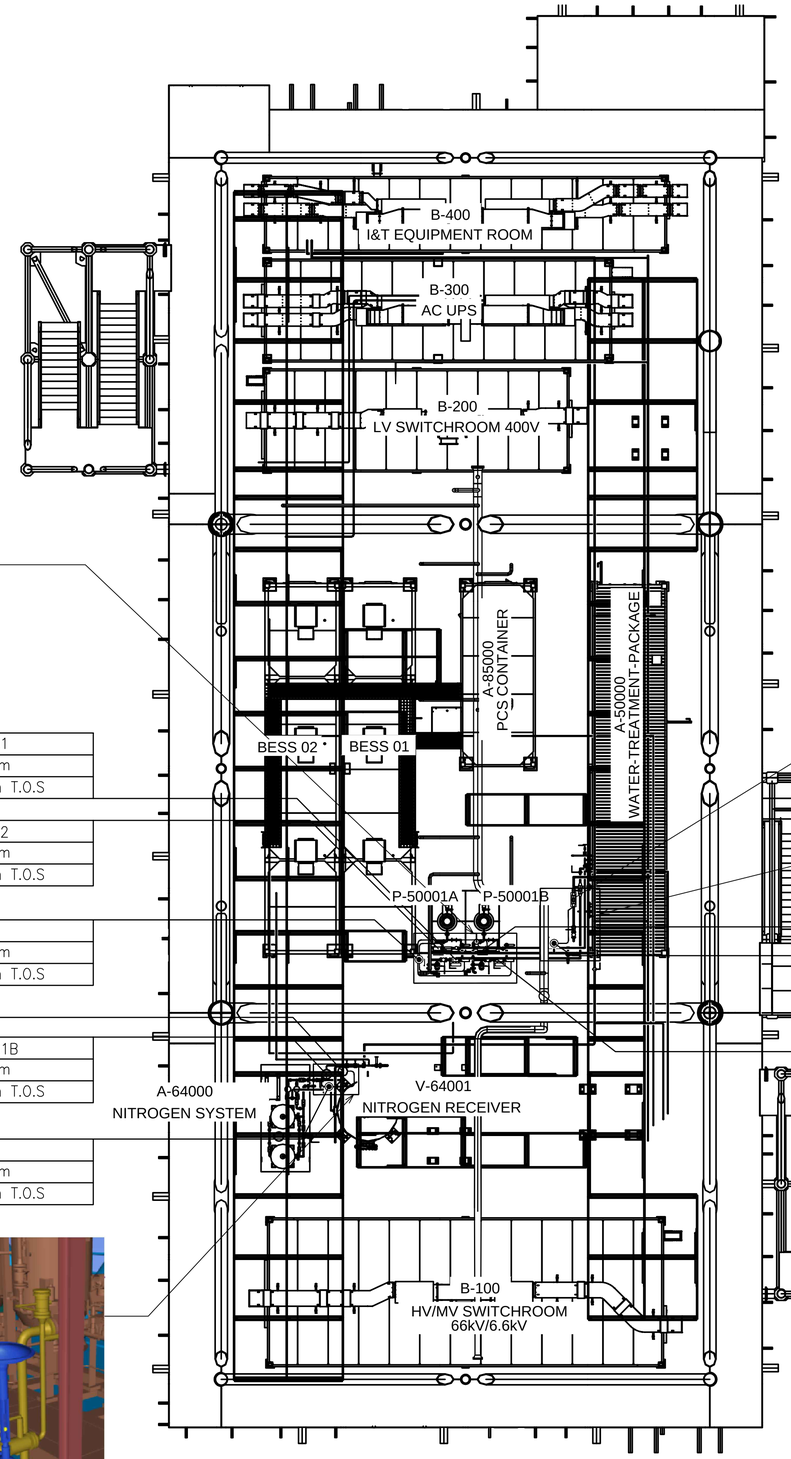

50-XV-001
+23.628mm
+0.318mm T.O.S


50-XV-002
+23.628mm
+0.318mm T.O.S

AV-63008
+24.188mm
+0.878mm T.O.S


64-PV-031A
+23.238mm
+0.072mm T.O.S

64-PV-031B
+23.238mm
+0.072mm T.O.S

AV-63005
+24.185mm
+0.875mm T.O.S

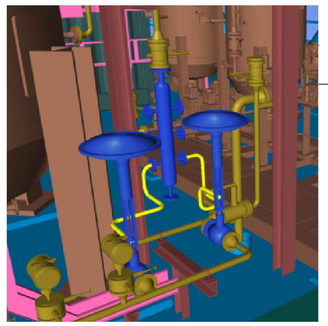

50-XV-005
+23.628mm
+0.318mm T.O.S

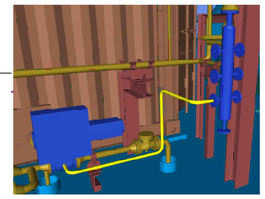

50-XV-004
+23.628mm
+0.318mm T.O.S

AV-63009
+24.235mm
+0.925mm T.O.S


50-XV-003
+23.628mm
+0.318mm T.O.S

LOWER DECK


SCALE: 1:1

VIEW EL. 23310mm to 29310mm


AV-63005

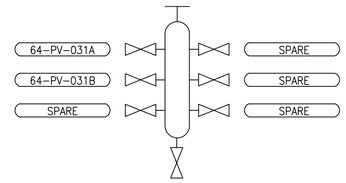


AV-63008

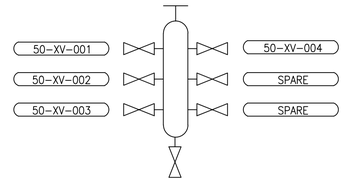

AV-63009

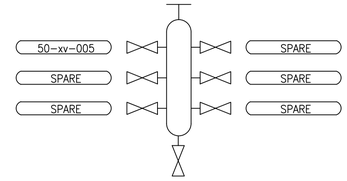

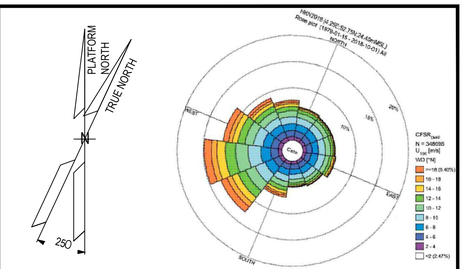

NOTES

1) TUBING ROUTING > 2m IS SHOWN AND IT IS INDICATIVE ONLY.
TUBING ROUTING SHALL BE FINALIZED DURING CONSTRUCTION ACTIVITIES.

LEGEND

- AIR DISTRIBUTION POT
- CONTROL VALVE
- ON-OFF VALVE
- TUBING

HOLDS

INSERT SUBCONTRACTOR / VENDOR LOGO HERE

REV.	DATE	DRN	CHKD	APPD	DESCRIPTION
02	29/09/25	SPS	LCA	CGI	AS-BUILT (ASB)
01	23/08/24	VBA	LCA	DLO	ACCEPTED FOR CONSTRUCTION (AFC)
00	23/02/23	VBA	LCA	DLO	ISSUE FOR REVIEW (IFR)

CROSSWIND

ROSETTI MARINO

TITLE :
BASE LOAD POWER HUB (BLPH)
INSTRUMENT TUBING LAYOUT
ELEVATION 23.310M

CONTRACT NO./TITLE	CW-I-WP4-2023-05/HOLLANDSE KUST NOORD WIND PARK		SCALE 1:100
DRAWN SPS	CHECKED LCA	APPROVED CGI	DATE 29/09/25

A1	DRAWING NO.	SHEET	REV.
	123A90-DDL-IN-DL-40084	001	02

File Name : 12390-DDL-IN-DL-40084_Rev.02