
DRAWING NO. 123A90-DDL-IN-DL-40114


REV. 02

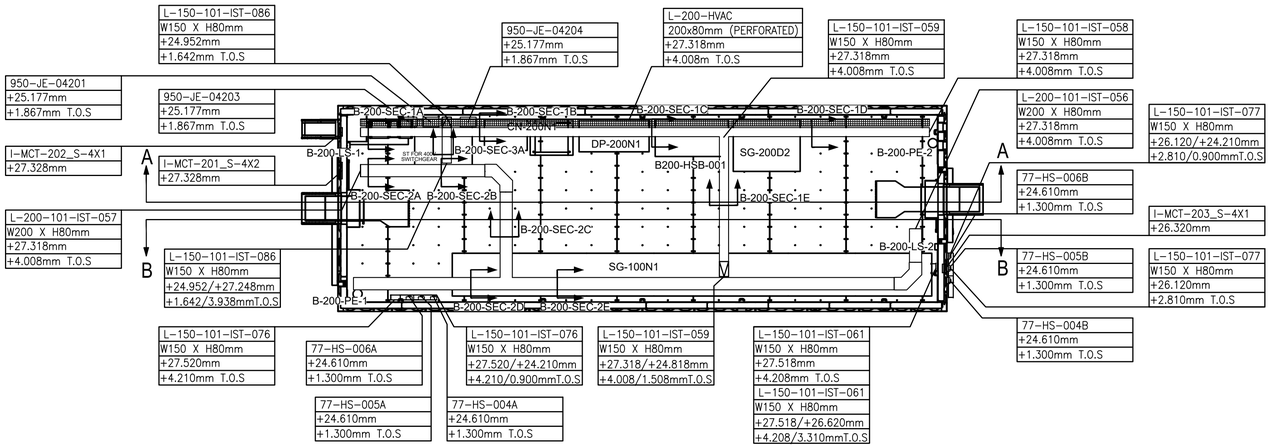


## PLAN VIEW


B-200 – LV SWITCHROOM

SCALE-1:1

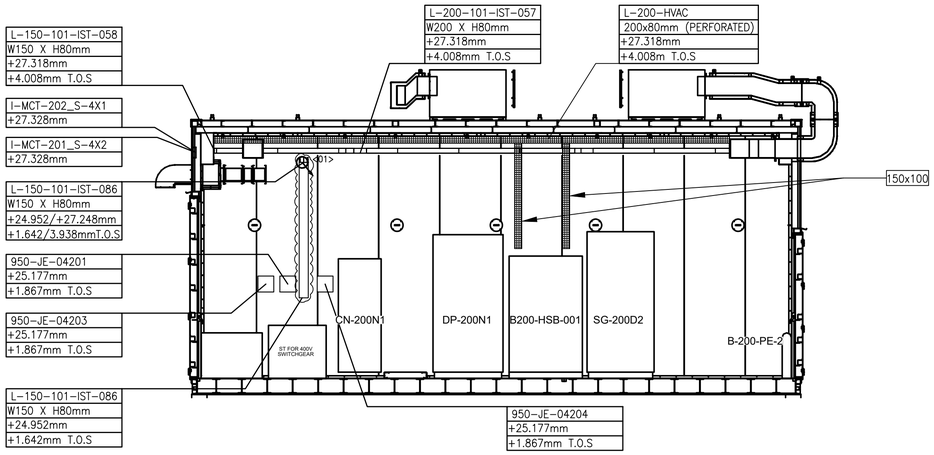



## SECTION A-A

SCALE-1:1

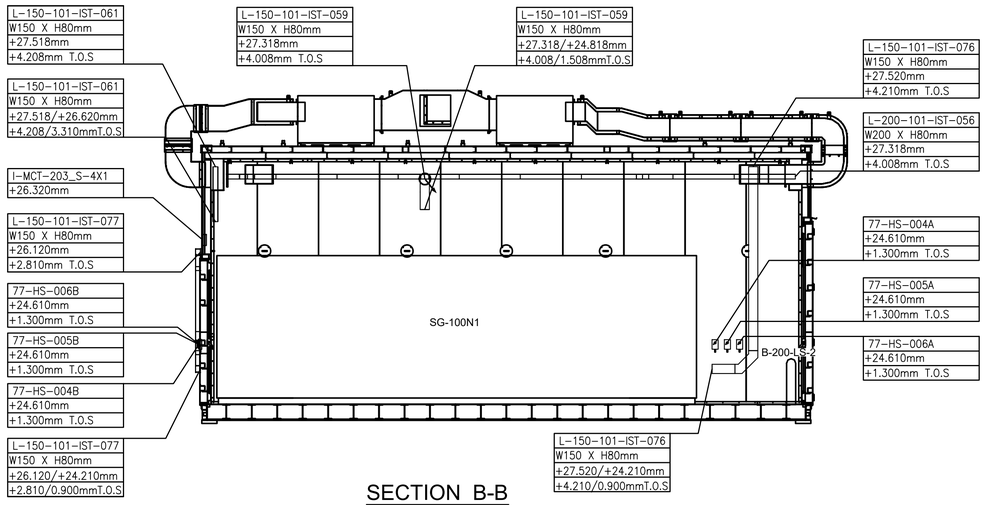


## SECTION B-B

SCALE-1:1

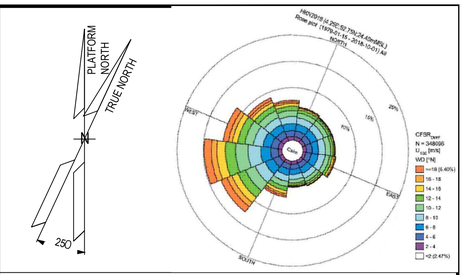


## NOTES

1. ALL DIMENSIONS AND ELEVATIONS ARE GIVEN IN mm UNLESS OTHERWISE NOTED.
2. ELEVATIONS REFER TO T.O.S.
3. THIS DRAWING IS VALID ONLY FOR CONTAINER CABLE TRAY LAYOUT.

## LEGEND

## HOLDS

## REFERENCE DOCUMENTS

| | |
|---|---|
| 123A90-DDL-PP-DL-70070 | PLOT PLAN - LOWER & UPPER DECK |
| 123A90-DDL-IN-DL-40081 | INSTRUMENT LAYOUT - UPPER DECK |
| 123A90-DDL-IN-LIS-40091 | INSTRUMENT CABLE LIST |
| 123A90-DDL-IN-DG-40015 | INSTRUMENT-CCS WIRING DIAGRAMS |
| 123A90-DDL-IN-DG-40016 | INSTRUMENT-SAFETY SYSTEM WIRING DIAGRAMS |
| 123A90-DDL-IN-DL-40083 | INSTRUMENT MAIN CABLES ROUTING-LOWER DECK |

INSERT SUBCONTRACTOR / VENDOR LOGO HERE

| REV. | DATE | DRN | CHKD | APPD | DESCRIPTION |
|---|---|---|---|---|---|
| 02 | 29/09/25 | SPS | LCA | CGI | AS-BUILT (ASB) |
| 01 | 04/10/24 | VBA | LCA | DLO | ACCEPTED FOR CONSTRUCTION (AFC) |
| 00 | 23/08/24 | VBA | LCA | DLO | ISSUE FOR REVIEW (IFR) |

CROSSWIND

ROSETTI MARINO

TITLE :

BASE LOAD POWER HUB (BLPH)

Base Load Power HUB Cables Tray Layout

B-200 Container Lower Deck – TOS EL. 23.310m

CONTRACT NO./TITLE CW-I-WP4-2023-05/HOLLANDSE KUST NOORD WIND PARK | SCALE 1:50

DRAWN SPS | CHECKED LCA | APPROVED CGI | DATE 29/09/25


A1 | DRAWING NO. 123A90-DDL-IN-DL-40114 | SHEET 001 | REV. 02

File Name : 123A90-DDL-IN-DL-40114 REV.02.dwg

DRAWING NO. 123A90-DDL-IN-DL-40114


REV. 02

## B-200-SEC-2A-L-200-101-IST-057

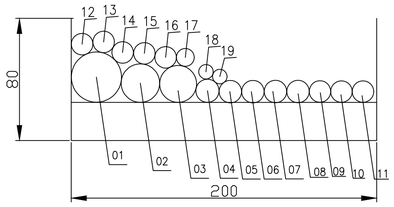



| B-200-SEC-2A-L-200-101-IST-057 | | | | |
|---|---|---|---|---|
| POS | CABLE NAME | FROM | TO | FORMATION |
| 1 | 950-JE-04201/B400-FGS-002 | 950-JE-04201 | B400-FGS-002 | 6x3x2,5 mm2 |
| 2 | B200-HSB-001/B400-FGS-002 | B200-HSB-001 | B400-FGS-002 | 6x2x0,75 mm2 |
| 3 | 950-JE-04203/B400-FGS-002 | 950-JE-04203 | B400-FGS-002 | 12x2,5 mm2 |
| 4 | C-B200-TIR-001/B400-PCS-002 | B200-TIR-001 | B400-FGS-002 | 2x2x0,75 mm2 |
| 5 | C-950-GDZ-04213/950-JE-04201 | 950-GDZ-04213 | 950-JE-04201 | 3x2.5 mm2 |
| 6 | C-950-GDZ-04214/950-JE-04201 | 950-GDZ-04214 | 950-JE-04201 | 3x2.5 mm2 |
| 7 | C-950-GDZ-04215/950-JE-04201 | 950-GDZ-04215 | 950-JE-04201 | 3x2.5 mm2 |
| 8 | C-950-GDZ-04216/950-JE-04201 | 950-GDZ-04216 | 950-JE-04201 | 3x2.5 mm2 |
| 9 | C-950-XZ-04203/950-JE-04203 | 950-XZ-04203 | 950-JE-04203 | 2x2.5 mm2 |
| 10 | C-950-XL-04205/950-JE-04203 | 950-XL-04205 | 950-JE-04203 | 2x2.5 mm2 |
| 11 | C-950-XL-04206/950-JE-04203 | 950-XL-04206 | 950-JE-04203 | 2x2.5 mm2 |
| 12 | C-77-HY-004/77-HS-004A | 77-HY-004 | 77-HS-004A | 2x2.5 mm2 |
| 13 | C-77-HY-006/77-HS-006A | 77-HY-006 | 77-HS-006A | 2x2.5 mm2 |
| 14 | C-77-XS-002/B400-SIS-001 | C-77-XS-002 | B400-SIS-001 | 2x2,5 mm2 |
| 15 | C-SG-200N1-001/B400-SIS-001 | SG-200N1-001 | B400-SIS-001 | 2x2,5 mm2 |
| 16 | C-SG-200N1-002/B400-SIS-001 | SG-200N1-002 | B400-SIS-001 | 2x2,5 mm2 |
| 17 | C-77-XA-002/B400-SIS-001 | C-77-XA-002 | B400-SIS-001 | 1x2x0,75 mm2 |
| 18 | C-B200-TDC-001/B400-PCS-002 | C-B200-TDC-001 | B400-PCS-002 | 1x2x0,75 mm2 |
| 19 | C-B200-TDC-002/B400-PCS-002 | C-B200-TDC-002 | B400-PCS-002 | 1x2x0,75 mm2 |

## B-200-SEC-2B-L-200-101-IST-057

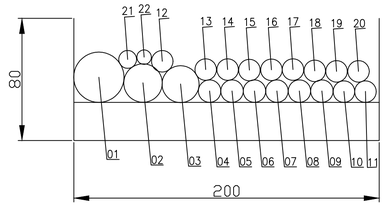



| B-200-SEC-2B-L-200-101-IST-057 | | | | |
|---|---|---|---|---|
| POS | CABLE NAME | FROM | TO | FORMATION |
| 1 | 950-JE-04201/B400-FGS-002 | 950-JE-04201 | B400-FGS-002 | 6x3x2,5 mm2 |
| 2 | B200-HSB-001/B400-FGS-002 | B200-HSB-001 | B400-FGS-002 | 6x2x0,75 mm2 |
| 3 | 950-JE-04203/B400-FGS-002 | 950-JE-04203 | B400-FGS-002 | 12x2,5 mm2 |
| 4 | C-950-GDZ-04213/950-JE-04201 | 950-GDZ-04213 | 950-JE-04201 | 3x2.5 mm2 |
| 5 | C-950-GDZ-04214/950-JE-04201 | 950-GDZ-04214 | 950-JE-04201 | 3x2.5 mm2 |
| 6 | C-950-GDZ-04215/950-JE-04201 | 950-GDZ-04215 | 950-JE-04201 | 3x2.5 mm2 |
| 7 | C-950-GDZ-04216/950-JE-04201 | 950-GDZ-04216 | 950-JE-04201 | 3x2.5 mm2 |
| 8 | C-950-GDZ-04217/950-JE-04201 | 950-GDZ-04217 | 950-JE-04201 | 3x2.5 mm2 |
| 9 | C-950-GDZ-04218/950-JE-04201 | 950-GDZ-04218 | 950-JE-04201 | 3x2.5 mm2 |
| 10 | C-77-XS-002/B400-SIS-001 | C-77-XS-002 | B400-SIS-001 | 2x2,5 mm2 |
| 11 | C-SG-200N1-001/B400-SIS-001 | SG-200N1-001 | B400-SIS-001 | 2x2,5 mm2 |
| 12 | C-SG-200N1-002/B400-SIS-001 | SG-200N1-002 | B400-SIS-001 | 2x2,5 mm2 |
| 13 | C-77-HS-004B/950-JE-04203 | 77-HS-004B | 950-JE-04203 | 2x2.5 mm2 |
| 14 | C-77-HS-005B/950-JE-04203 | 77-HS-005B | 950-JE-04203 | 2x2.5 mm2 |
| 15 | C-77-HS-006B/950-JE-04203 | 77-HS-006B | 950-JE-04203 | 2x2.5 mm2 |
| 16 | C-950-XZ-04203/950-JE-04203 | 950-XZ-04203 | 950-JE-04203 | 2x2.5 mm2 |
| 17 | C-950-XL-04205/950-JE-04203 | 950-XL-04205 | 950-JE-04203 | 2x2.5 mm2 |
| 18 | C-950-XL-04206/950-JE-04203 | 950-XL-04206 | 950-JE-04203 | 2x2.5 mm2 |
| 19 | C-77-HY-004/77-HS-004A | 77-HY-004 | 77-HS-004A | 2x2.5 mm2 |
| 20 | C-77-HY-006/77-HS-006A | 77-HY-006 | 77-HS-006A | 2x2.5 mm2 |
| 21 | C-77-XA-002/B400-SIS-001 | C-77-XA-002 | B400-SIS-001 | 1x2x0,75 mm2 |
| 22 | C-B200-TDC-001/B400-PCS-002 | C-B200-TDC-001 | B400-PCS-002 | 1x2x0,75 mm2 |

## B-200-SEC-2C-L-200-101-IST-057

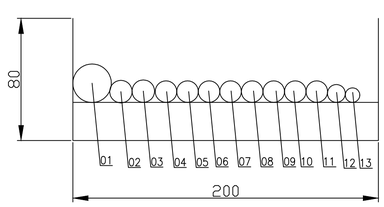



| B-200-SEC-2C-L-200-101-IST-057 | | | | |
|---|---|---|---|---|
| POS | CABLE NAME | FROM | TO | FORMATION |
| 1 | B200-HSB-001/B400-FGS-002 | B200-HSB-001 | B400-FGS-002 | 6x2x0,75 mm2 |
| 2 | C-950-GDZ-04217/950-JE-04201 | 950-GDZ-04217 | 950-JE-04201 | 3x2.5 mm2 |
| 3 | C-950-GDZ-04218/950-JE-04201 | 950-GDZ-04218 | 950-JE-04201 | 3x2.5 mm2 |
| 4 | C-77-XS-002/B400-SIS-001 | C-77-XS-002 | B400-SIS-001 | 2x2,5 mm2 |
| 5 | C-SG-200N1-001/B400-SIS-001 | SG-200N1-001 | B400-SIS-001 | 2x2,5 mm2 |
| 6 | C-SG-200N1-002/B400-SIS-001 | SG-200N1-002 | B400-SIS-001 | 2x2,5 mm2 |
| 7 | C-77-HS-004B/950-JE-04203 | 77-HS-004B | 950-JE-04203 | 2x2.5 mm2 |
| 8 | C-77-HS-005B/950-JE-04203 | 77-HS-005B | 950-JE-04203 | 2x2.5 mm2 |
| 9 | C-77-HS-006B/950-JE-04203 | 77-HS-006B | 950-JE-04203 | 2x2.5 mm2 |
| 10 | C-77-HY-004/77-HS-004A | 77-HY-004 | 77-HS-004A | 2x2.5 mm2 |
| 11 | C-77-HY-006/77-HS-006A | 77-HY-006 | 77-HS-006A | 2x2.5 mm2 |
| 12 | C-77-XA-002/B400-SIS-001 | C-77-XA-002 | B400-SIS-001 | 1x2x0,75 mm2 |
| 13 | C-B200-TDC-001/B400-PCS-002 | C-B200-TDC-001 | B400-PCS-002 | 1x2x0,75 mm2 |

## B-200-SEC-1A-L-150-101-IST-058

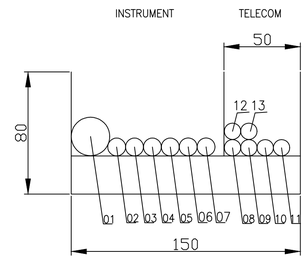


| B-200-SEC-1A-L-150-101-IST-058 | | | | |
|---|---|---|---|---|
| POS | CABLE NAME | FROM | TO | FORMATION |
| 1 | 950-JE-04204/B400-FGS-002 | 950-JE-04204 | B400-FGS-002 | 6x2x0,75 mm2 |
| 2 | C-950-SDZ-04213/950-JE-04204 | 950-SDZ-04213 | 950-JE-04204 | 1x2x0.75 mm2 |
| 3 | C-950-SDZ-04214/950-JE-04204 | 950-SDZ-04214 | 950-JE-04204 | 1x2x0.75 mm2 |
| 4 | C-950-SDZ-04215/950-JE-04204 | 950-SDZ-04215 | 950-JE-04204 | 1x2x0.75 mm2 |
| 5 | C-950-SDZ-04216/950-JE-04204 | 950-SDZ-04216 | 950-JE-04204 | 1x2x0.75 mm2 |
| 6 | C-950-SDZ-04217/950-JE-04204 | 950-SDZ-04217 | 950-JE-04204 | 1x2x0.75 mm2 |
| 7 | C-950-SDZ-04218/950-JE-04204 | 950-SDZ-04218 | 950-JE-04204 | 1x2x0.75 mm2 |
| 8 | B200-HSB-001/B400-NET-001 | B200-HSB-001 | B400-NET-001 | CAT.6A 4x2xAWG23 |
| 9 | SG-200N1/B400-NET-001.01 | SG-200N1 | B400-NET-001 | CAT.6A 4x2xAWG23 |
| 10 | SG-200N1/B400-NET-001.02 | SG-200N1 | B400-NET-001 | CAT.6A 4x2xAWG23 |
| 11 | SG-200N1/B400-NET-001.03 | SG-200N1 | B400-NET-001 | CAT.6A 4x2xAWG23 |
| 12 | SG-200D2/B400-NET-001 | SG-200D2 | B400-NET-001 | CAT.6A 4x2xAWG23 |
| 13 | HNA6/CN-200N1 | HNA6 | CN-200N1 | FO12 OS2 |


## B-200-SEC-1B-L-150-101-IST-058

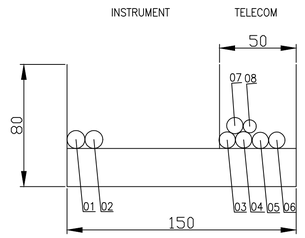


| B-200-SEC-1B-L-150-101-IST-058 | | | | |
|---|---|---|---|---|
| POS | CABLE NAME | FROM | TO | FORMATION |
| 1 | C-950-SDZ-04217/950-JE-04204 | 950-SDZ-04217 | 950-JE-04204 | 1x2x0.75 mm2 |
| 2 | C-950-SDZ-04218/950-JE-04204 | 950-SDZ-04218 | 950-JE-04204 | 1x2x0.75 mm2 |
| 3 | B200-HSB-001/B400-NET-001 | B200-HSB-001 | B400-NET-001 | CAT.6A 4x2xAWG23 |
| 4 | SG-200N1/B400-NET-001.01 | SG-200N1 | B400-NET-001 | CAT.6A 4x2xAWG23 |
| 5 | SG-200N1/B400-NET-001.02 | SG-200N1 | B400-NET-001 | CAT.6A 4x2xAWG23 |
| 6 | SG-200N1/B400-NET-001.03 | SG-200N1 | B400-NET-001 | CAT.6A 4x2xAWG23 |
| 7 | SG-200D2/B400-NET-001 | SG-200D2 | B400-NET-001 | CAT.6A 4x2xAWG23 |
| 8 | HNA6/CN-200N1 | HNA6 | CN-200N1 | FO12 OS2 |

| B-200-SEC-1D-L-150-101-IST-058 | | | | |
|---|---|---|---|---|
| POS | CABLE NAME | FROM | TO | FORMATION |
| 1 | C-950-SDZ-04218/950-JE-04204 | 950-SDZ-04218 | 950-JE-04204 | 1x2x0.75 mm2 |
| 2 | SG-200D2/B400-NET-001 | SG-200D2 | B400-NET-001 | CAT.6A 4x2xAWG23 |

## B-200-SEC-1D-L-150-101-IST-058

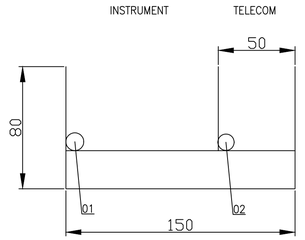


INSERT SUBCONTRACTOR / VENDOR LOGO HERE

| REV. | DATE | DRN | CHKD | APPD | DESCRIPTION |
|---|---|---|---|---|---|
| 02 | 29/09/25 | SPS | LCA | CGI | AS-BUILT (ASB) |
| 01 | 04/10/24 | VBA | LCA | DLO | ACCEPTED FOR CONSTRUCTION (AFC) |
| 00 | 23/08/24 | VBA | LCA | DLO | ISSUE FOR REVIEW (IFR) |

CROSSWIND

ROSETTI MARINO

TITLE :
BASE LOAD POWER HUB (BLPH)
Base Load Power HUB Cables Tray Layout
B-200 Container Lower Deck – TOS EL. 23.310m

CONTRACT NO./TITLE CW-I-WP4-2023-05/HOLLANDSE KUST NOORD WIND PARK | SCALE 1:50

DRAWN SPS | CHECKED LCA | APPROVED CGI | DATE 29/09/25


A1 | DRAWING NO. 123A90-DDL-IN-DL-40114 | SHEET 002 | REV. 02

File Name : 123A90-DDL-IN-DL-40114 REV.02.dwg

DRAWING NO. 123A90-DDL-IN-DL-40114


REV. 02

## B-200-SEC-2D-L-200-101-IST-057

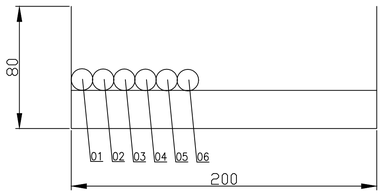



| B-200-SEC-2D-L-200-101-IST-057 | | | | |
|---|---|---|---|---|
| POS | CABLE NAME | FROM | TO | FORMATION |
| 1 | C-77-HY-004/77-HS-004A | 77-HY-004 | 77-HS-004A | 2x2.5 mm2 |
| 2 | C-77-HY-005/77-HS-005A | 77-HY-005 | 77-HS-005A | 2x2.5 mm2 |
| 3 | C-77-HY-006/77-HS-006A | 77-HY-006 | 77-HS-006A | 2x2.5 mm2 |
| 4 | C-77-HS-004A/77-HS-004B | 77-HS-004A | 77-HS-004B | 2x2.5 mm2 |
| 5 | C-77-HS-005A/77-HS-005B | 77-HS-005A | 77-HS-005B | 2x2.5 mm2 |
| 6 | C-77-HS-006A/77-HS-006B | 77-HS-006A | 77-HS-006B | 2x2.5 mm2 |

## B-200-SEC-2E-L-200-101-IST-057

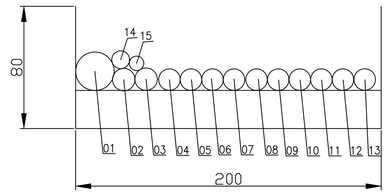



| B-200-SEC-2E-L-200-101-IST-057 | | | | |
|---|---|---|---|---|
| POS | CABLE NAME | FROM | TO | FORMATION |
| 1 | B200-HSB-001/B400-FGS-002 | B200-HSB-001 | B400-FGS-002 | 6x2x0,75 mm2 |
| 2 | C-950-GDZ-04217/950-JE-04201 | 950-GDZ-04217 | 950-JE-04201 | 3x2.5 mm2 |
| 3 | C-950-GDZ-04218/950-JE-04201 | 950-GDZ-04218 | 950-JE-04201 | 3x2.5 mm2 |
| 4 | C-77-XS-002/B400-SIS-001 | C-77-XS-002 | B400-SIS-001 | 2x2,5 mm2 |
| 5 | C-SG-200N1-001/B400-SIS-001 | SG-200N1-001 | B400-SIS-001 | 2x2,5 mm2 |
| 6 | C-SG-200N1-002/B400-SIS-001 | SG-200N1-002 | B400-SIS-001 | 2x2,5 mm2 |
| 7 | C-77-HS-004B/950-JE-04203 | 77-HS-004B | 950-JE-04203 | 2x2,5 mm2 |
| 8 | C-77-HS-004A/77-HS-004B | 77-HS-004A | 77-HS-004B | 2x2,5 mm2 |
| 9 | C-77-HS-005B/950-JE-04203 | 77-HS-005B | 950-JE-04203 | 2x2,5 mm2 |
| 10 | C-77-HS-005A/77-HS-005B | 77-HS-005A | 77-HS-005B | 2x2,5 mm2 |
| 11 | C-77-HY-005/77-HS-005A | 77-HY-005 | 77-HS-005A | 2x2.5 mm2 |
| 12 | C-77-HS-006B/950-JE-04203 | 77-HS-006B | 950-JE-04203 | 2x2.5 mm2 |
| 13 | C-77-HS-006A/77-HS-006B | 77-HS-006A | 77-HS-006B | 2x2.5 mm2 |
| 14 | C-77-XA-002/B400-SIS-001 | C-77-XA-002 | B400-SIS-001 | 1x2x0,75 mm2 |
| 15 | C-B200-TDC-001/B400-PCS-002 | C-B200-TDC-001 | B400-PCS-002 | 1x2x0,75 mm2 |

## B-200-SEC-3A-L-150-101-IST-086

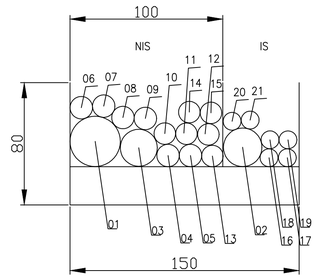



| B-200-SEC-3A-L-150-101-IST-086 | | | | |
|---|---|---|---|---|
| POS | CABLE NAME | FROM | TO | FORMATION |
| 1 | 950-JE-04201/B400-FGS-002 | 950-JE-04201 | B400-FGS-002 | 6x3x2,5 mm2 |
| 2 | 950-JE-04204/B400-FGS-002 | 950-JE-04204 | B400-FGS-002 | 6x2x0,75 mm2 |
| 3 | 950-JE-04203/B400-FGS-002 | 950-JE-04203 | B400-FGS-002 | 12x2,5 mm2 |
| 4 | C-950-GDZ-04213/950-JE-04201 | 950-GDZ-04213 | 950-JE-04201 | 3x2.5 mm2 |
| 5 | C-950-GDZ-04214/950-JE-04201 | 950-GDZ-04214 | 950-JE-04201 | 3x2.5 mm2 |
| 6 | C-950-GDZ-04215/950-JE-04201 | 950-GDZ-04215 | 950-JE-04201 | 3x2.5 mm2 |
| 7 | C-950-GDZ-04216/950-JE-04201 | 950-GDZ-04216 | 950-JE-04201 | 3x2.5 mm2 |
| 8 | C-950-GDZ-04217/950-JE-04201 | 950-GDZ-04217 | 950-JE-04201 | 3x2.5 mm2 |
| 9 | C-950-GDZ-04218/950-JE-04201 | 950-GDZ-04218 | 950-JE-04201 | 3x2.5 mm2 |
| 10 | C-950-XZ-04203/950-JE-04203 | 950-XZ-04203 | 950-JE-04203 | 2x2.5 mm2 |
| 11 | C-950-XL-04205/950-JE-04203 | 950-XL-04205 | 950-JE-04203 | 2x2.5 mm2 |
| 12 | C-950-XL-04206/950-JE-04203 | 950-XL-04206 | 950-JE-04203 | 2x2.5 mm2 |
| 13 | C-77-HS-004B/950-JE-04203 | 77-HS-004B | 950-JE-04203 | 2x2.5 mm2 |
| 14 | C-77-HS-005B/950-JE-04203 | 77-HS-005B | 950-JE-04203 | 2x2.5 mm2 |
| 15 | C-77-HS-006B/950-JE-04203 | 77-HS-006B | 950-JE-04203 | 2x2.5 mm2 |
| 16 | C-950-SDZ-04213/950-JE-04204 | 950-SDZ-04213 | 950-JE-04204 | 1x2x0.75 mm2 |
| 17 | C-950-SDZ-04214/950-JE-04204 | 950-SDZ-04214 | 950-JE-04204 | 1x2x0.75 mm2 |
| 18 | C-950-SDZ-04215/950-JE-04204 | 950-SDZ-04215 | 950-JE-04204 | 1x2x0.75 mm2 |
| 19 | C-950-SDZ-04216/950-JE-04204 | 950-SDZ-04216 | 950-JE-04204 | 1x2x0.75 mm2 |
| 20 | C-950-SDZ-04217/950-JE-04204 | 950-SDZ-04217 | 950-JE-04204 | 1x2x0.75 mm2 |
| 21 | C-950-SDZ-04218/950-JE-04204 | 950-SDZ-04218 | 950-JE-04204 | 1x2x0.75 mm2 |

## B-200-SEC-1C-L-150-101-IST-058

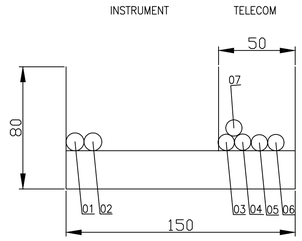


| B-200-SEC-1C-L-150-101-IST-058 | | | | |
|---|---|---|---|---|
| POS | CABLE NAME | FROM | TO | FORMATION |
| 1 | C-950-SDZ-04217/950-JE-04204 | 950-SDZ-04217 | 950-JE-04204 | 1x2x0.75 mm2 |
| 2 | C-950-SDZ-04218/950-JE-04204 | 950-SDZ-04218 | 950-JE-04204 | 1x2x0.75 mm2 |
| 3 | B200-HSB-001/B400-NET-001 | B200-HSB-001 | B400-NET-001 | CAT.6A 4x2xAWG23 |
| 4 | SG-200N1/B400-NET-001.01 | SG-200N1 | B400-NET-001 | CAT.6A 4x2xAWG23 |
| 5 | SG-200N1/B400-NET-001.02 | SG-200N1 | B400-NET-001 | CAT.6A 4x2xAWG23 |
| 6 | SG-200N1/B400-NET-001.03 | SG-200N1 | B400-NET-001 | CAT.6A 4x2xAWG23 |
| 7 | SG-200D2/B400-NET-001 | SG-200D2 | B400-NET-001 | CAT.6A 4x2xAWG23 |

## B-200-SEC-1E-L-150-101-IST-059

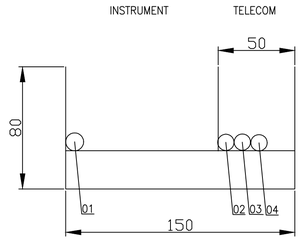


| B-200-SEC-1E-L-150-101-IST-059 | | | | |
|---|---|---|---|---|
| POS | CABLE NAME | FROM | TO | FORMATION |
| 1 | C-950-SDZ-04217/950-JE-04204 | 950-SDZ-04217 | 950-JE-04204 | 1x2x0.75 mm2 |
| 2 | SG-200N1/B400-NET-001.01 | SG-200N1 | B400-NET-001 | CAT.6A 4x2xAWG23 |
| 3 | SG-200N1/B400-NET-001.02 | SG-200N1 | B400-NET-001 | CAT.6A 4x2xAWG23 |
| 4 | SG-200N1/B400-NET-001.03 | SG-200N1 | B400-NET-001 | CAT.6A 4x2xAWG23 |

INSERT SUBCONTRACTOR / VENDOR LOGO HERE

| REV. | DATE | DRN | CHKD | APPD | DESCRIPTION |
|---|---|---|---|---|---|
| 02 | 29/09/25 | SPS | LCA | CGI | AS-BUILT (ASB) |
| 01 | 04/10/24 | VBA | LCA | DLO | ACCEPTED FOR CONSTRUCTION (AFC) |
| 00 | 23/08/24 | VBA | LCA | DLO | ISSUE FOR REVIEW (IFR) |

CROSSWIND

ROSETTI MARINO

TITLE :
BASE LOAD POWER HUB (BLPH)
Base Load Power HUB Cables Tray Layout
B-200 Container Lower Deck – TOS EL. 23.310m

CONTRACT NO./TITLE CW-I-WP4-2023-05/HOLLANDSE KUST NOORD WIND PARK | SCALE 1:50

DRAWN SPS | CHECKED LCA | APPROVED CGI | DATE 29/09/25

A1 | DRAWING NO. 123A90-DDL-IN-DL-40114 | SHEET 003 | REV. 02

File Name : 123A90-DDL-IN-DL-40114 REV:02.dwg