

DRAWING NO. 123A90-DDL-PP-DD-70055


REV. 02

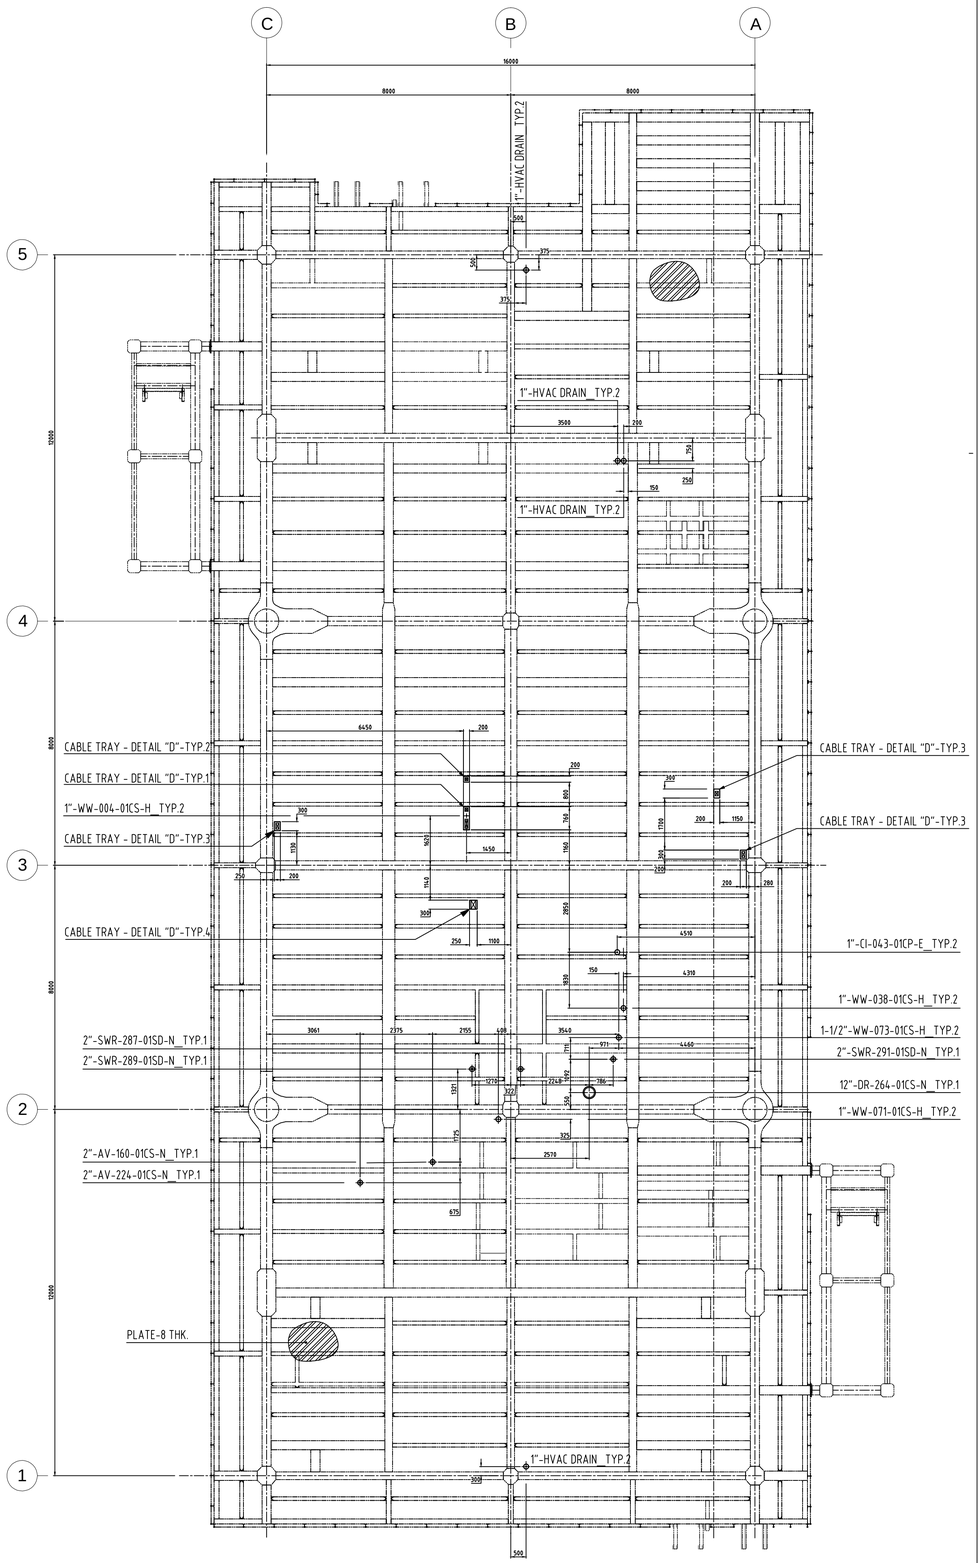


LOWER DECK
PLAN @ EL.+23.310m (TOP OF STEEL)

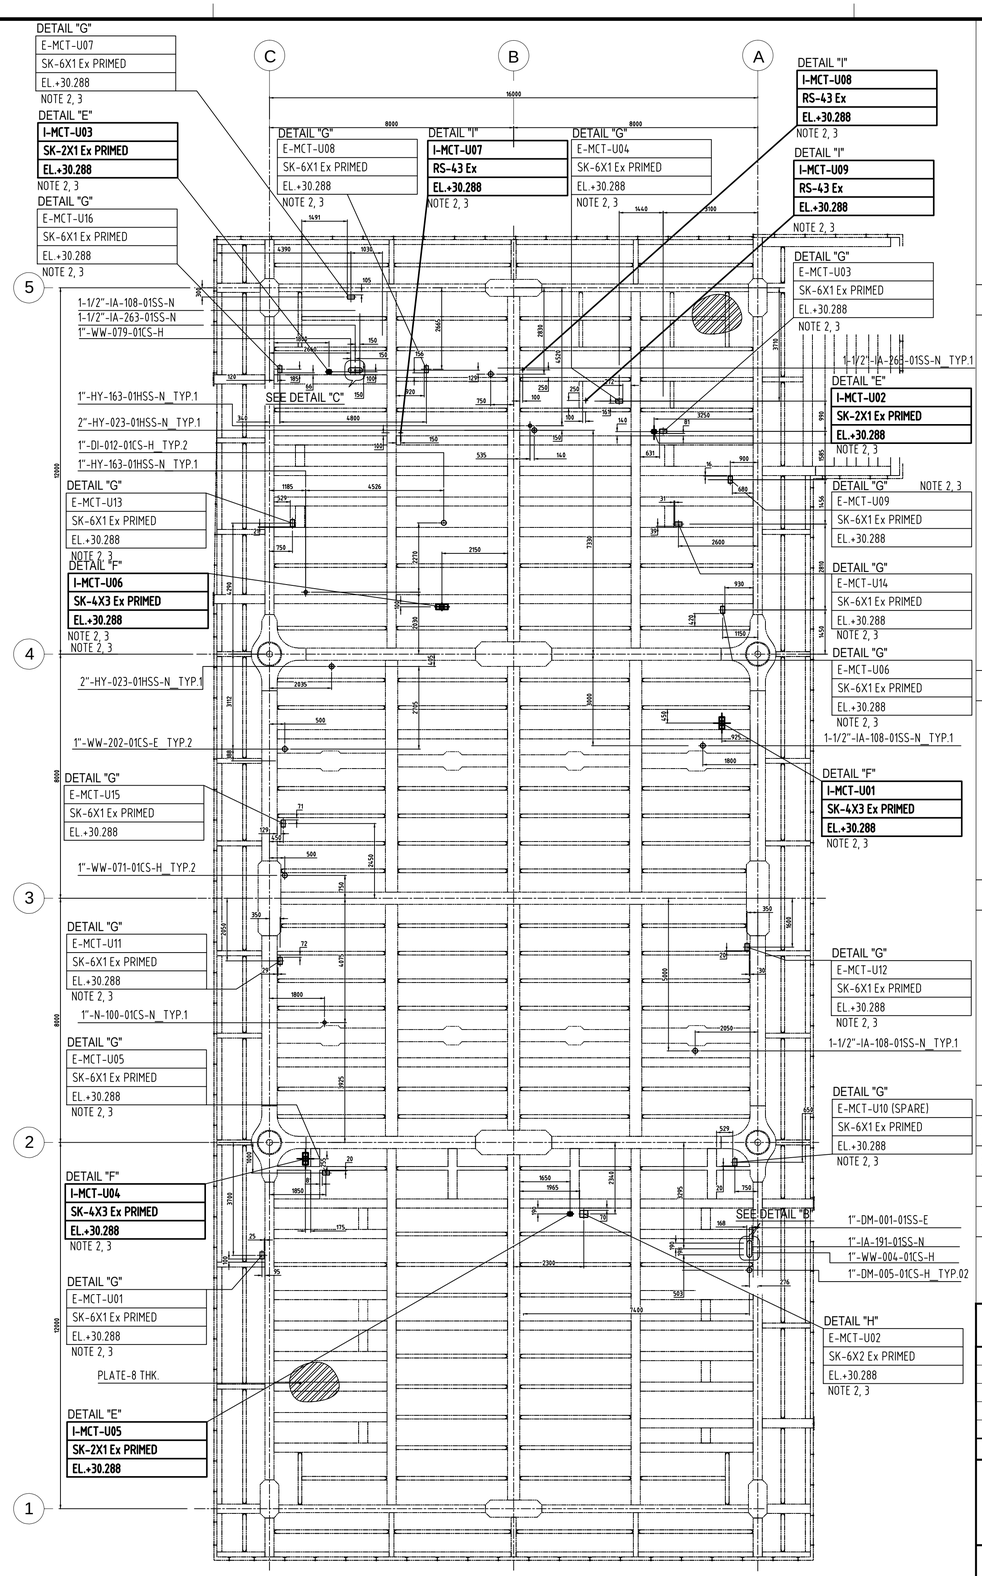


UPPER DECK
PLAN @ EL.+30.310m (TOP OF STEEL)

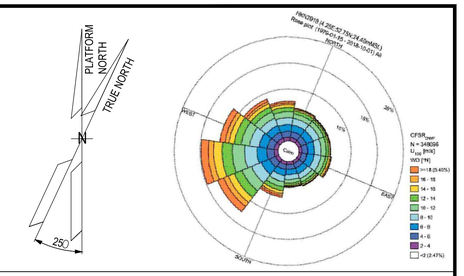


## NOTES

1. ALL DIMENSIONS AND ELEVATIONS ARE IN MILLIMETERS.
2. DIMENSIONS SHOWN REFER TO THE MAXIMUM DIMENSIONS OF THE MCT FRAME AND NOT TO THE ACTUAL CUT-OUT THAT SHOULD BE INCREASED by 1,5 mm. Max. ON EACH SIDE.
3. ALL MTC's SHALL BE INSTALLED ACCORDING TO ROXTEC (VENDOR) PROCEDURE
4. ALL PIPE PENETRATION SHALL BE SEALED WITH APPROPRIATE MATERIAL

## LEGEND

LEGEND:

FLAT PLATE - 8 THK

## HOLDS

## REFERENCE DOCUMENTS

| | |
|---|---|
| 123A90-DDL-PP-DD-70056 | PIPING FLOOR PENETRATION EL. +31.410m TO EL.+36.210m - Typical & detail |
| 123A90-DDL-PP-DD-70057 | PIPING FLOOR PENETRATION TRANSITION PIECE VIEW EL. +17180mm to +23340mm |

| REV. | DATE | DRN | CHKD | APPD | DESCRIPTION |
|---|---|---|---|---|---|
| 02 | 22/09/25 | SPS | CBO | CGI | AS-BUILT (ASB) |
| 01 | 02/07/24 | MMA | CBO | DLO | ACCEPTED FOR CONSTRUCTION (AFC) |
| 00 | 06/05/24 | MMA | CBO | DLO | ISSUE FOR REVIEW (IFR) |

CROSSWIND

ROSETTI MARINO

TITLE :
BASE LOAD POWER HUB (BLPH)
PIPING FLOOR PENETRATION LOWER & UPPER DECK
EL.+23.310m & EL.+30.310m

| | | | |
|---|---|---|---|
| CONTRACT NO./TITLE | CW-I-WP4-2023-05/HOLLANDSE KUST NOORD WIND PARK | | SCALE 1:100 |
| DRAWN SPS | CHECKED C. BORTOLIN | APPROVED CGI | DATE 22/09/25 |
| A1 | DRAWING NO. 123A90-DDL-PP-DD-70055 | SHEET 001 | REV. 02 |

File Name: 123A90-DDL-PP-DD-70055_02