
NOTES

1. STREAM INFO IS PRESENTED IN H&MB (123A90-DDL-PR-BL-80002).
2. LINE REQUIRED FOR PURGING OF PIPE WORK.

V-25001A/B/C/D/E/F
HYDROGEN
STORAGE
VESSELS

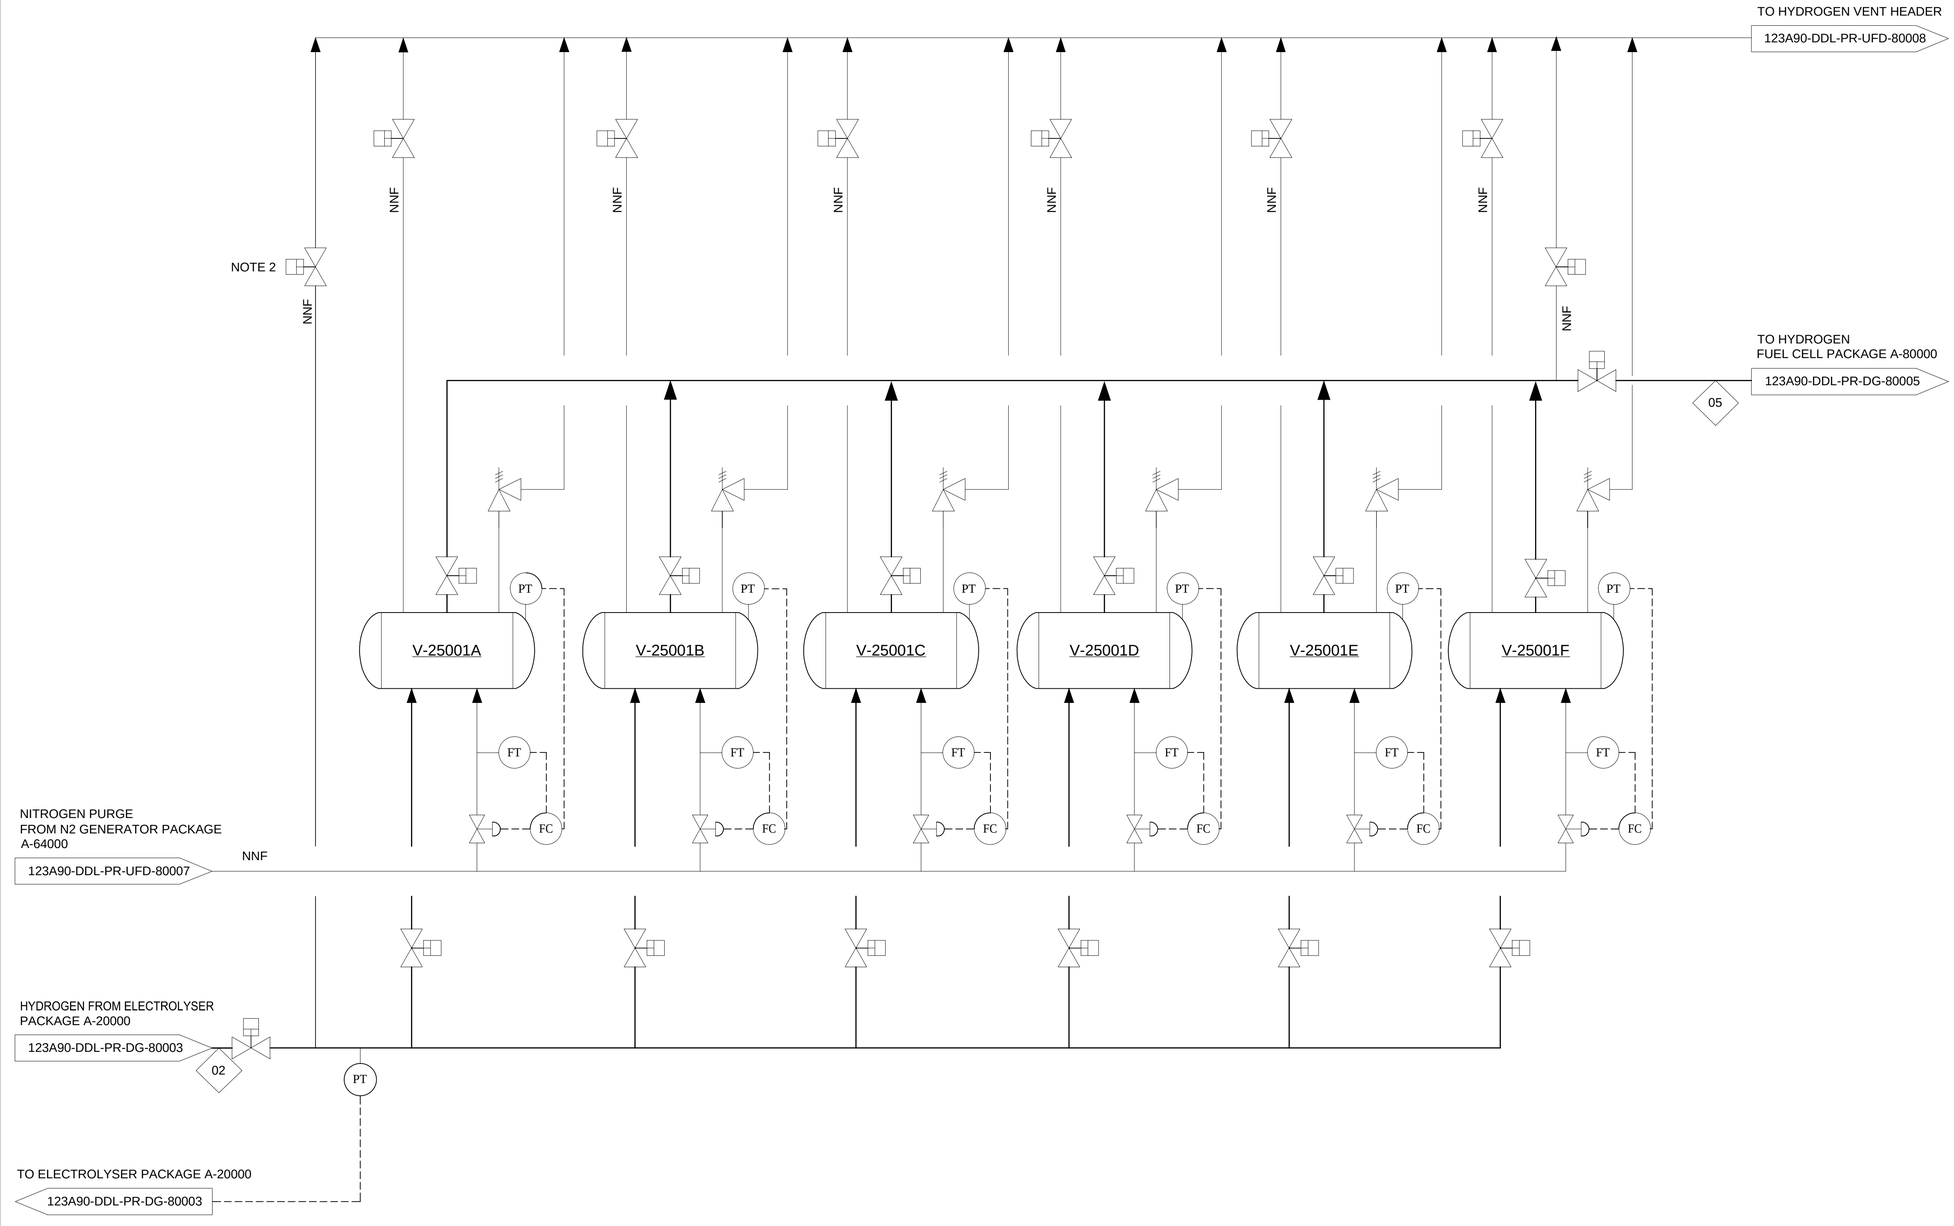

HOLDS

1. "DELETED"

LEGEND

- MAJOR PROCESS LINE
- MINOR PROCESS LINE
- INSTRUMENT SIGNAL
- VENDOR PACKAGE

REV.	DATE	DRN	CHKD	APPD	DESCRIPTION
03	18/09/25	SPS	CIM	CGI	AS-BUILT (ASB)
02	22/08/24	SSE	CIM	DLO	ACCEPTED FOR CONSTRUCTION (AFC)
01	23/11/23	SSE	CIM	DLO	ACCEPTED FOR CONSTRUCTION (AFC)
00	18/09/23	SSE	CIM	DLO	ISSUE FOR REVIEW (IFR)

CROSSWIND

ROSETTI MARINO

TITLE :
BASE LOAD POWER HUB (BLPH)
PROCESS FLOW SCHEME
HYDROGEN STORAGE

CONTRACT NO./TITLE CW-I-WP4-2023-05/HOLLANDSE KUST NOORD WIND PARK			SCALE
DRAWN SPS	CHECKED CIM	APPROVED CGI	DATE 18/09/25

A1	DRAWING NO. 123A90-DDL-PR-DG-80004	SHEET 001	REV. 03