
DRAWING NO. DRAWING_NO. 123A90-DDL-PR-PID-80014

REV. REV 04

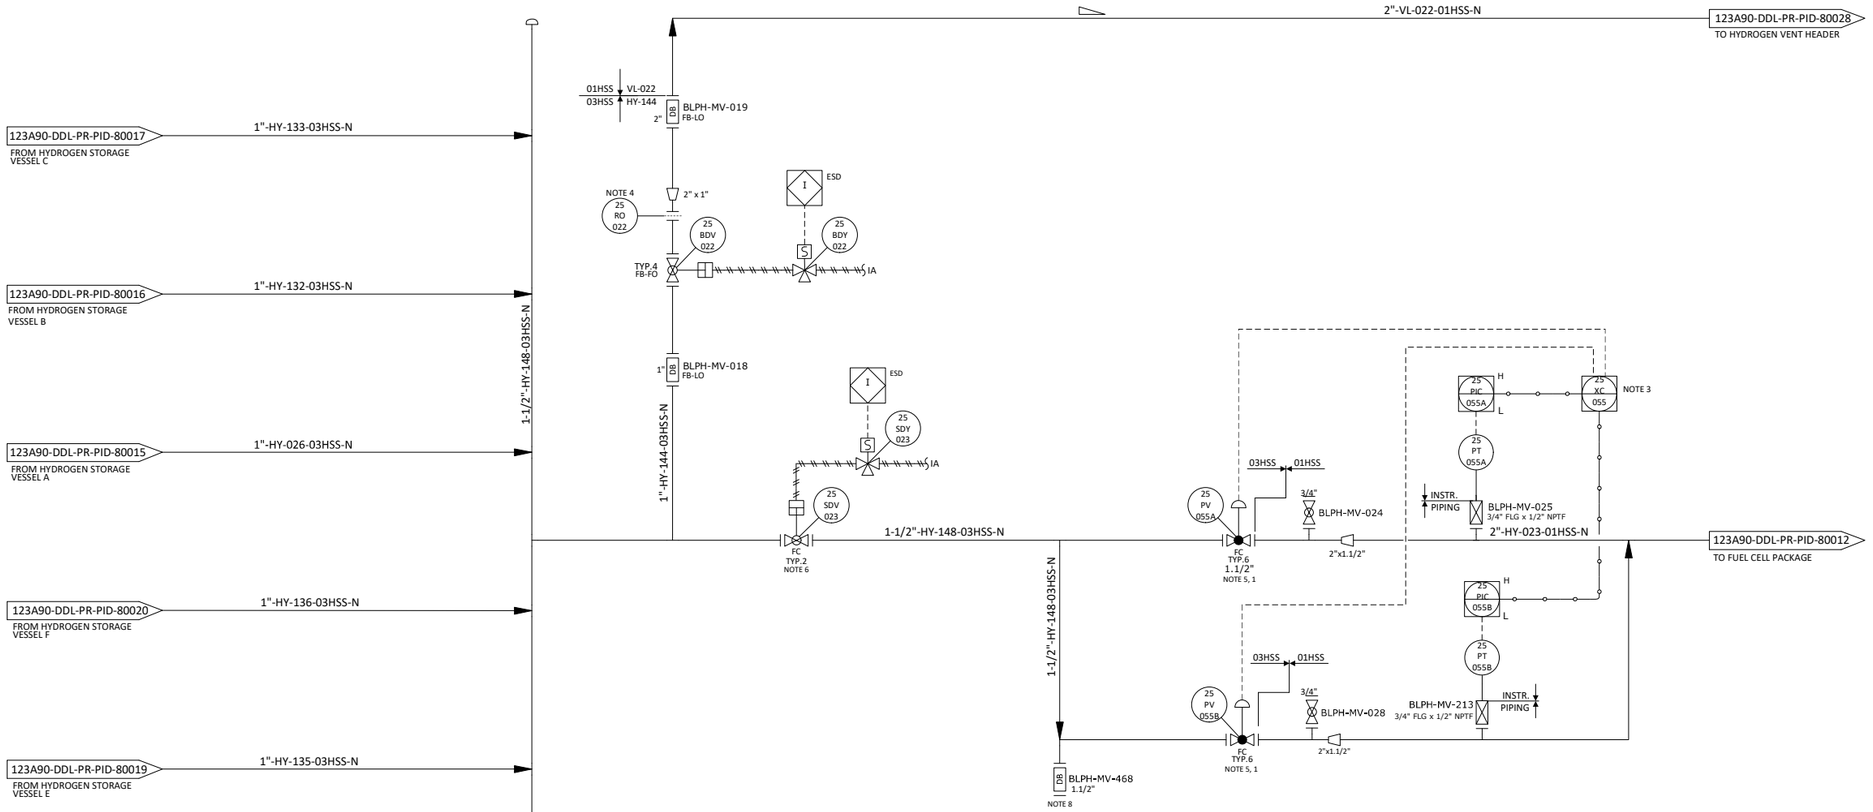

NOTES

1. TIGHT SHUT-OFF VALVE.
2. DELETED.
3. CONTROL VALVES 25-PV-055A/B WORK IN SPLIT RANGE:
   - FOR LOW OPERATING CV (UP TO 0.31) VALVE "B" IS USED
   - FOR HIGH OPERATING CV (FROM 0.31) VALVE "A" IS USED
4. FOR ORIFICE DIAMETER REFERENCE SHALL BE MADE TO "RELIEF, VENT AND BLOWDOWN REPORT" DOC. N. "123A90-DDL-PR-RE-80030".
5. SOFTWARE INTERLOCK PREVENTS OPENING OF THE CONTROL VALVES 25-PV-055A/B IN CASE FUEL CELL PACKAGE (A-80000) IS NOT READY TO START.
6. SDV VALVE 25-SDV-023 TO BE INSTALLED AS CLOSE AS POSSIBLE TO THE CONTROL VALVES 25-PV-055A/B.
7. DELETED.
8. TO BE USED DURING COMMISSIONING PHASE.

HOLDS

1. DELETED.
2. DELETED.

REV.	DATE	DRN	CHKD	APPD	DESCRIPTION
04	21/10/2025	RZI	RZI	CGI	AS BUILT
03	09/09/2024	CIM	RZI	DLO	ACCEPTED FOR CONSTRUCTION (AFC)
02	12/06/2024	CIM	RZI	DLO	ACCEPTED FOR CONSTRUCTION (AFC)
01	15/02/2024	CIM	RZI	DLO	ISSUE FOR ACCEPTANCE (IFA)
00	20/10/2023	CIM	RZI	DLO	ISSUE FOR ACCEPTANCE (IFA)

CROSSWIND

ROSETTI MARINO

TITLE :
BLPH PIPING AND INSTRUMENTATION DIAGRAM
HYDROGEN STORAGE VESSELS HEADER (OUTLET)

CONTRACT NO./TITLE	CW-I-WP4-2023-05/HOLLANDSE KUST NOORD WIND PARK		SCALE NTS
DRAWN	CHECKED	APPROVED	DATE
A1	DRAWING NO. 123A90-DDL-PR-PID-80014	SHEET 001	REV. 04

File Name : FILE_NAME