
DRAWING NO. DRAWING_NO. 123A90-DDL-PR-PID-80025

REV. REV 06

B-50014

BRINE DISCHARGE CAISSON
SIZE : 323 mm (ID) x 21808 mm (H)
MATERIAL : CARBON STEEL)

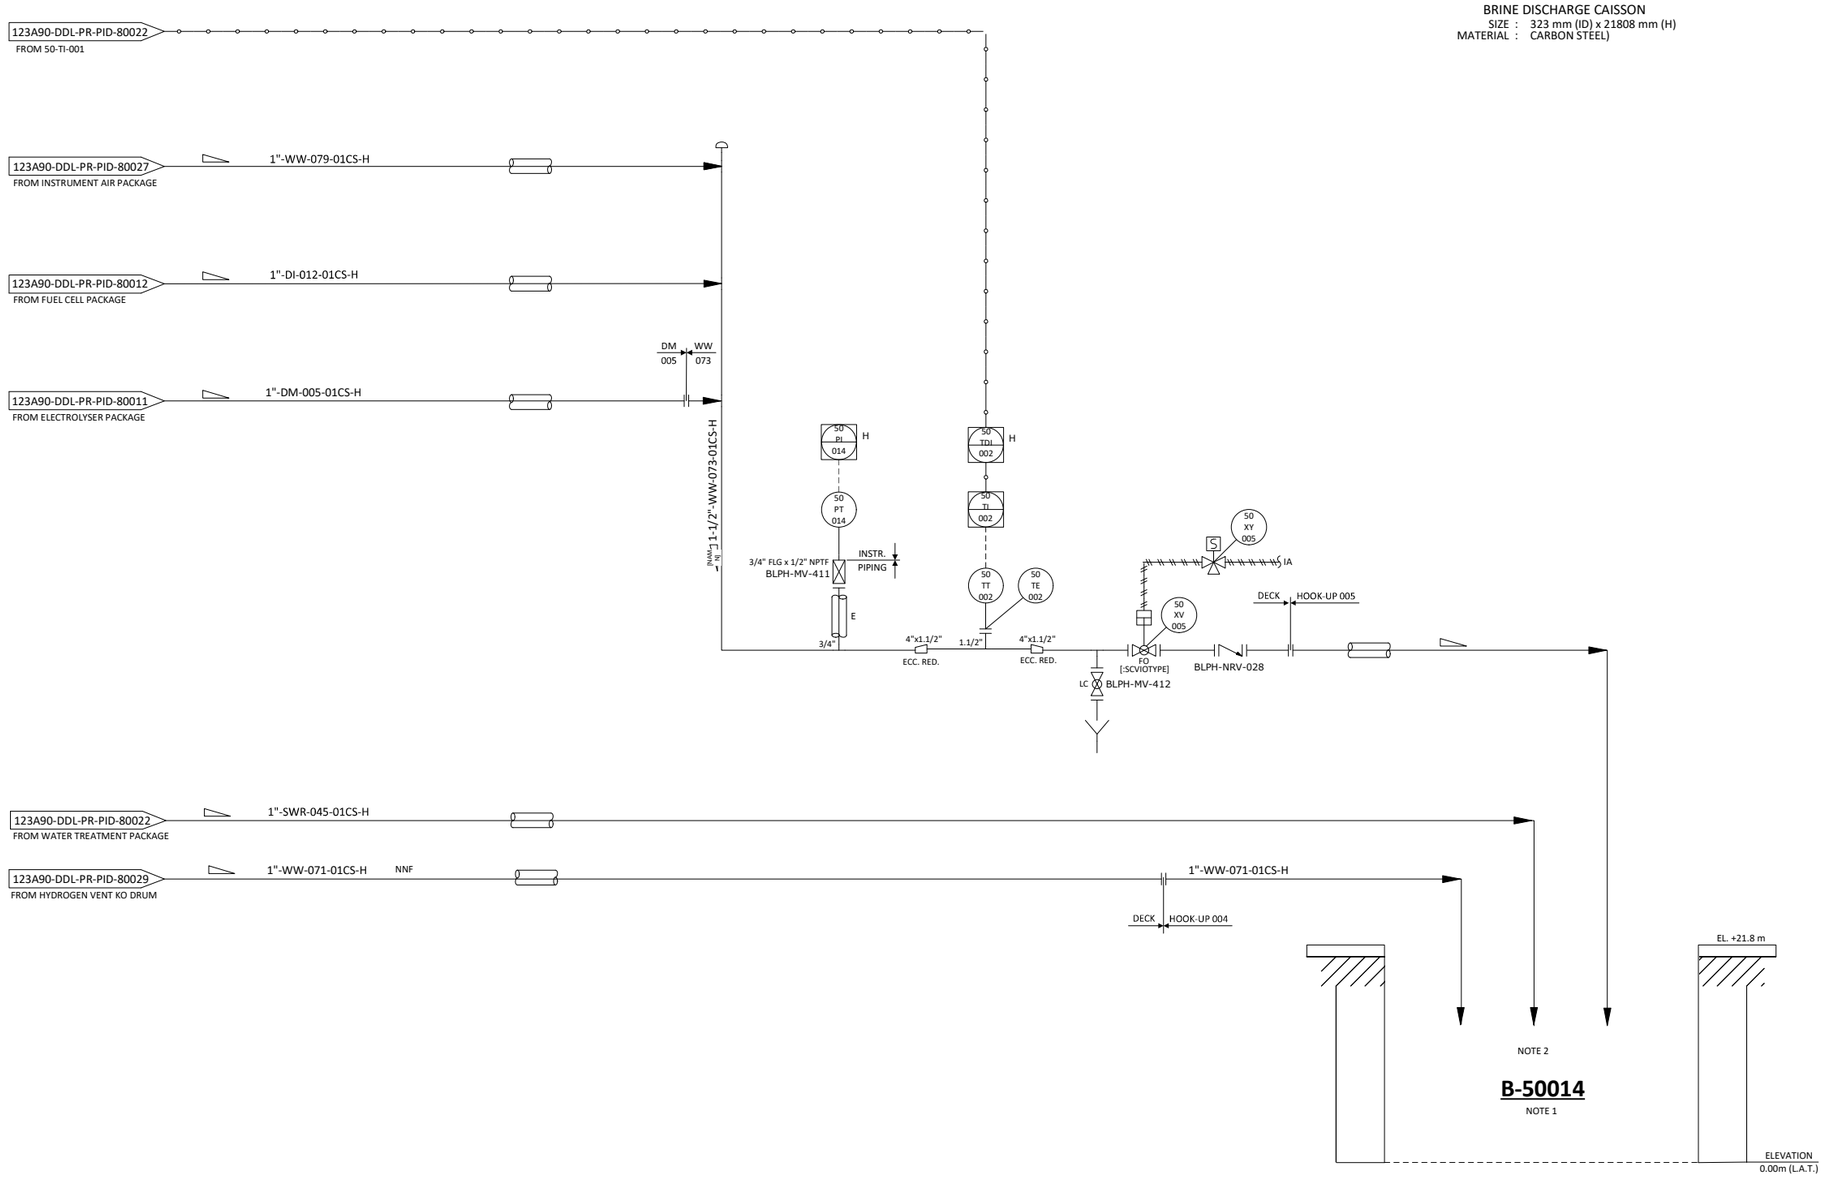

NOTES

1. CAISSON IS OPEN TOPPED.
2. ALL LINES TO TERMINATE APPROXIMATLEY 21000 mm ABOVE SEAWATER LEVEL (LAT).

HOLDS

1. DELETED.

REV.	DATE	DRN	CHKD	APPD	DESCRIPTION
06	21/10/2025	RZI	RZI	CGI	AS BUILT
05	16/04/2025	CIM	RZI	CGI	ACCEPTED FOR CONSTRUCTION (AFC)
04	11/10/2024	CIM	RZI	DLO	ACCEPTED FOR CONSTRUCTION (AFC)
03	09/09/2024	CIM	RZI	DLO	ACCEPTED FOR CONSTRUCTION (AFC)
02	12/06/2024	CIM	RZI	DLO	ACCEPTED FOR CONSTRUCTION (AFC)
01	15/02/2024	CIM	RZI	DLO	ISSUE FOR ACCEPTANCE (IFA)
00	20/10/2023	CIM	RZI	DLO	ISSUE FOR ACCEPTANCE (IFA)

CROSSWIND

ROSETTI MARINO

TITLE :
BLPH PIPING AND INSTRUMENTATION DIAGRAM
WATER DISPOSAL SHEET 1

CONTRACT NO./TITLE	CW-I-WP4-2023-05/HOLLANDSE KUST NOORD WIND PARK	SCALE	NTS
DRAWN	CHECKED	APPROVED	DATE

A1	DRAWING NO. 123A90-DDL-PR-PID-80025	SHEET 001	REV. 06

File Name : FILE_NAME