
DRAWING NO. DRAWING_NO. 123A90-DDL-PR-PID-80026

REV. REV 06

T-55001

WASTE WATER TANK

CAPACITY : 16 m³
DESIGN P/T : 0.005 barg / 80°C
MATERIAL : CARBON STEEL

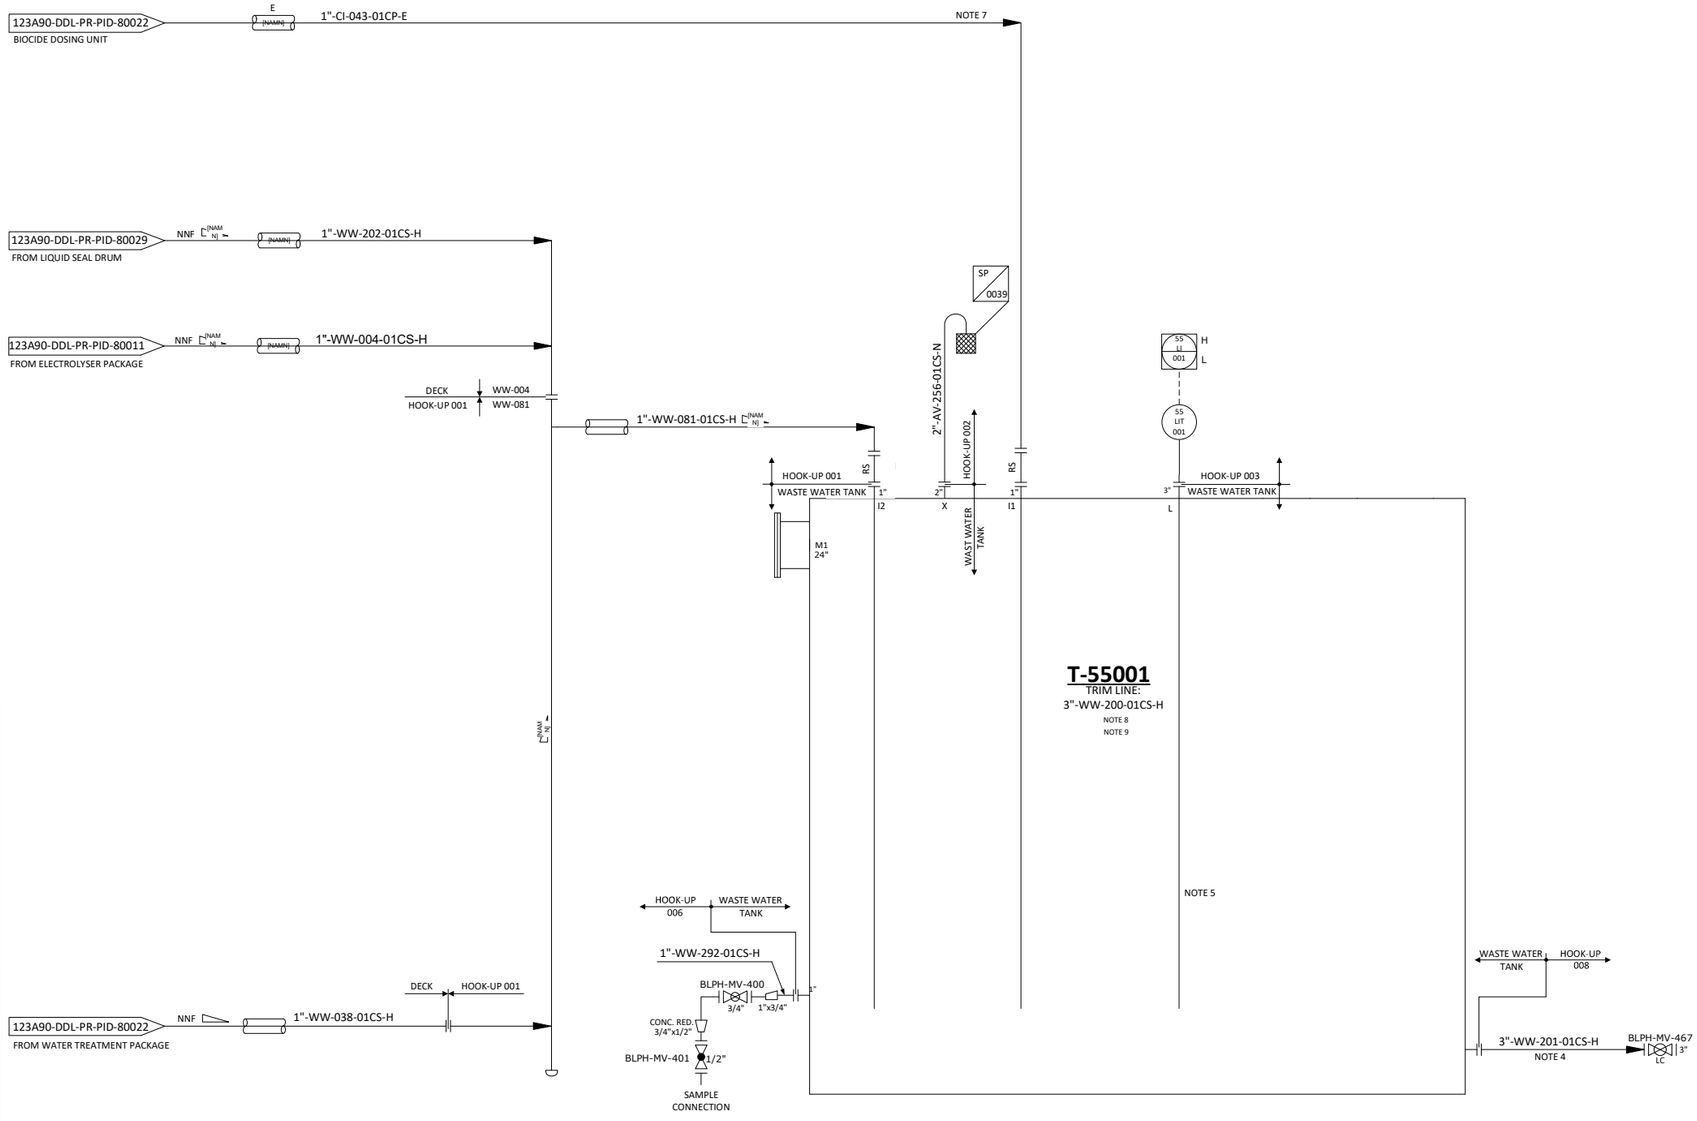

NOTES

1. DELETED.
2. DELETED.
3. DELETED.
4. DRAIN LINE TO SHIP DISPOSAL.
5. PERFORATED STILLING TUBE.
6. DELETED.
7. FOR PERIODIC DOSING OF THE WASTE WATER TANK.
8. FOR DESCRIPTION AND SPECIFICATION OF VESSEL NOZZLE, REFERENCE SHALL BE MADE TO THE TECHNICAL DATA SHEET FOR WASTE WATER TANK - T-55001, DOC. N. "123A90-DDL-MAC-DS-50008"
9. THE WASTE WATER TANK IS FILLED WITH 100% MEG TO AVOID FREEZING THE CONTENT BETWEEN SIX MONTHLY MAINTENANCE PERIOD.

HOLDS

1. DELETED.
2. DELETED.
3. DELETED.
4. DELETED.
5. DELETED.

REV.	DATE	DRN	CHKD	APPD	DESCRIPTION
06	21/10/2025	RZI	RZI	CGI	AS BUILT
05	19/05/2025	CIM	RZI	CGI	ACCEPTED FOR CONSTRUCTION (AFC)
04	16/04/2025	CIM	RZI	CGI	ACCEPTED FOR CONSTRUCTION (AFC)
03	09/09/2024	CIM	RZI	DLO	ACCEPTED FOR CONSTRUCTION (AFC)
02	12/06/2024	CIM	RZI	DLO	ACCEPTED FOR CONSTRUCTION (AFC)
01	15/02/2024	CIM	RZI	DLO	ISSUE FOR ACCEPTANCE (IFA)
00	20/10/2023	CIM	RZI	DLO	ISSUE FOR ACCEPTANCE (IFA)

CROSSWIND

ROSETTI MARINO

TITLE :
BLPH PIPING AND INSTRUMENTATION DIAGRAM
WATER DISPOSAL SHEET 2

CONTRACT NO./TITLE	CW-I-WP4-2023-05/HOLLANDSE KUST NOORD WIND PARK		SCALE	NTS
DRAWN	CHECKED	APPROVED	DATE	
A1	DRAWING NO. 123A90-DDL-PR-PID-80026		SHEET 001	REV. 06

File Name : FILE_NAME