

DRAWING NO. 123A90-DDL-SAF-DL-30030


REV. 02

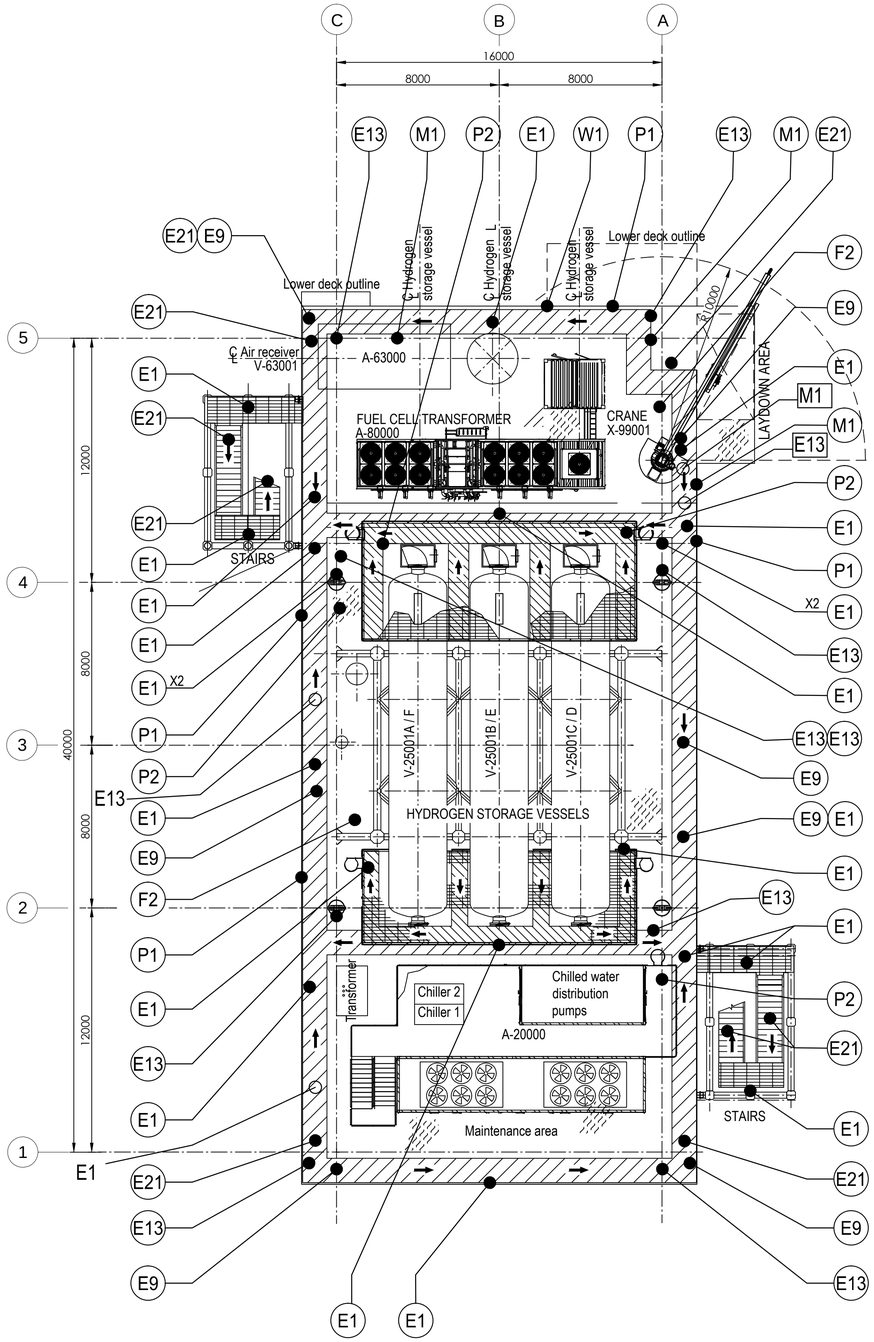

PLAN ON UPPER DECK
EL+30.310 T.O.S.

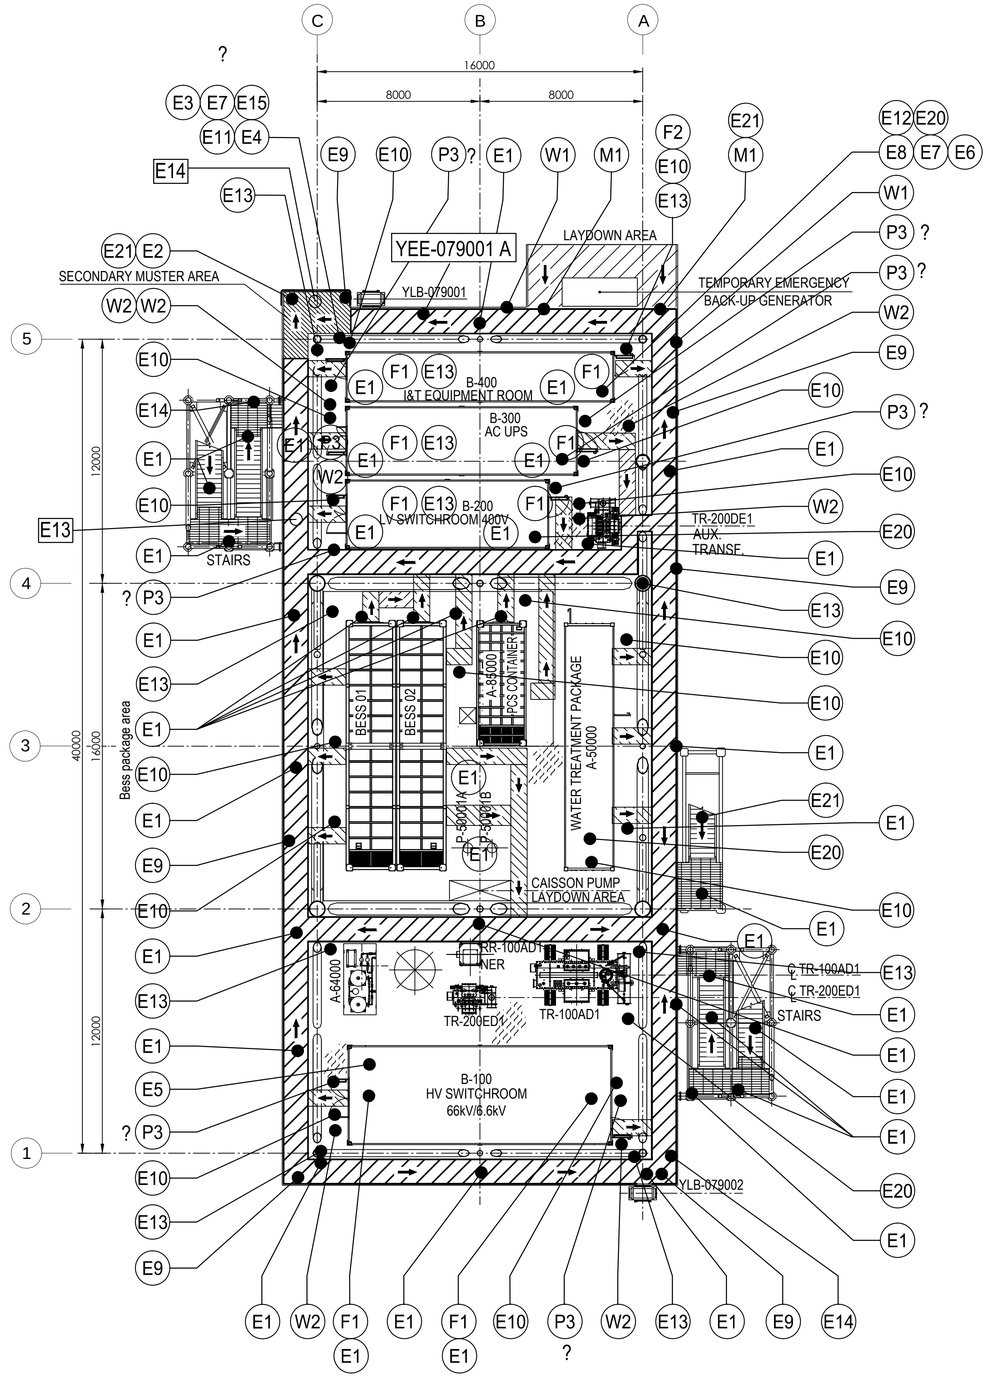

PLAN ON LOWER DECK
EL+23.310 T.O.S.

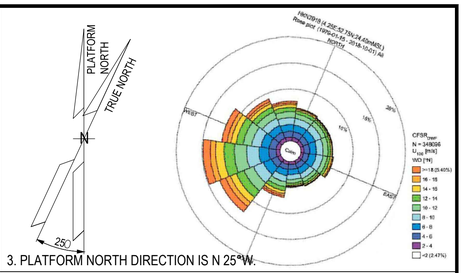

3. PLATFORM NORTH DIRECTION IS N 25°W.

LEGEND

SIMB	DESCRIPTION	Q.ty
E1	ESCAPE ROUTE DIRECTION ARROW (STRAIGHT)	49
E21	ESCAPE ROUTE DIRECTION ARROW (LEFT/RIGHT)	15
E2	MUSTER POINT	1
E3	SAFETY CABINET	1
E5	ELECTRICAL SAFETY KIT	1
E6	RESUSCITATION UNIT	1
E7	FIRST AID KIT	2
E8	ESCAPE MASK	1
E9	LIFE BUOYS	13
E10	EMERGENCY EXIT	14
E11	LIFE JACKET BOX	1
E12	STRETCHER	1
E13	EMERGENCY PUSH BUTTON	20
E14	LIFE RAFT	2
E20	EYE WASH STATION (BOTTLES)	4
F1	FIRE EXTINGUISHER CO2	8
F2	FIRE EXTINGUISHER POWDER	3
M1	WEAR HELMET	5
M2	WEAR EAR PROTECTION	–
M4	WEAR SAFETY VEST	–
P1	OPEN FLAME AND SMOKING PROHIBITED	4
P2	ACCESS ALLOWED ONLY WITH PTW	4
P4	ACCESS FOR UNAUTHORIZED PERSONS PROHIBITED	–
W1	ATTENTION SUSPENDED LOAD	3
W2	ELECTRICAL HAZARD	7

NOTES

BOTH SAFETY SIGNS SHALL BE IN ENGLISH AND DUTCH LANGUAGE.

HOLDS

M2 POSITION TO BE DEFINED. WAITING FOR NOISE REPORT.

REFERENCE DOCUMENTS

123A90-DDL-PP-DS-70070	PLOT PLAN - LOWER & UPPER DECK
123A90-DDL-SAF-DL-30026	ESCAPE ROUTES, FIRE FIGHTING, LIFE SAVING EQUIPMENT AND SAFETY EQUIPMENT LAYOUTS DRAWINGS

REV.	DATE	DRN	CHKD	APPD	DESCRIPTION
02	15/09/25	SPS	CCA	CGI	AS-BUILT (ASB)
01	21/11/24	ECA	CCA	DLO	ACCEPTED FOR CONSTRUCTION (AFC)
00	02/10/24	ECA	CCA	DLO	ISSUE FOR REVIEW (IFR)

CROSSWIND

ROSETTI MARINO

TITLE :
SAFETY SIGN
EQUIPMENT LAYOUT DRAWINGS

CONTRACT NO./TITLE CW-I-WP4-2023-05/HOLLANDSE KUST NOORD WIND PARK | SCALE 1:150

DRAWN SPS | CHECKED C. CARACCIOLO | APPROVED CGI | DATE 15/09/25

A1 | DRAWING NO. 123A90-DDL-SAF-DL-30030 | SHEET 001 | REV. 02

File Name : 123A90-DDL-SAF-DL-30030 REV.02