

DRAWING NO. 123A90-DDL-ST-DD-90037 REV. 02

TYPICAL FIXED HANDRAIL

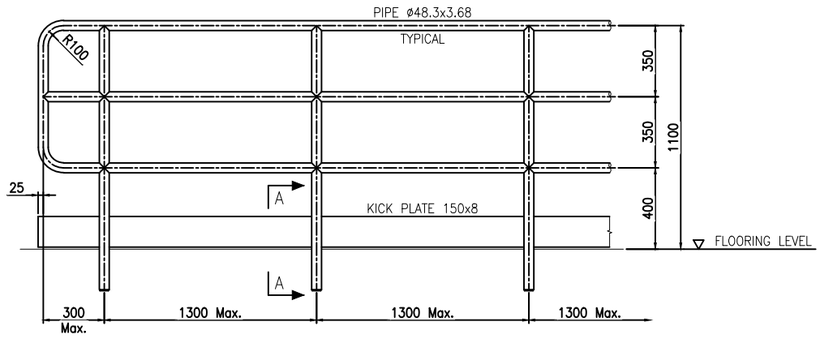



TYPICAL REMOVABLE HANDRAIL

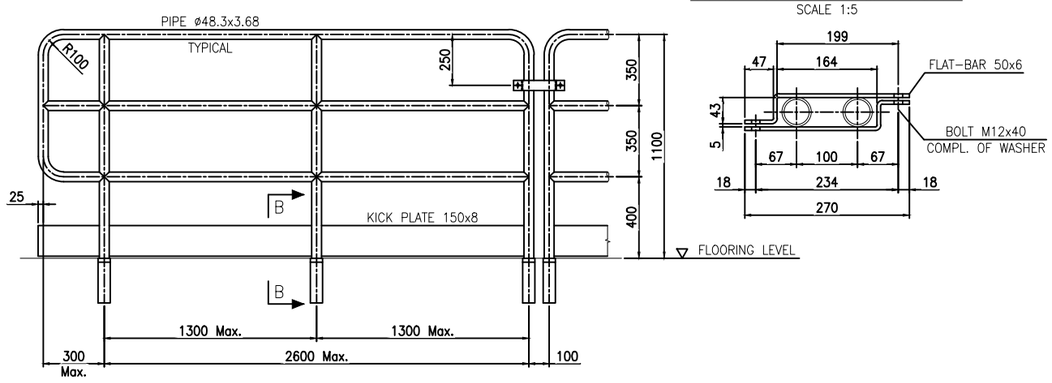

CLAMP FOR REMOVABLE HANDRAIL
SCALE 1:5

FIXED HANDRAIL – SECTION A–A (SCALE 1:5)

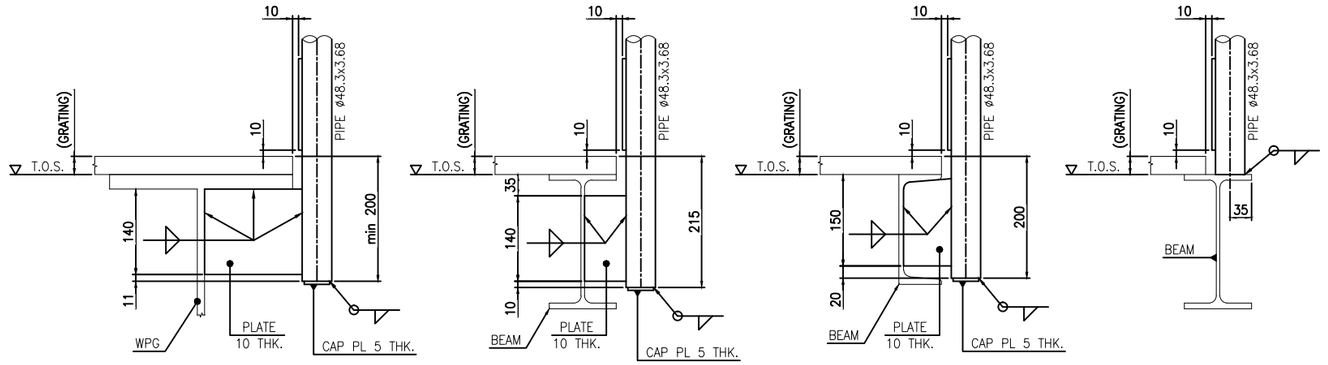

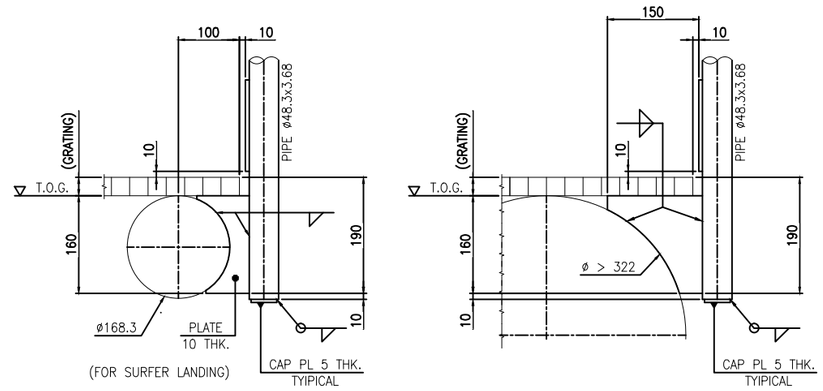


NOTES:

1 – ALL DIMENSIONS ARE IN mm (U.N.O.)
2 – ALL FILLET WELDS SHALL BE CONTINUOUS AND THE LEG SIZE SHALL BE EQUAL 0.7 THE MINIMUM THICKNESS TO BE JOINTED U.N.O.
3 – ALL HANDRAILS PANELS, KICK PLATES AND FITTINGS TO BE "HOT DIP".
4 – ALL BOLTS, NUTS AND WASHERS TO BE "SPUN" GALVANIZED.

TYPICAL HANDRAIL FOR STAIR


FIXED HANDRAIL DETAIL
SCALE 1:5

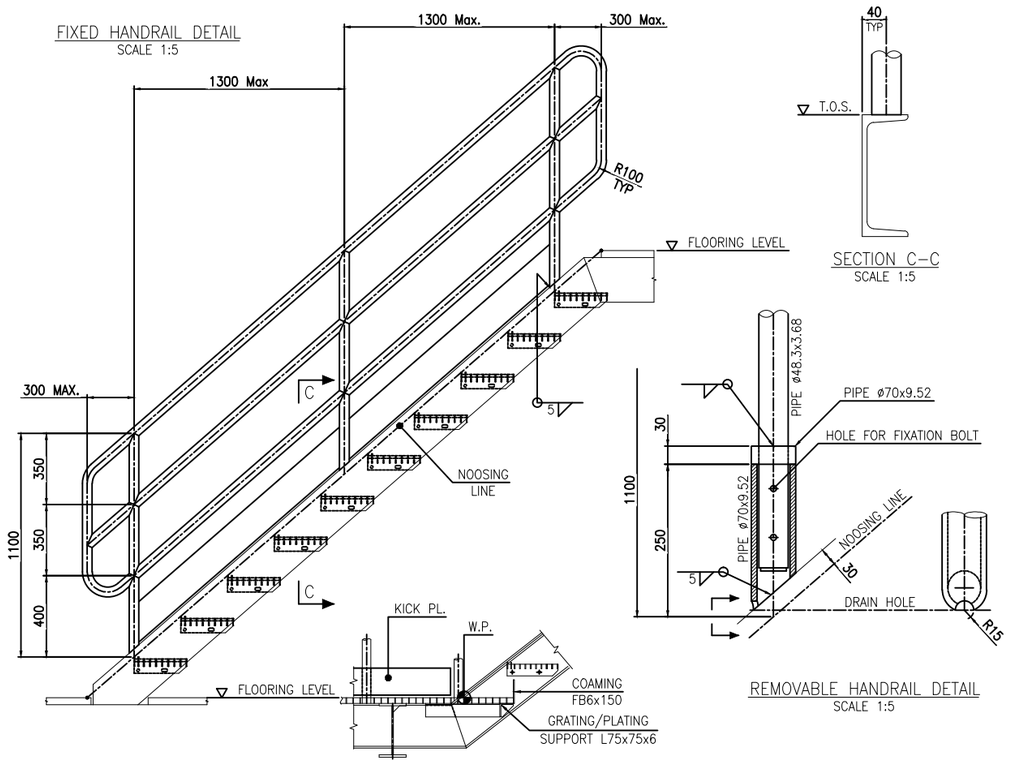


SECTION C–C
SCALE 1:5

REMOVABLE HANDRAIL DETAIL
SCALE 1:5

REMOVABLE HANDRAIL – SECTION B–B (SCALE 1:5)

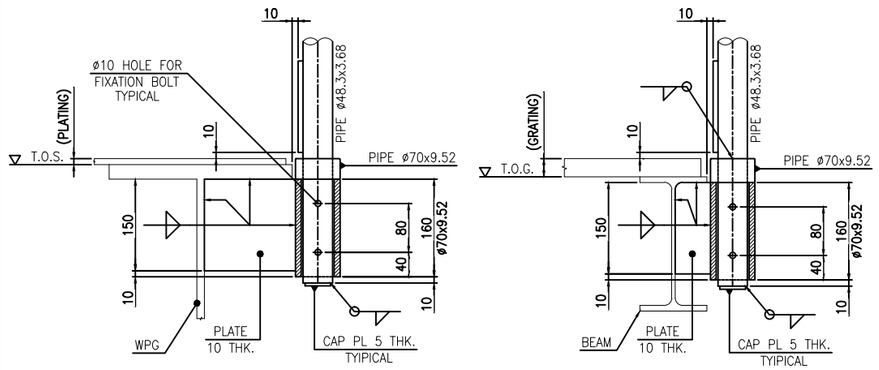

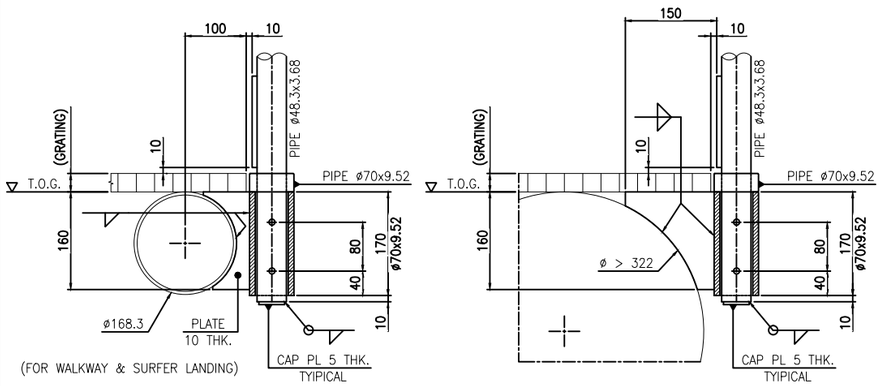

REV.	DATE	DRN	CHKD	APPD	DESCRIPTION
02	22/09/25	SPS	AB	CGI	AS-BUILT (ASB)
01	31/01/24	SGR	AB	DLS	ACCEPTED FOR CONSTRUCTION (AFC)
00	13/10/23	SGR	AB	DLS	ISSUE FOR REVIEW (IFR)

TECON

CROSSWIND

ROSETTI MARINO

TITLE :
BASE LOAD POWER HUB (BLPH)
STANDARD DRAWINGS
HANDRAILS

CONTRACT NO./TITLE CW-I-WP4-2023-05/HOLLANDSE KUST NOORD WIND PARK		SCALE 1:15	
DRAWN SPS	CHECKED A.BALZAROTTI	APPROVED CGI	DATE 22/09/25
A1	DRAWING NO. 123A90-DDL-ST-DD-90037	SHEET 001	REV. 02

File Name : 123A90-DDL-ST-DD-90037 REV.02.dwg