

DRAWING NO. 123A90-DDL-ST-DD-90054


REV. 05

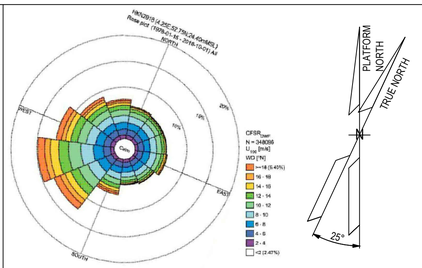

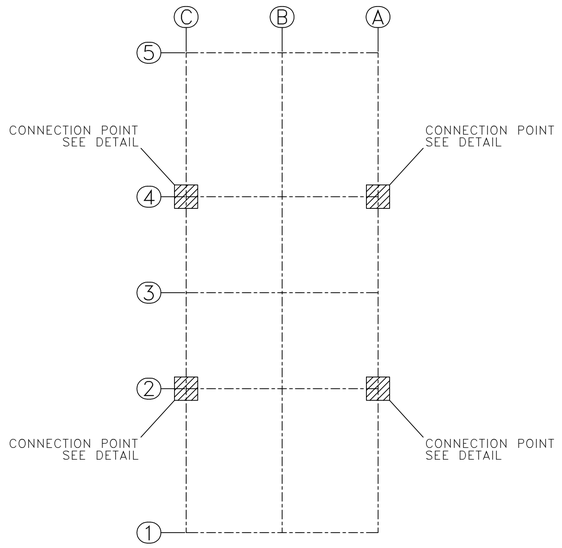


KEY PLAN

SCALE 1:250

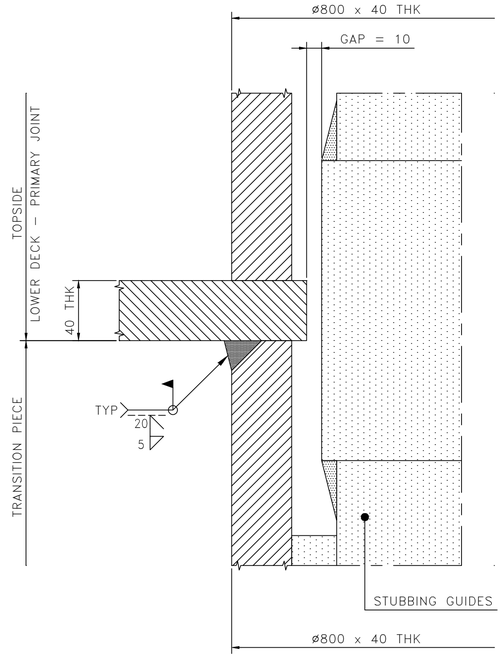


NOMINAL POSITION

SCALE 1:2

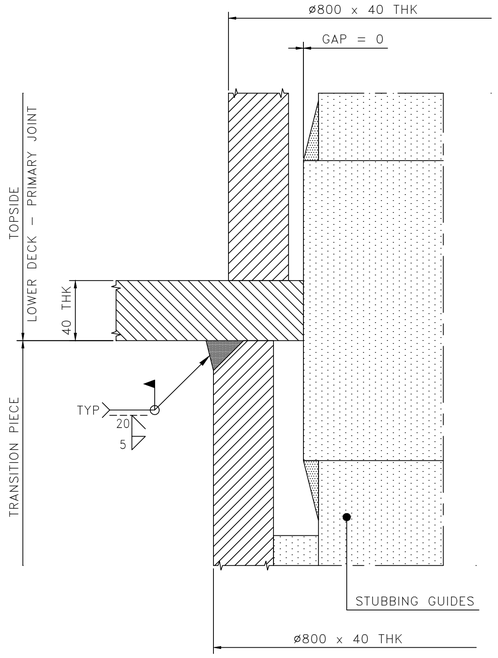

OPTION –1– NO GAP

SCALE 1:2

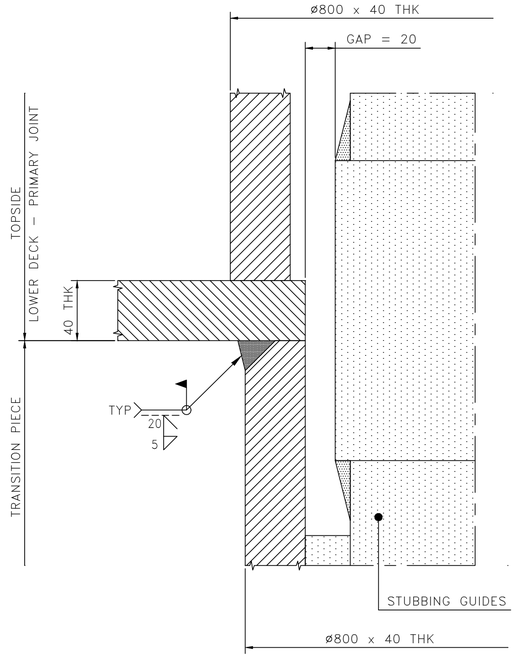

OPTION –2– MAXIMUM GAP

SCALE 1:2

NOTES

1 – ALL DIMENSIONS AND ELEVATIONS ARE IN MILLIMETERS U.N.O.
2 – ALL ELEVATIONS ARE REFERED TO C.D.
3 – ALL FILLET WELDS SHALL BE CONTINUOUS AND THE LEG SIZE (z) SHALL BE EQUAL 0.7 THE MINIMUM THICKNESS TO BE JOINTED U.N.O.

MATERIALS

ITEM IDENTIFICATION	MATERIAL DESIGNATION

HOLDS

REFERENCE DRAWINGS

DWG No.	DESCRIPTION
123A90-DDL-ST-DD-90025	DRAWING LIST
123A90-DDL-ST-DD-90026	GENERAL NOTES
123A90-DDL-ST-DD-90027	WELDING GENERAL NOTES
123A90-DDL-ST-DD-90051	PRIMARY JOINTS – LOWER DECK – JOINT –1– DETAIL
123A90-DDL-ST-DD-90086	TP – TOPSIDE SUPPORT POINT
123A90-DDL-TI-DD-99042	TP – STABBING GUIDES – ASSEMBLY AND DETAILS

TECON

REV.	DATE	DRN	CHKD	APPD	DESCRIPTION
05	22/09/25	SPS	AB	CGI	AS-BUILT (ASB)
04	16/09/24	SGR	AB	DLS	ACCEPTED FOR CONSTRUCTION (AFC)
03	02/07/24	SGR	AB	DLS	ACCEPTED FOR CONSTRUCTION (AFC)
02	23/05/24	SGR	AB	DLS	ACCEPTED FOR CONSTRUCTION (AFC)
01	12/03/24	SGR	AB	DLS	ISSUE FOR APPROVAL (IFA)

CROSSWIND | ROSETTI MARINO

TITLE :

BASE LOAD POWER HUB (BLPH)
TOPSIDE
TOPSIDE TO TP WELD CONNECTION – DETAILS

CONTRACT NO./TITLE CW-I-WP4-2023-05/HOLLANDSE KUST NOORD WIND PARK | SCALE 1:75

DRAWN SPS | CHECKED A.BALZAROTTI | APPROVED CGI | DATE 22/09/25

A1 | DRAWING NO. 123A90-DDL-ST-DD-90054 | SHEET 001 | REV. 05

File Name : 123A90-DDL-ST-DD-90054_05.dwg