

DRAWING NO. 123A90-DDL-ST-DD-90060

REV. 03

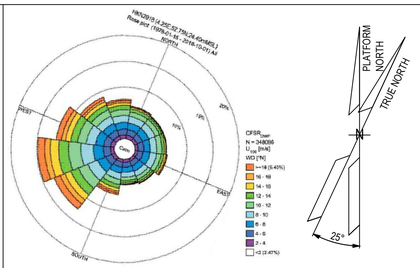

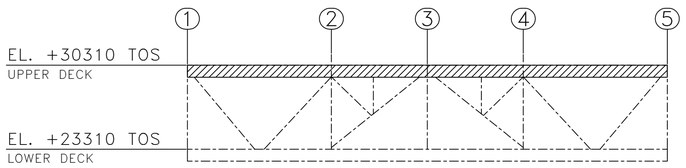


KEY ELEVATION

SCALE 1:250

LEGEND

- FLAT PLATE – 8 THK
- FLAT PLATE – 10 THK
- GRATING – MESH 30 x 50 BEARING PLATE 30 x 5
- GRATING – BEARING BAR DIRECTION
- FIXED HANDRAILS
- REMOVABLE HANDRAILS
- HEAVY DUTY HANDRAILS

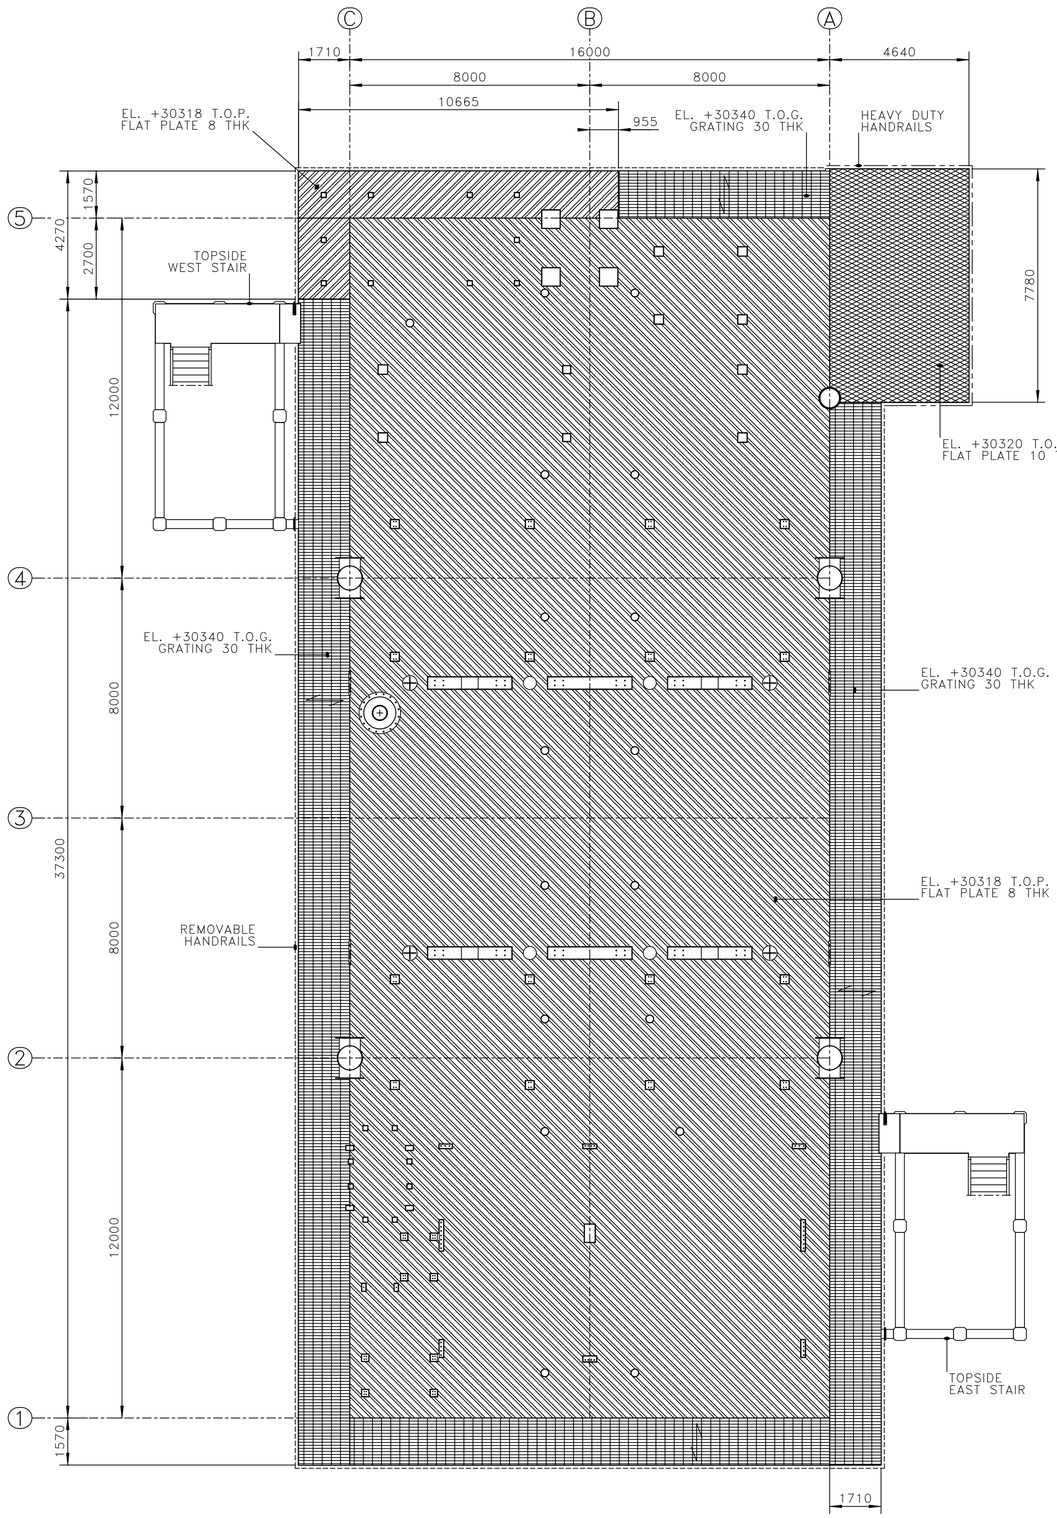

PLAN AT EL.+30310 TOS

SCALE 1:100

NOTES

1 – ALL DIMENSIONS AND ELEVATIONS ARE IN MILLIMETERS U.N.O.
2 – ALL ELEVATIONS ARE REFERED TO C.D.

MATERIALS

ITEM IDENTIFICATION	MATERIAL DESIGNATION
PL 30 THK	DC5-IV-235-10_GRATING
PL 8 THK	DC5-IV-355-10
PL 10 THK	DC5-IV-355-10

HOLDS

REFERENCE DRAWINGS

DWG No.	DESCRIPTION
123A90-DDL-ST-DD-90025	DRAWING LIST
123A90-DDL-ST-DD-90026	GENERAL NOTES
123A90-DDL-ST-DD-90027	WELDING GENERAL NOTES
123A90-DDL-ST-DD-90037	STANDARD DRAWINGS – HANDRAILS
123A90-DDL-ST-DD-90038	HEAVY DUTY HANDRAILS
123A90-DDL-ST-DD-90039	PLATING AND GRATING TYPICAL DETAILS
123A90-DDL-ST-DD-90050	PRIMARY STEEL – PLAN AT EL +30310 TOS
123A90-DDL-ST-DD-90058	SEC. STEEL – PLAN AT EL +30310 TOS – SH. 1
123A90-DDL-ST-DA-90070	TOPSIDE – UPPER DECK – EQUIPMENT SUPPORTS
123A90-DDL-ST-DD-90075	DRAIN SYSTEM – PLAN AT EL +30310 TOS
123A90-DDL-ST-DD-90105	SEC. STEEL – PLAN AT EL +30310 TOS – SH. 2

TECON

REV.	DATE	DRN	CHKD	APPD	DESCRIPTION
03	22/09/25	SPS	AB	CGI	AS-BUILT (ASB)
02	22/08/24	SGR	AB	DLS	ACCEPTED FOR CONSTRUCTION (AFC)
01	02/07/24	SGR	AB	DLS	ACCEPTED FOR CONSTRUCTION (AFC)
00	01/12/23	SGR	AB	DLS	ISSUE FOR REVIEW (IFR)

CROSSWIND

ROSETTI MARINO

TITLE :

BASE LOAD POWER HUB (BLPH)
TOPSIDE – FLOORING
PLAN AT EL. +30310 T.O.S.

CONTRACT NO./TITLE CW-I-WP4-2023-05/HOLLANDSE KUST NOORD WIND PARK | SCALE 1:100

DRAWN SPS | CHECKED A.BALZAROTTI | APPROVED CGI | DATE 22/09/25

A1 | DRAWING NO. 123A90-DDL-ST-DD-90060 | SHEET 001 | REV. 03

File Name : 123A90-DDL-ST-DD-90060_03.dwg