


DRAWING NO. 123A90-DDL-ST-DD-90081

REV. 04

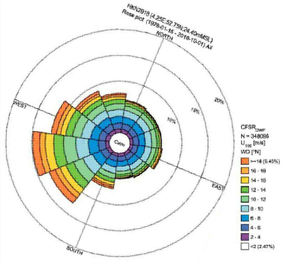

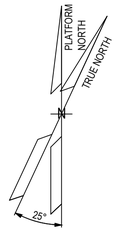

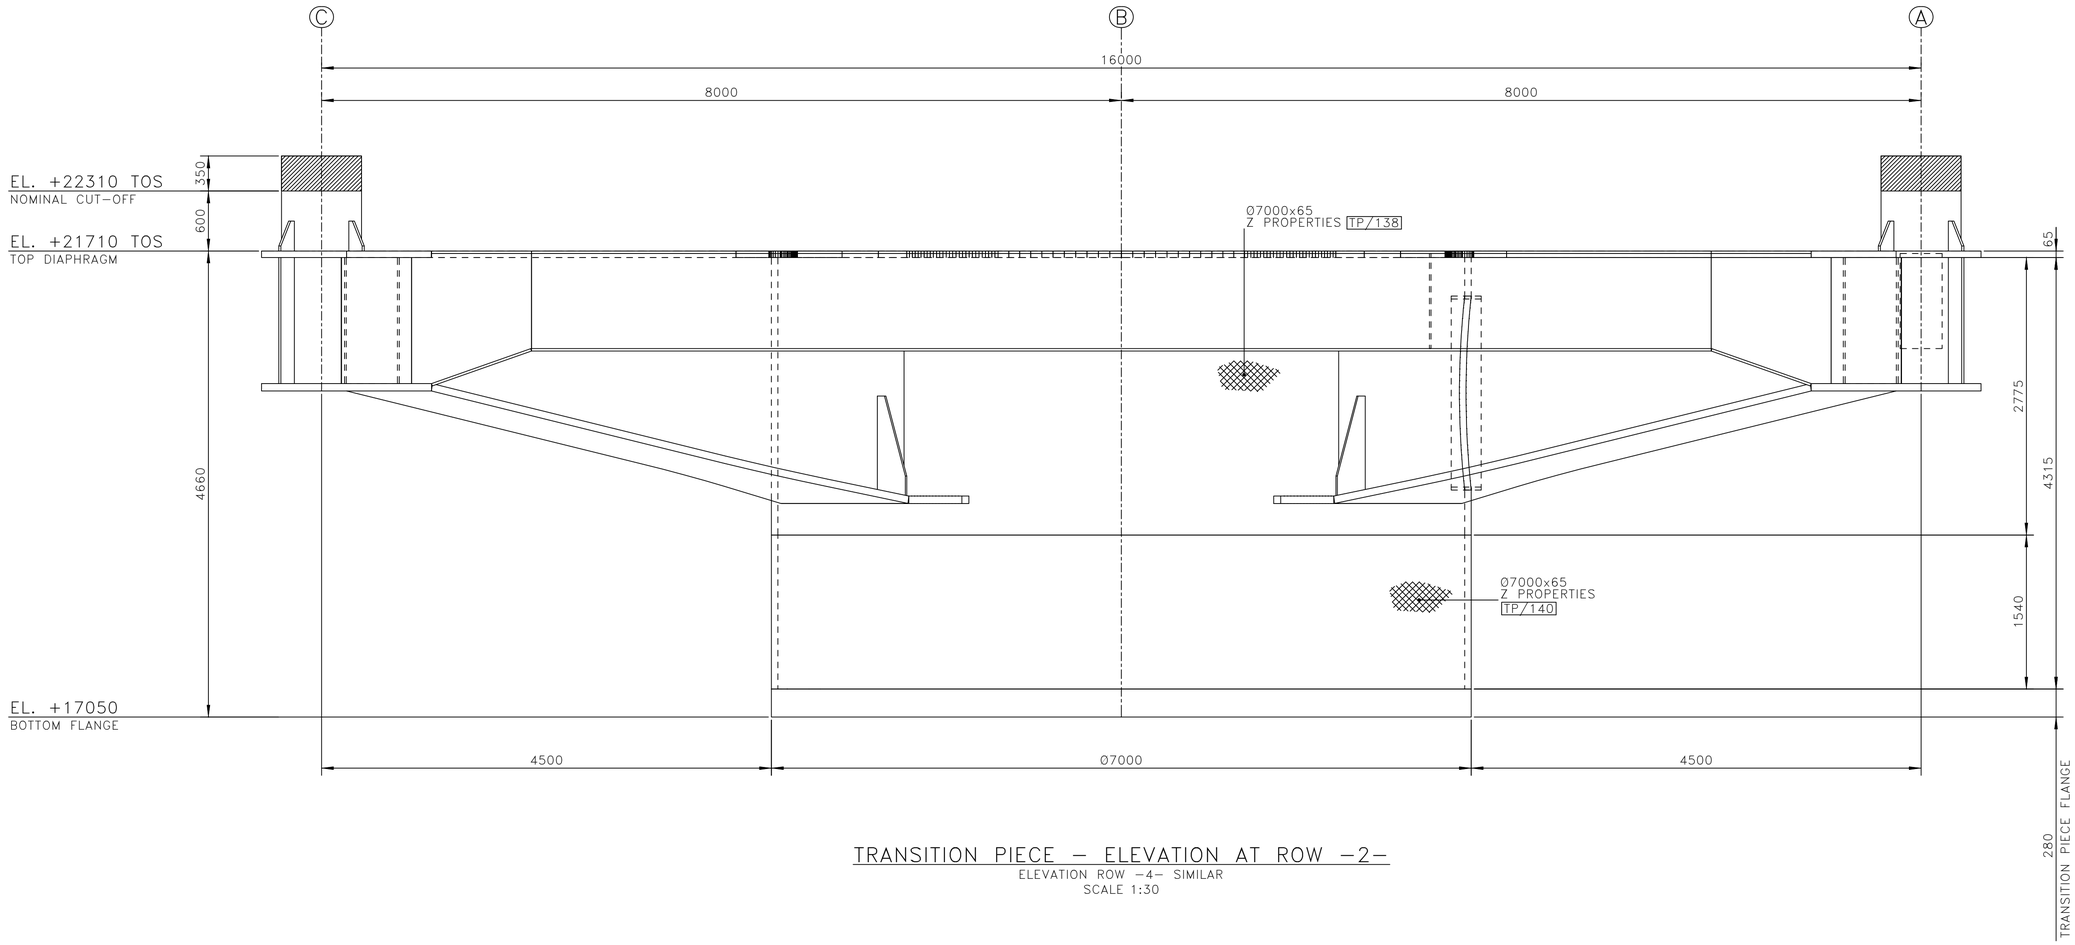

TRANSITION PIECE – ELEVATION AT ROW –2–

ELEVATION ROW –4– SIMILAR
SCALE 1:30

NOTES

1 – ALL DIMENSIONS AND ELEVATIONS ARE IN MILLIMETERS U.N.O.
2 – ALL ELEVATIONS ARE REFERED TO C.D.

MATERIALS

HOLDS

REFERENCE DRAWINGS

DWG No.	DESCRIPTION
123A90-DDL-ST-DD-90025	DRAWING LIST
123A90-DDL-ST-DD-90026	GENERAL NOTES
123A90-DDL-ST-DD-90027	WELDING GENERAL NOTES
123A90-DDL-ST-DD-90085	TP – PRIMARY STEEL – PLAN AT EL. +21710 TOS

TECON

REV.	DATE	DRN	CHKD	APPD	DESCRIPTION
04	22/09/25	SPS	AB	CGI	AS-BUILT (ASB)
03	05/11/24	SGR	AB	DLS	ACCEPTED FOR CONSTRUCTION (AFC)
02	25/03/24	SGR	AB	DLS	ACCEPTED FOR CONSTRUCTION (AFC)
01	20/12/23	SGR	AB	DLS	ACCEPTED FOR CONSTRUCTION (AFC)
00	08/11/23	SGR	AB	DLS	ISSUE FOR REVIEW (IFR)

CROSSWIND | ROSETTI MARINO

TITLE :
BASE LOAD POWER HUB (BLPH)
TP – PRIMARY STEEL
ELEVATION ROW –2–

CONTRACT NO./TITLE CW-I-WP4-2023-05/HOLLANDSE KUST NOORD WIND PARK | SCALE 1:30

DRAWN SPS | CHECKED A.BALZAROTTI | APPROVED CGI | DATE 22/09/25

A1 | DRAWING NO. 123A90-DDL-ST-DD-90081 | SHEET 001 | REV. 04

File Name : 123A90-DDL-ST-DD-90081_04.dwg