

DRAWING NO. 123A90-DDL-ST-DD-90105


REV. 03

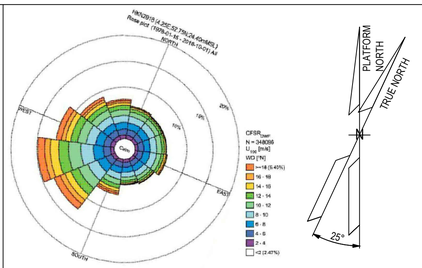

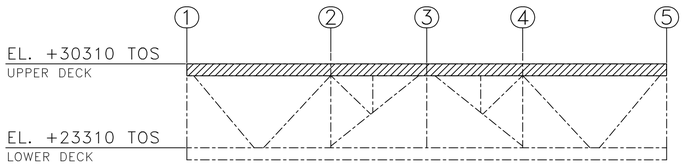

KEY ELEVATION

SCALE 1:250

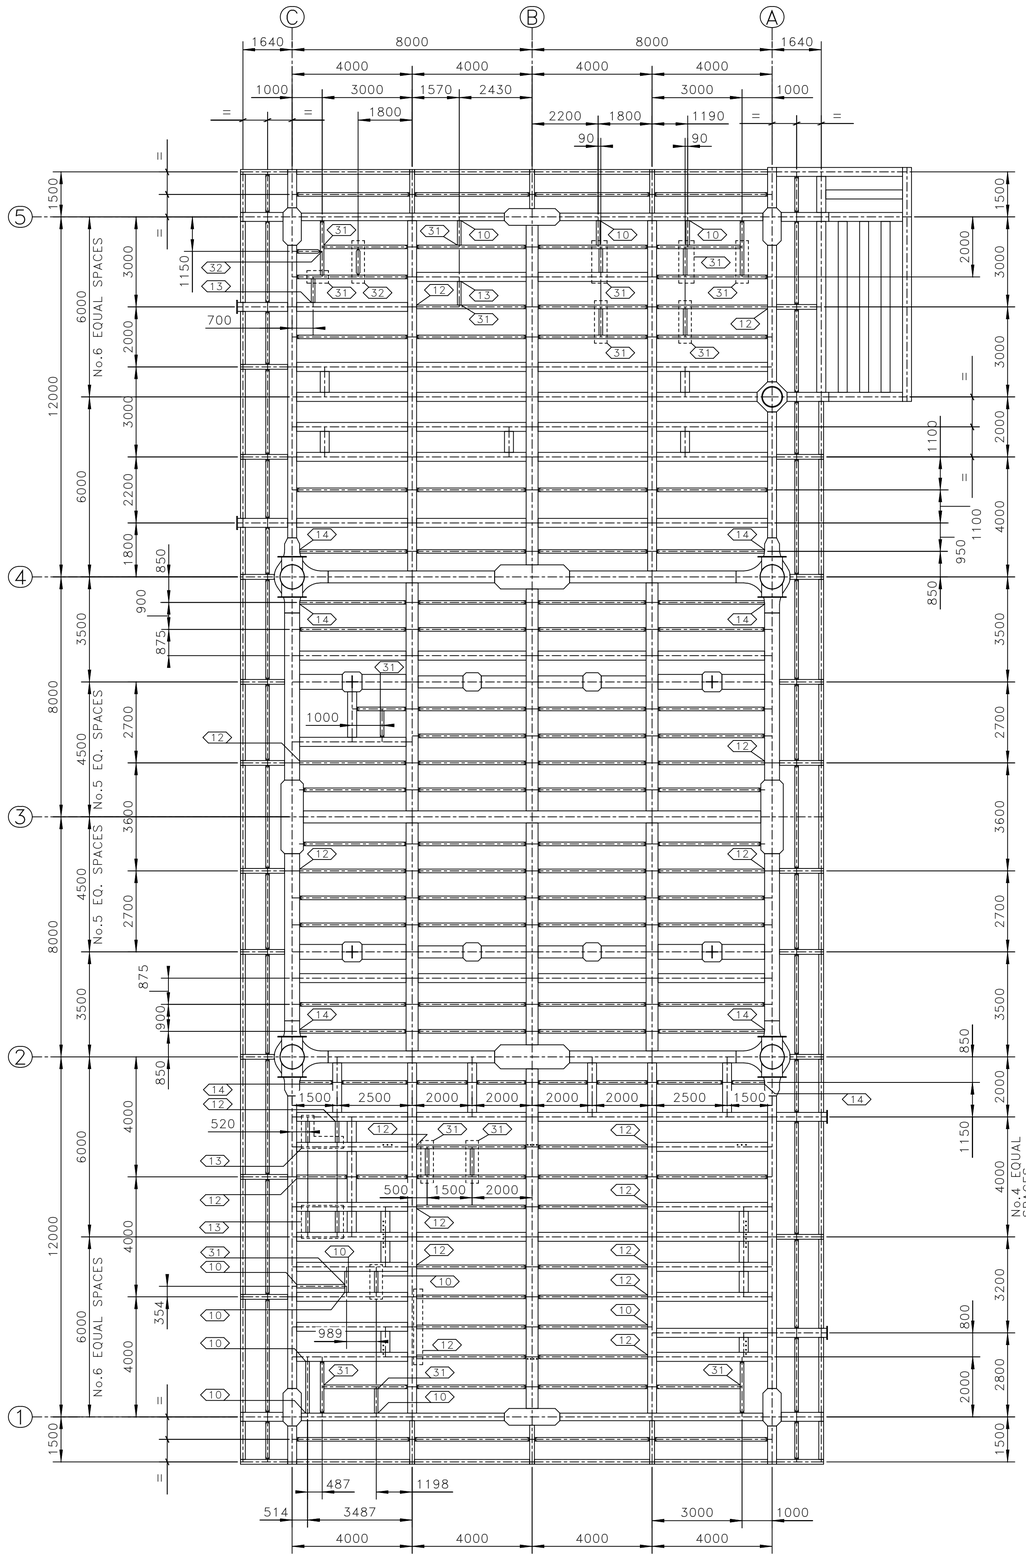

PLAN AT EL.+30310 TOS

ALL BEAMS ARE IPE240 U.N.O. – ALL CONNECTIONS ARE ⟨11⟩ U.N.O.

SCALE 1:100

NOTES

1 – ALL DIMENSIONS AND ELEVATIONS ARE IN MILLIMETERS U.N.O.
2 – ALL ELEVATIONS ARE REFERED TO C.D.
3 – ALL STIFFENER MATERIALS ARE DC4-III-355-0 U.N.O.

MATERIALS

ITEM IDENTIFICATION	MATERIAL DESIGNATION
IPE240	DC4-III-355-0

HOLDS

REFERENCE DRAWINGS

DWG No.	DESCRIPTION
123A90-DDL-ST-DD-90025	DRAWING LIST
123A90-DDL-ST-DD-90026	GENERAL NOTES
123A90-DDL-ST-DD-90027	WELDING GENERAL NOTES
123A90-DDL-ST-DD-90034	TYPICAL BEAM CONNECTIONS
123A90-DDL-ST-DD-90050	PRIMARY STEEL – PLAN AT EL +30310 TOS
123A90-DDL-ST-DD-90058	SEC. STEEL – PLAN AT EL +30310 TOS – SH. 1

TECON

REV.	DATE	DRN	CHKD	APPD	DESCRIPTION
03	22/09/25	SPS	AB	CGI	AS-BUILT (ASB)
02	16/09/24	SGR	AB	DLS	ACCEPTED FOR CONSTRUCTION (AFC)
01	23/05/24	SGR	AB	DLS	ACCEPTED FOR CONSTRUCTION (AFC)
00	01/12/23	SGR	AB	DLS	ISSUE FOR REVIEW (IFR)

CROSSWIND

ROSETTI MARINO

TITLE :

BASE LOAD POWER HUB (BLPH)
TOPSIDE – SECONDARY STEEL
PLAN AT EL. +30310 T.O.S. – SHEET 2

CONTRACT NO./TITLE CW-I-WP4-2023-05/HOLLANDSE KUST NOORD WIND PARK | SCALE 1:100

DRAWN SPS | CHECKED A.BALZAROTTI | APPROVED CGI | DATE 22/09/25

A1 | DRAWING NO. 123A90-DDL-ST-DD-90105 | SHEET 001 | REV. 03

File Name : 123A90-DDL-ST-DD-90105_03.dwg