


DRAWING NO. 123A90-DDL-ST-DD-90126

REV. 02

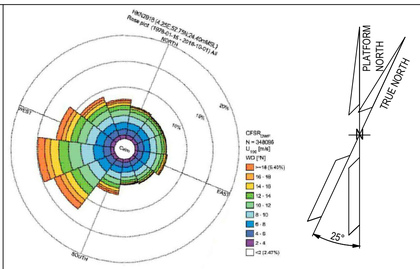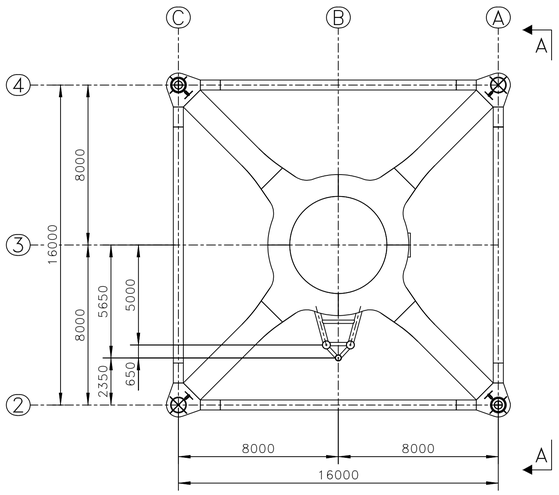


TP – CAISSON FRAME
KEY PLAN
SCALE 1:150

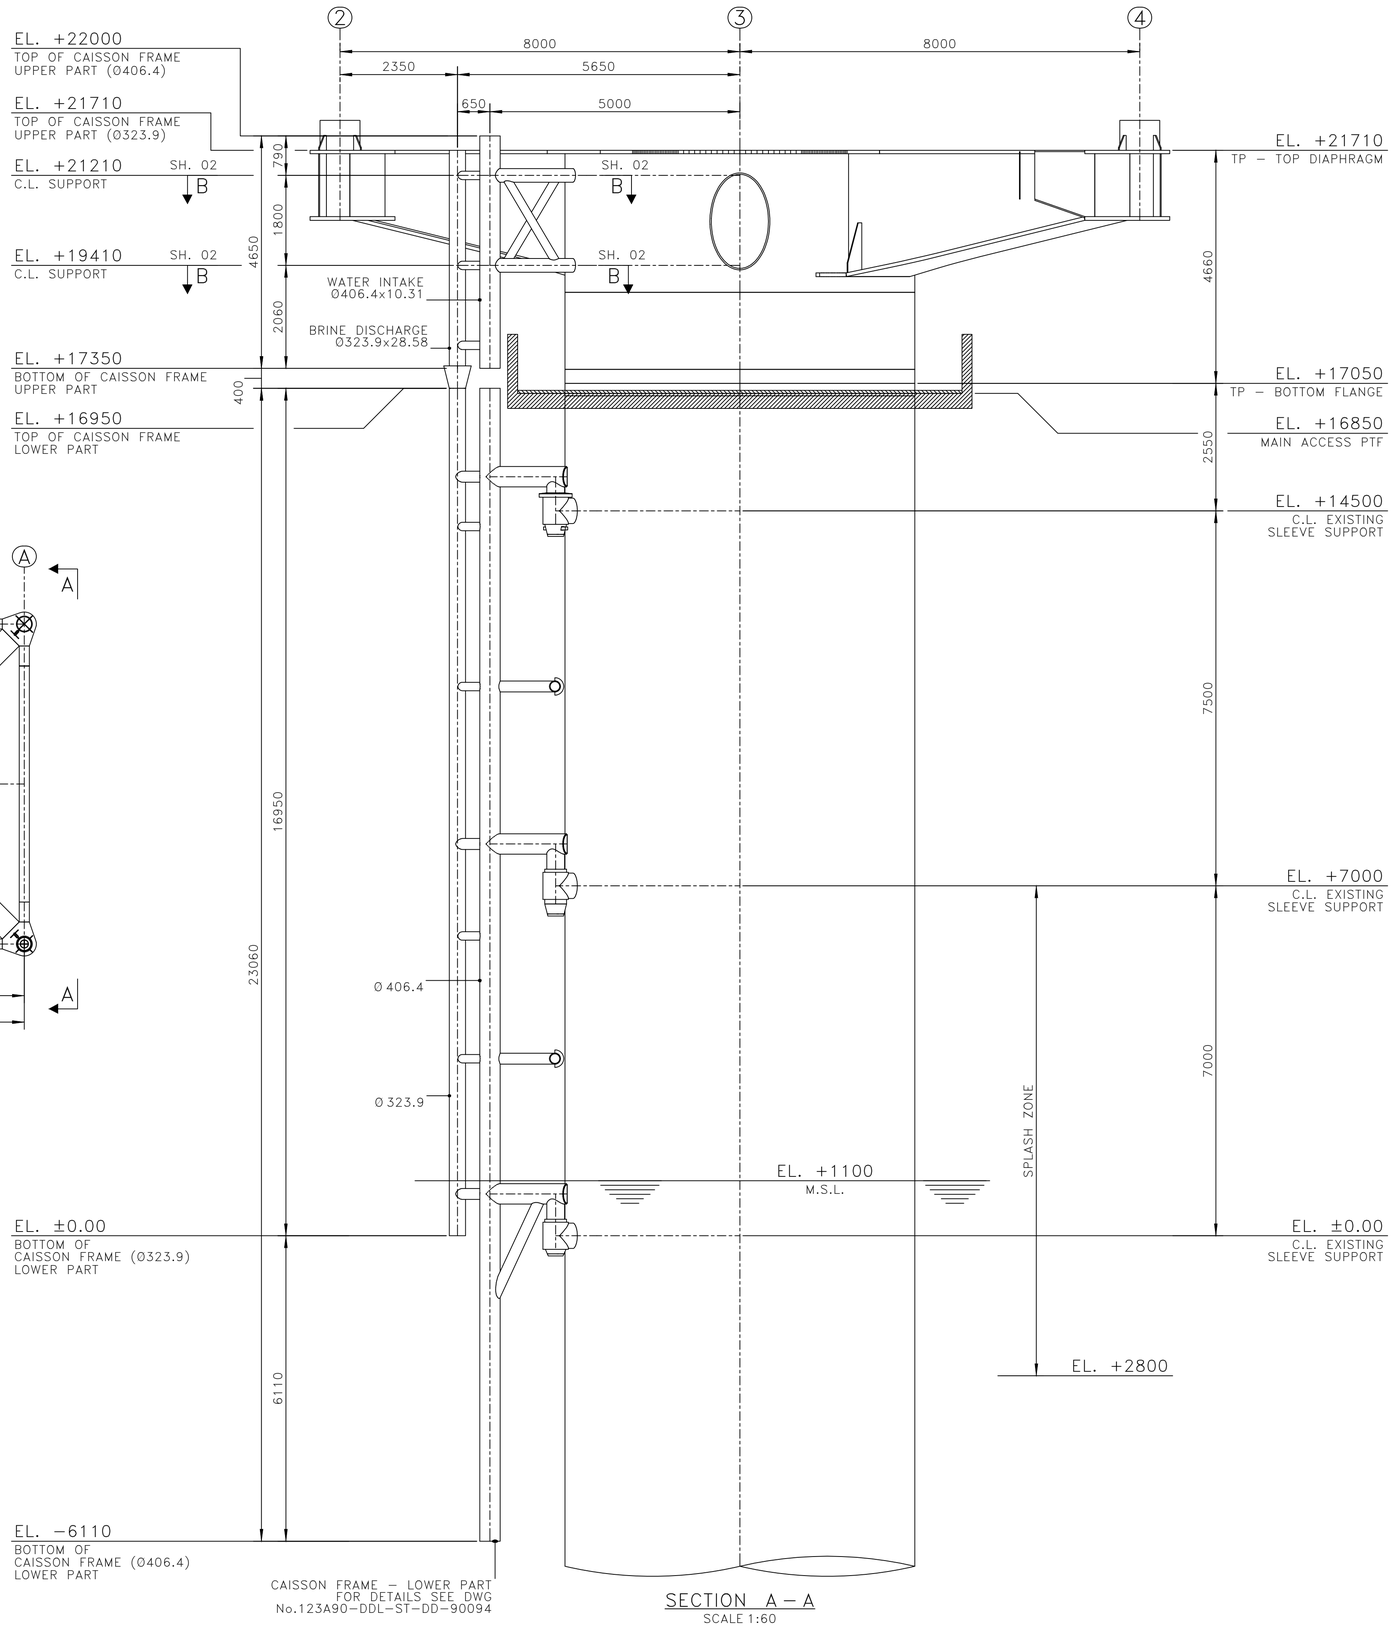


SECTION A – A
SCALE 1:60

## NOTES

1 – ALL DIMENSIONS AND ELEVATIONS ARE IN MILLIMETERS U.N.O.
2 – ALL ELEVATIONS ARE REFERED TO C.D.

## MATERIALS

| ITEM IDENTIFICATION | MATERIAL DESIGNATION |
|---|---|
| Ø168.3x7.11 | DC3–II–X52–0 |
| Ø273.1x9.27 | DC3–II–X52–0 |
| Ø406.4x10.31 | DC3–II–X52–0 |
| Ø323.9x28.58 | DC3–II–X52–40 |

## HOLDS

## REFERENCE DRAWINGS

| DWG No. | DESCRIPTION |
|---|---|
| 123A90-DDL-ST-DD-90025 | DRAWING LIST |
| 123A90-DDL-ST-DD-90026 | GENERAL NOTES |
| 123A90-DDL-ST-DD-90126 | TP – CAISSON FRAME – ASS. AND SEC. – SH.1 |

TECON

| REV. | DATE | DRN | CHKD | APPD | DESCRIPTION |
|---|---|---|---|---|---|
| 02 | 22/09/25 | SPS | AB | CGI | AS-BUILT (ASB) |
| 01 | 12/12/24 | SGR | AB | DLS | ACCEPTED FOR CONSTRUCTION (AFC) |
| 00 | 28/11/24 | SGR | AB | DLS | ISSUE FOR REVIEW (IFR) |

CROSSWIND

ROSETTI MARINO

TITLE :
BASE LOAD POWER HUB (BLPH)
TP – CAISSON FRAME
ASSEMBLY AND SECTIONS


CONTRACT NO./TITLE CW-I-WP4-2023-05/HOLLANDSE KUST NOORD WIND PARK | SCALE 1:60

DRAWN SPS | CHECKED A.BALZAROTTI | APPROVED CGI | DATE 22/09/25

A1 | DRAWING NO. 123A90-DDL-ST-DD-90126 | SHEET / SHEETS 001/002 | REV. 02

File Name : 123A90-DDL-ST-DD-90126_02.dwg


DRAWING NO. 123A90-DDL-ST-DD-90126 REV. 02

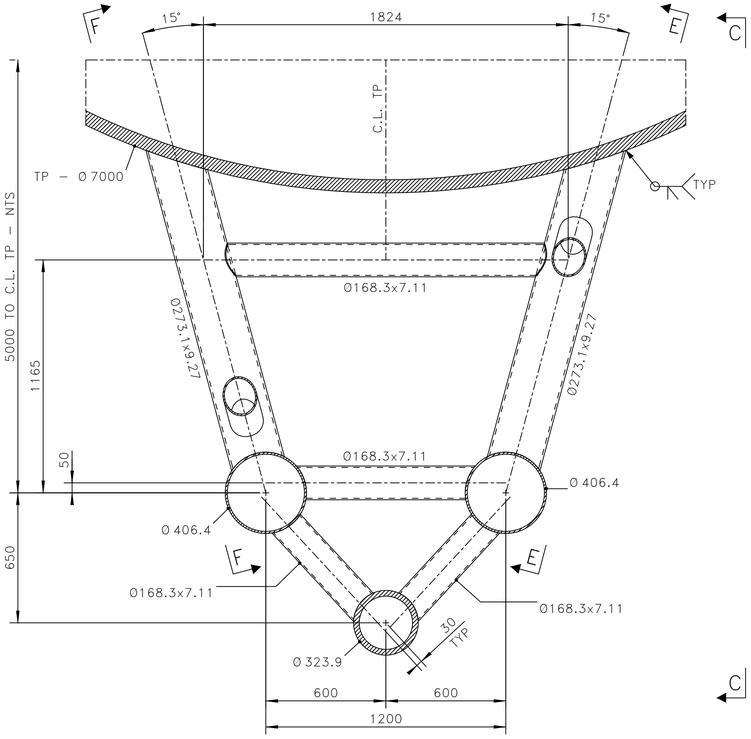


SECTION B – B


123A90-DDL-ST-DD-90126 – SH.01

SCALE 1:15

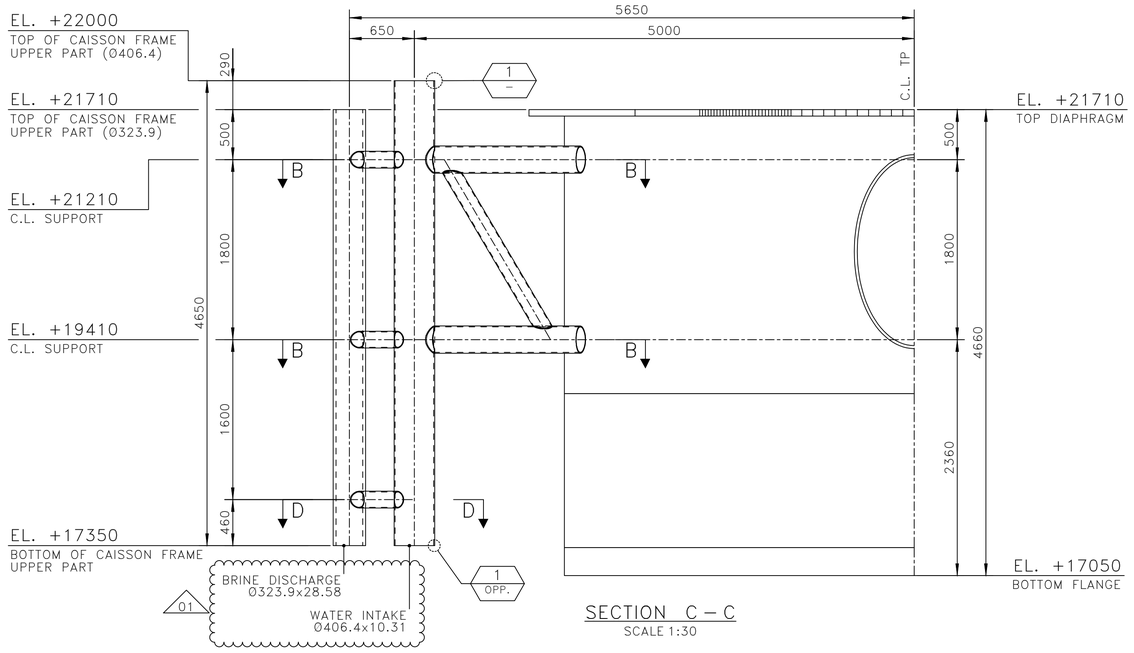



SECTION C – C

SCALE 1:30

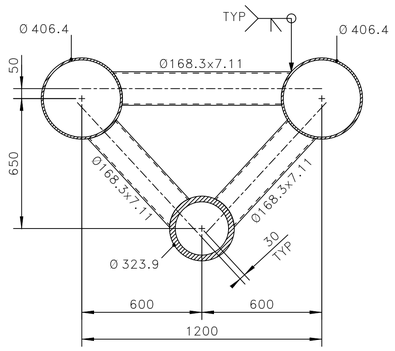



SECTION D – D

SCALE 1:15

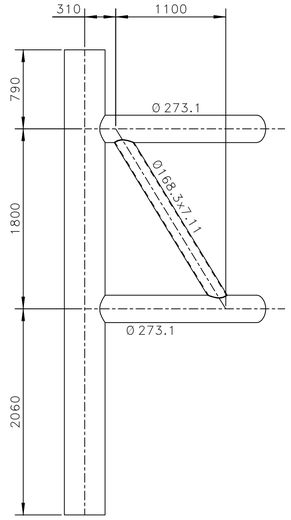



SECTION E – E

SCALE 1:30

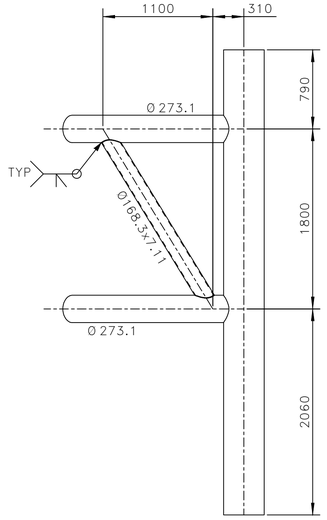


SECTION F – F

SCALE 1:30

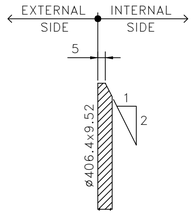


DETAIL –1–

SCALE 1:2

## NOTES

1 – ALL DIMENSIONS AND ELEVATIONS ARE IN MILLIMETERS U.N.O.
2 – ALL ELEVATIONS ARE REFERED TO C.D.
3 – ALL WELDS ARE FULL PENETRATION WELDS U.N.O.
4 – ALL FILLET WELDS SHALL BE CONTINUOUS AND THE LEG SIZE SHALL BE EQUAL 0.7 THE MINIMUM THICKNESS TO BE JOINTED U.N.O.

## MATERIALS

| ITEM IDENTIFICATION | MATERIAL DESIGNATION |
|---|---|
| Ø168.3x7.11 | DC3–II–X52–0 |
| Ø273.1x9.27 | DC3–II–X52–0 |
| Ø406.4x10.31 | DC3–II–X52–0 |
| Ø323.9x28.58 | DC3–II–X52–40 |

## HOLDS

## REFERENCE DRAWINGS

| DWG No. | DESCRIPTION |
|---|---|
| 123A90-DDL-ST-DD-90025 | DRAWING LIST |
| 123A90-DDL-ST-DD-90026 | GENERAL NOTES |
| 123A90-DDL-ST-DD-90027 | WELDING GENERAL NOTES |
| 123A90-DDL-ST-DD-90029 | TUBULAR JOINTS – STANDARD WELDING DETAILS |
| 123A90-DDL-ST-DD-90126 | TP – CAISSON FRAME – ASS. AND SEC. – SH.2 |

TECON

| REV. | DATE | DRN | CHKD | APPD | DESCRIPTION |
|---|---|---|---|---|---|
| 02 | 22/09/25 | SPS | AB | CGI | AS-BUILT (ASB) |
| 01 | 12/12/24 | SGR | AB | DLS | ACCEPTED FOR CONSTRUCTION (AFC) |
| 00 | 28/11/24 | SGR | AB | DLS | ISSUE FOR REVIEW (IFR) |

CROSSWIND

ROSETTI MARINO

TITLE :

BASE LOAD POWER HUB (BLPH)
TP – CAISSON FRAME
ASSEMBLY AND SECTIONS

CONTRACT NO./TITLE CW-I-WP4-2023-05/HOLLANDSE KUST NOORD WIND PARK | SCALE 1:60

DRAWN SPS | CHECKED A.BALZAROTTI | APPROVED CGI | DATE 22/09/25

A1 | DRAWING NO. 123A90-DDL-ST-DD-90126 | SHEET / SHEETS 002/002 | REV. 02

File Name : 123A90-DDL-ST-DD-90126_002.dwg