
DRAWING NO. 123A90-DDL-TI-DD-99021

REV. 02

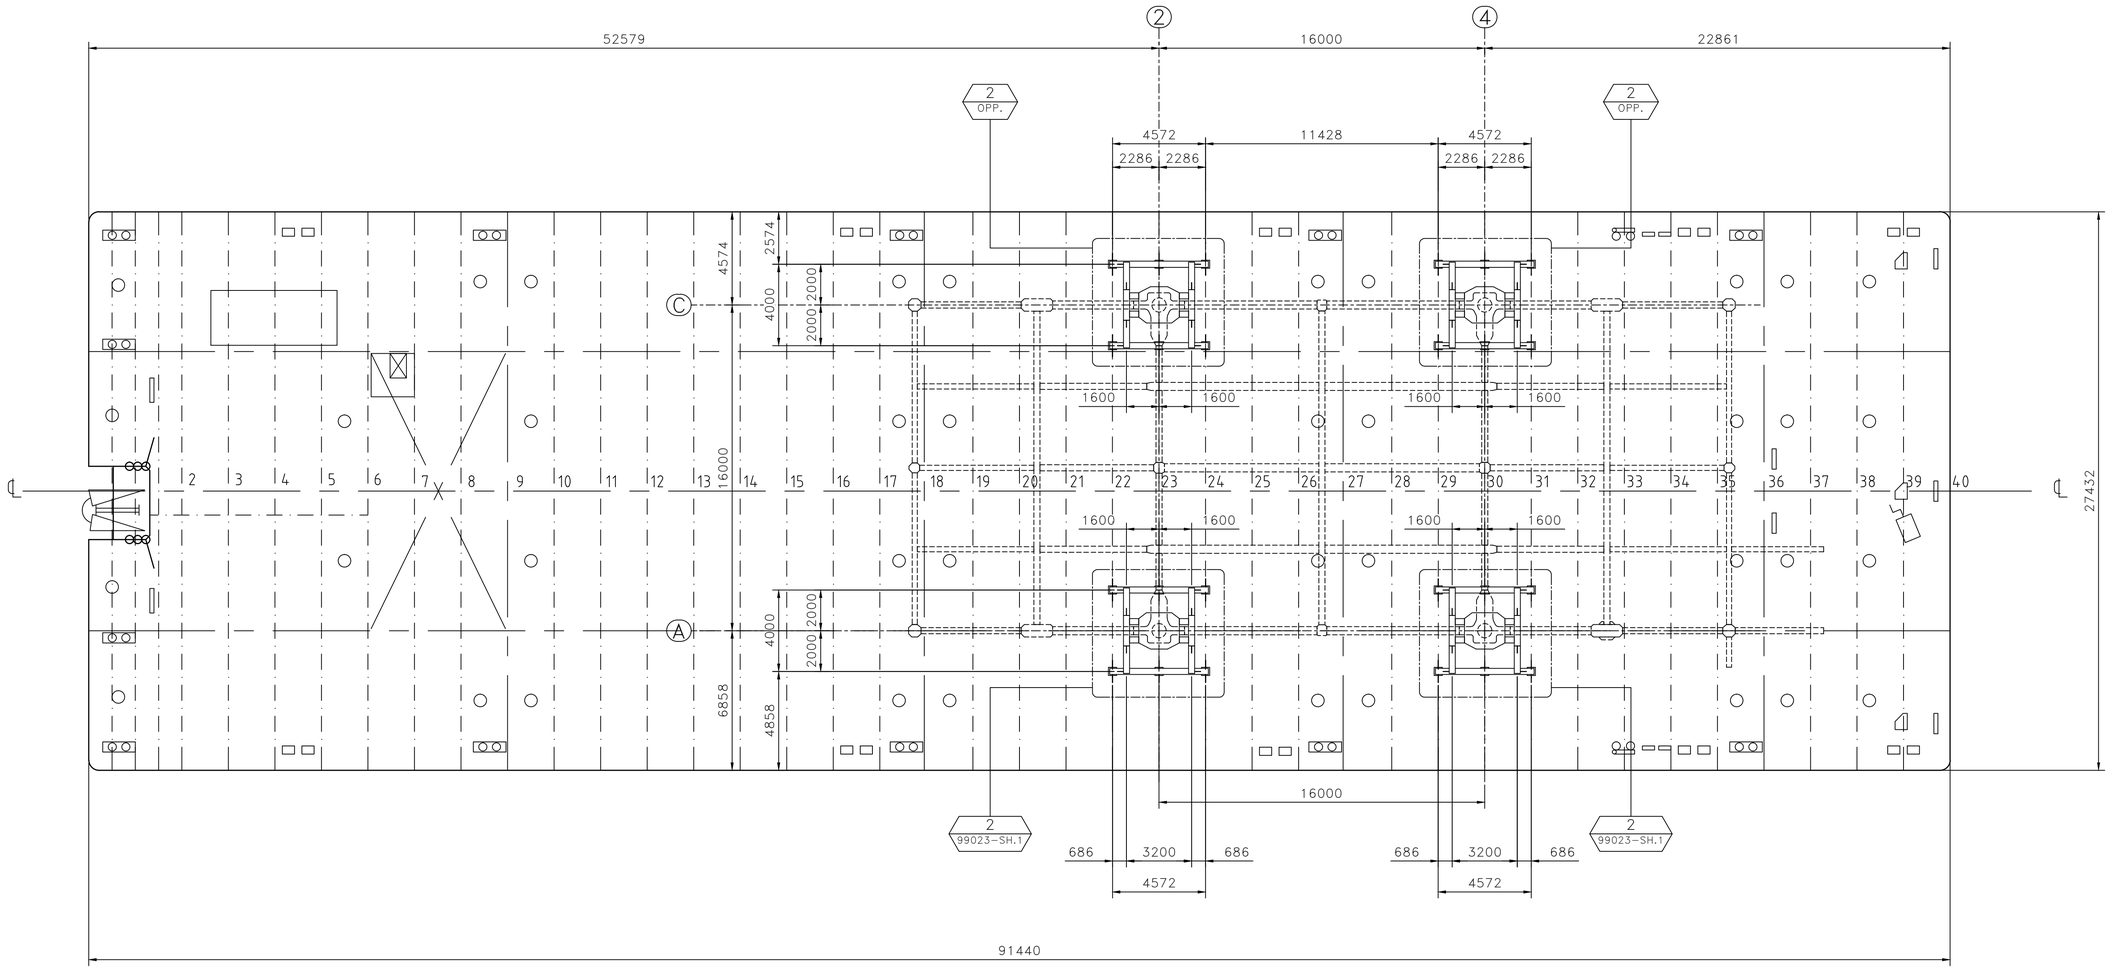


TOP SIDE – GRILLAGE – ASSEMBLY

SCALE 1:150

## NOTES

1 – ALL DIMENSIONS AND ELEVATIONS ARE IN MILLIMETERS U.N.O.
2 – ALL ELEVATIONS ARE REFERED TO C.D.

## HOLDS

## REFERENCE DRAWINGS

| DWG No. | DESCRIPTION |
|---|---|
| 123A90-DDL-ST-DD-90025 | DRAWING LIST |
| 123A90-DDL-ST-DD-90026 | GENERAL NOTES |
| 123A90-DDL-TI-DD-99022 | TOP SIDE – GRILLAGE ROW C – PLAN AND SECTION |
| 123A90-DDL-TI-DD-99023 | TOP SIDE – GRILLAGE ROW A – PLAN AND SECTION |

TECON

| REV. | DATE | DRN | CHKD | APPD | DESCRIPTION |
|---|---|---|---|---|---|
| 02 | 18/09/25 | SPS | AB | CGI | AS-BUILT (ASB) |
| 01 | 14/02/25 | SGR | AB | DLS | ACCEPTED FOR CONSTRUCTION (AFC) |
| 00 | 20/01/25 | SGR | AB | DLS | ISSUE FOR REVIEW (IFR) |

CROSSWIND

ROSETTI MARINO

TITLE :
BASE LOAD POWER HUB (BLPH)
TOP SIDE – GRILLAGE
ASSEMBLY

CONTRACT NO./TITLE CW-I-WP4-2023-05/HOLLANDSE KUST NOORD WIND PARK | SCALE 1:150

DRAWN SPS | CHECKED A.BALZAROTTI | APPROVED CGI | DATE 18/09/25

A1 | DRAWING NO. 123A90-DDL-TI-DD-99021 | SHEET 001 | REV. 02

File Name : 123A90-DDL-TI-DD-99021 REV.02.dwg