
DRAWING NO. 123A90-DDL-TI-DD-99024

REV. 02

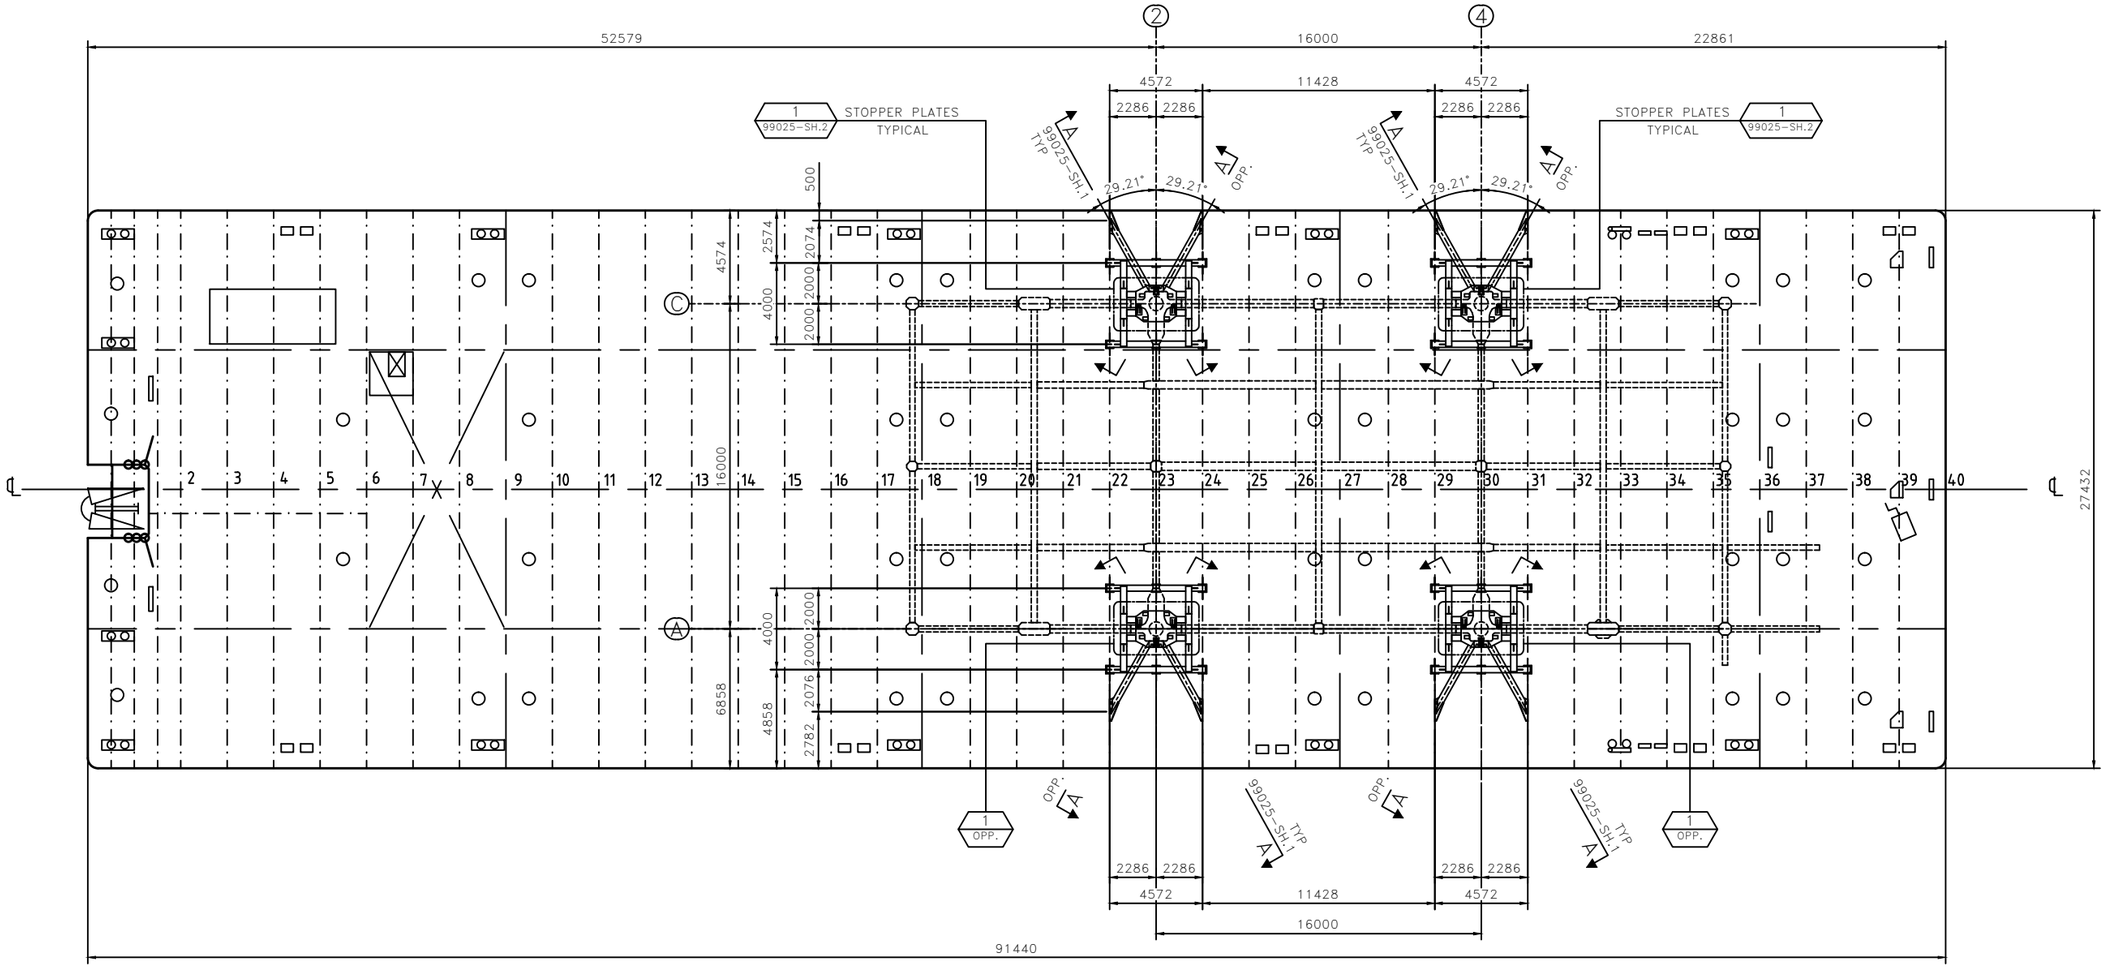

TOP SIDE – SEA FASTENING – ASSEMBLY

SCALE 1:150

NOTES

1 – ALL DIMENSIONS AND ELEVATIONS ARE IN MILLIMETERS U.N.O.
2 – ALL ELEVATIONS ARE REFERED TO C.D.

HOLDS

REFERENCE DRAWINGS

DWG No.	DESCRIPTION
123A90-DDL-ST-DD-90025	DRAWING LIST
123A90-DDL-ST-DD-90026	GENERAL NOTES
123A90-DDL-TI-DD-99022	TOP SIDE – GRILLAGE ROW C – PLAN AND SECTION
123A90-DDL-TI-DD-99023	TOP SIDE – GRILLAGE ROW A – PLAN AND SECTION

TECON

REV.	DATE	DRN	CHKD	APPD	DESCRIPTION
02	18/09/25	SPS	AB	CGI	AS-BUILT (ASB)
01	03/06/25	SGR	AB	DLS	ACCEPTED FOR CONSTRUCTION (AFC)
00	20/02/25	SGR	AB	DLS	ISSUE FOR REVIEW (IFR)

CROSSWIND

ROSETTI MARINO

TITLE : BASE LOAD POWER HUB (BLPH)
TOP SIDE – SEA FASTENING
ASSEMBLY

CONTRACT NO./TITLE CW-I-WP4-2023-05/HOLLANDSE KUST NOORD WIND PARK | SCALE 1:150

DRAWN SPS | CHECKED A.BALZAROTTI | APPROVED CGI | DATE 18/09/25

A1 | DRAWING NO. 123A90-DDL-TI-DD-99024 | SHEET 001 | REV. 02

File Name : 123A90-DDL-TI-DD-99024 REV.02.dwg