

DRAWING NO. 123A90-DDL-TI-DD-99036


REV. 02

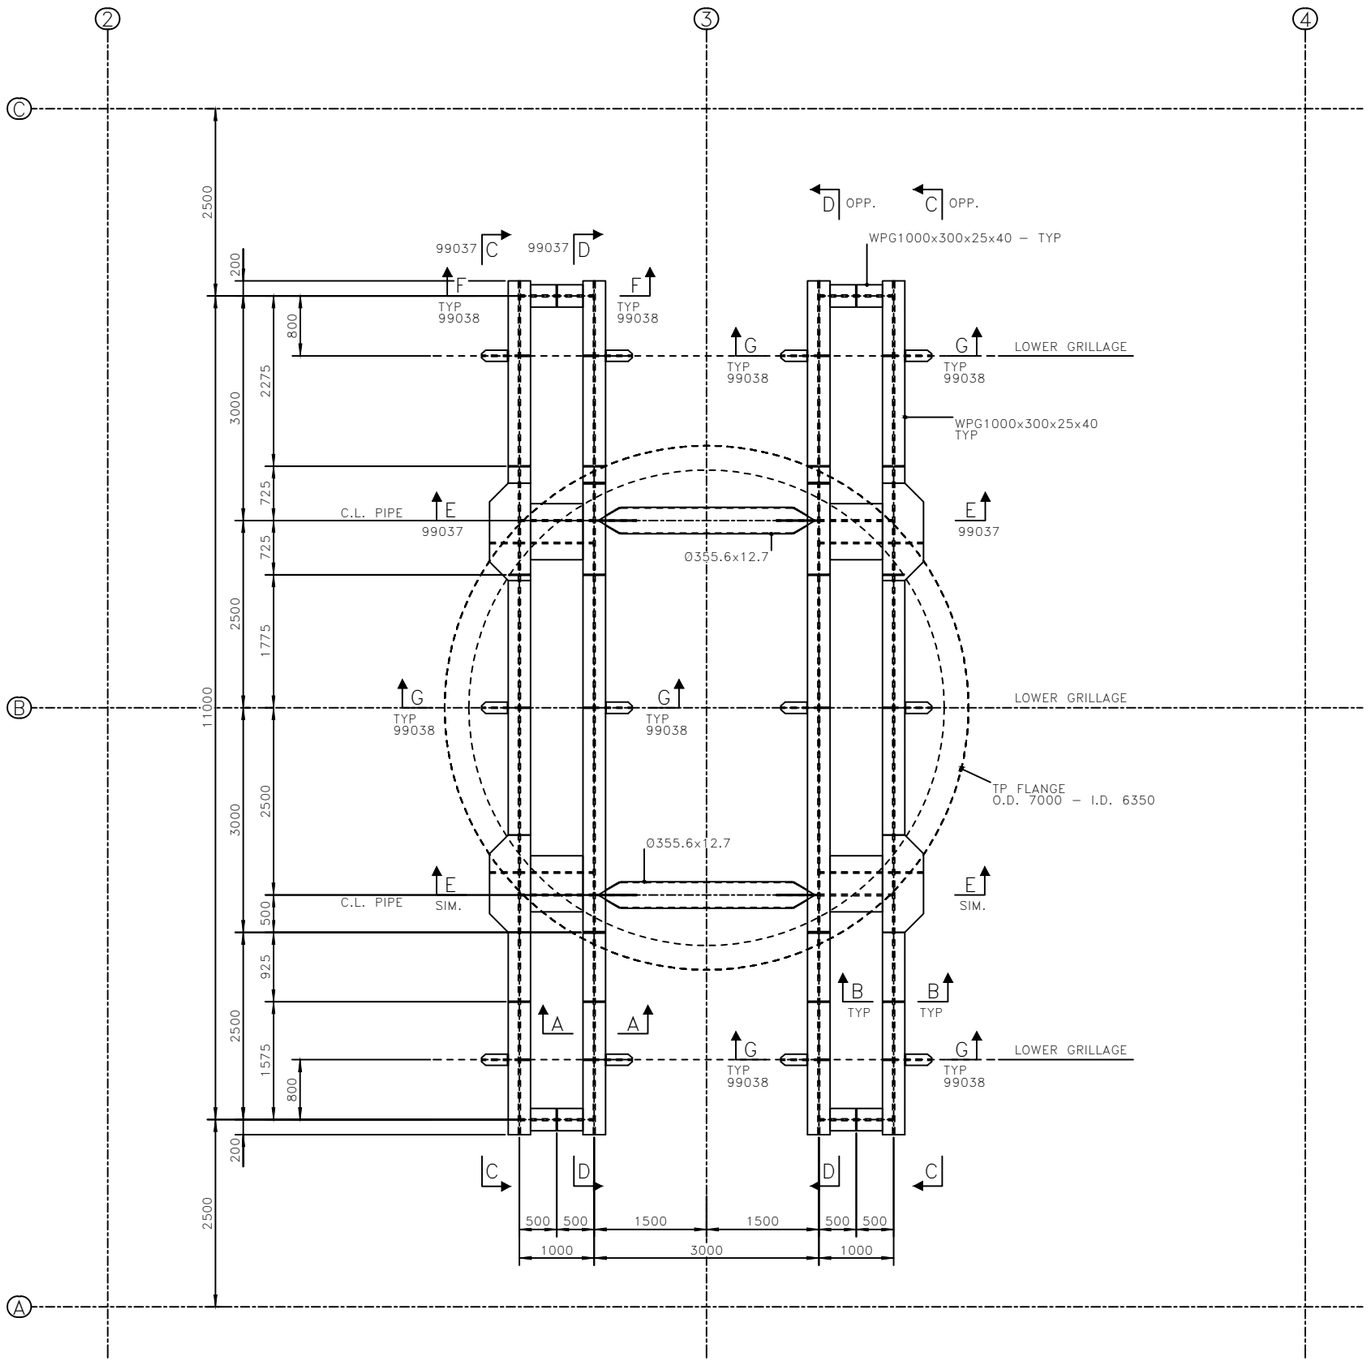


TP – UPPER GRILLAGE – PLAN VIEW
SCALE 1:40

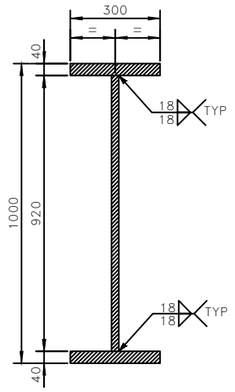


SECTION A – A
SCALE 1:10

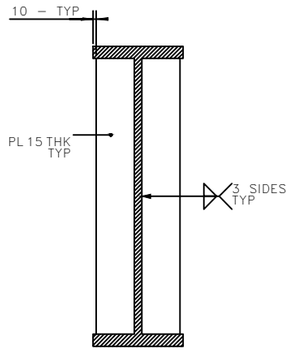


SECTION B – B
SCALE 1:10

## NOTES

1 – ALL DIMENSIONS AND ELEVATIONS ARE IN MILLIMETERS U.N.O.
2 – ALL ELEVATIONS ARE REFERED TO C.D.
3 – ALL WELDS ARE FULL PENETRATION WELDS U.N.O.
4 – ALL FILLET WELDS SHALL BE CONTINUOUS AND THE LEG SIZE SHALL BE EQUAL 0.7 THE MINIMUM THICKNESS TO BE JOINTED U.N.O.
5 – ALL STIFFENER MATERIALS ARE DC3-II-355-20 U.N.O.

## MATERIALS

| ITEM IDENTIFICATION | MATERIAL DESIGNATION |
|---|---|
| WPG1000x300x25x40 | DC3-II-355-40 |
| Ø355.6x12.7 | DC3-II-X52-20 |

## HOLDS

## REFERENCE DRAWINGS

| DWG No. | DESCRIPTION |
|---|---|
| 123A90-DDL-ST-DD-90025 | DRAWING LIST |
| 123A90-DDL-ST-DD-90026 | GENERAL NOTES |
| 123A90-DDL-ST-DD-90027 | WELDING GENERAL NOTES |
| 123A90-DDL-ST-DD-90032 | PLATES – DOUBLE SIDED WELDS |
| 123A90-DDL-ST-DD-90033 | PLATES – SINGLE SIDED WELDS |
| 123A90-DDL-ST-DD-90078 | TP – PRIMARY STEEL – ELEVATION ROW –A– |
| 123A90-DDL-ST-DD-90083 | TP – PRIMARY STEEL – FLANGE CONNECTION |
| 123A90-DDL-TI-DD-99037 | TP – UPPER GRILLAGE – SECTIONS |
| 123A90-DDL-TI-DD-99038 | TP – UPPER GRILLAGE – SECTION AND DETAILS |

| REV. | DATE | DRN | CHKD | APPD | DESCRIPTION |
|---|---|---|---|---|---|
| 02 | 18/09/25 | SPS | AB | CGI | AS-BUILT (ASB) |
| 01 | 10/01/25 | SGR | AB | DLS | ACCEPTED FOR CONSTRUCTION (AFC) |
| 00 | 30/04/24 | SGR | AB | DLS | ISSUE FOR REVIEW (IFR) |

CROSSWIND

ROSETTI MARINO

TITLE :
BASE LOAD POWER HUB (BLPH)
TP – UPPER GRILLAGE
PLAN VIEW

CONTRACT NO./TITLE CW-I-WP4-2023-05/HOLLANDSE KUST NOORD WIND PARK | SCALE 1:40

DRAWN SPS | CHECKED A.BALZAROTTI | APPROVED CGI | DATE 18/09/25

A1 | DRAWING NO. 123A90-DDL-TI-DD-99036 | SHEET 001 | REV. 02

File Name : 123A90-DDL-TI-DD-99036_02.dwg