


DRAWING NO. 123A90-DDL-AR-DD-10032

REV. 02

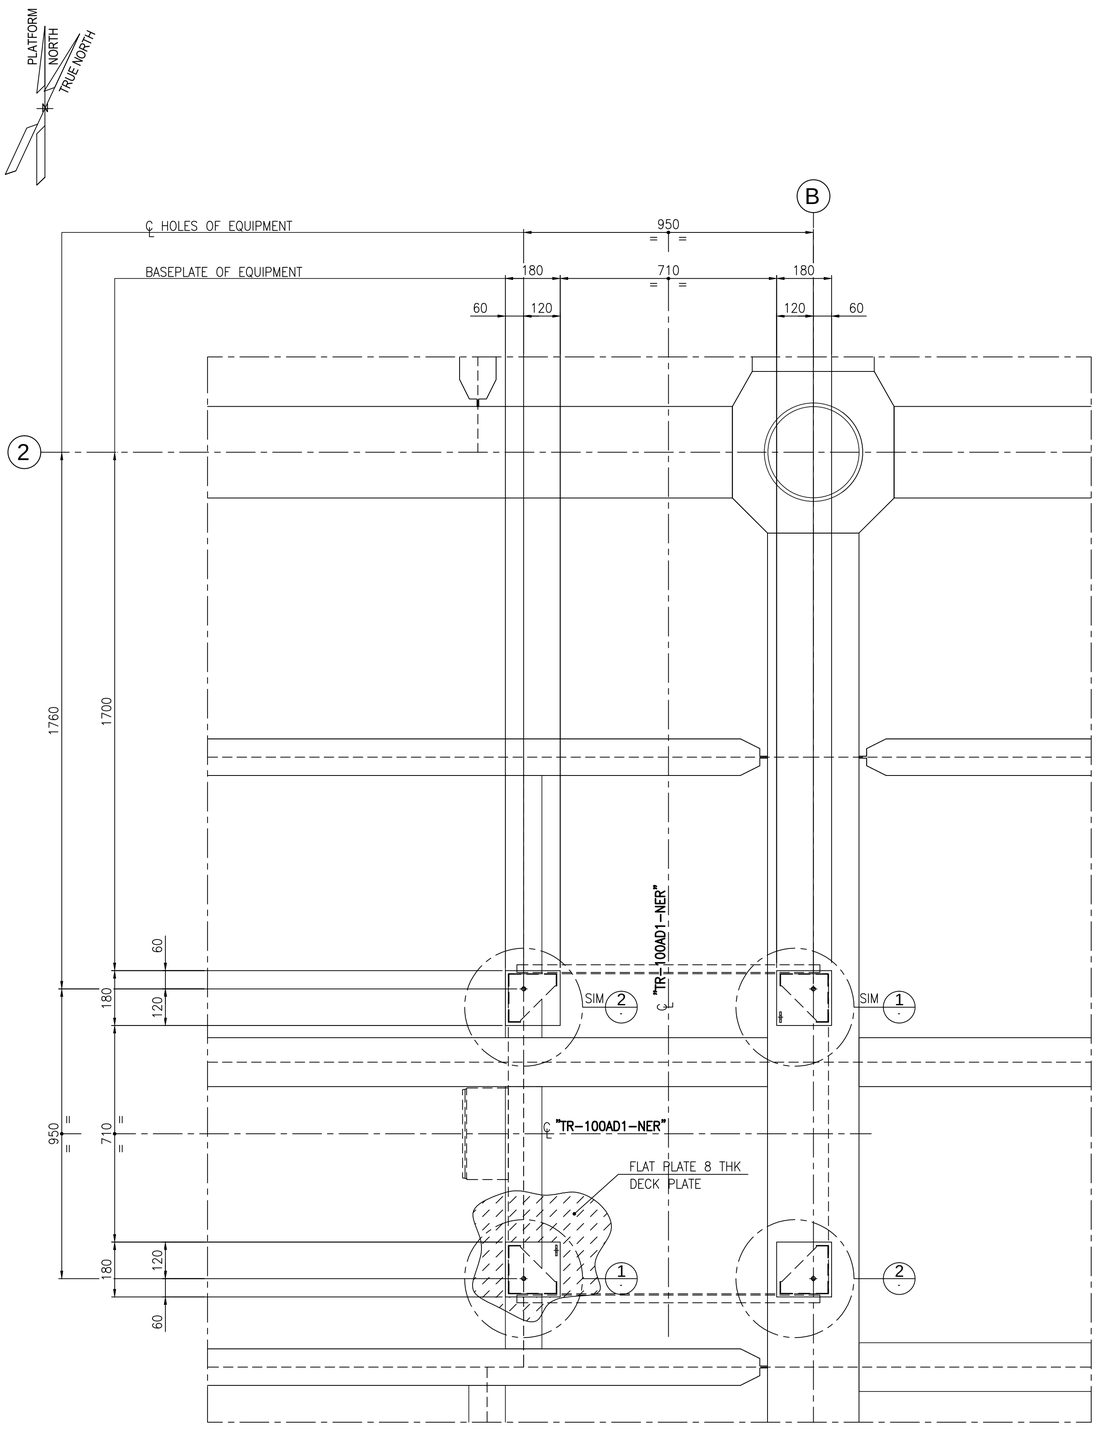



SUPPORT OF "TR-100AD1-NER"
EXTRACT OF PLAN AT EL.+ 23.310 T.O.S.
LOWER DECK

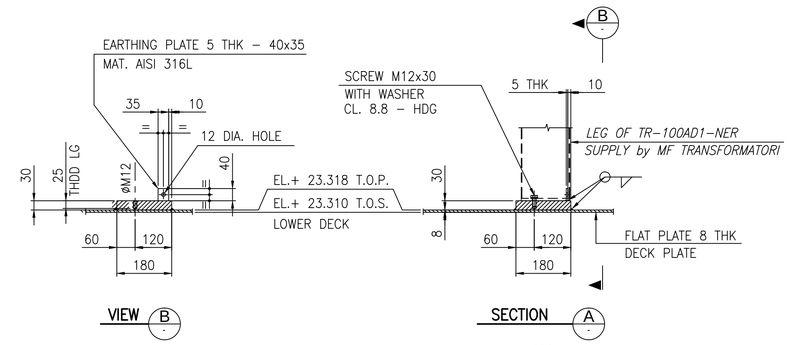

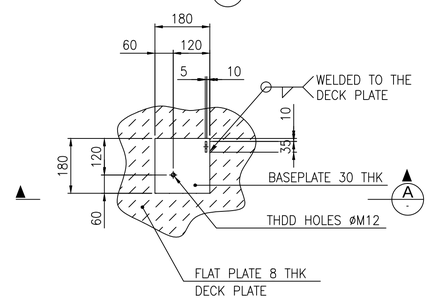


DETAIL 1
N°. 2 OFF
WITH EARTHING PLATE
FOR LOCATION/ORIENTATION SEE PLAN

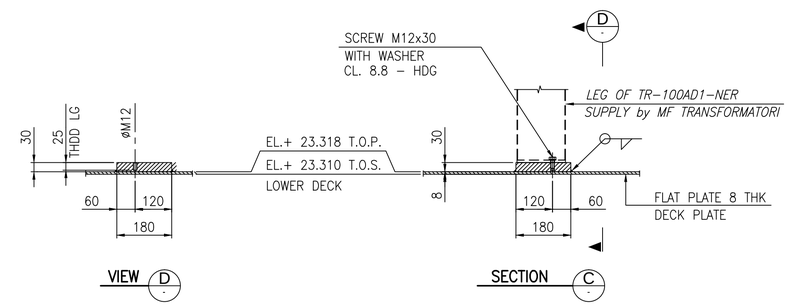

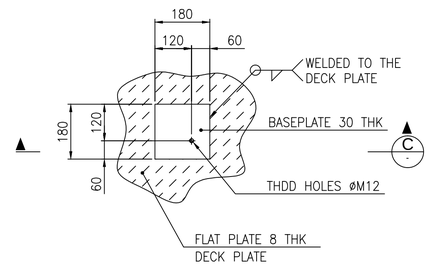


DETAIL 2
N°. 2 OFF
WITHOUT EARTHING PLATE
FOR LOCATION/ORIENTATION SEE PLAN

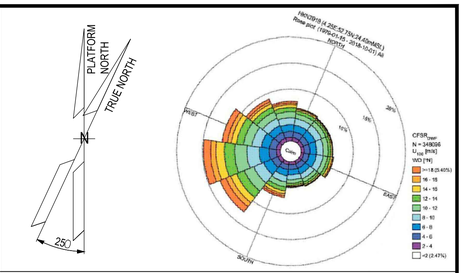

NOTES

1. U.N.O. ALL DIMENSIONS ARE IN MILLIMETERS.
2. ALL WELDS SHALL BE ACCORDING TO A.W.S. CODE.
3. ALL WELDS MUST BE CONTINUOUS, SPOT WELDS ARE NOT PERMITTED.
4. U.N.O. ALL FILLET WELDS SHALL HAVE FOLLOWING DIMENSION:

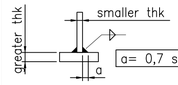

LEGEND

U.N.O.	UNLESS NOTED OTHERWISE
T.O.S.	TOP OF STEEL
T.O.P.	TOP OF PLATE
℄	CENTER LINE
SIM.	SIMILAR
H.D.G.	HOT DIP GALVANIZED
▨	FLAT PLATE 8 THK

MATERIALS


PLATES	EN 10025 – S275 J0
EARTHING PLATE	AISI 316L
BOLTING	CL. 8.8 – H.D.G.

HOLDS

REFERENCE

DOCUMENT TITLE	DOCUMENT NUMBER
TR-100AD1-NER – General Arrangement drawings	1723001697-EL-DA-00009
Topsise – Secondary Steel – Plan el.+ 23310 tos	123A90-DDL-DD-90057
Topsise – Secondary Steel – Plan el.+ 23310 tos sh.2	123A90-DDL-DD-90104
Topsise – Flooring Plan el.+ 23310 tos	123A90-DDL-DD-90059

KEY PLAN

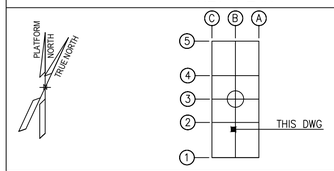

REV.	DATE	DRN	CHKD	APPD	DESCRIPTION
02	18/09/25	SPS	M. GA	CGI	AS-BUILT (ASB)
01	07/05/24	R. BO	M. GA	D. LO	ACCEPTED FOR CONSTRUCTION (AFC)
00	21/03/24	R. BO	M. GA	D. LO	ISSUE FOR REVIEW (IFR)

CROSSWIND

ROSETTI MARINO

TITLE :
BASE LOAD POWER HUB (BLPH)
LOWER DECK EL.+ 23.310 TOS
SUPPORT OF "TR-100AD1-NER"

CONTRACT NO./TITLE CW-I-WP4-2023-05/HOLLANDSE KUST NOORD WIND PARK			SCALE 1:10
DRAWN SPS	CHECKED M. GA	APPROVED CGI	DATE 15/09/25
A1	DRAWING NO. 123A90-DDL-AR-DD-10032		SHEET 001 / REV. 02

File Name : 123A90-DDL-AR-DD-10032