
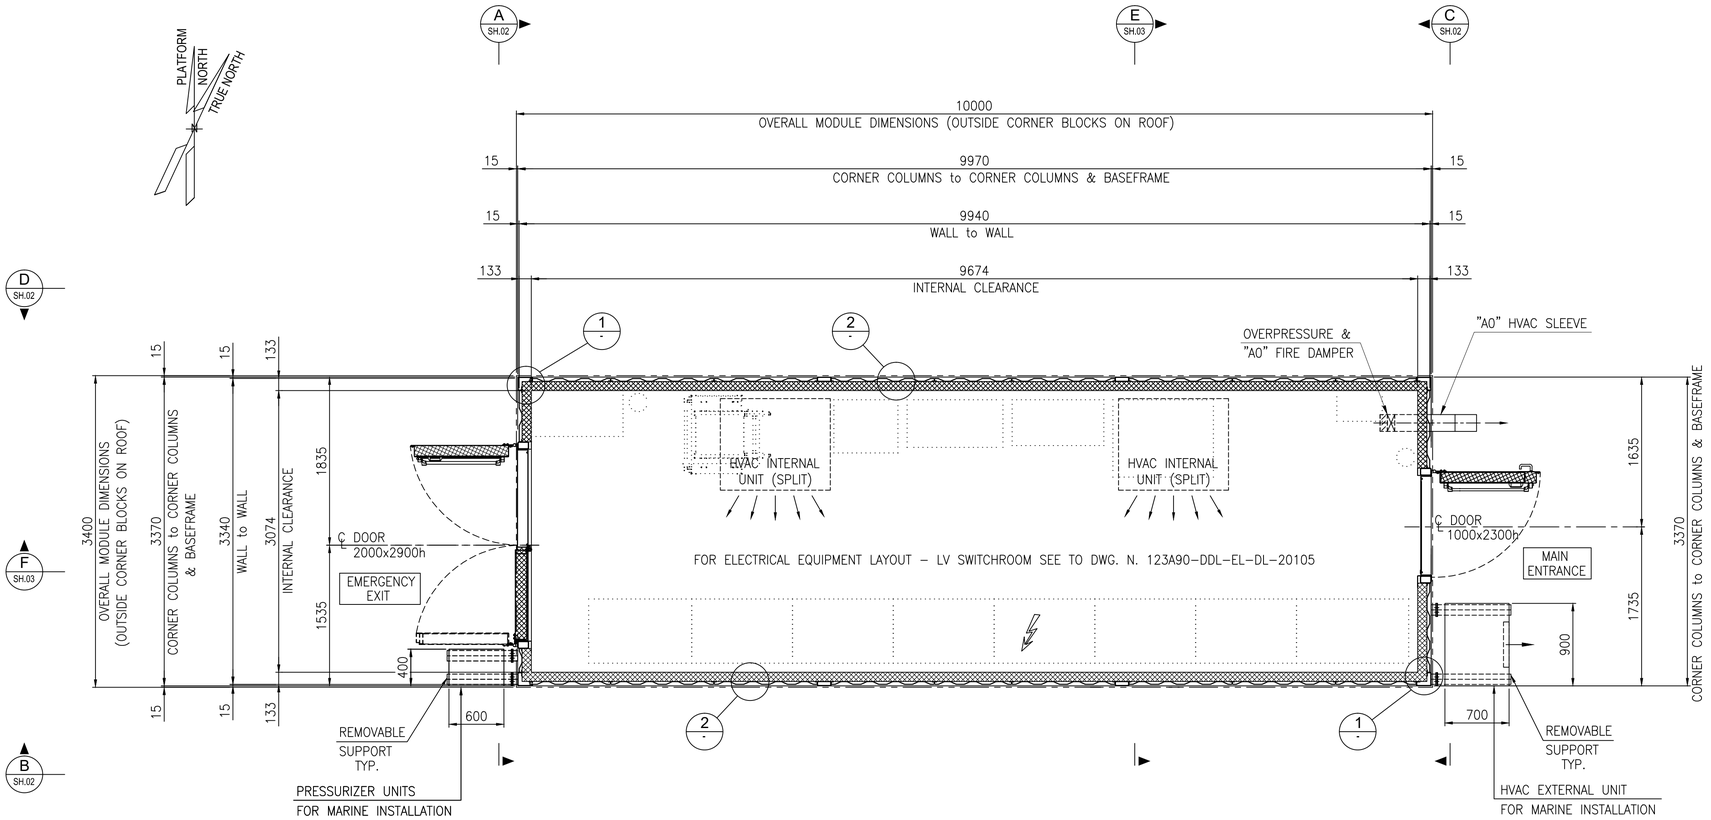


PLAN OF LV (400V) SWITCHGEAR ROOM B-200


FOR SECTIONS & VIEWS SEE DWG N. 123A90-DDL-AR-DL-10008 Sh. 02 & 03

INCLUDED IN SUPPLY COMPLETE HVAC SYSTEM, NORMAL AND EMERGENCY LIGHTING SYSTEM INCLUDING CONTROL PANELS


FOR HVAC SYSTEM, LIGHTING SYSTEM, EARTH SYSTEM REF.TO DOC. N.1724000049-AR-DD-00019 (by VENDOR)

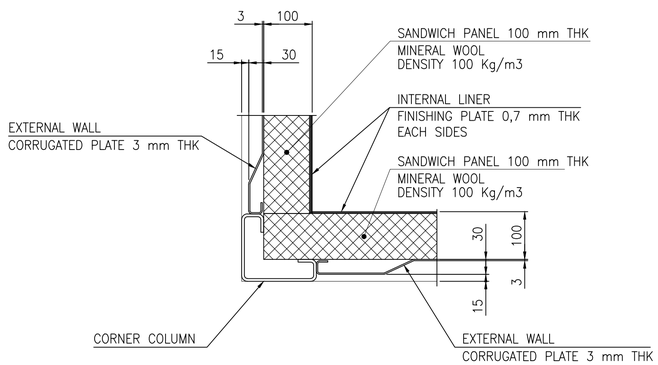

DETAIL 1 - AT CORNERS TYPICAL

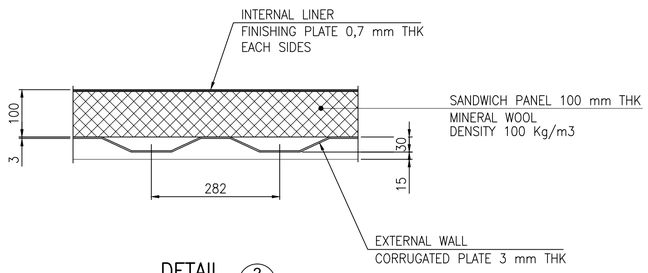

DETAIL 2 - WALL TYPICAL

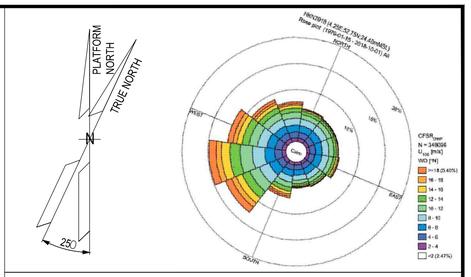

NOTES

1. U.N.O. ALL DIMENSIONS ARE IN MILLIMETERS.
2. ALL WELDS MUST BE CONTINUOUS, SPOT WELDS ARE NOT PERMITTED

LEGEND

U.N.O. _____ UNLESS NOTED OTHERWISE
T.O.S. _____ TOP OF STEEL
T.O.P. _____ TOP OF PLATE
T.B.D. _____ TO BE DEFINED
T.B.C. _____ TO BE COMFIRMED

_____ CORRUGATED PLATE 3 mm THK

_____ THERMAL INSULATION


_____ EQUIPMENT INSIDE MODULE

HOLDS

REFERENCE

DOCUMENT TITLE	DOCUMENT NUMBER
LV (400V) Switchroom – Supply Specification	123A90-DDL-AR-SP-10007
LV (400V) Switchroom – Material Requisition	123A90-DDL-AR-MR-10012
LV (400V) Switchroom – Doors Map and Schedule	123A90-DDL-AR-DL-10009
LV (400V) Switchroom – Flooring and Lining Layout	123A90-DDL-AR-DL-10010
LV (400V) Switchroom – Fire rated requirement layout (plan, section, typical detail)	123A90-DDL-AR-DL-10011
Electrical Equipment Layout – LV Switchroom	123A90-DDL-EL-DL-20105
B-200 General Arramgement Drawings (by Vendor)	1724000049-AR-DA-00015
B-200 Detail Drawings (by Vendor)	1724000049-AR-DD-00019
B-200 Structural Calculation (by Vendor)	1724000049-ST-CA-00007
B-200 Foundation Dwg (by Vendor)	1724000049-ST-DD-00011
Lifting Drawings (by Vendor)	1724000049-AR-DD-00062

KEY PLAN

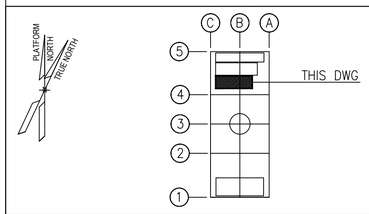

STHLOG

REV.	DATE	DRN	CHKD	APPD	DESCRIPTION
02	18/09/25	SPS	M. GA	CGI	AS-BUILT (ASB)
01	12/03/24	R. BO	M. GA	D. LO	ACCEPTED FOR CONSTRUCTION (AFC)
00	17/10/23	R. BO	M. GA	D. LO	ISSUE FOR REVIEW (IFR)

CROSSWIND


ROSETTI MARINO

TITLE : BASE LOAD POWER HUB (BLPH)
LV (400V) SWITCHGEAR ROOM B-200 – ARCHITECTURAL
GENERAL LAYOUT – PLAN, WIEW, SECT. & TYP. DET.

CONTRACT NO./TITLE	CW-I-WP4-2023-05/HOLLANDSE KUST NOORD WIND PARK		SCALE 1:33
DRAWN SPS	CHECKED M. GATTI	APPROVED CGI	DATE 18/09/25
A1	DRAWING NO. 123A90-DDL-AR-DL-10008	SHEET 001	REV. 02


File Name : 123A90-DDL-AR-DL-10008 REV.02


DRAWING NO. 123A90-DDL-AR-DL-10008 REV. 02

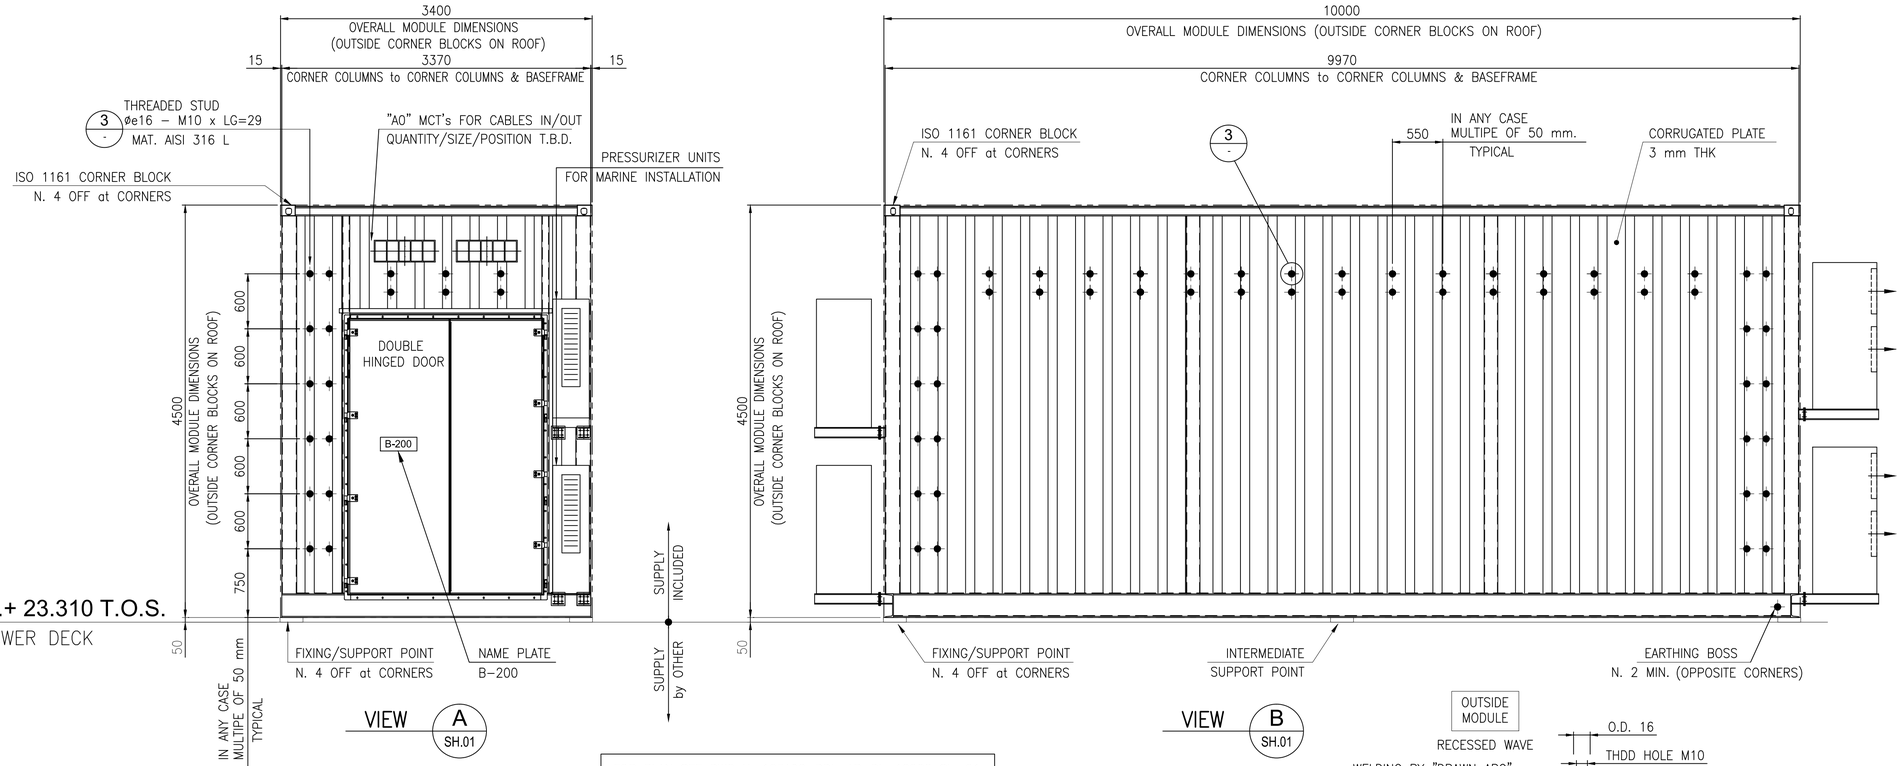


FOR PLAN SEE DWG N. 123A90-DDL-AR-DL-10008 Sh. 01

FOR HVAC SYSTEM, LIGHTING SYSTEM, EARTH SYSTEM, MCT's WALL PENETRATIONS
REF. TO DOC. N.1724000049-AR-DD-00019 (by VENDOR)

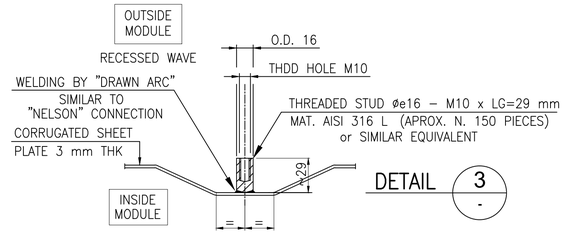

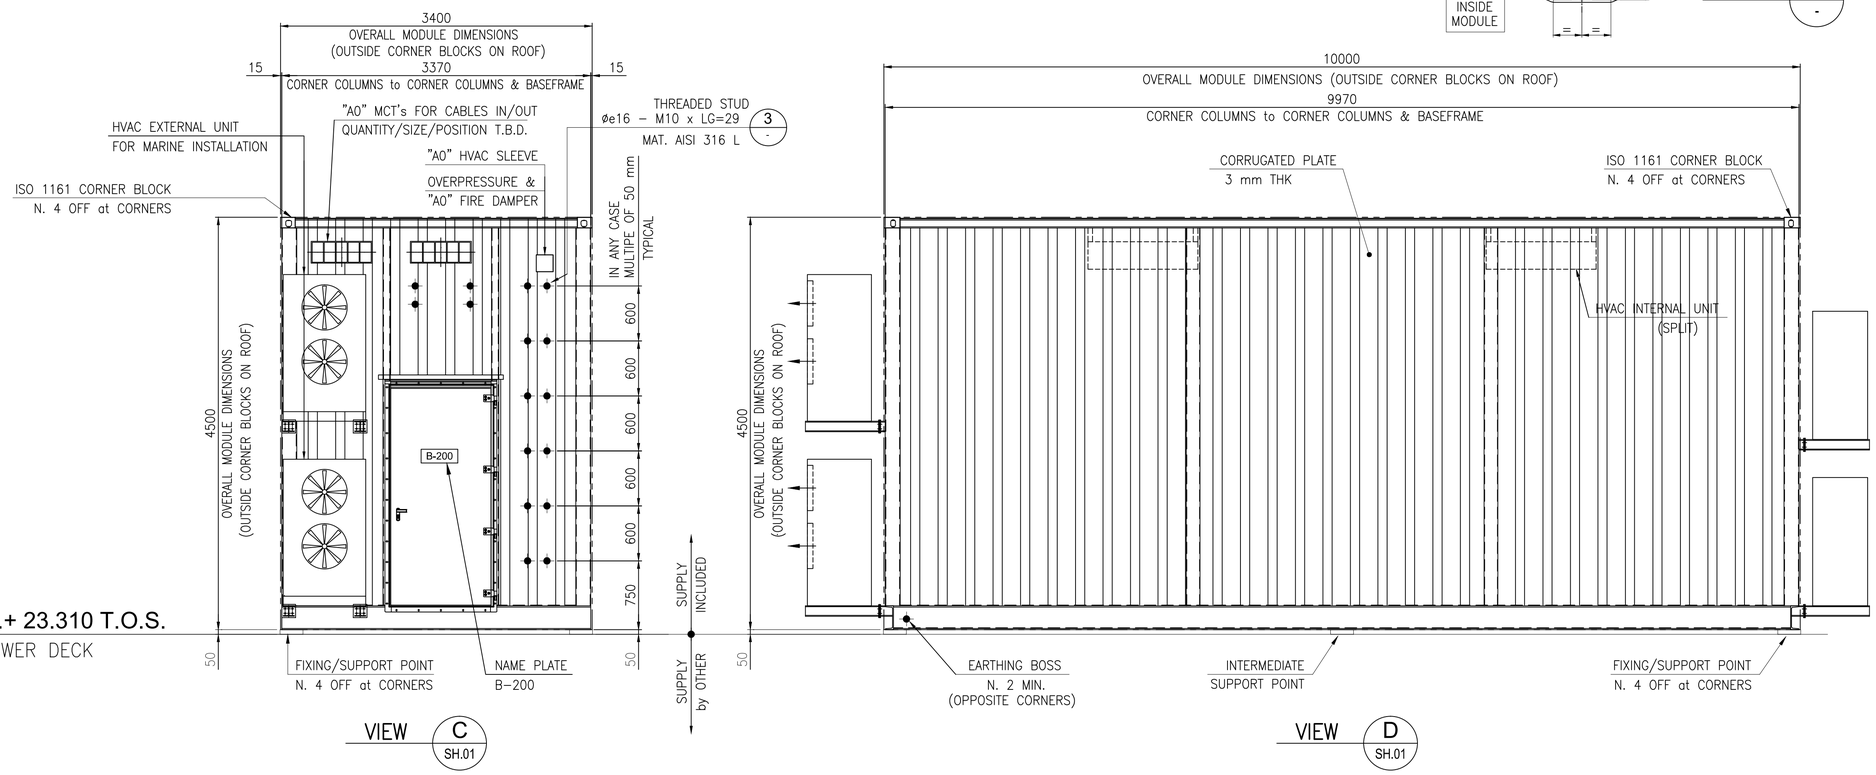

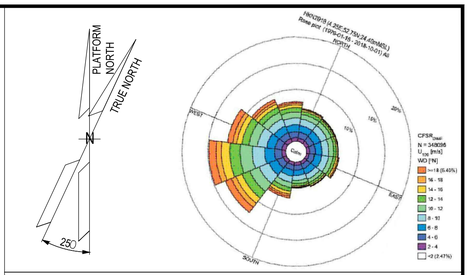

NOTES

1. U.N.O. ALL DIMENSIONS ARE IN MILLIMETERS.
2. ALL WELDS MUST BE CONTINUOUS, SPOT WELDS ARE NOT PERMITTED

LEGEND

U.N.O. _____ UNLESS NOTED OTHERWISE
T.O.S. _____ TOP OF STEEL
T.O.P. _____ TOP OF PLATE
T.B.D. _____ TO BE DEFINED
T.B.C. _____ TO BE COMFIRMED


_____ CORRUGATED PLATE 3 mm THK
_____ THERMAL INSULATION
_____ EQUIPMENT INSIDE MODULE

HOLDS

REFERENCE

DOCUMENT TITLE	DOCUMENT NUMBER
LV (400V) Switchroom – Supply Specification	123A90-DDL-AR-SP-10007
LV (400V) Switchroom – Material Requisition	123A90-DDL-AR-MR-10012
LV (400V) Switchroom – Doors Map and Schedule	123A90-DDL-AR-DL-10009
LV (400V) Switchroom – Flooring and Lining Layout	123A90-DDL-AR-DL-10010
LV (400V) Switchroom – Fire rated requirement layout (plan, section, typical detail)	123A90-DDL-AR-DL-10011
Electrical Equipment Layout – LV Switchroom	123A90-DDL-EL-DL-20105
B-200 General Arramgement Drawings (by Vendor)	1724000049-AR-DA-00015
B-200 Detail Drawings (by Vendor)	1724000049-AR-DD-00019
B-200 Structural Calculation (by Vendor)	1724000049-ST-CA-00007
B-200 Foundation Dwg (by Vendor)	1724000049-ST-DD-00011
Lifting Drawings (by Vendor)	1724000049-AR-DD-00062

KEY PLAN

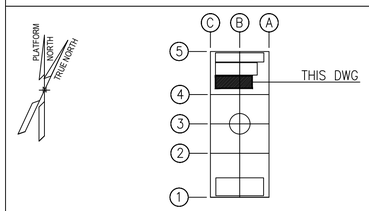

STILOG

REV.	DATE	DRN	CHKD	APPD	DESCRIPTION
02	18/09/25	SPS	M. GA	CGI	AS-BUILT (ASB)
01	12/03/24	R. BO	M. GA	D. LO	ACCEPTED FOR CONSTRUCTION (AFC)
00	17/10/23	R. BO	M. GA	D. LO	ISSUE FOR REVIEW (IFR)

CROSSWIND

ROSETTI MARINO


TITLE :
BASE LOAD POWER HUB (BLPH)
LV (400V) SWITCHGEAR ROOM B-200 – ARCHITECTURAL
GENERAL LAYOUT – PLAN, WIEW, SECT. & TYP. DET.

CONTRACT NO./TITLE	CW-I-WP4-2023-05/HOLLANDSE KUST NOORD WIND PARK		SCALE	1:33
DRAWN SPS	CHECKED M. GATTI	APPROVED CGI	DATE	18/09/25
A1	DRAWING NO. 123A90-DDL-AR-DL-10008		SHEET 002	REV. 02

File Name : 123A90-DDL-AR-DL-10008 REV.02

DRAWING NO. 123A90-DDL-AR-DL-10008


REV. 02

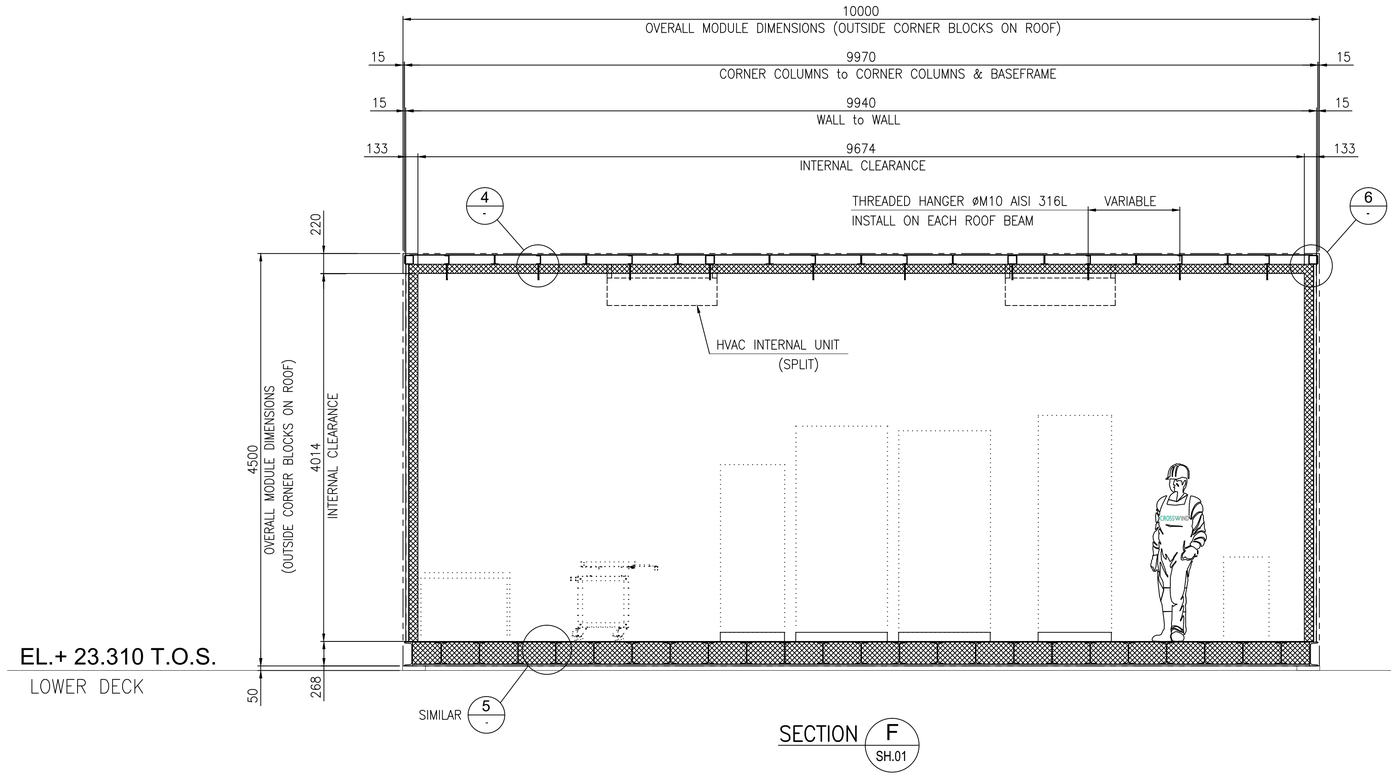

EL.+ 23.310 T.O.S.

LOWER DECK

SECTION F SH.01

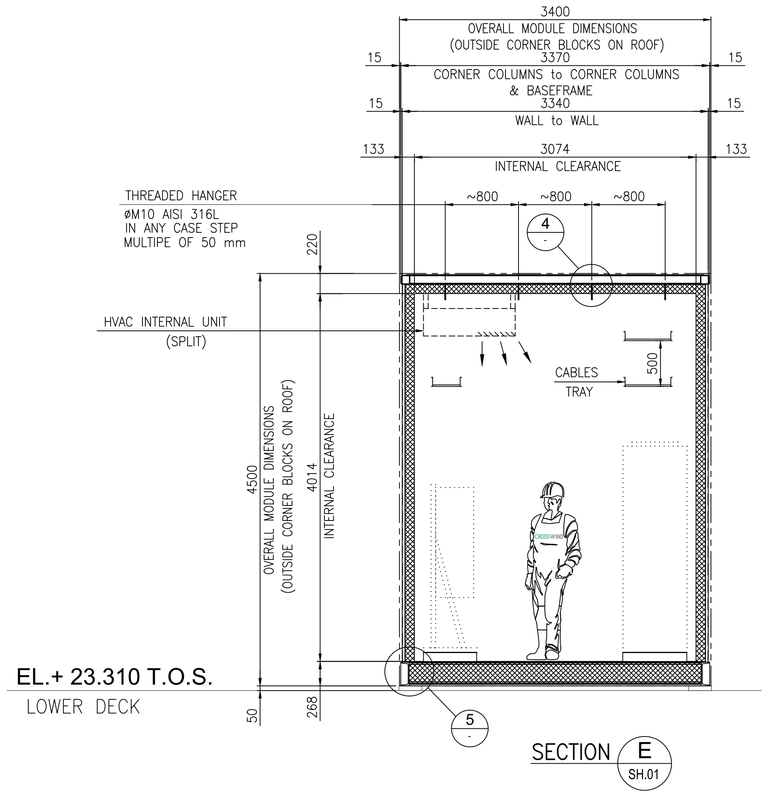


EL.+ 23.310 T.O.S.

LOWER DECK


SECTION E SH.01

FOR PLAN SEE DWG N. 123A90-DDL-AR-DL-10008 Sh. 01


FOR HVAC SYSTEM, LIGHTING SYSTEM, EARTH SYSTEM, MCT's WALL PENETRATIONS REF. TO DOC. N.1724000049-AR-DD-00019 (by VENDOR)

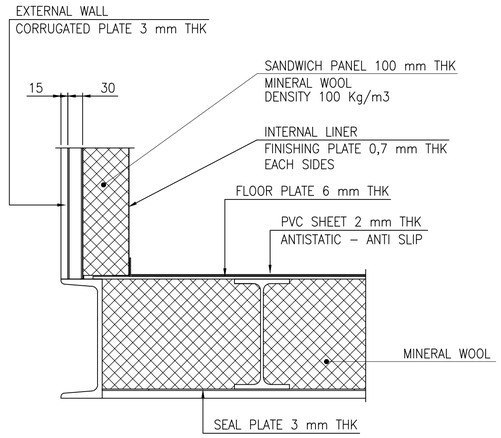


DETAIL 5

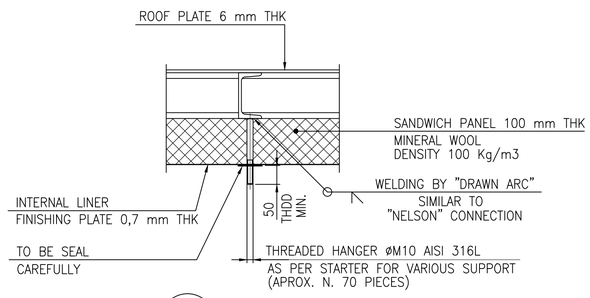

DETAIL 4

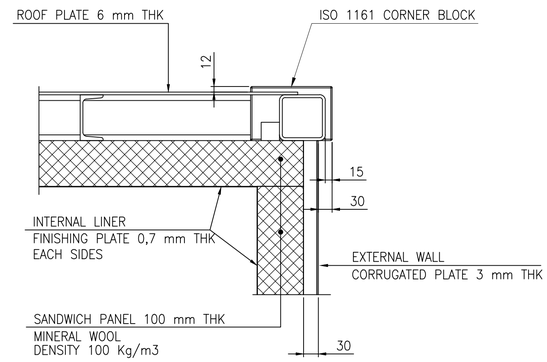

DETAIL 6

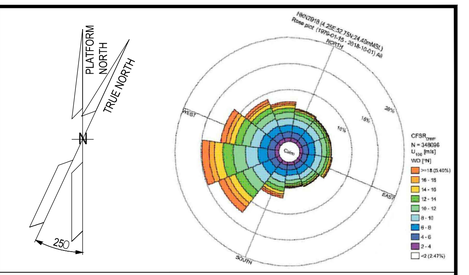

NOTES

1. U.N.O. ALL DIMENSIONS ARE IN MILLIMETERS.
2. ALL WELDS MUST BE CONTINUOUS, SPOT WELDS ARE NOT PERMITTED

LEGEND

U.N.O. _____ UNLESS NOTED OTHERWISE
T.O.S. _____ TOP OF STEEL
T.O.P. _____ TOP OF PLATE
T.B.D. _____ TO BE DEFINED
T.B.C. _____ TO BE COMFIRMED

_____ CORRUGATED PLATE 3 mm THK

_____ THERMAL INSULATION


_____ EQUIPMENT INSIDE MODULE

HOLDS

REFERENCE

DOCUMENT TITLE	DOCUMENT NUMBER
LV (400V) Switchroom – Supply Specification	123A90-DDL-AR-SP-10007
LV (400V) Switchroom – Material Requisition	123A90-DDL-AR-MR-10012
LV (400V) Switchroom – Doors Map and Schedule	123A90-DDL-AR-DL-10009
LV (400V) Switchroom – Flooring and Lining Layout	123A90-DDL-AR-DL-10010
LV (400V) Switchroom – Fire rated requirement layout (plan, section, typical detail)	123A90-DDL-AR-DL-10011
Electrical Equipment Layout – LV Switchroom	123A90-DDL-EL-DL-20105
B-200 General Arramgement Drawings (by Vendor)	1724000049-AR-DA-00015
B-200 Detail Drawings (by Vendor)	1724000049-AR-DD-00019
B-200 Structural Calculation (by Vendor)	1724000049-ST-CA-00007
B-200 Foundation Dwg (by Vendor)	1724000049-ST-DD-00011
Lifting Drawings (by Vendor)	1724000049-AR-DD-00062

KEY PLAN

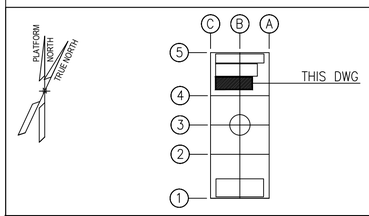

STILOG

REV.	DATE	DRN	CHKD	APPD	DESCRIPTION
02	18/09/25	SPS	M. GA	CGI	AS-BUILT (ASB)
01	12/03/24	R. BO	M. GA	D. LO	ACCEPTED FOR CONSTRUCTION (AFC)
00	17/10/23	R. BO	M. GA	D. LO	ISSUE FOR REVIEW (IFR)

CROSSWIND

ROSETTI MARINO

TITLE :
BASE LOAD POWER HUB (BLPH)
LV (400V) SWITCHGEAR ROOM B-200 – ARCHITECTURAL
GENERAL LAYOUT – PLAN, WIEW, SECT. & TYP. DET.

CONTRACT NO./TITLE CW-I-WP4-2023-05/HOLLANDSE KUST NOORD WIND PARK		SCALE 1:33	
DRAWN SPS	CHECKED M. GATTI	APPROVED CGI	DATE 18/09/25
A1	DRAWING NO. 123A90-DDL-AR-DL-10008	SHEET 003	REV. 02

File Name : 123A90-DDL-AR-DL-10008 REV.02