

DRAWING NO. 123A90-DDL-AR-DL-10010

REV. 02

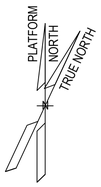


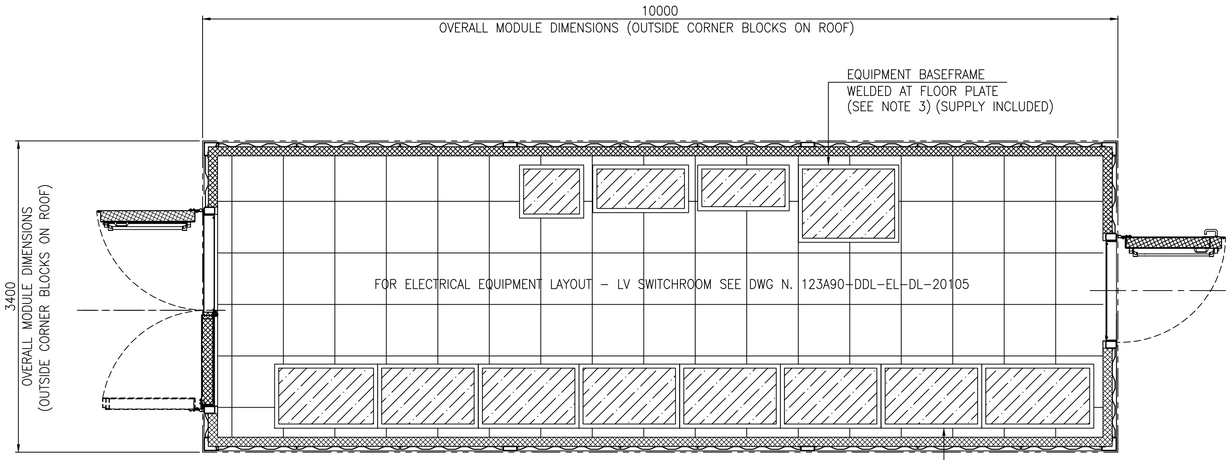


PLAN OF LV (400V) SWITCHGEAR ROOM B-200
FLOOR FINISHING

ALL SUPPORTS FOR FLOOR and WALL MOUNTED CABINETS/EQUIPMENT ARE INCLUDED IN THE SCOPE OF SUPPLY


FOR BASEFRAMES DETAILS REF. TO DOC. B-200 DETAIL DRAWINGS N°. 1724000049-AR-DD-00019 (by VENDOR)

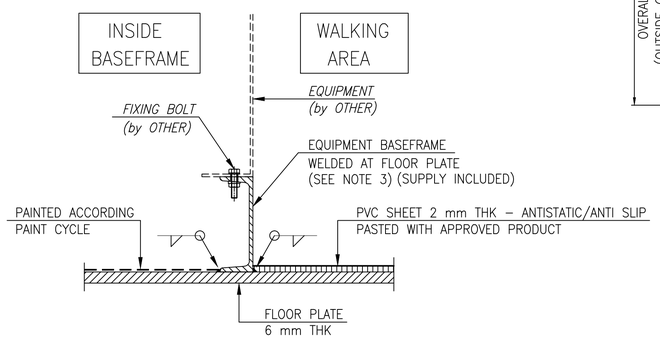

FLOOR FINISHING DETAIL
AND BASEFRAME INTALLATION DETAIL

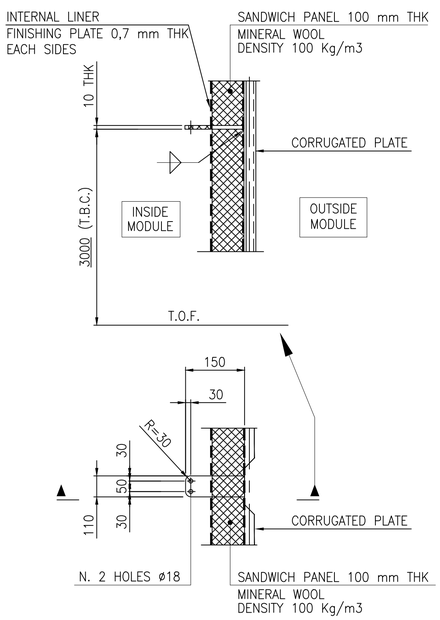


DETAIL OF SEAFASTENING PLATE
TOTAL N. 14 PIECES

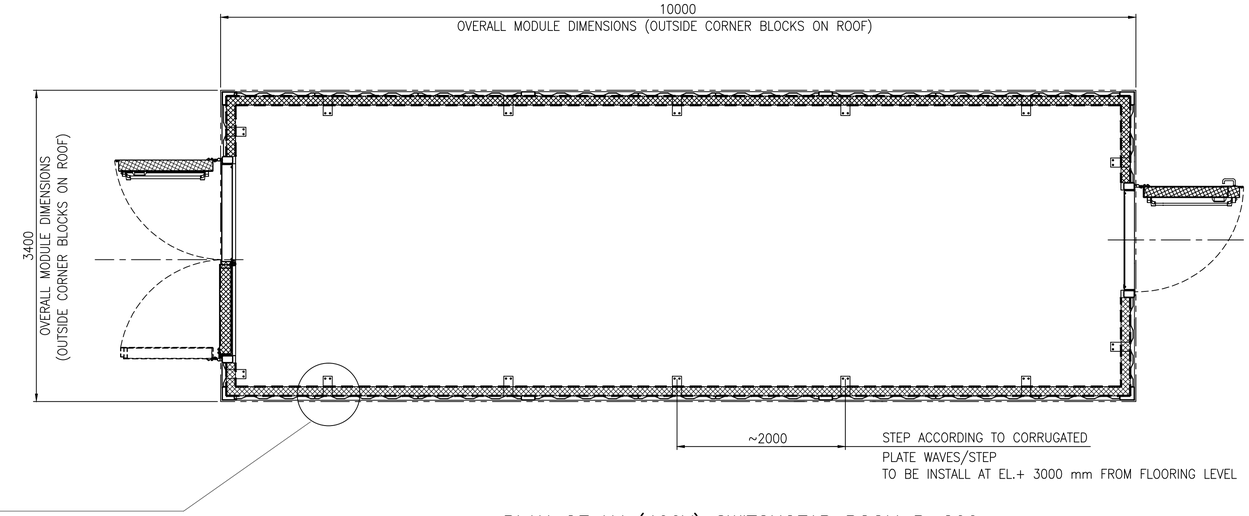


PLAN OF LV (400V) SWITCHGEAR ROOM B-200
INTERNAL LINER & PLATE FOR SEAFASTENING

FOR SEAFASTENING PLATES DETAILS REF. TO DOC. B-200 DETAIL DRAWINGS N°. 1724000049-AR-DD-00019 (by VENDOR)

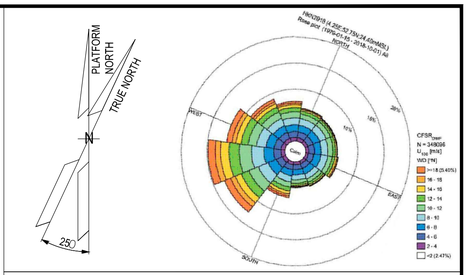

NOTES

1. U.N.O. ALL DIMENSIONS ARE IN MILLIMETERS.
2. ALL WELDS SHALL BE ACCORDING TO A.W.S. CODE.
3. ALL WELDS MUST BE CONTINUOUS, SPOT WELDS ARE NOT PERMITTED
4. U.N.O. ALL FILLET WELDS SHALL HAVE FOLLOWING DIMENSION:

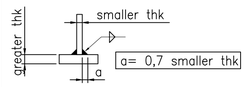

LEGEND


U.N.O.	UNLESS NOTED OTHERWISE
T.O.S.	TOP OF STEEL
T.O.P.	TOP OF PLATE
T.O.F.	TOP OF FLOOR
℄	CENTER LINE
T.B.D.	TO BE DEFINED
T.B.C.	TO BE COMFIRMED
	FLOOR FINISHING – SEAMLESS PVC SHEET 2 mm THK NON-SLIP, ANTI-STATIC SUITABLE FOR HEAVY DUTY USE
	DECK PAINTING ONLY
	LINER 0,7 mm THK INCLUDED IN SANDWICH PANEL
	SEAFASTENING PLATE

HOLDS

REFERENCE

DOCUMENT TITLE	DOCUMENT NUMBER
LV (400V) Switchroom – Supply Specification	123A90-DDL-AR-SP-10007
LV (400V) Switchroom – Architectural General Layout (plan, view, section & typical details)	123A90-DDL-AR-SP-10008
LV (400V) Switchroom – Doors Map and Schedule	123A90-DDL-AR-DL-10009
LV (400V) Switchroom – Fire rated requirement layout (plan, section, typical detail)	123A90-DDL-AR-DL-10011
Electrical Equipment Layout – LV Switchroom	123A90-DDL-EL-DL-20105
B-200 General Arramgement Drawings (by Vendor)	1724000049-AR-DA-00015
B-200 Detail Drawings (by Vendor)	1724000049-AR-DD-00019

KEY PLAN

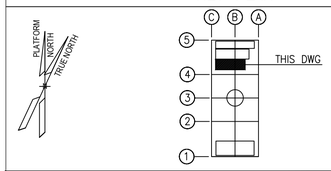

STILOG

REV.	DATE	DRN	CHKD	APPD	DESCRIPTION
02	18/09/25	SPS	M. GA	CGI	AS-BUILT (ASB)
01	12/03/24	R. BO	M. GA	D. LO	ACCEPTED FOR CONSTRUCTION (AFC)
00	17/10/23	R. BO	M. GA	D. LO	ISSUE FOR REVIEW (IFR)

CROSSWIND

ROSETTI MARINO

TITLE :
BASE LOAD POWER HUB (BLPH)
LV (400V) SWITCHGEAR ROOM B-200 – ARCHITECTURAL
FLOORING and LINING LAYOUT

CONTRACT NO./TITLE CW-I-WP4-2023-05/HOLLANDSE KUST NOORD WIND PARK			SCALE 1:33
DRAWN SPS	CHECKED M. GATTI	APPROVED CGI	DATE 18/09/25
A1	DRAWING NO. 123A90-DDL-AR-DL-10010		SHEET 001 / REV. 02

File Name : 123A90-DDL-AR-DL-10010 REV.02