
DRAWING NO. 123A90-DDL-AR-DL-10015 REV. 02

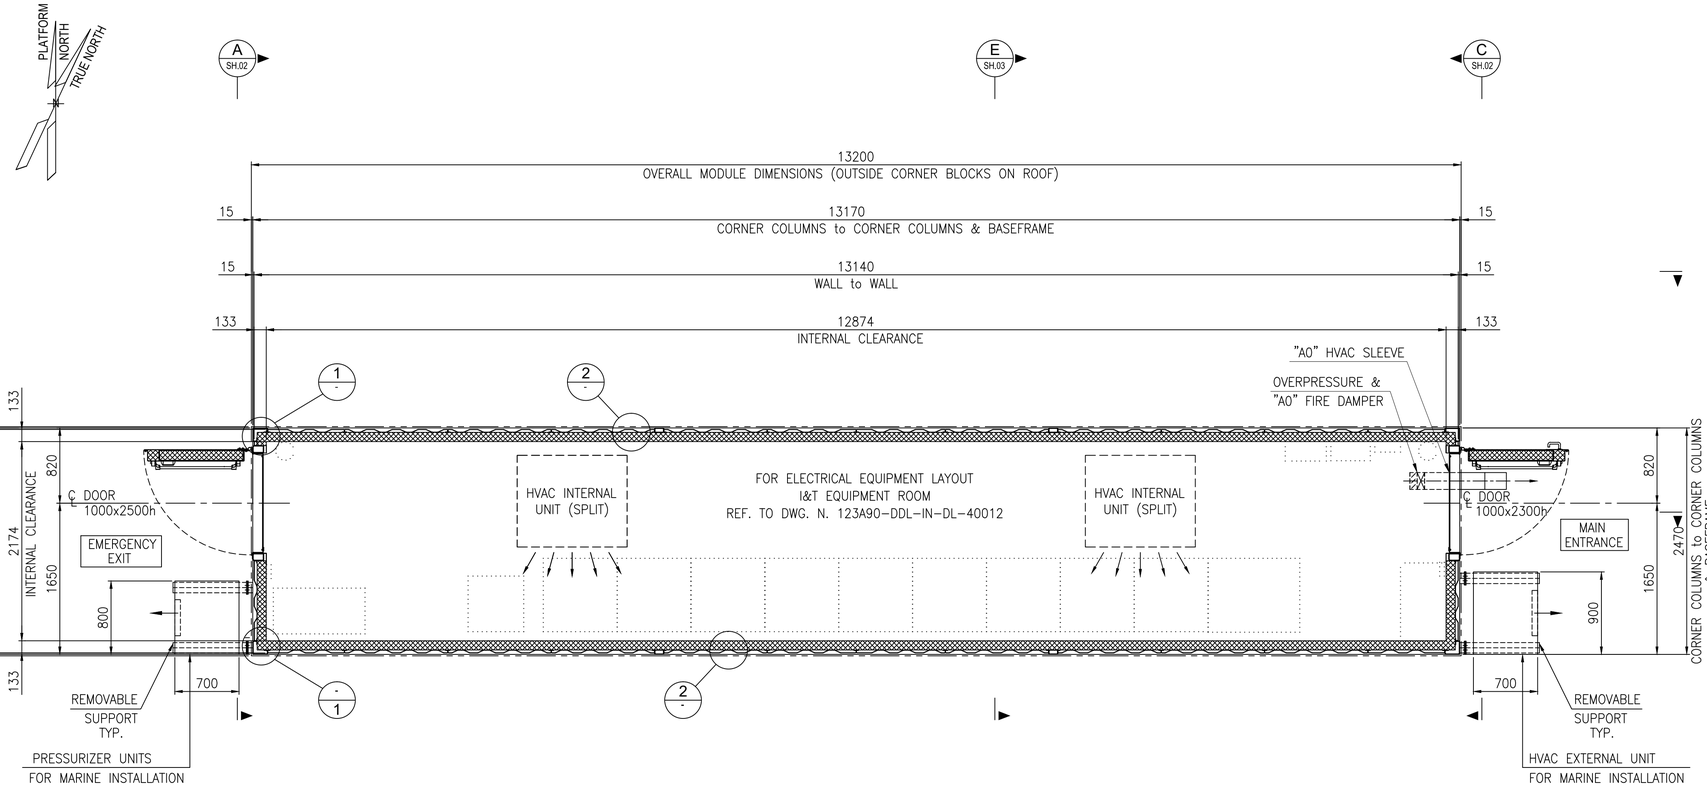


PLAN OF I&T EQUIPMENT ROOM B-400


FOR SECTIONS & VIEWS SEE DWG N. 123A90-DDL-AR-DL-10015 Sh. 02 & 03

INCLUDED IN SUPPLY COMPLETE HVAC SYSTEM, NORMAL AND EMERGENCY LIGHTING SYSTEM INCLUDING CONTROL PANELS


FOR HVAC SYSTEM, LIGHTING SYSTEM, EARTH SYSTEM REF.TO DOC. N.1724000049-AR-DD-00021 (by VENDOR)

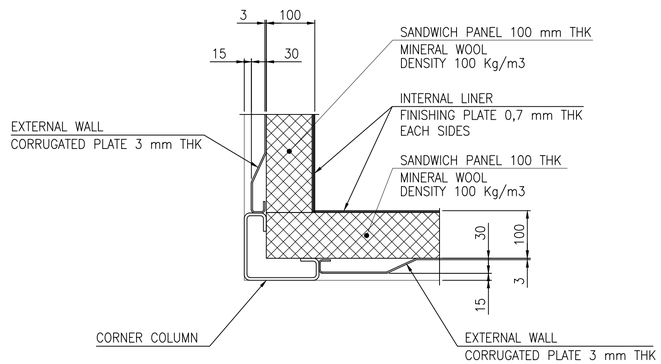

DETAIL 1 - AT CORNERS TYPICAL

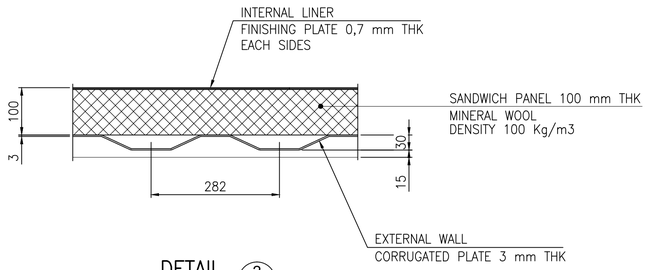

DETAIL 2 - WALL TYPICAL

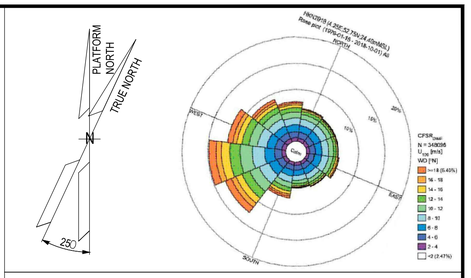

NOTES

1. U.N.O. ALL DIMENSIONS ARE IN MILLIMETERS.
2. ALL WELDS MUST BE CONTINUOUS, SPOT WELDS ARE NOT PERMITTED

LEGEND


U.N.O. — UNLESS NOTED OTHERWISE
T.O.S. — TOP OF STEEL
T.O.P. — TOP OF PLATE
T.B.D. — TO BE DEFINED
T.B.C. — TO BE COMFIRMED
CORRUGATED PLATE 3 mm THK
THERMAL INSULATION
EQUIPMENT INSIDE MODULE

HOLDS

REFERENCE

DOCUMENT TITLE	DOCUMENT NUMBER
I&T Equipment Room – Supply Specification	123A90-DDL-AR-SP-10014
I&T Equipment Room – Material Requisition	123A90-DDL-AR-MR-10019
I&T Equipment Room – Doors Map and Schedule	123A90-DDL-AR-DL-10016
I&T Equipment Room – Flooring and Lining Layout	123A90-DDL-AR-DL-10017
I&T Equipment Room – Fire rated requirement layout (plan, section, typical detail)	123A90-DDL-AR-DL-10018
I&T Equipment Room – Equipment Layout	23A90-DDL-IN-DL-40012
B-400 General Arramgement Dwg's (by Vendor)	1724000049-AR-DA-00017
B-400 Detail Dwg's (by Vendor)	1724000049-AR-DD-00021
B-400 Structural Calculation (by Vendor)	1724000049-ST-CA-00009
B-400 Foundation Dwg (by Vendor)	1724000049-ST-DD-00013
Lifting Drawings (by Vendor)	1724000049-AR-DD-00062

KEY PLAN

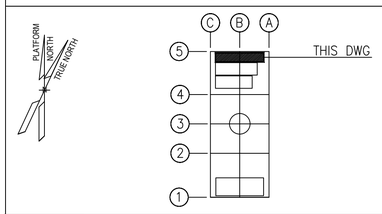

STILOG

REV.	DATE	DRN	CHKD	APPD	DESCRIPTION
02	18/09/25	SPS	M. GA	CGI	AS-BUILT (ASB)
01	23/02/24	R. BO	M. GA	D. LO	ACCEPTED FOR CONSTRUCTION (AFC)
00	30/10/23	R. BO	M. GA	D. LO	ISSUE FOR REVIEW (IFR)

CROSSWIND


ROSETTI MARINO


TITLE :
BASE LOAD POWER HUB (BLPH)
I&T EQUIPMENT ROOM B-400 – ARCHITECTURAL
GENERAL LAYOUT – PLAN, WIEW, SECT. & TYP. DET.

CONTRACT NO./TITLE CW-I-WP4-2023-05/HOLLANDSE KUST NOORD WIND PARK | SCALE 1:33
DRAWN SPS | CHECKED M. GATTI | APPROVED CGI | DATE 18/09/25
A1 | DRAWING NO. 123A90-DDL-AR-DL-10015 | SHEET 001 | REV. 02

File Name : 123A90-DDL-AR-DL-10015 REV.02


DRAWING NO. 123A90-DDL-AR-DL-10015 REV. 02

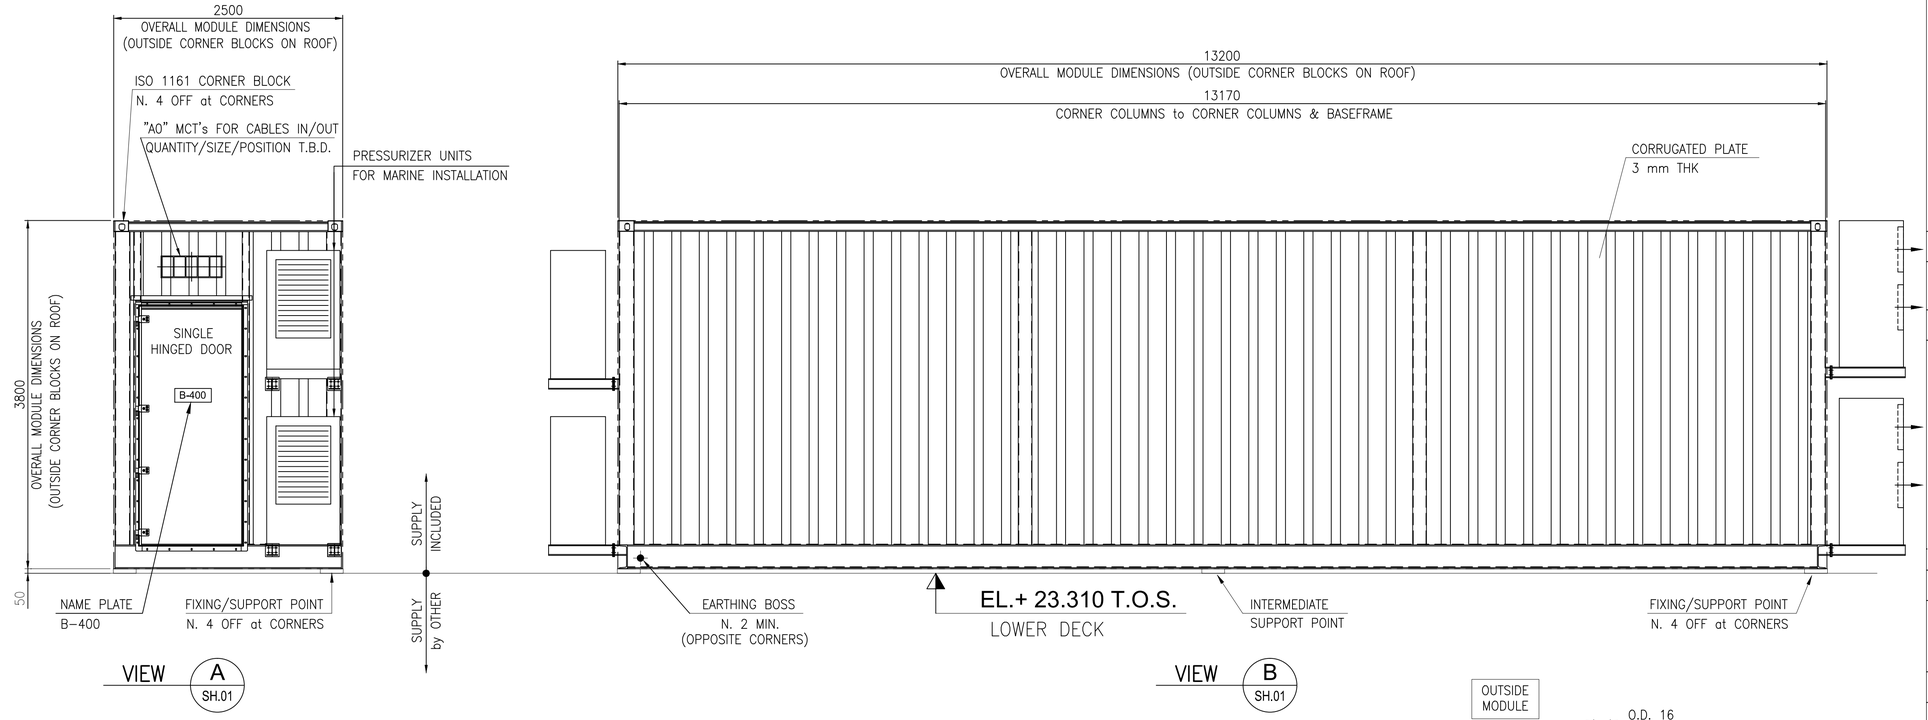


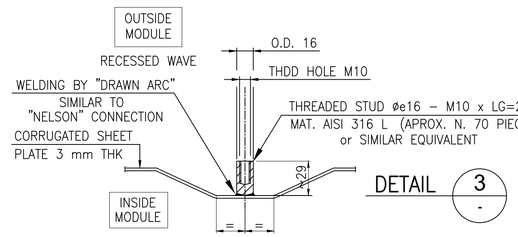

FOR PLAN SEE DWG N. 123A90-DDL-AR-DL-10015 Sh. 01

FOR HVAC SYSTEM, LIGHTING SYSTEM, EARTH SYSTEM, MCT's WALL PENETRATIONS
REF. TO DOC. N.1724000049-AR-DD-00021 (by VENDOR)

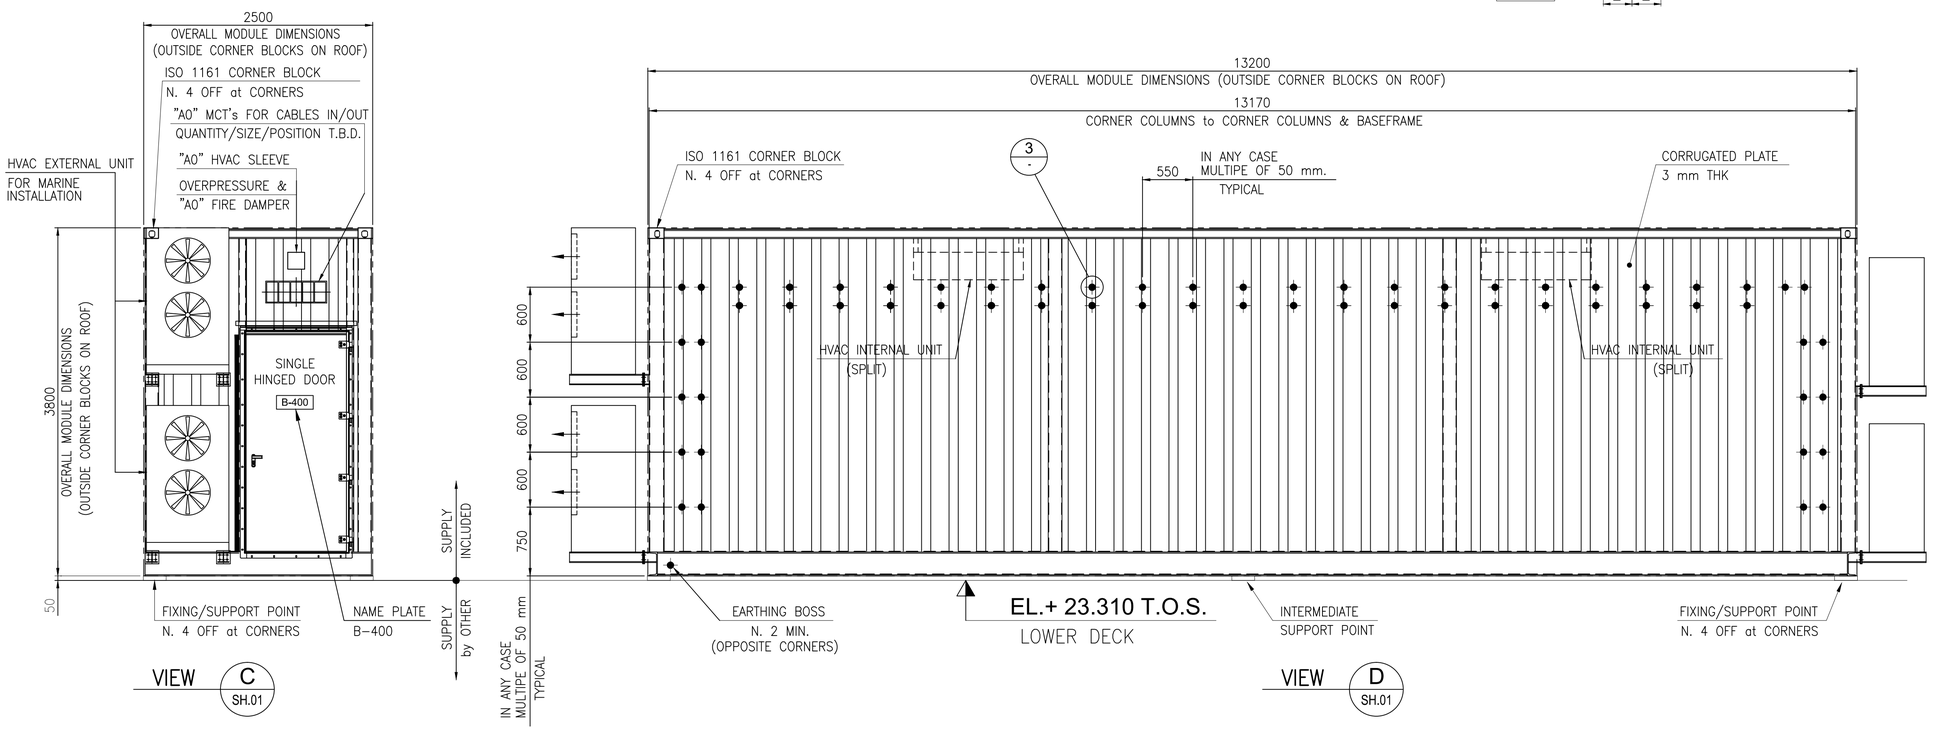

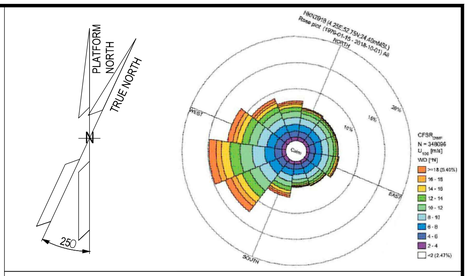

NOTES

1. U.N.O. ALL DIMENSIONS ARE IN MILLIMETERS.
2. ALL WELDS MUST BE CONTINUOUS, SPOT WELDS ARE NOT PERMITTED

LEGEND


U.N.O.	UNLESS NOTED OTHERWISE
T.O.S.	TOP OF STEEL
T.O.P.	TOP OF PLATE
T.B.D.	TO BE DEFINED
T.B.C.	TO BE COMFIRMED
	CORRUGATED PLATE 3 mm THK
	THERMAL INSULATION
	EQUIPMENT INSIDE MODULE

HOLDS

REFERENCE

DOCUMENT TITLE	DOCUMENT NUMBER
I&T Equipment Room – Supply Specification	123A90-DDL-AR-SP-10014
I&T Equipment Room – Material Requisition	123A90-DDL-AR-MR-10019
I&T Equipment Room – Doors Map and Schedule	123A90-DDL-AR-DL-10016
I&T Equipment Room – Flooring and Lining Layout	123A90-DDL-AR-DL-10017
I&T Equipment Room – Fire rated requirement layout (plan, section, typical detail)	123A90-DDL-AR-DL-10018
I&T Equipment Room – Equipment Layout	23A90-DDL-IN-DL-40012
B-400 General Arramgement Dwg's (by Vendor)	1724000049-AR-DA-00017
B-400 Detail Dwg's (by Vendor)	1724000049-AR-DD-00021
B-400 Structural Calculation (by Vendor)	1724000049-ST-CA-00009
B-400 Foundation Dwg (by Vendor)	1724000049-ST-DD-00013
Lifting Drawings (by Vendor)	1724000049-AR-DD-00062

KEY PLAN

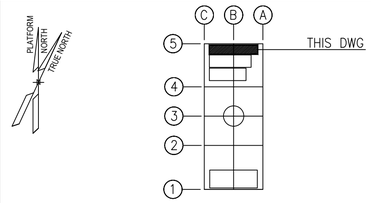

STILOG

REV.	DATE	DRN	CHKD	APPD	DESCRIPTION
02	18/09/25	SPS	M. GA	CGI	AS-BUILT (ASB)
01	23/02/24	R. BO	M. GA	D. LO	ACCEPTED FOR CONSTRUCTION (AFC)
00	30/10/23	R. BO	M. GA	D. LO	ISSUE FOR REVIEW (IFR)

CROSSWIND

ROSETTI MARINO


TITLE :
BASE LOAD POWER HUB (BLPH)
I&T EQUIPMENT ROOM B-400 – ARCHITECTURAL
GENERAL LAYOUT – PLAN, WIEW, SECT. & TYP. DET.

CONTRACT NO./TITLE CW-I-WP4-2023-05/HOLLANDSE KUST NOORD WIND PARK			SCALE 1:33
DRAWN SPS	CHECKED M. GATTI	APPROVED CGI	DATE 18/09/25
A1	DRAWING NO. 123A90-DDL-AR-DL-10015	SHEET 002	REV. 02


File Name : 123A90-DDL-AR-DL-10015 REV.02

DRAWING NO. 123A90-DDL-AR-DL-10015

REV. 02

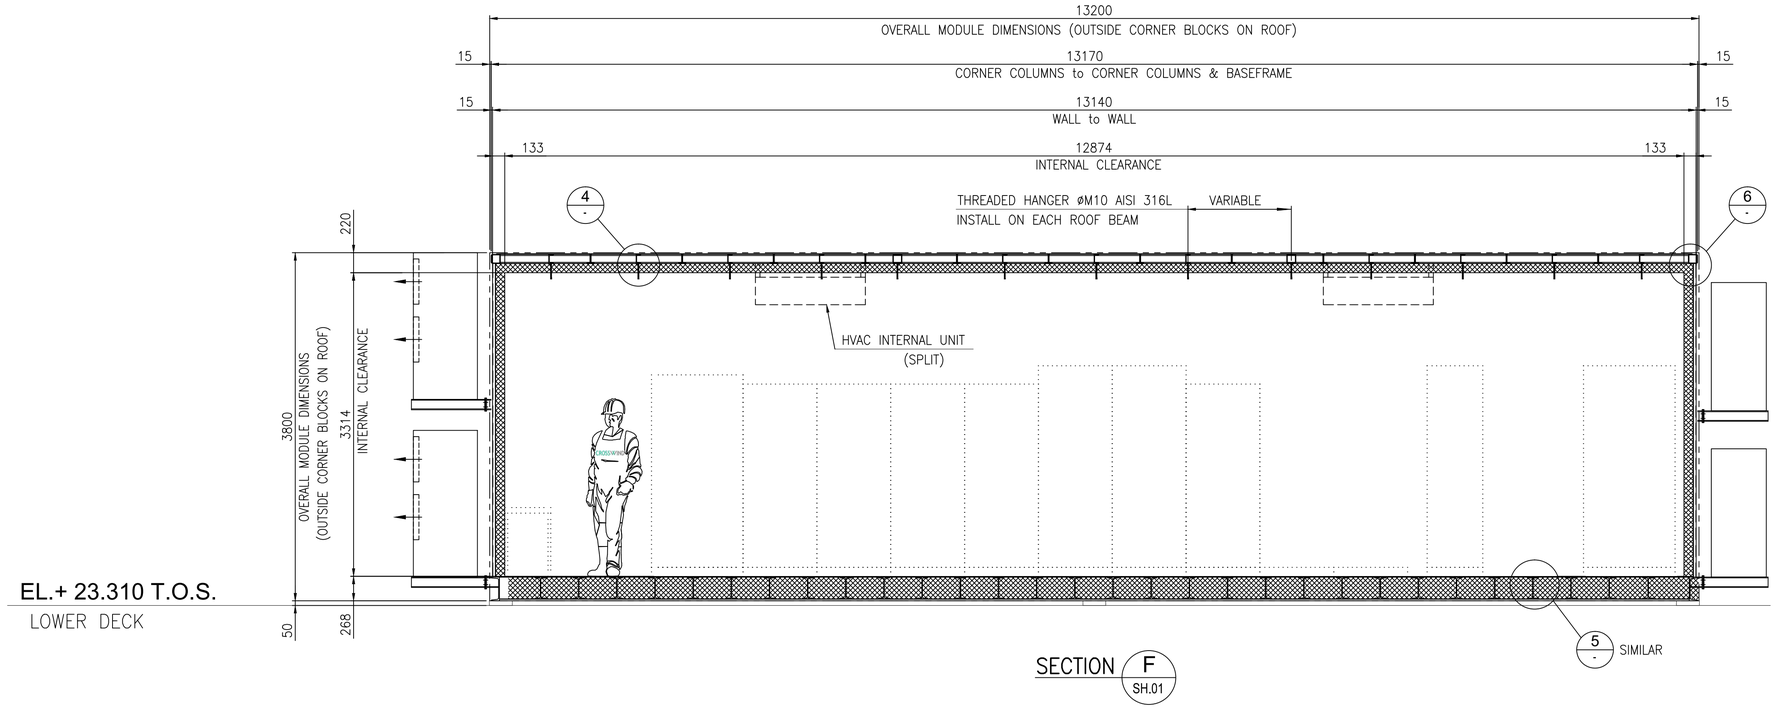

SECTION F SH.01

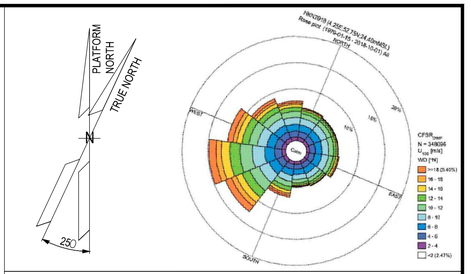

NOTES

1. U.N.O. ALL DIMENSIONS ARE IN MILLIMETERS.
2. ALL WELDS MUST BE CONTINUOUS, SPOT WELDS ARE NOT PERMITTED

LEGEND


U.N.O.	UNLESS NOTED OTHERWISE
T.O.S.	TOP OF STEEL
T.O.P.	TOP OF PLATE
T.B.D.	TO BE DEFINED
T.B.C.	TO BE COMFIRMED
	CORRUGATED PLATE 3 mm THK
	THERMAL INSULATION
	EQUIPMENT INSIDE MODULE


HOLDS

REFERENCE

DOCUMENT TITLE	DOCUMENT NUMBER
I&T Equipment Room – Supply Specification	123A90-DDL-AR-SP-10014
I&T Equipment Room – Material Requisition	123A90-DDL-AR-MR-10019
I&T Equipment Room – Doors Map and Schedule	123A90-DDL-AR-DL-10016
I&T Equipment Room – Flooring and Lining Layout	123A90-DDL-AR-DL-10017
I&T Equipment Room – Fire rated requirement layout (plan, section, typical detail)	123A90-DDL-AR-DL-10018
I&T Equipment Room – Equipment Layout	23A90-DDL-IN-DL-40012
B-400 General Arramgement Dwg's (by Vendor)	1724000049-AR-DA-00017
B-400 Detail Dwg's (by Vendor)	1724000049-AR-DD-00021
B-400 Structural Calculation (by Vendor)	1724000049-ST-CA-00009
B-400 Foundation Dwg (by Vendor)	1724000049-ST-DD-00013
Lifting Drawings (by Vendor)	1724000049-AR-DD-00062

KEY PLAN

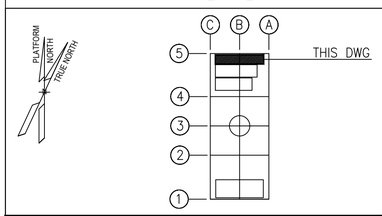


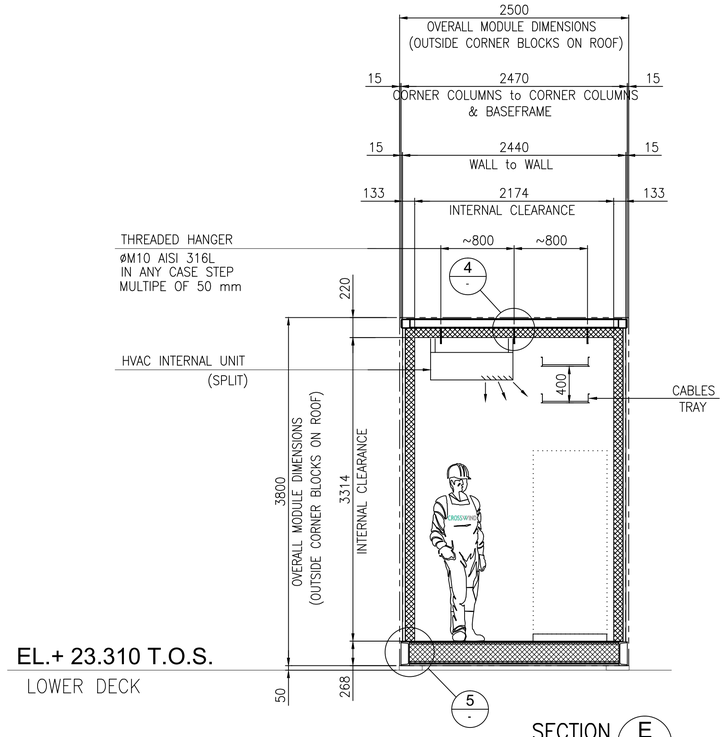


SECTION E SH.01

FOR PLAN SEE DWG N. 123A90-DDL-AR-DL-10015 Sh. 01


FOR HVAC SYSTEM, LIGHTING SYSTEM, EARTH SYSTEM, MCT's WALL PENETRATIONS REF. TO DOC. N.1724000049-AR-DD-00021 (by VENDOR)

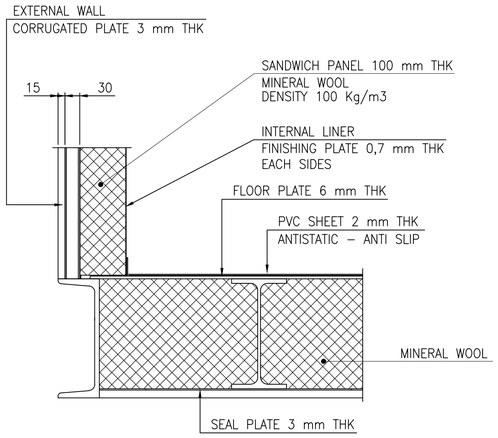

DETAIL 5

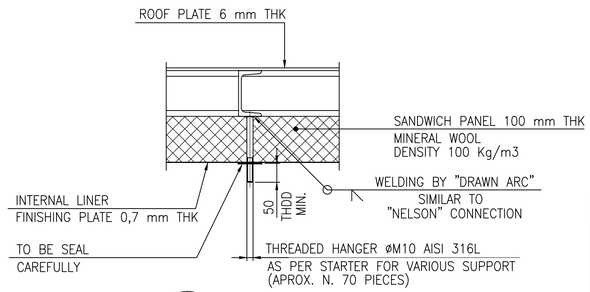

DETAIL 4

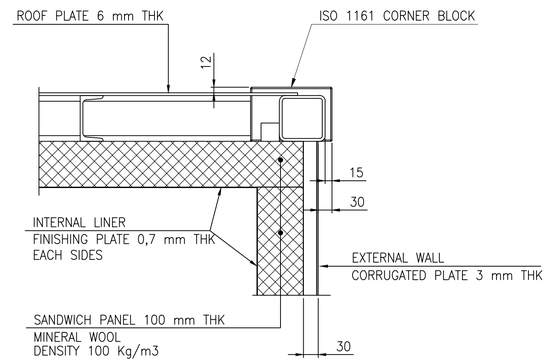

DETAIL 6

REV.	DATE	DRN	CHKD	APPD	DESCRIPTION
02	18/09/25	SPS	M. GA	CGI	AS-BUILT (ASB)
01	23/02/24	R. BO	M. GA	D. LO	ACCEPTED FOR CONSTRUCTION (AFC)
00	30/10/23	R. BO	M. GA	D. LO	ISSUE FOR REVIEW (IFR)

CROSSWIND

ROSETTI MARINO

TITLE : BASE LOAD POWER HUB (BLPH)
I&T EQUIPMENT ROOM B-400 – ARCHITECTURAL
GENERAL LAYOUT – PLAN, WIEW, SECT. & TYP. DET.

CONTRACT NO./TITLE CW-I-WP4-2023-05/HOLLANDSE KUST NOORD WIND PARK		SCALE 1:33	
DRAWN SPS	CHECKED M. GATTI	APPROVED CGI	DATE 18/09/25
A1	DRAWING NO. 123A90-DDL-AR-DL-10015	SHEET 003	REV. 02

File Name : 123A90-DDL-AR-DL-10015 REV.02