

DRAWING NO. 123A90-DDL-AR-DL-10016

REV. 02

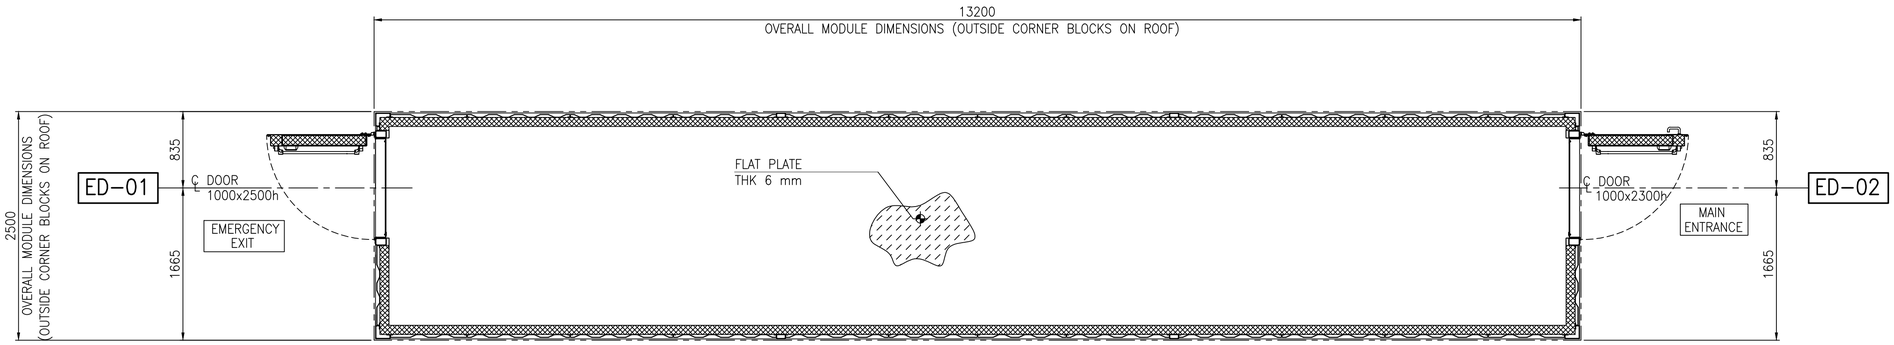


PLAN OF I&T EQUIPMENT ROOM B-400
DOORS MAP

THIS DRAWING IS VALID FOR DOORS MAPS/SCHEDULE ONLY

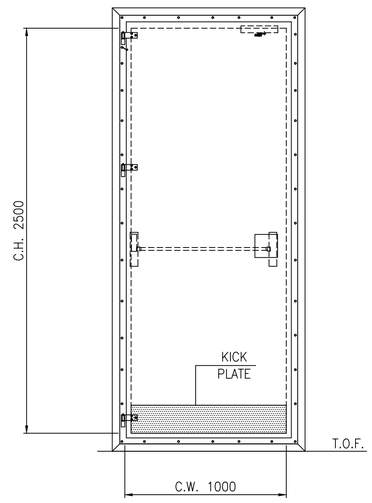


EXTERNAL
SINGLE DOOR "A0"

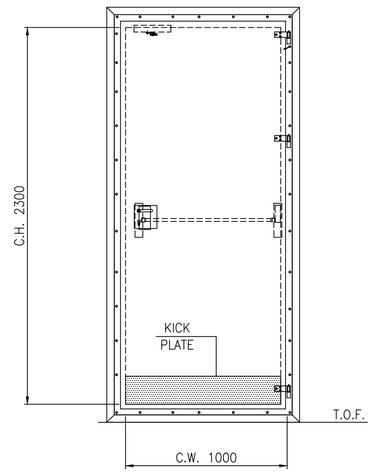

EXTERNAL
SINGLE DOOR "A0"

DOOR OPENING SENSE:

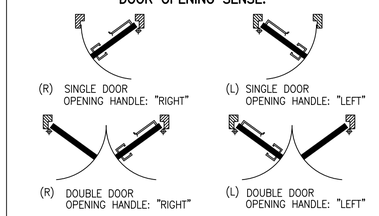

DOORS SCHEDULE HOLD 1

DOOR IDENTIFICATION NUMBER	QUATITY	FIRE CLASS	SIZE AND OPENING SENSE					LOCATION	COATINGS AND COLOURS							LOCK TYPE AND HARDWARE										VARIOUS							
									DOOR LEAF (INTERNAL / EXTERNAL)				FRAME																				
									EXTERNAL		INTERNAL																						
			CLEAR OPENING W x H (mm)	SINGLE DOOR	DOUBLE DOOR	LEFT	RIGTH		MATERIAL	COLOUR RAL	MATERIAL	COLOUR RAL	MATERIAL	TO BE BOLTED	TO BE WELDED	COLOUR RAL	THRESHOLD (MINIMUM HEIGHT)	HINGE TYPE	HANDLE TYPE EXTERNAL SIDE & ESCUTCHEON	HANDLE TYPE INTERNAL SIDE & ESCUTCHEON	PANIC BAR INTERNAL SIDE	CYLINDER LOCK	SHOOT BOLT (TO BE INTAL. ON THE SEC. WING)	FIRE RESISTANT GASKET DOOR FRAME STRUCTURE FRAME	S.S. KICK PLATE H=200mm ON BOTH SIDES OF EACH DOOR LEAF	SELF CLOSING DEVICE	LIMIT SWITCH	INTERNAL OVER PRESSURE (Pa) (NORMAL OPERATION)	BLAST RESISTANCE (mbarg)	THERMAL INSULATION (W/m2/°C)	ACOUSTIC INSULATION (dbA) SOUND REDUCTION	VISION PANEL WITH S.S. FRAME 500x200 mm	HINGE NUMBER (AT LEAST)	AIR LEAKEGE MAX 10m3/h*m2 at 50 Pa	EARTHING SYSTEM CONNECTION
ED-01	1	A0	1000 x 2500	X		X		TECHNICAL ROOM	S.S.	7035	S.S.	7035	S.S.	X		7035	X	S.S.	N.A.		S.S.	X		X	X	X	by other	25	N.A.	0,45	40	N.A.	3	X	X
ED-02	1	A0	1000 x 2300	X			X	TECHNICAL ROOM	S.S.	7035	S.S.	7035	S.S.	X		7035	X	S.S.	S.S.		S.S.	X		X	X	X	by other	25	N.A.	0,45	40	N.A.	3	X	X

NOTES

1. U.N.O. ALL DIMENSIONS ARE IN MILLIMETERS
2. IN CASE OF DOUBLE LEAF DOORS, THE DOOR ACCESSORIES ARE INTENDED TO BE INSTALLED ONLY ON THE ACTIVE LEAF
3. ALL WELDS MUST BE CONTINUOUS, SPOT WELDS ARE NOT PERMITTED

LEGEND

U.N.O.	UNLESS NOTED OTHERWISE
T.O.S.	TOP OF STEEL
T.O.P.	TOP OF PLATE
T.O.F.	TOP OF FLOOR
℄	CENTER LINE
G.S.	GALVANIZED STEEL
S.S.	STAINLEES STEEL (AISI 316L)
N.A.	NOT APPLICABLE
T.B.D.	TO BE DEFINED
T.B.C.	TO BE COMFIRMED
C.O.	CLEAR OPENING
C.W.	CLEAR WIDTH
C.H.	CLEAR HEIGHT


XX-ZZ — CONTINUOUS NUMBER
ED=EXTERNAL DOOR

HOLDS

REFERENCE

DOCUMENT TITLE	DOCUMENT NUMBER
I&T Equipment Room – Supply Specification	123A90-DDL-AR-SP-10014
I&T Equipment Room – Architectural General Layout (plan, view, section & typical details)	123A90-DDL-AR-SP-10015
I&T Equipment Room – Flooring and Lining Layout	123A90-DDL-AR-DL-10017
I&T Equipment Room – Fire rated requirement layout (plan, section, typical detail)	123A90-DDL-AR-DL-10018
B-400 General Arramgement Dwg's (by Vendor)	1724000049-AR-DA-00017
B-400 Detail Dwg's (by Vendor)	1724000049-AR-DD-00021

KEY PLAN

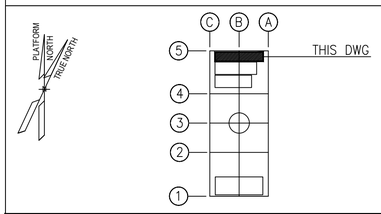

STILOG

REV.	DATE	DRN	CHKD	APPD	DESCRIPTION
02	18/09/25	SPS	M. GA	CGI	AS-BUILT (ASB)
01	23/02/24	R. BO	M. GA	D. LO	ACCEPTED FOR CONSTRUCTION (AFC)
00	30/10/23	R. BO	M. GA	D. LO	ISSUE FOR REVIEW (IFR)

CROSSWIND — ROSETTI MARINO

TITLE :
BASE LOAD POWER HUB (BLPH)
I&T EQUIPMENT ROOM B-400 – ARCHITECTURAL
DOOR MAP and DOOR SCHEDULE

CONTRACT NO./TITLE	CW-I-WP4-2023-05/HOLLANDSE KUST NOORD WIND PARK	SCALE	1:33
DRAWN SPS	CHECKED M. GATTI	APPROVED CGI	DATE 18/09/25

A1	DRAWING NO.	SHEET	REV.
	123A90-DDL-AR-DL-10016	001	02

File Name : 123A90-DDL-AR-DL-10016 REV.02