

DRAWING NO. 123A90-DDL-AR-DL-10017

REV. 02

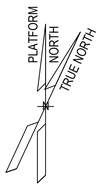


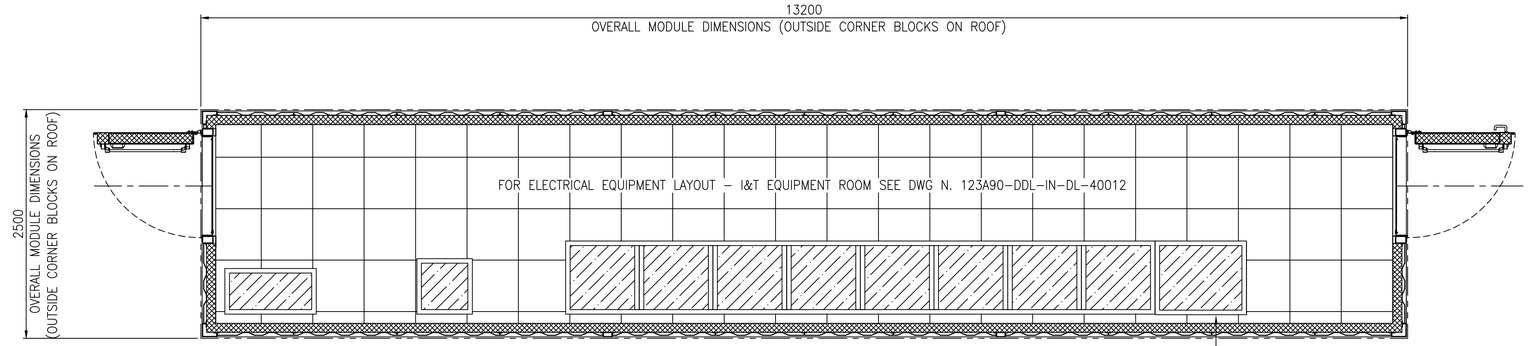


PLAN OF I&T EQUIPMENT ROOM B-400
FLOOR FINISHING

ALL SUPPORTS FOR FLOOR and WALL MOUNTED CABINETS/EQUIPMENT ARE INCLUDED IN THE SCOPE OF SUPPLY


FOR BASEFRAMES DETAILS REF. TO DOC. B-400 DETAIL DRAWINGS N°. 1724000049-AR-DD-00021 (by VENDOR)

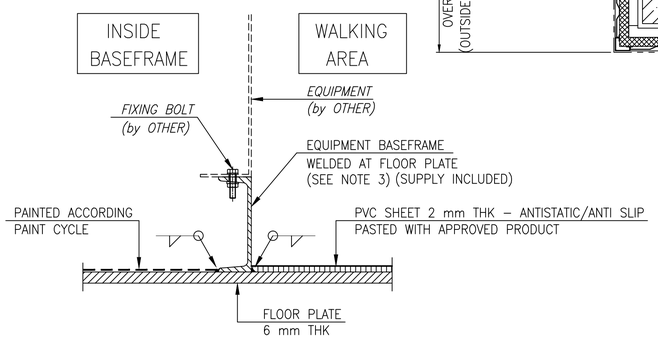

FLOOR FINISHING DETAIL
AND BASEFRAME INTALLATION DETAIL

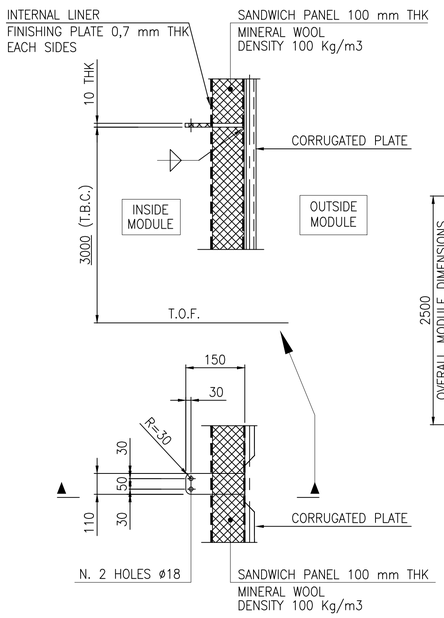



DETAIL OF SEAFASTENING PLATE
TOTAL N. 14 PIECES

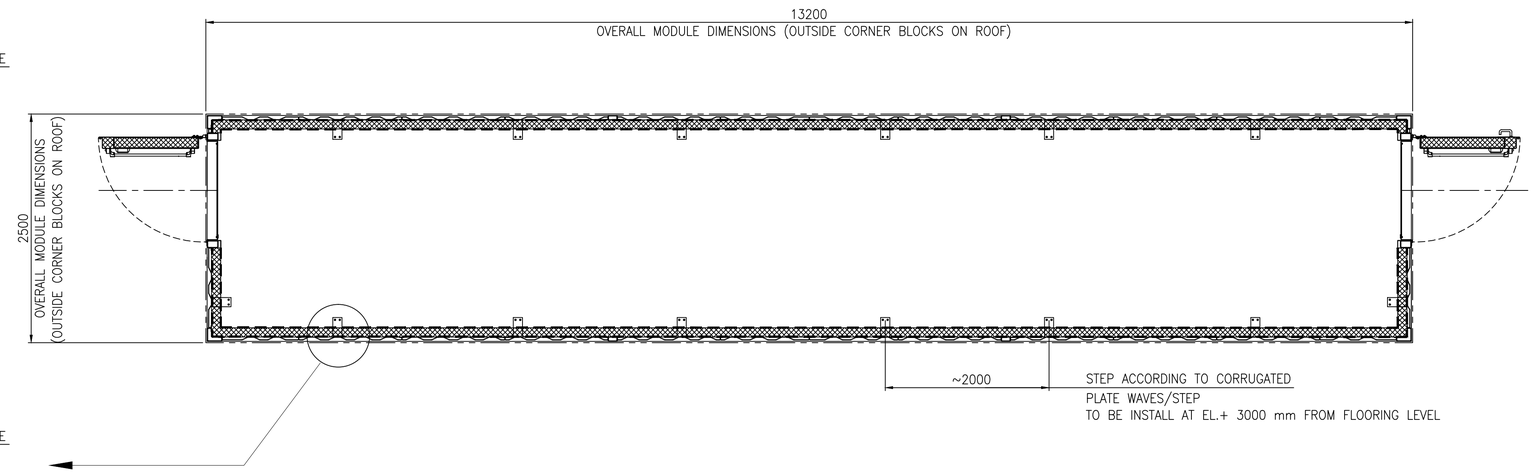

PLAN OF I&T EQUIPMENT ROOM B-400
INTERNAL LINER & PLATE FOR SEAFASTENING


FOR BASEFRAMES DETAILS REF. TO DOC. B-400 DETAIL DRAWINGS N°. 1724000049-AR-DD-00021 (by VENDOR)

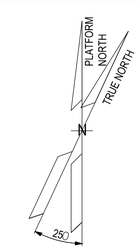

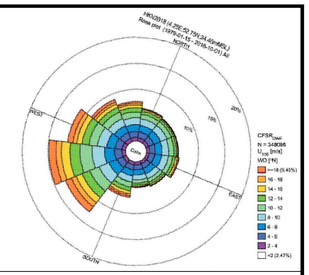

NOTES

1. U.N.O. ALL DIMENSIONS ARE IN MILLIMETERS.
2. ALL WELDS SHALL BE ACCORDING TO A.W.S. CODE.
3. ALL WELDS MUST BE CONTINUOUS, SPOT WELDS ARE NOT PERMITTED
4. U.N.O. ALL FILLET WELDS SHALL HAVE FOLLOWING DIMENSION:

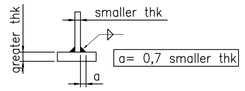

LEGEND


U.N.O.	UNLESS NOTED OTHERWISE
T.O.S.	TOP OF STEEL
T.O.P.	TOP OF PLATE
T.O.F.	TOP OF FLOOR
℄	CENTER LINE
T.B.D.	TO BE DEFINED
T.B.C.	TO BE COMFIRMED
	FLOOR FINISHING – SEAMLESS PVC SHEET 2 mm THK NON-SLIP, ANTI-STATIC SUITABLE FOR HEAVY DUTY USE
	DECK PAINTING ONLY
	LINER 0,7 mm THK INCLUDED IN SANDWICH PANEL
	SEAFASTENING PLATE

HOLDS

REFERENCE

DOCUMENT TITLE	DOCUMENT NUMBER
I&T Equipment Room – Supply Specification	123A90-DDL-AR-SP-10014
I&T Equipment Room – Architectural General Layout (plan, view, section & typical details)	123A90-DDL-AR-SP-10015
I&T Equipment Room – Doors Map and Schedule	123A90-DDL-AR-DL-10016
I&T Equipment Room – Fire rated requirement layout (plan, section, typical detail)	123A90-DDL-AR-DL-10018
B-400 General Arramgement Dwg's (by Vendor)	1724000049-AR-DA-00017
B-400 Detail Dwg's (by Vendor)	1724000049-AR-DD-00021

KEY PLAN

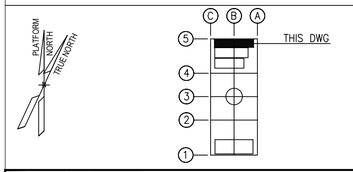

STILOG

REV.	DATE	DRN	CHKD	APPD	DESCRIPTION
02	18/09/25	SPS	M. GA	CGI	AS-BUILT (ASB)
01	23/02/24	R. BO	M. GA	D. LO	ACCEPTED FOR CONSTRUCTION (AFC)
00	30/10/23	R. BO	M. GA	D. LO	ISSUE FOR REVIEW (IFR)

CROSSWIND

ROSETTI MARINO

TITLE :
BASE LOAD POWER HUB (BLPH)
I&T EQUIPMENT ROOM B-400 – ARCHITECTURAL
FLOORING and LINING LAYOUT

CONTRACT NO./TITLE CW-I-WP4-2023-05/HOLLANDSE KUST NOORD WIND PARK			SCALE 1:33
DRAWN SPS	CHECKED M. GATTI	APPROVED CGI	DATE 18/09/25
A1	DRAWING NO. 123A90-DDL-AR-DL-10017	SHEET 001	REV. 02

File Name : 123A90-DDL-AR-DL-10017 REV.02