
DRAWING NO. 123A90-DDL-AR-DL-10022 REV. 02

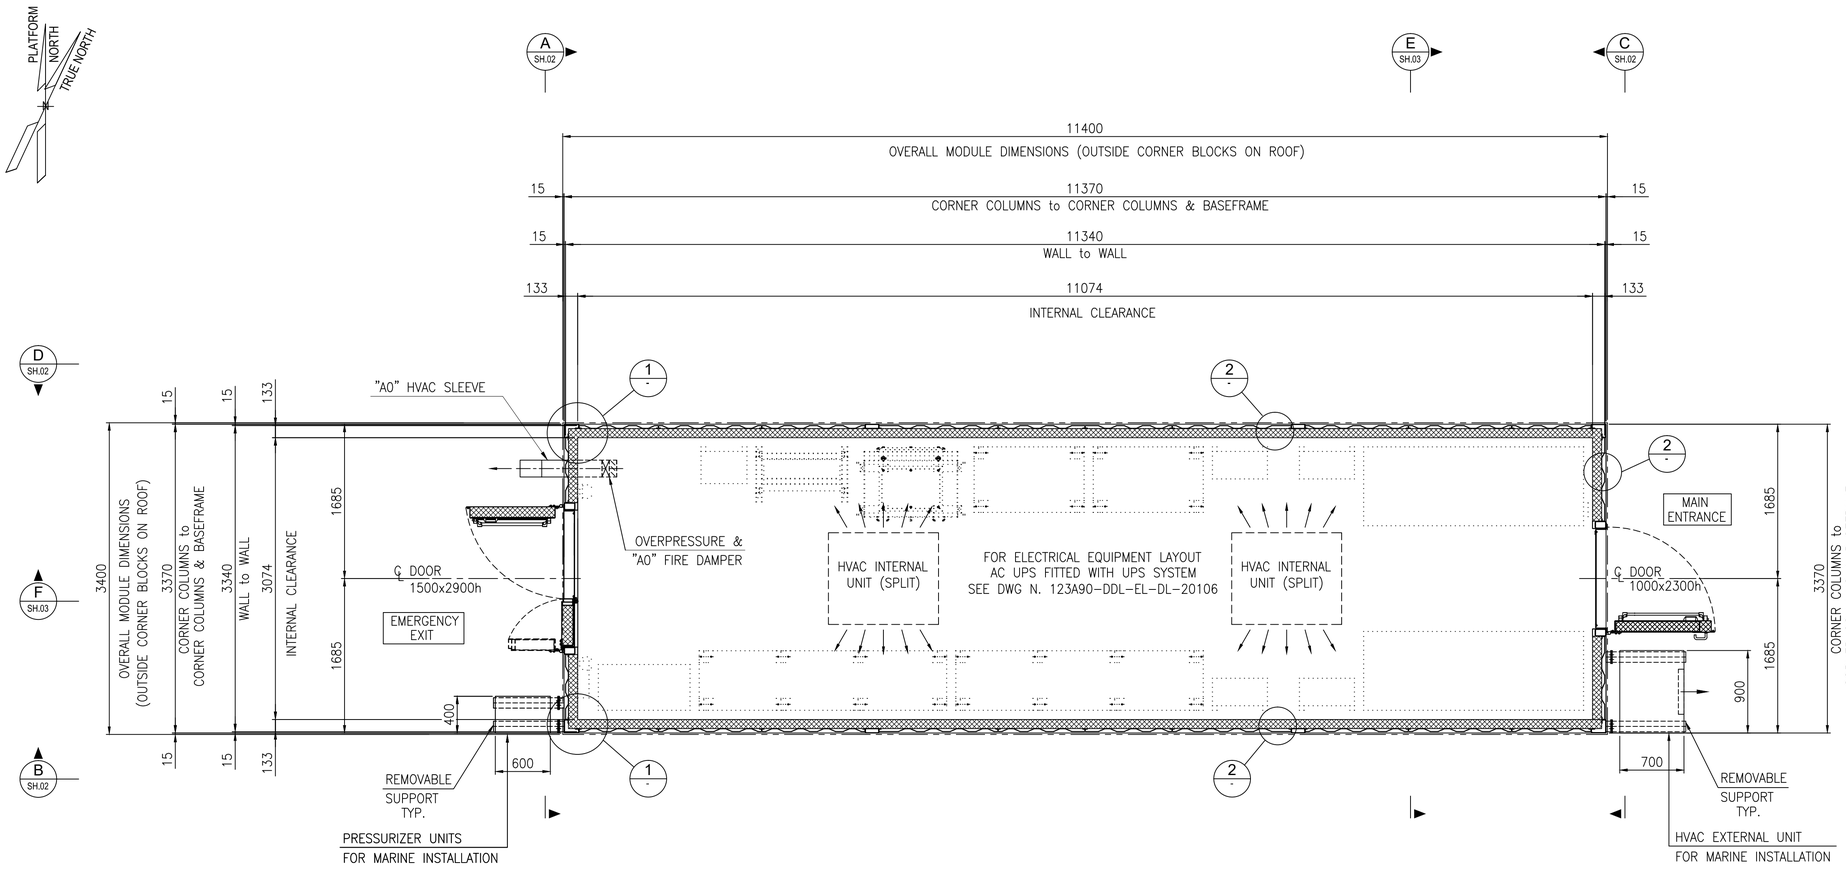



## PLAN OF AC UPS FITTED WITH UPS SYSTEM EQUIPMENT ROOM B-300


FOR SECTIONS & VIEWS SEE DWG N. 123A90-DDL-AR-DL-10022 Sh. 02 & 03

INCLUDED IN SUPPLY COMPLETE HVAC SYSTEM, NORMAL AND EMERGENCY LIGHTING SYSTEM INCLUDING CONTROL PANELS


FOR HVAC SYSTEM, LIGHTING SYSTEM, EARTH SYSTEM REF.TO DOC. N.1724000049-AR-DD-00020 (by VENDOR)

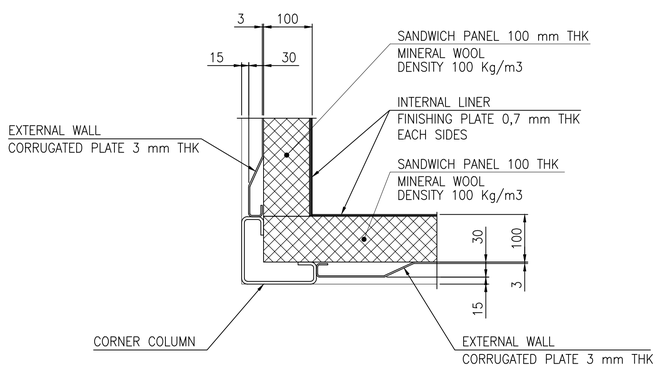


DETAIL 1 - AT CORNERS TYPICAL

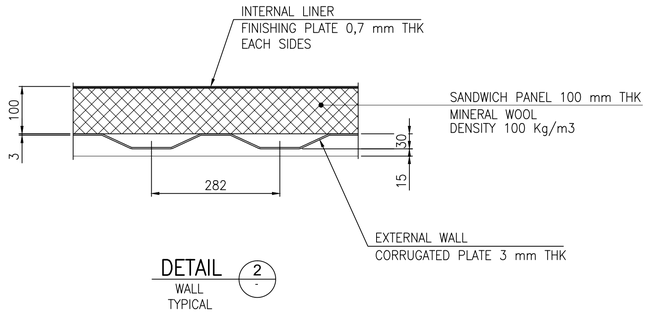


DETAIL 2 - WALL TYPICAL

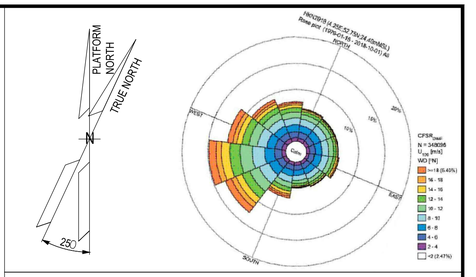


## NOTES

1. U.N.O. ALL DIMENSIONS ARE IN MILLIMETERS.
2. ALL WELDS MUST BE CONTINUOUS, SPOT WELDS ARE NOT PERMITTED

## LEGEND

U.N.O. _____ UNLESS NOTED OTHERWISE
T.O.S. _____ TOP OF STEEL
T.O.P. _____ TOP OF PLATE
T.B.D. _____ TO BE DEFINED
T.B.C. _____ TO BE COMFIRMED

_____ CORRUGATED PLATE 3 mm THK

_____ THERMAL INSULATION


_____ EQUIPMENT INSIDE MODULE

## HOLDS

## REFERENCE

| DOCUMENT TITLE | DOCUMENT NUMBER |
|---|---|
| AC UPS fitted with UPS system E.R. – Supply Specification | 123A90-DDL-AR-SP-10021 |
| AC UPS fitted with UPS system E.R. – Material Requisition | 123A90-DDL-AR-SP-10026 |
| AC UPS with UPS system E.R. – Doors Map and Schedule | 123A90-DDL-AR-DL-10023 |
| AC UPS with UPS system E.R. – Flooring and Lining Layout | 123A90-DDL-AR-DL-10024 |
| AC UPS fitted with UPS system E.R. Fire rated requirement layout (plan, section, typical detail) | 123A90-DDL-AR-DL-10025 |
| El. Equipment Layout – AC UPS fitted with UPS system E.R. | 123A90-DDL-EL-DL-20106 |
| B-300 General Arrangement Drawings (by Vendor) | 1724000049-AR-DA-00016 |
| B-300 Detail Drawings (by Vendor) | 1724000049-AR-DD-00020 |
| B-300 Structural Calculation (by Vendor) | 1724000049-ST-CA-00008 |
| B-300 Foundation Dwg (by Vendor) | 1724000049-ST-DD-00012 |
| Lifting Drawings (by Vendor) | 1724000049-AR-DD-00062 |

## KEY PLAN

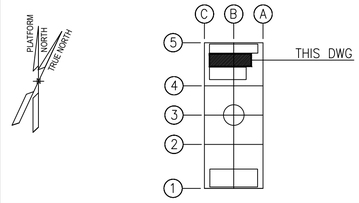


STILOG

| REV. | DATE | DRN | CHKD | APPD | DESCRIPTION |
|---|---|---|---|---|---|
| 02 | 18/09/25 | SPS | M. GA | CGI | AS-BUILT (ASB) |
| 01 | 29/02/24 | R. BO | M. GA | D. LO | ACCEPTED FOR CONSTRUCTION (AFC) |
| 00 | 30/10/23 | R. BO | M. GA | D. LO | ISSUE FOR REVIEW (IFR) |

CROSSWIND

ROSETTI MARINO

TITLE : BASE LOAD POWER HUB (BLPH)
AC UPS fitted with UPS system Equipment Room B-300 – ARCHITECTURAL
GENERAL LAYOUT – PLAN, WIEW, SECT. & TYP. DET.


CONTRACT NO./TITLE CW-I-WP4-2023-05/HOLLANDSE KUST NOORD WIND PARK | SCALE 1:33

DRAWN SPS | CHECKED M. GATTI | APPROVED CGI | DATE 18/09/25

A1 | DRAWING NO. 123A90-DDL-AR-DL-10022 | SHEET 001 | REV. 02


File Name : 123A90-DDL-AR-DL-10022 REV.02


DRAWING NO. 123A90-DDL-AR-DL-10022 REV. 02

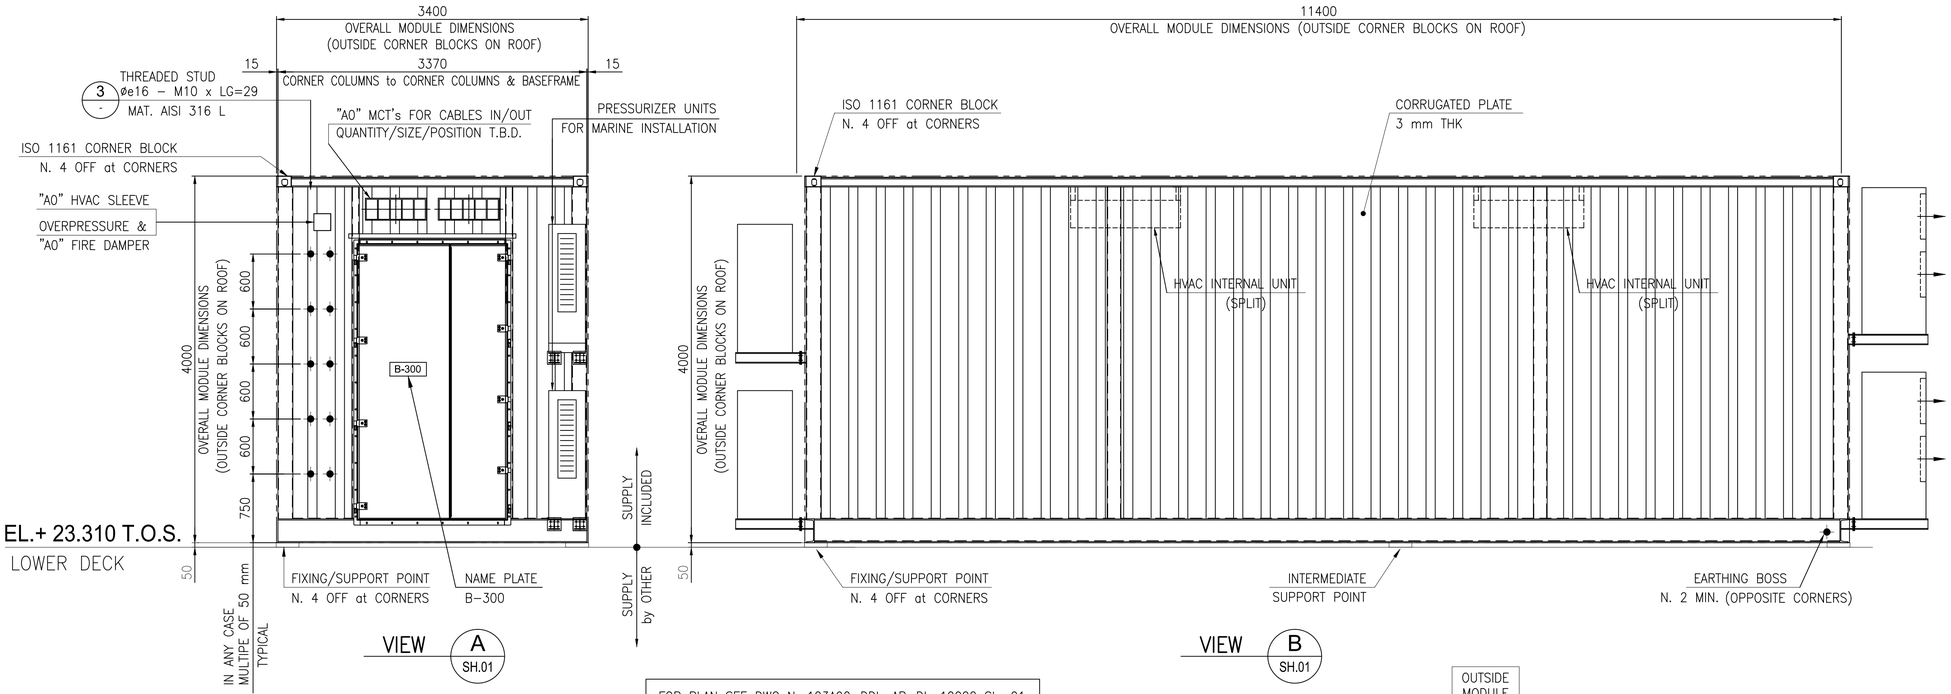



FOR PLAN SEE DWG N. 123A90-DDL-AR-DL-10022 Sh. 01

FOR HVAC SYSTEM, LIGHTING SYSTEM, EARTH SYSTEM, MCT's WALL PENETRATIONS
REF. TO DOC. N.1724000049-AR-DD-00020 (by VENDOR)

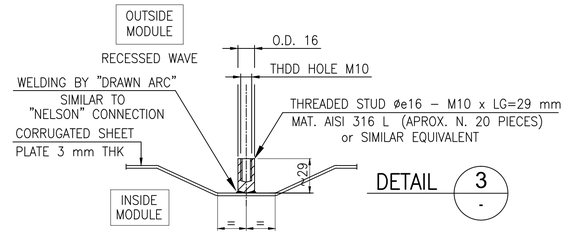

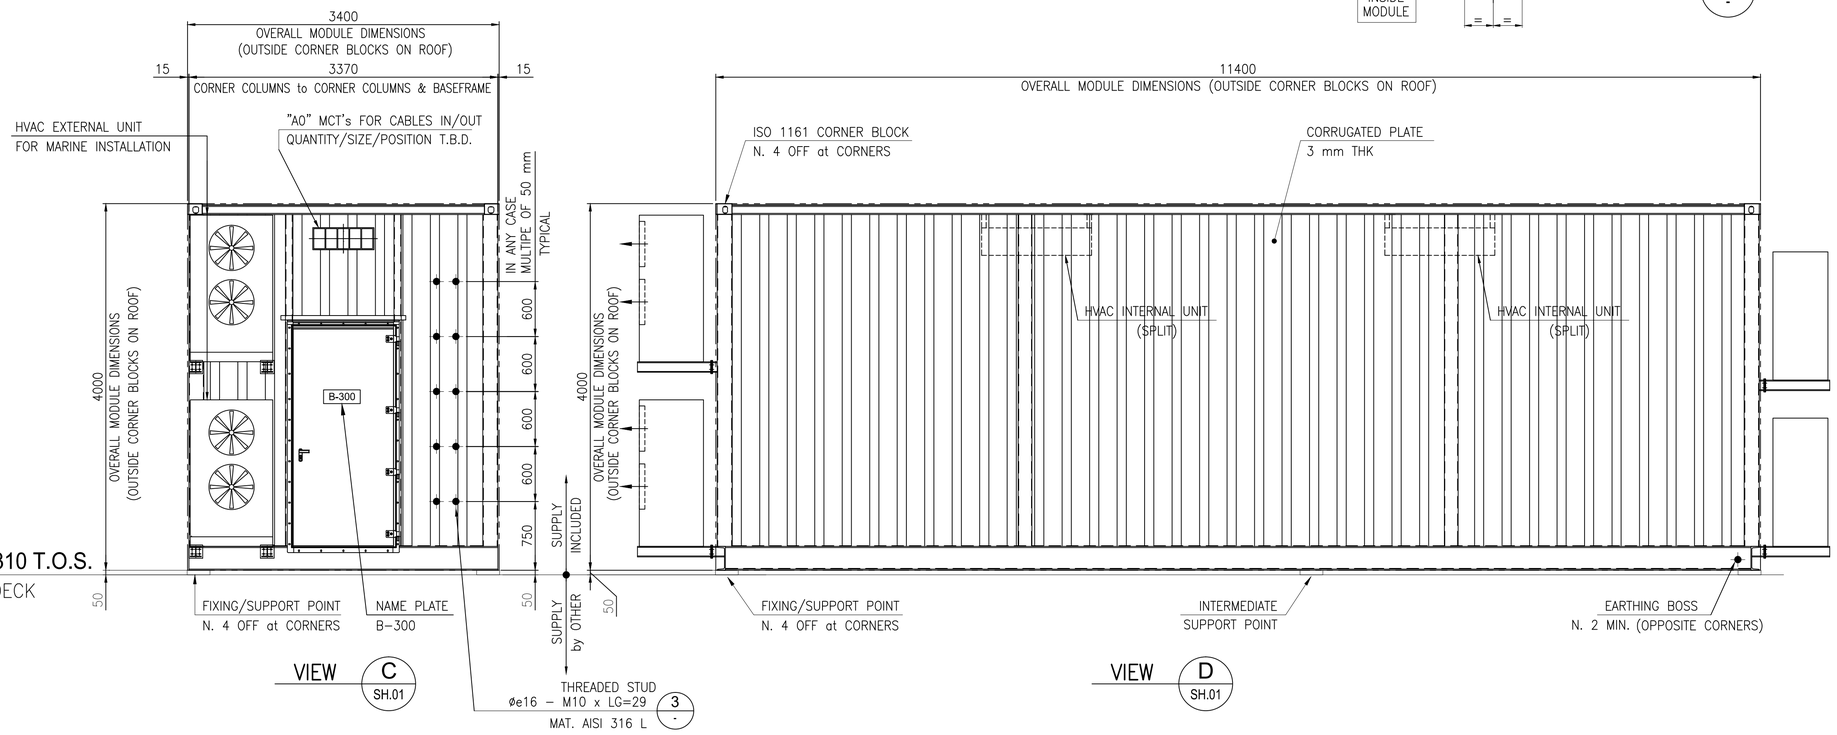
## NOTES

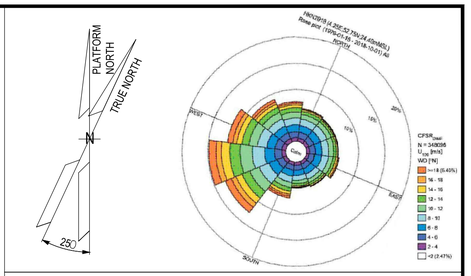1. U.N.O. ALL DIMENSIONS ARE IN MILLIMETERS.
2. ALL WELDS MUST BE CONTINUOUS, SPOT WELDS ARE NOT PERMITTED

## LEGEND

U.N.O. _____ UNLESS NOTED OTHERWISE
T.O.S. _____ TOP OF STEEL
T.O.P. _____ TOP OF PLATE
T.B.D. _____ TO BE DEFINED
T.B.C. _____ TO BE COMFIRMED


_____ CORRUGATED PLATE 3 mm THK
_____ THERMAL INSULATION
_____ EQUIPMENT INSIDE MODULE

## HOLDS

## REFERENCE

| DOCUMENT TITLE | DOCUMENT NUMBER |
|---|---|
| AC UPS fitted with UPS system E.R. – Supply Specification | 123A90-DDL-AR-SP-10021 |
| AC UPS fitted with UPS system E.R. – Material Requisition | 123A90-DDL-AR-SP-10026 |
| AC UPS with UPS system E.R. – Doors Map and Schedule | 123A90-DDL-AR-DL-10023 |
| AC UPS with UPS system E.R. – Flooring and Lining Layout | 123A90-DDL-AR-DL-10024 |
| AC UPS fitted with UPS system E.R. Fire rated requirement layout (plan, section, typical detail) | 123A90-DDL-AR-DL-10025 |
| El. Equipment Layout – AC UPS fitted with UPS system E.R. | 123A90-DDL-EL-DL-20106 |
| B-300 General Arrangement Drawings (by Vendor) | 1724000049-AR-DA-00016 |
| B-300 Detail Drawings (by Vendor) | 1724000049-AR-DD-00020 |
| B-300 Structural Calculation (by Vendor) | 1724000049-ST-CA-00008 |
| B-300 Foundation Dwg (by Vendor) | 1724000049-ST-DD-00012 |
| Lifting Drawings (by Vendor) | 1724000049-AR-DD-00062 |

## KEY PLAN

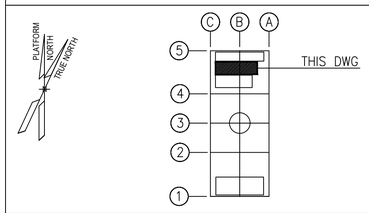


STILOG

| REV. | DATE | DRN | CHKD | APPD | DESCRIPTION |
|---|---|---|---|---|---|
| 02 | 18/09/25 | SPS | M. GA | CGI | AS-BUILT (ASB) |
| 01 | 29/02/24 | R. BO | M. GA | D. LO | ACCEPTED FOR CONSTRUCTION (AFC) |
| 00 | 30/10/23 | R. BO | M. GA | D. LO | ISSUE FOR REVIEW (IFR) |

CROSSWIND

ROSETTI MARINO

TITLE : BASE LOAD POWER HUB (BLPH)
AC UPS fitted with UPS system Equipment Room B-300 – ARCHITECTURAL
GENERAL LAYOUT – PLAN, WIEW, SECT. & TYP. DET.

CONTRACT NO./TITLE CW-I-WP4-2023-05/HOLLANDSE KUST NOORD WIND PARK | SCALE 1:33


DRAWN SPS | CHECKED M. GATTI | APPROVED CGI | DATE 18/09/25

A1 | DRAWING NO. 123A90-DDL-AR-DL-10022 | SHEET 002 | REV. 02


File Name : 123A90-DDL-AR-DL-10022 REV.02

DRAWING NO. 123A90-DDL-AR-DL-10022

REV. 02

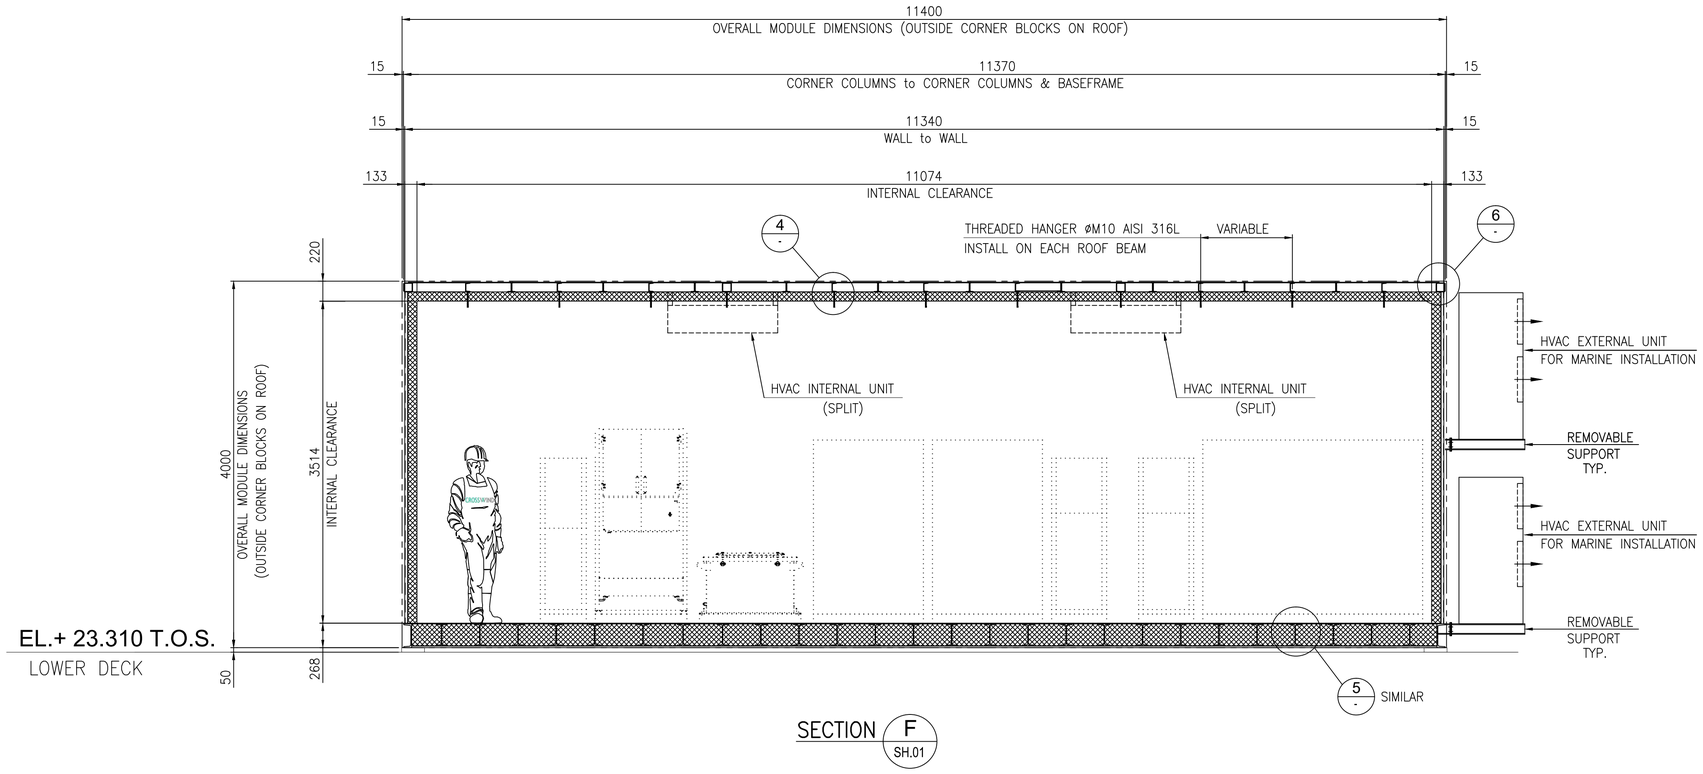


SECTION F
SH.01

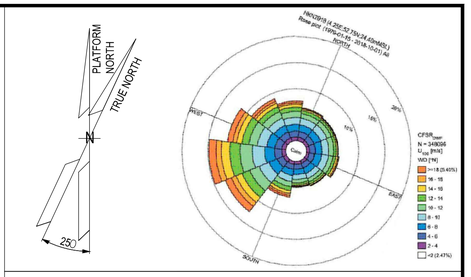


## NOTES

1. U.N.O. ALL DIMENSIONS ARE IN MILLIMETERS.
2. ALL WELDS MUST BE CONTINUOUS, SPOT WELDS ARE NOT PERMITTED


## LEGEND

| | |
|---|---|
| U.N.O. | UNLESS NOTED OTHERWISE |
| T.O.S. | TOP OF STEEL |
| T.O.P. | TOP OF PLATE |
| T.B.D. | TO BE DEFINED |
| T.B.C. | TO BE COMFIRMED |
| | CORRUGATED PLATE 3 mm THK |
| | THERMAL INSULATION |
| | EQUIPMENT INSIDE MODULE |

## HOLDS

## REFERENCE


| DOCUMENT TITLE | DOCUMENT NUMBER |
|---|---|
| AC UPS fitted with UPS system E.R. – Supply Specification | 123A90-DDL-AR-SP-10021 |
| AC UPS fitted with UPS system E.R. – Material Requisition | 123A90-DDL-AR-SP-10026 |
| AC UPS with UPS system E.R. – Doors Map and Schedule | 123A90-DDL-AR-DL-10023 |
| AC UPS with UPS system E.R. – Flooring and Lining Layout | 123A90-DDL-AR-DL-10024 |
| AC UPS fitted with UPS system E.R. Fire rated requirement layout (plan, section, typical detail) | 123A90-DDL-AR-DL-10025 |
| El. Equipment Layout – AC UPS fitted with UPS system E.R. | 123A90-DDL-EL-DL-20106 |
| B-300 General Arrangement Drawings (by Vendor) | 1724000049-AR-DA-00016 |
| B-300 Detail Drawings (by Vendor) | 1724000049-AR-DD-00020 |
| B-300 Structural Calculation (by Vendor) | 1724000049-ST-CA-00008 |
| B-300 Foundation Dwg (by Vendor) | 1724000049-ST-DD-00012 |
| Lifting Drawings (by Vendor) | 1724000049-AR-DD-00062 |

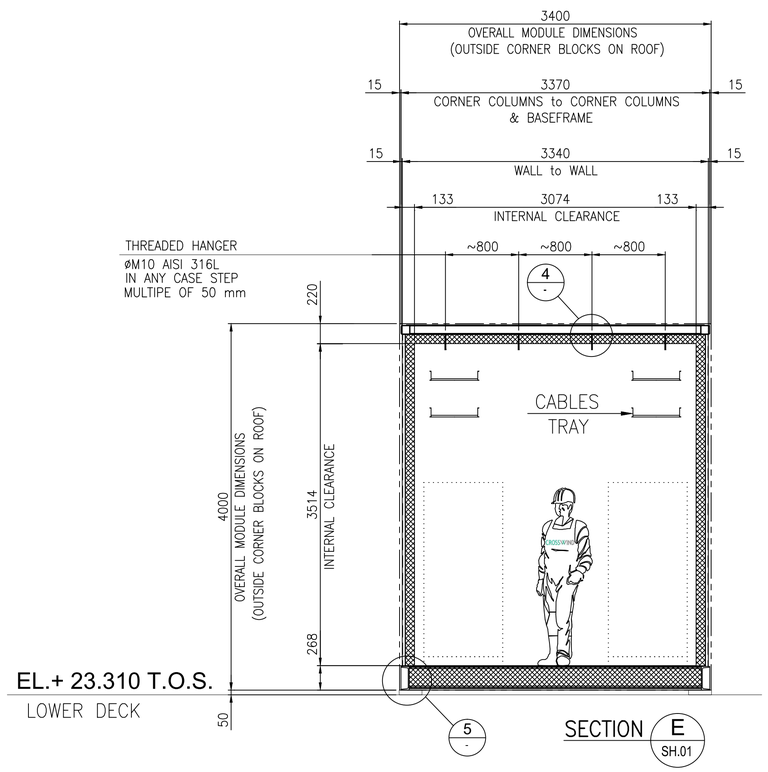



SECTION E
SH.01

FOR PLAN SEE DWG N. 123A90-DDL-AR-DL-10022 Sh. 01


FOR HVAC SYSTEM, LIGHTING SYSTEM, EARTH SYSTEM, MCT's WALL PENETRATIONS REF. TO DOC. N.1724000049-AR-DD-00020 (by VENDOR)

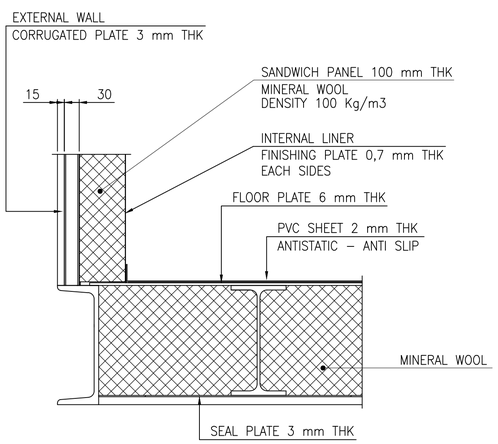


DETAIL 5
-

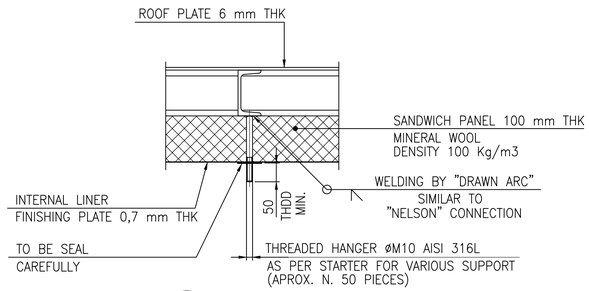



DETAIL 4
-

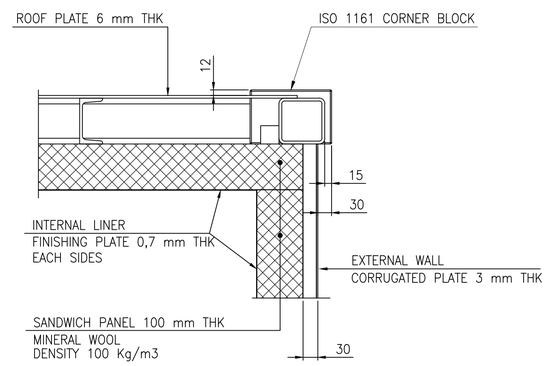


DETAIL 6
-

## KEY PLAN

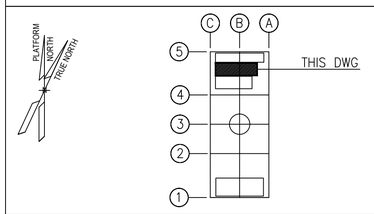


STILOG

| REV. | DATE | DRN | CHKD | APPD | DESCRIPTION |
|---|---|---|---|---|---|
| 02 | 18/09/25 | SPS | M. GA | CGI | AS-BUILT (ASB) |
| 01 | 29/02/24 | R. BO | M. GA | D. LO | ACCEPTED FOR CONSTRUCTION (AFC) |
| 00 | 30/10/23 | R. BO | M. GA | D. LO | ISSUE FOR REVIEW (IFR) |

CROSSWIND

ROSETTI MARINO

TITLE :
BASE LOAD POWER HUB (BLPH)
AC UPS fitted with UPS system Equipment Room B-300 – ARCHITECTURAL
GENERAL LAYOUT – PLAN, WIEW, SECT. & TYP. DET.

| | | | |
|---|---|---|---|
| CONTRACT NO./TITLE CW-I-WP4-2023-05/HOLLANDSE KUST NOORD WIND PARK | | SCALE 1:33 | |
| DRAWN SPS | CHECKED M. GATTI | APPROVED CGI | DATE 18/09/25 |
| A1 | DRAWING NO. 123A90-DDL-AR-DL-10022 | SHEET 003 | REV. 02 |

File Name : 123A90-DDL-AR-DL-10022 REV.02