

DRAWING NO. 123A90-DDL-AR-DL-10023

REV. 02

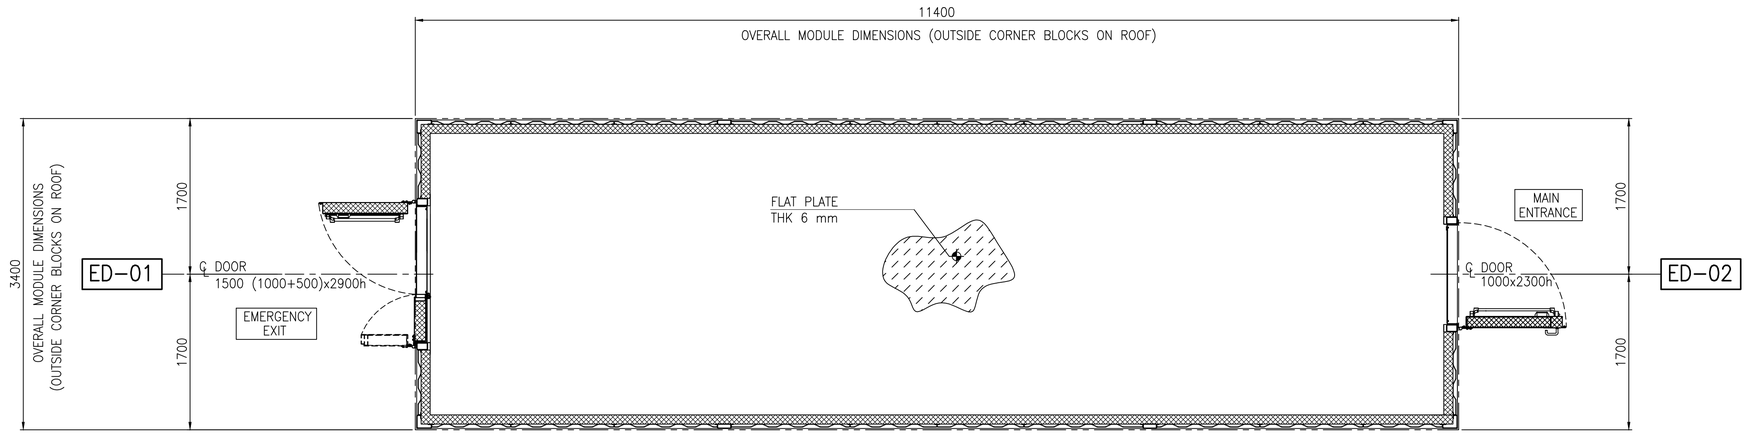


PLAN OF AC UPS FITTED WITH UPS SYSTEM EQUIPMENT ROOM B-300
DOORS MAP

THIS DRAWING IS VALID FOR DOORS MAPS/SCHEDULE ONLY

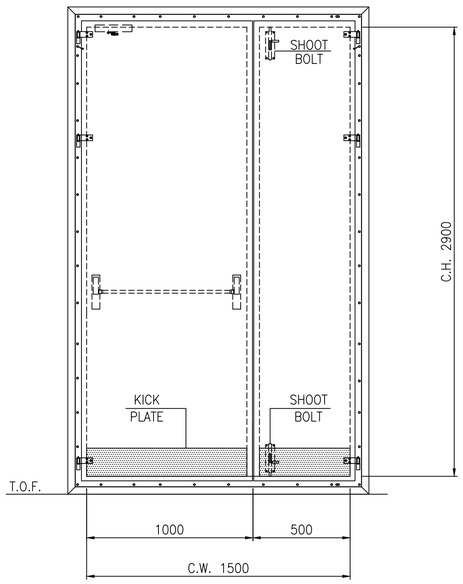


EXTERNAL
DOUBLE DOOR "A0"

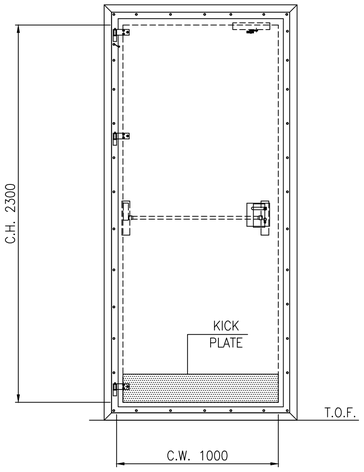

EXTERNAL
SINGLE DOOR "A0"

DOOR OPENING SENSE:

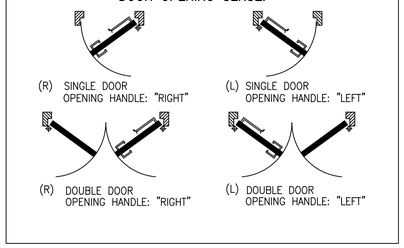

DOORS SCHEDULE HOLD 1

DOOR IDENTIFICATION NUMBER	QUATITY	FIRE CLASS	SIZE AND OPENING SENSE					LOCATION	COATINGS AND COLOURS								LOCK TYPE AND HARDWARE										VARIOUS							
									DOOR LEAF (INTERNAL / EXTERNAL)				FRAME																					
									EXTERNAL		INTERNAL																							
			CLEAR OPENING W x H (mm)	SINGLE DOOR	DOUBLE DOOR	LEFT	RIGTH		MATERIAL	COLOUR RAL	MATERIAL	COLOUR RAL	MATERIAL	TO BE BOLTED	TO BE WELDED	COLOUR RAL	THRESHOLD (MINIMUM HEIGHT)	HINGE TYPE	HANDLE TYPE EXTERNAL SIDE & ESCUTCHEON	HANDLE TYPE INTERNAL SIDE & ESCUTCHEON	PANIC BAR INTERNAL SIDE	CYLINDER LOCK	SHOOT BOLT (TO BE INTAL. ON THE SEC. WING)	FIRE RESISTANT GASKET DOOR FRAME STRUCTURE FRAME	S.S. KICK PLATE H=200mm ON BOTH SIDES OF EACH DOOR LEAF	SELF CLOSING DEVICE	LIMIT SWITCH	INTERNAL OVER PRESSURE (Pa) (NORMAL OPERATION)	BLAST RESISTANCE (mbarg)	THERMAL INSULATION (W/m2/°C)	ACOUSTIC INSULATION (dbA) SOUND REDUCTION	VISION PANEL WITH S.S. FRAME 500x200 mm	HINGE NUMBER (AT LEAST)	AIR LEAKEGE MAX 10m3/h*m2 at 50 Pa	EARTHING SYSTEM CONNECTION
ED-01	1	A0	1500 (1000+500)x2900		X	X		TECHNICAL ROOM	S.S.	7035	S.S.	7035	S.S.	X		7035	X	S.S.	N.A.		S.S.	X	X	X	X	X	by other	25	N.A.	0,45	40	N.A.	3+3	X	X
ED-02	1	A0	1000 x 2200	X		X		TECHNICAL ROOM	S.S.	7035	S.S.	7035	S.S.	X		7035	X	S.S.	S.S.		S.S.	X		X	X	X	by other	25	N.A.	0,45	40	N.A.	3	X	X

NOTES

1. U.N.O. ALL DIMENSIONS ARE IN MILLIMETERS
2. IN CASE OF DOUBLE LEAF DOORS, THE DOOR ACCESSORIES ARE INTENDED TO BE INSTALLED ONLY ON THE ACTIVE LEAF
3. ALL WELDS MUST BE CONTINUOUS, SPOT WELDS ARE NOT PERMITTED

LEGEND

U.N.O.	UNLESS NOTED OTHERWISE
T.O.S.	TOP OF STEEL
T.O.P.	TOP OF PLATE
T.O.F.	TOP OF FLOOR
℄	CENTER LINE
G.S.	GALVANIZED STEEL
S.S.	STAINLEES STEEL (AISI 316L)
N.A.	NOT APPLICABLE
T.B.D.	TO BE DEFINED
T.B.C.	TO BE COMFIRMED
C.O.	CLEAR OPENING
C.W.	CLEAR WIDTH
C.H.	CLEAR HEIGHT


XX-ZZ — CONTINUOUS NUMBER
ED=EXTERNAL DOOR

HOLDS

REFERENCE

DOCUMENT TITLE	DOCUMENT NUMBER
AC UPS fitted with UPS system E.R. – Supply Specification	123A90-DDL-AR-SP-10021
AC UPS with UPS system E.R. – General Layout (plan, view, section)	123A90-DDL-AR-DL-10022
AC UPS with UPS system E.R. – Flooring and Lining Layout	123A90-DDL-AR-DL-10024
AC UPS fitted with UPS system E.R. Fire rated requirement layout (plan, section, typical detail)	123A90-DDL-AR-DL-10025
B-300 General Arrangement Drawings (by Vendor)	1724000049-AR-DA-00016
B-300 Detail Drawings (by Vendor)	1724000049-AR-DD-00020

KEY PLAN

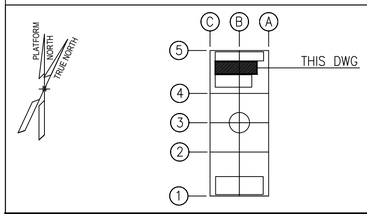

STILOG

REV.	DATE	DRN	CHKD	APPD	DESCRIPTION
02	18/09/25	SPS	M. GA	CGI	AS-BUILT (ASB)
01	29/02/24	R. BO	M. GA	D. LO	ACCEPTED FOR CONSTRUCTION (AFC)
00	30/10/23	R. BO	M. GA	D. LO	ISSUE FOR REVIEW (IFR)

CROSSWIND — ROSETTI MARINO

TITLE :
BASE LOAD POWER HUB (BLPH)
AC UPS fitted with UPS system Equipment Room B-300 – ARCHITECTURAL
DOOR MAP and DOOR SCHEDULE

CONTRACT NO./TITLE CW-I-WP4-2023-05/HOLLANDSE KUST NOORD WIND PARK | SCALE 1:33
DRAWN SPS | CHECKED M. GATTI | APPROVED CGI | DATE 18/09/25
A1 | DRAWING NO. 123A90-DDL-AR-DL-10023 | SHEET 001 | REV. 02

File Name : 123A90-DDL-AR-DL-10023 REV.02