

DRAWING NO. 123A90-DDL-AR-DL-100124

REV. 02

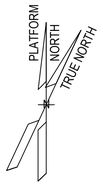


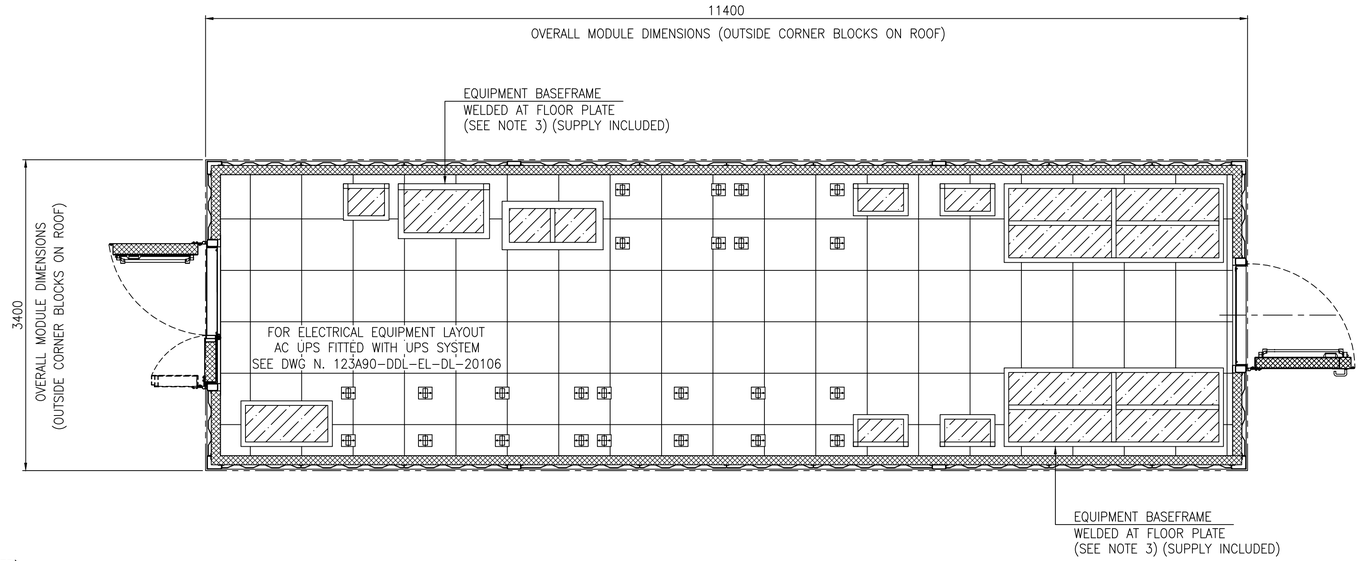


PLAN OF AC UPS FITTED WITH UPS SYSTEM EQUIPMENT ROOM B-300
FLOOR FINISHING

ALL SUPPORTS FOR FLOOR and WALL MOUNTED CABINETS/EQUIPMENT ARE INCLUDED IN THE SCOPE OF SUPPLY


FOR BASEFRAMES DETAILS REF. TO DOC. B-300 DETAIL DRAWINGS N°. 1724000049-AR-DD-00020 (by VENDOR)

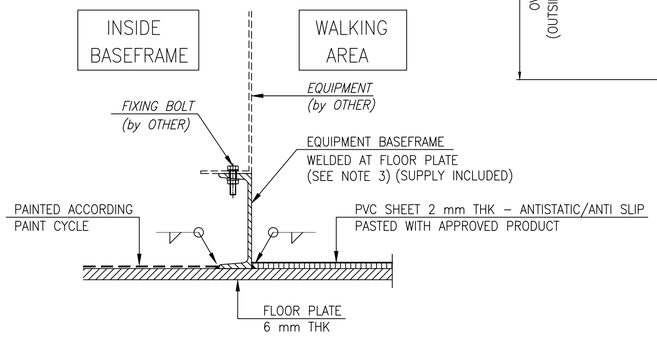

FLOOR FINISHING DETAIL
AND BASEFRAME INTALLATION DETAIL

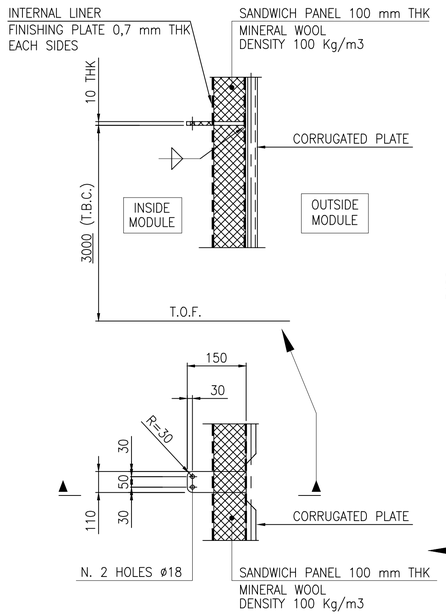



DETAIL OF SEAFASTENING PLATE
TOTAL N. 16 PIECES

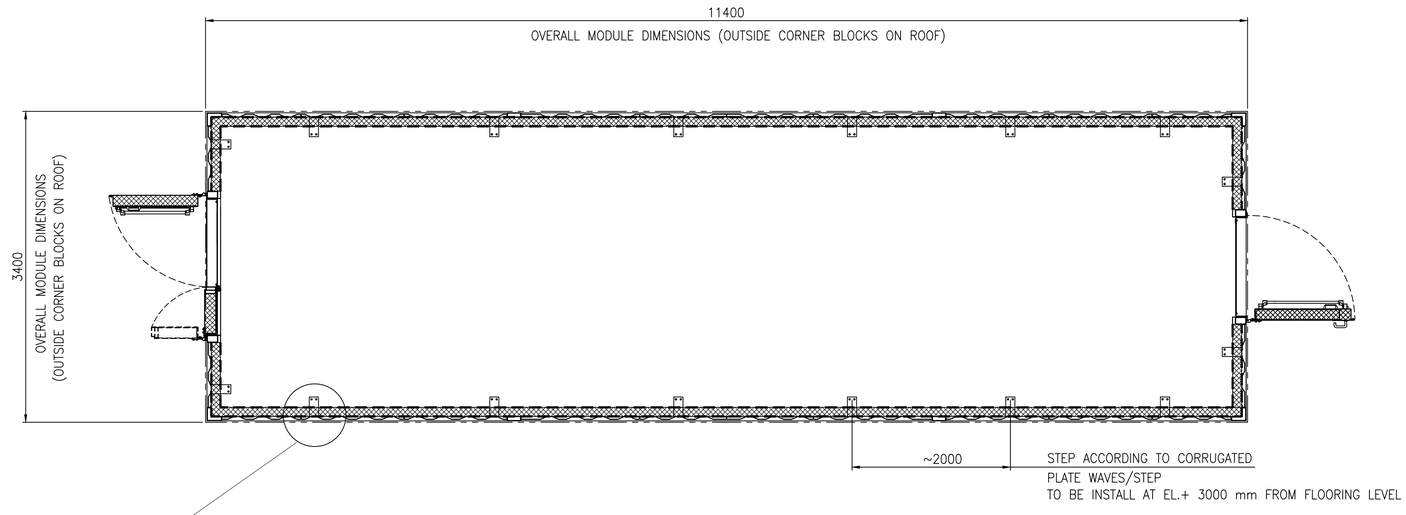

PLAN OF AC UPS FITTED WITH UPS SYSTEM EQUIPMENT ROOM B-300
INTERNAL LINER & PLATE FOR SEAFASTENING


FOR BASEFRAMES DETAILS REF. TO DOC. B-300 DETAIL DRAWINGS N°. 1724000049-AR-DD-00020 (by VENDOR)

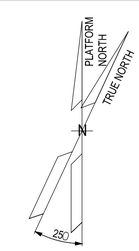

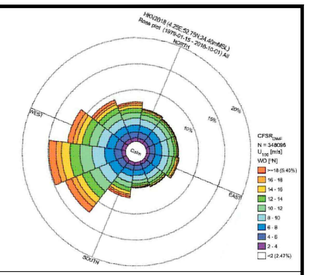

NOTES

1. U.N.O. ALL DIMENSIONS ARE IN MILLIMETERS.
2. ALL WELDS SHALL BE ACCORDING TO A.W.S. CODE.
3. ALL WELDS MUST BE CONTINUOUS, SPOT WELDS ARE NOT PERMITTED
4. U.N.O. ALL FILLET WELDS SHALL HAVE FOLLOWING DIMENSION:

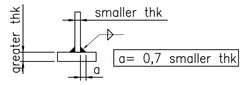

LEGEND


U.N.O.	UNLESS NOTED OTHERWISE
T.O.S.	TOP OF STEEL
T.O.P.	TOP OF PLATE
T.O.F.	TOP OF FLOOR
℄	CENTER LINE
T.B.D.	TO BE DEFINED
T.B.C.	TO BE COMFIRMED
	FLOOR FINISHING – SEAMLESS PVC SHEET 2 mm THK NON-SLIP, ANTI-STATIC SUITABLE FOR HEAVY DUTY USE
	DECK PAINTING ONLY
	LINER 0,7 mm THK INCLUDED IN SANDWICH PANEL
	SEAFASTENING PLATE

HOLDS

REFERENCE

DOCUMENT TITLE	DOCUMENT NUMBER
AC UPS fitted with UPS system E.R. – Supply Specification	123A90-DDL-AR-SP-10021
AC UPS with UPS system E.R. – General Layout (plan, view, section)	123A90-DDL-AR-DL-10022
AC UPS with UPS system E.R. – Doors Map and Schedule	123A90-DDL-AR-DL-10023
AC UPS fitted with UPS system E.R. Fire rated requirement layout (plan, section, typical detail)	123A90-DDL-AR-DL-10025
B-300 General Arrangement Drawings (by Vendor)	1724000049-AR-DA-00016
B-300 Detail Drawings (by Vendor)	1724000049-AR-DD-00020

KEY PLAN

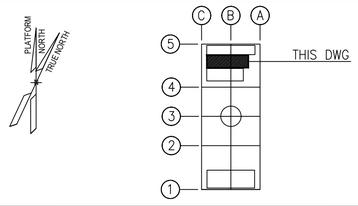

STILOG

REV.	DATE	DRN	CHKD	APPD	DESCRIPTION
02	18/09/25	SPS	M. GA	CGI	AS-BUILT (ASB)
01	29/02/24	R. BO	M. GA	D. LO	ACCEPTED FOR CONSTRUCTION (AFC)
0	30/10/23	R. BO	M. GA	D. LO	ISSUE FOR REVIEW (IFR)

CROSSWIND

ROSETTI MARINO

TITLE :
BASE LOAD POWER HUB (BLPH)
AC UPS fitted with UPS system Equipment Room B-300 – ARCHITECTURAL
FLOORING and LINING LAYOUT

CONTRACT NO./TITLE	CW-I-WP4-2023-05/HOLLANDSE KUST NOORD WIND PARK		SCALE 1:33
DRAWN SPS	CHECKED M. GATTI	APPROVED CGI	DATE 18/09/25

A1	DRAWING NO.	SHEET	REV.
	123A90-DDL-AR-DL-10024	001	02

File Name : 123A90-DDL-AR-DL-10024 REV.02