


DRAWING NO. 123A90-DDL-AR-DL-10025 REV. 02

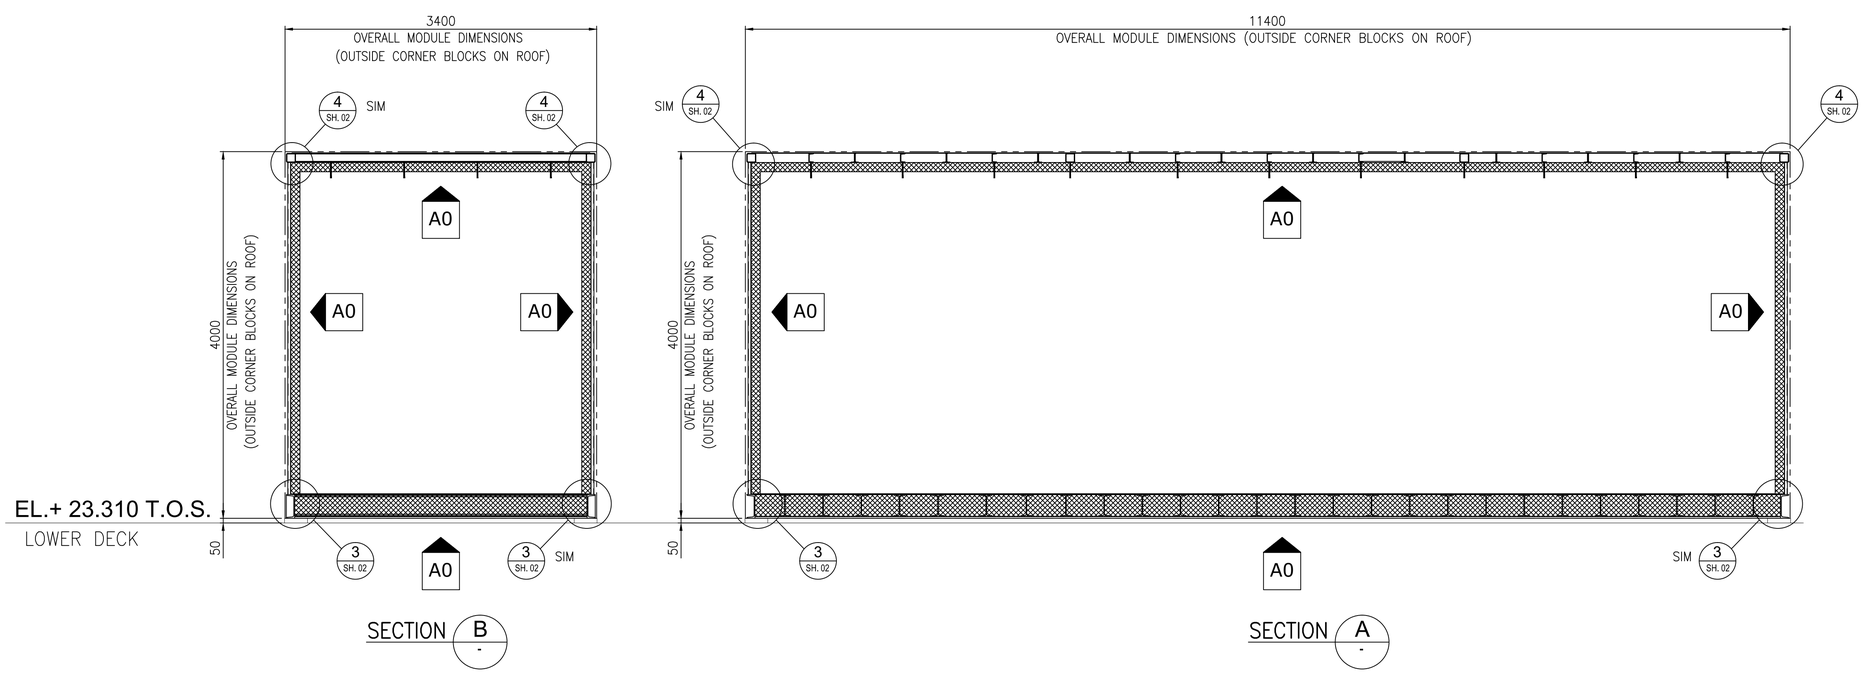

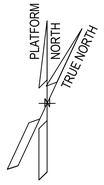

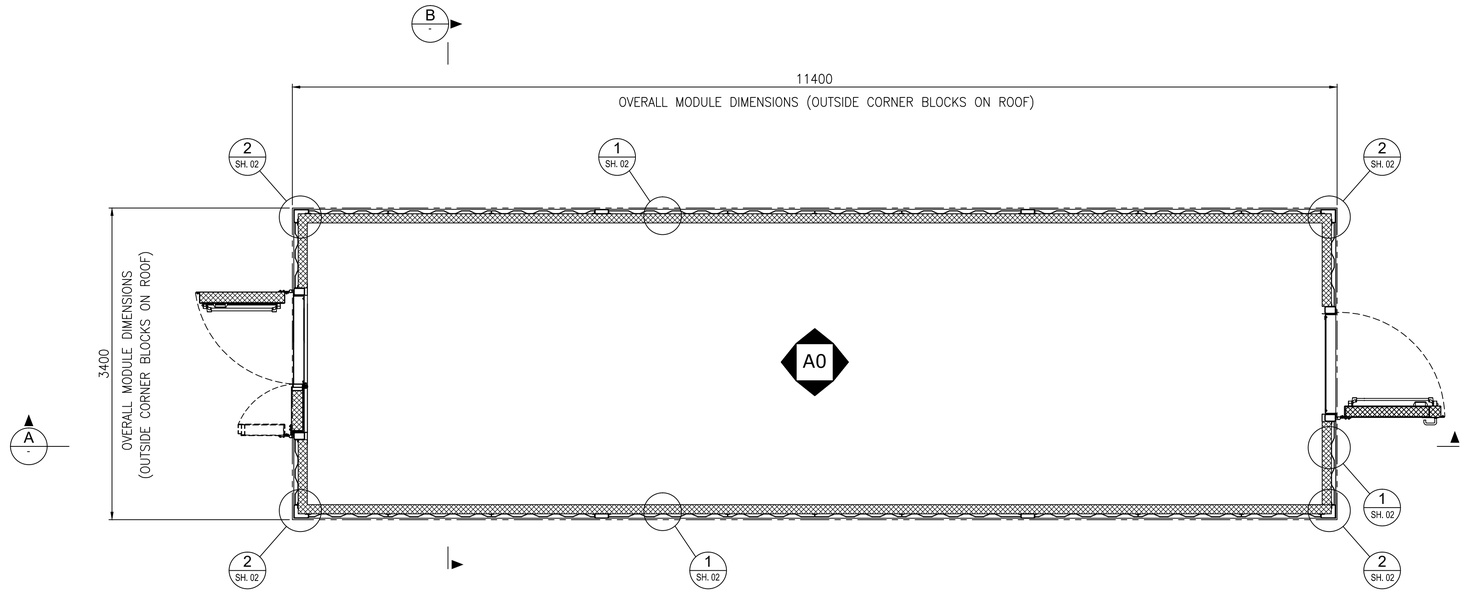


PLAN OF AC UPS FITTED WITH UPS SYSTEM EQUIPMENT ROOM B-300

FIRE SUBDIVISION and THERMAL & FIRE INSULATION

FOR DETAILS SEE DWG N. 123A90-DDL-AR-DL-10025 Sh. 02

THERMAL INSULATION REQUIREMENTS

"U" VALUE = 0,45 [W/m2.K)] { ROOF; EXPOSED BULKHEAD; FLOOR EXPOSED BELOW; INTERNAL BULKHEAD

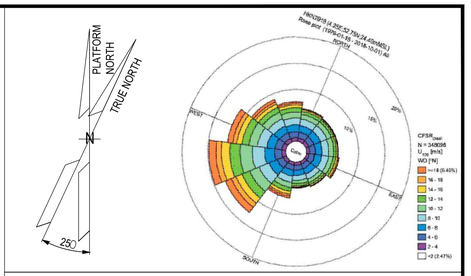

NOTES

1. U.N.O. ALL DIMENSIONS ARE IN MILLIMETERS.
2. FIRE RATING OF DOOR AND PENETRATION SHALL BE THE SAME AS WALL/DECK FIRE RATING.
3. FIRE PROOFING SHALL BE SUPPLIED WITH CERTIFICATE OF TYPICAL APPROVAL BY "IACS MEMBER".
4. FIRE PROOFING DETERMINED ACCORDING TO SOLAS CHAPTER II-2 REGULATION 9

LEGEND


U.N.O.	UNLESS NOTED OTHERWISE
T.O.S.	TOP OF STEEL
T.O.P.	TOP OF PLATE
T.O.F.	TOP OF FLOOR
℄	CENTER LINE
SIM	SIMILAR
T.B.D.	TO BE DEFINED
T.B.C.	TO BE COMFIRMED
A0	IMPACT DIRECTION OF POTENTIAL FIRE RESISTANCE CLASS

HOLDS

REFERENCE

DOCUMENT TITLE	DOCUMENT NUMBER
AC UPS fitted with UPS system E.R. – Supply Specification	123A90-DDL-AR-SP-10021
AC UPS with UPS system E.R. – General Layout (plan, view, section)	123A90-DDL-AR-DL-10022
AC UPS with UPS system E.R. – Doors Map and Schedule	123A90-DDL-AR-DL-10023
AC UPS with UPS system E.R. – Flooring and Lining Layout	123A90-DDL-AR-DL-10024
B-300 General Arrangement Drawings (by Vendor)	1724000049-AR-DA-00016
B-300 Detail Drawings (by Vendor)	1724000049-AR-DD-00020

KEY PLAN

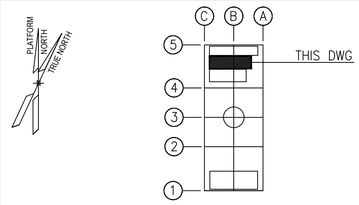

STILOG

REV.	DATE	DRN	CHKD	APPD	DESCRIPTION
02	18/09/25	SPS	M. GA	CGI	AS-BUILT (ASB)
01	29/02/24	R. BO	M. GA	D. LO	ACCEPTED FOR CONSTRUCTION (AFC)
00	30/10/23	R. BO	M. GA	D. LO	ISSUE FOR REVIEW (IFR)

CROSSWIND


ROSETTI MARINO

TITLE : BASE LOAD POWER HUB (BLPH)
AC UPS fitted with UPS system Equipment Room B-300 – ARCHITECTURAL
FIRE RATED REQ. – PLAN, SECTION & TYP. DET.


CONTRACT NO./TITLE	CW-I-WP4-2023-05/HOLLANDSE KUST NOORD WIND PARK		SCALE 1:33
DRAWN SPS	CHECKED M. GATTI	APPROVED CGI	DATE 18/09/25
A1	DRAWING NO. 123A90-DDL-AR-DL-10025	SHEET 001	REV. 02

File Name : 123A90-DDL-AR-DL-10025 REV.02

DRAWING NO. 123A90-DDL-AR-DL-10025 REV. 02

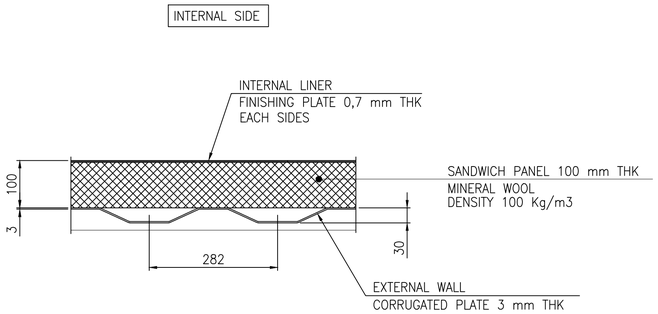


DETAIL 1 — WALL TYPICAL (SH. 01)

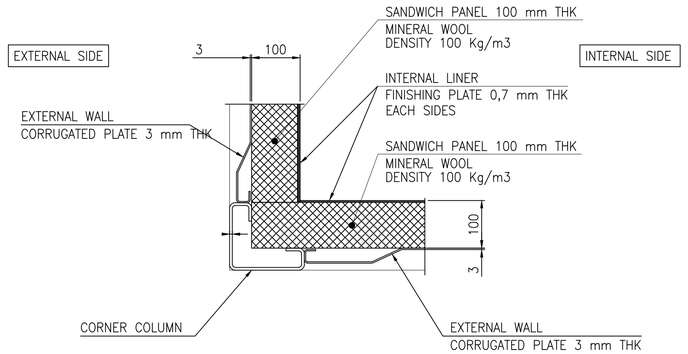


DETAIL 2 — AT PLAN CORNERS TYPICAL (SH. 01)


FOR PLAN SEE DWG N. 123A90-DDL-AR-DL-10025 Sh. 01

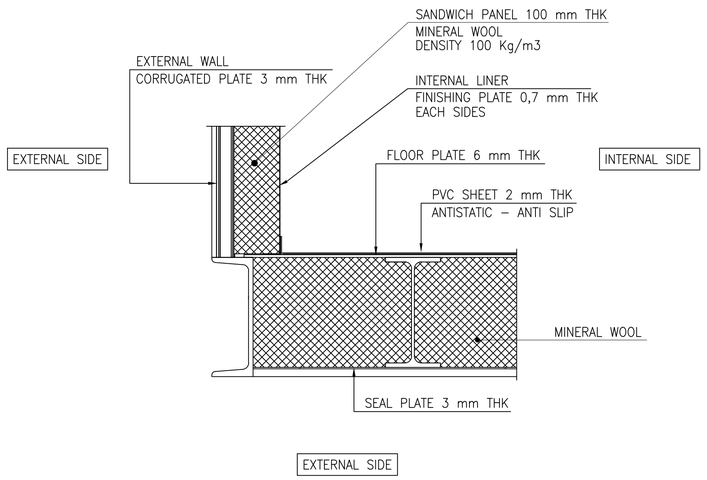

DETAIL 3 — AT BOTTOM CORNERS TYPICAL (SH. 01)

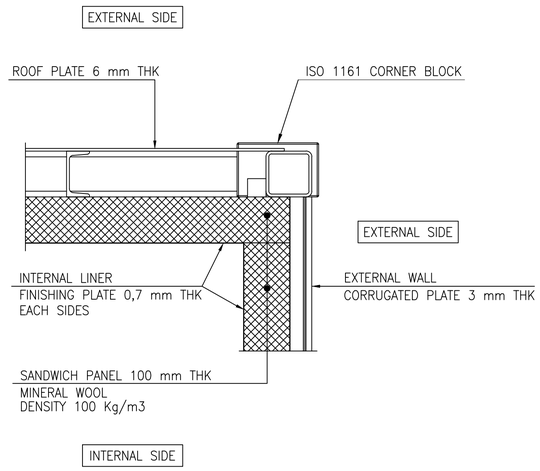

DETAIL 4 — AT TOP CORNERS TYPICAL (SH. 01)

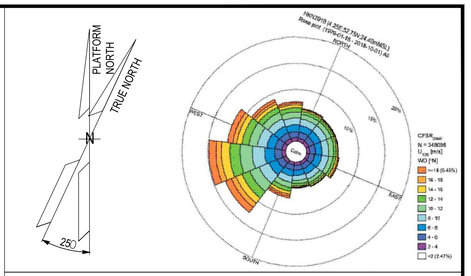

NOTES

1. U.N.O. ALL DIMENSIONS ARE IN MILLIMETERS.
2. FIRE RATING OF DOOR AND PENETRATION SHALL BE THE SAME AS WALL/DECK FIRE RATING.
3. FIRE PROOFING SHALL BE SUPPLIED WITH CERTIFICATE OF TYPICAL APPROVAL BY "IACS MEMBER".
4. FIRE PROOFING DETERMINED ACCORDING TO SOLAS CHAPTER II–2 REGULATION 9

LEGEND


U.N.O.	UNLESS NOTED OTHERWISE
T.O.S.	TOP OF STEEL
T.O.P.	TOP OF PLATE
T.O.F.	TOP OF FLOOR
℄	CENTER LINE
SIM	SIMILAR
T.B.D.	TO BE DEFINED
T.B.C.	TO BE COMFIRMED
A0	IMPACT DIRECTION OF POTENTIAL FIRE RESISTANCE CLASS

HOLDS

REFERENCE

DOCUMENT TITLE	DOCUMENT NUMBER
AC UPS fitted with UPS system E.R. – Supply Specification	123A90-DDL-AR-SP-10021
AC UPS with UPS system E.R. – General Layout (plan, view, section)	123A90-DDL-AR-DL-10022
AC UPS with UPS system E.R. – Doors Map and Schedule	123A90-DDL-AR-DL-10023
AC UPS with UPS system E.R. – Flooring and Lining Layout	123A90-DDL-AR-DL-10024
B-300 General Arrangement Drawings (by Vendor)	1724000049-AR-DA-00016
B-300 Detail Drawings (by Vendor)	1724000049-AR-DD-00020

KEY PLAN

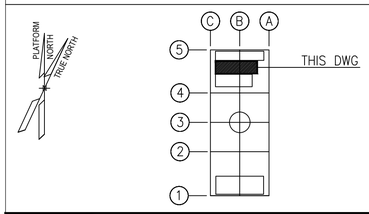

STILOG

REV.	DATE	DRN	CHKD	APPD	DESCRIPTION
02	18/09/25	SPS	M. GA	CGI	AS-BUILT (ASB)
01	29/02/24	R. BO	M. GA	D. LO	ACCEPTED FOR CONSTRUCTION (AFC)
0	30/10/23	R. BO	M. GA	D. LO	ISSUE FOR REVIEW (IFR)

CROSSWIND — ROSETTI MARINO

TITLE :
BASE LOAD POWER HUB (BLPH)
AC UPS fitted with UPS system Equipment Room B-300 – ARCHITECTURAL
FIRE RATED REQ. – PLAN, SECTION & TYP. DET.

CONTRACT NO./TITLE CW-I-WP4-2023-05/HOLLANDSE KUST NOORD WIND PARK			SCALE 1:5
DRAWN SPS	CHECKED M. GATTI	APPROVED CGI	DATE 18/09/25

A1	DRAWING NO. 123A90-DDL-AR-DL-10025	SHEET 002	REV. 02

File Name : 123A90-DDL-AR-DL-10025 REV.02